

LAND CORNER RECORDATION CERTIFICATE
Filing Requirement of Act 74, Mich. P.A. 1970 as Amended

For corners in

Macomb (County)	Located In: City of St. Clair Shores	Corner Code # PC 013
1. Public Land Survey	T <u>1N</u> R <u>13E</u>	_____
	T _____ R _____	_____
	T _____ R _____	_____
	T _____ R _____	_____
2. Property Controlling In Section	S _____ T _____ R _____	_____
	s _____ T _____ R _____	_____
3. Miscellaneous Property in Sec.	S _____ T _____ R _____	_____
	S _____ T _____ R _____	_____

9129133
 LIBER 20050 PAGE 367
 12/04/2009 04:03:06 P.M.
 MACOMB COUNTY, MI
 CARNELLA SABAUGH, REGISTER OF DEEDS

Register of Deeds Stamp & File Number

4. Lot No. _____, Recorded Plat
 5. Private Claims Northeast corner of PC 611 also being the Northwest corner of PC 624

I, Craig P. Amey, in a field survey on August 5, 2009 do hereby state that under requirements of P.A. 74, Michigan P.A. of 1970, the corner points mentioned in lines 1 and 2 above were in conformance with regulations and rules therefore as required in the current manual of survey instructions of the United States Department of the Interior, Bureau of Land Management or by a decree of a Court of Law and /or that the corner points mentioned in lines 3, 4 and 5 above were in conformance with the rules of the Michigan Board of Land Surveyors or by a Decree of a Court of Law; established, re-established, monumented, recovered, found as expressed below:

NOTE: Not more than 2 corners, all in the same town and range, may be recorded on this certificate.

A. Description of original monument and accessories and/or subsequent restoration:

Item	Date	L	P	Document	Name	#	Cor. Desc.
1	1810	--	--	Private Claim Notes	Greeley		Black Ash Tree
2	1870	1	18	Denis J. Campau's Subdivision	Munro		Not Stated
3	1924	8	12	Lake Park Subdivision	Branch	911	Not Stated
4	1925	9	65	Harper-Defer Subdivision	Lehner	123	Not Stated
5	1930	14	39	Assessors Plat No.8	Lehner	123	Not Stated
6	1955	32	30	Eastland Woods Subdivision	Fuller	1645	Not Stated
7	1956	35	8	Eastland Woods Subdivision No.1	Fuller	1645	Not Stated

(continued on back)

B. Description of corner evidence found and/or method applied in restoring or reestablishing corner:

There is no monumentation or witnesses for this corner. It is in the middle of Spindler Park. The location for this corner is the northeast corner of PC 611 also being the northwest corner of PC 624. To reestablish this position I located monumentation in the subdivisions listed in part A. I determined a position for the northerly line of Freeway Industrial Urban Renewal Plat and Harmon Subdivision and extended it northwesterly to intersect the easterly line of Eastland Woods Subdivision No. 1, No.2 and No.3. (see comparative distances on back)

C. Description of monument for corner and accessories established to perpetuate locating the position of the corner:

I set a 2" aluminum cap stamped "MACOMB COUNTY MONUMENT MI ACT 345 1990 MCL PC 013 PS 34970" in a 4" diameter, 36" long concrete monument.

- Az 05° 3.15 Centerline of a 4" fence corner post (tennis court)
- Az 140° 55.70 Centerline of a 4" fence corner post (horse shoe pits)
- Az 190° 50.10 Centerline of a 4" fence corner post (horse shoe pits)
- Az 230° 95.50 Set MCR tag and nail in the north face of an 18" oak
- Az 335° 9.48 Set chiseled "X" in east edge of a sanitary manhole rim

ACCEPTED BY THE MACOMB COUNTY SURVEY PEER GROUP AS THE OFFICIAL CORNER UNDER MICHIGAN PUBLIC ACT 345 OF 1990 AT A MEETING HELD

ON 9-29-09

Martin C. Dunn
 MARTIN C. DUNN, P.S. CHAIRMAN

THE SELECTED LOCATION IS ACCEPTED BY ME AND IS GENERALLY ACCEPTED BY PROFESSIONAL SURVEYORS AS THE BEST AVAILABLE EVIDENCE OF THE POSITION OF THIS CORNER.



Signed by [Signature]
 Surveyor's Michigan License No. 34970

Date Dec 02, 2009



LAND CORNER RECORDATION CERTIFICATE
Filing Requirement of Act 74, Mich. P.A. 1970 as Amended

For corners in

Macomb

(County)

Located In:
City of St. Clair Shores

Corner Code #
PC 013

Liber 020050 Page 00368

- | | | | | | |
|------------------------------------|---|-------|---|-------|-------|
| 1. Public Land Survey | T | 1N | R | 13E | _____ |
| | T | _____ | R | _____ | _____ |
| | T | _____ | R | _____ | _____ |
| | T | _____ | R | _____ | _____ |
| 2. Property Controlling In Section | S | _____ | T | _____ | _____ |
| | s | _____ | T | _____ | _____ |
| 3. Miscellaneous Property in Sec. | S | _____ | T | _____ | _____ |
| | S | _____ | T | _____ | _____ |


4. Lot No. _____, Recorded Plat
 5. Private Claims Northeast corner of PC 611 also being the Northwest corner of PC 624

A. Description of original monument and accessories and/or subsequent restoration:

Item	Date	L	P	Document	Name	#	Cor. Desc.
8	1957	39	42	Assessors Plat NO.33	Fuller	1645	Not Stated
9	1958	42	21	Eastland Woods Subdivision No.2	Fuller	1645	Not Stated
10	1959	45	3	Eastland Woods Subdivision No.3	Fuller	1645	Not Stated
11	1963	52	13	Bock Farms Urban Renewal Plat	Walker	5390	Not Stated
12	1966	56	43&44	Freeway Industrial Urban Renewal Plat	Walker	5390	Not Stated
13	1980	52	13&14	Harmon Subdivision	De Busscher	10684	Not Stated

B. Description of corner evidence found and/or method applied in restoring or reestablishing corner:

<u>Plat:</u>	<u>Record Distance:</u>	<u>Measured Distance:</u>
Eastland Woods Subdivision No. 1 from the NE corner to NW corner PC 624	1079.53'	1078.92'
Eastland Woods Subdivision No. 2 from the NE corner to NW corner PC 624	240.40'	240.95'
Freeway Industrial Urban Renewal Plat from the NW corner to NW corner PC 624	668.08'	656.14'

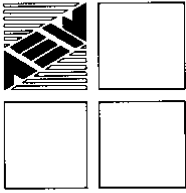

ANDERSON, ECKSTEIN AND WESTRICK, INC.

51301 Schoenherr Road, Shelby Township, Michigan 48315
Civil Engineers • Surveyors • Architects 586-726-1234

2009 Remonumentation
Corner: PC 013

In 2009, we were contracted by Macomb County to remonument PC 013 which is the northwest corner of PC 624, pursuant to ACT 345 of 1990.

In early February, we solicited information from area surveyors. None of the surveyors contacted had any unrecorded information pertinent to this corner. We also researched the public records. No surveys or LCRC's were recorded for this corner. The only evidence we were able to collect was copies of platted subdivisions.

The corner is located in Assessor's Plat No. 33, but it is not specifically denoted on the plat. The corner has direct ties to Eastland Wood Subdivision No. 1 (L.35, P.8) and Eastland Woods Subdivision No. 2 (L.42, P.21), from the south, and Freeway Industrial Urban Renewal Plat (L.56, P.43) from the east. Additionally, Bock Farms Urban Renewal Plat (L.52, P.13) and Harmon Subdivision (L.52, P.13) reference the northerly line of Private Claim 624.


To reestablish the position of the corner, we conducted field surveys to locate monumentation and occupations evidence in the above referenced plats to define the westerly line of PC 624 and the northerly line of PC 624. Once defined, the westerly line of PC 624 was extended to the north, and the northerly line of PC 624 was extended to the west. The intersection of these two lines is the northwest corner of PC 624 (PC-013). A concrete monument was set at this point

<u>Plat:</u>	<u>Record Distance:</u>	<u>Measured Distance:</u>
Eastland Woods Subdivision No. 1 from the NE corner to NW corner PC 624	1079.53'	1078.92'
Eastland Woods Subdivision No. 2 from the NE corner to NW corner PC 624	240.40'	240.95'
Freeway Industrial Urban Renewal Plat from the NW corner to NW corner PC 624	668.08'	656.14'

I believe that the methods described above have determined the best location of the northwest corner of PC 624.

Respectfully Submitted,

Craig P. Amey, PS

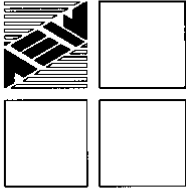

ANDERSON, ECKSTEIN AND WESTRICK, INC.


51301 Schoenherr Road, Shelby Township, Michigan 48315
Civil Engineers • Surveyors • Architects 586-726-1234

2009 Remonumentation
Corner: PC-013


Index

- I. Section 1
 - A. Index
 - B. Photographs
- II. Section 2
 - A. LCRC
 - B. Surveyor's Report
- III. Section 3
 - A. Field Notes
 - 1. Corner Witnesses
 - 2. GPS Notes
 - B. Composites
 - 1. 27A
 - 2. 27E
- IV. Section 4
 - A. GLO Notes and Plats
 - 1. 1916 Atlas
 - 2. Private Claim 624
 - 3. Denis J. Campau's Subdivision
 - 4. Lake Park Subdivision
 - 5. Harper-Defer Subdivision
 - 6. Assessors Plat No.8
 - 7. Eastland Woods Subdivision
 - 8. Eastland Woods Subdivision No.1
 - 9. Assessors Plat NO.33
 - 10. Eastland Woods Subdivision No.2
 - 11. Eastland Woods Subdivision No.3
 - 12. Bock Farms Urban Renewal Plat
 - 13. Freeway Industrial Urban Renewal Plat
 - 14. Harmon Subdivision

Corner Code: PC-013
 Town: 01N
 Range: 13E
 Object Found: None

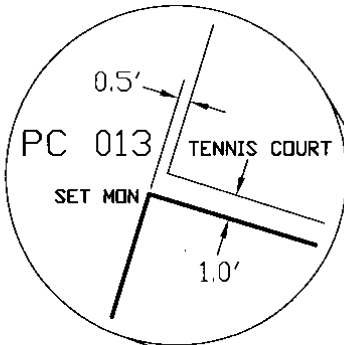

SPINDLER PARK

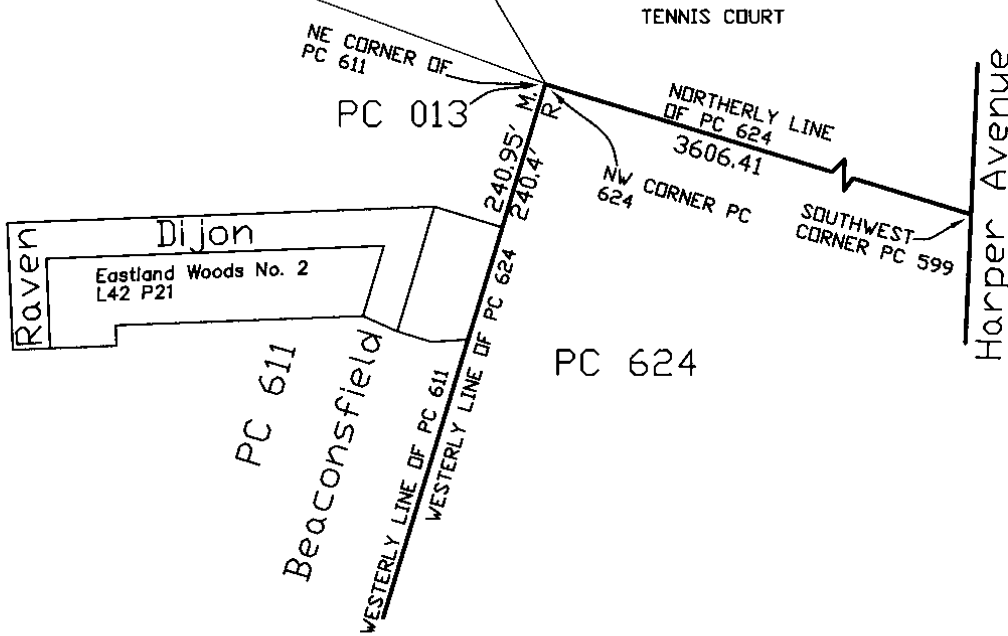

**ANDERSON, ECKSTEIN
 AND WESTRICK, INC.**
 Civil Engineers Surveyors • Architects
 51301 Schoenherr Road, Shelby Township, Michigan 48315
 Phone 586•726•1234 Fax 586•726•8780

PROJECT

**Macomb Co.
 Remon
 2009**

DATE

11/09

DRAWN BY

cpa

CHECKED BY

cpa

PROJECT NO.

223-032


SHEET No.

PC-013

233033
CPA
05-05-09

PC 013
2009 REM 04

PT
1016 20 ALCY OF FENCE OR ON LINE
1017 50 ELY OF FENCE OR, ON LINE
1018 35 ELY OF FENCE OR, ON LINE
1019 20 ELY OF FENCE
1020 ON FENCE
1021 VOID
1022 VOID
1023 ON FENCE LINE.

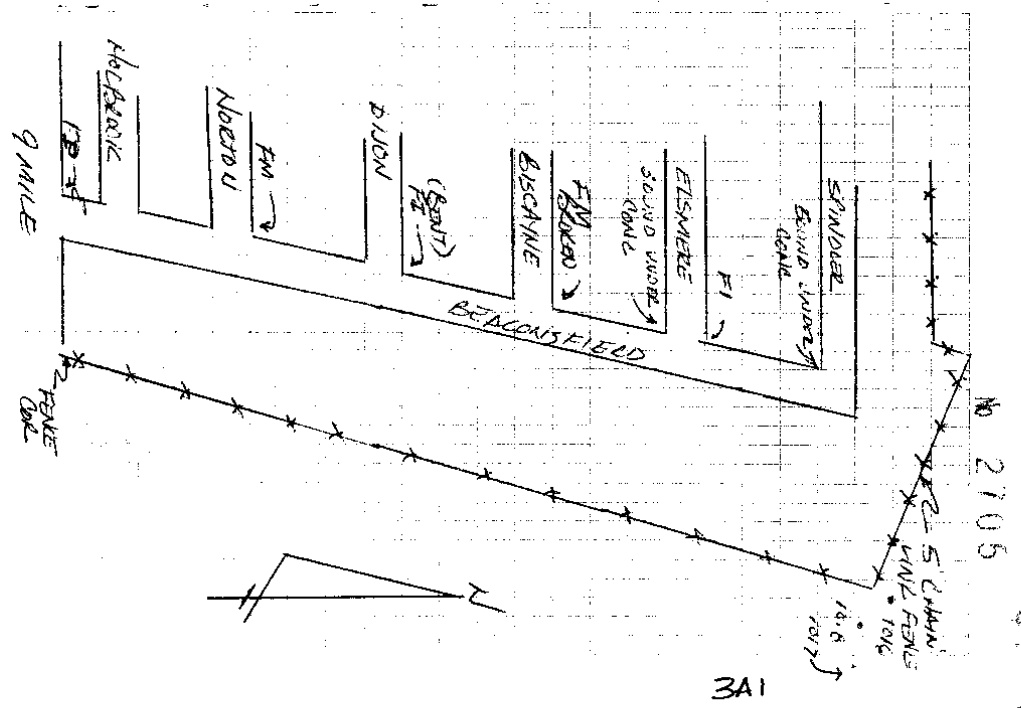

3A1

223-033
 08/24/09
 CPA MAT

PC 013
 2009 REMON


No 2105

- 100 END BENT PIPE NW COR INDUSTRIAL
- 1025 PHYSICAL @ PLEASANT ST NEAR I 94
- 1026 PHYSICAL @ PLEASANT ST NEAR INDUSTRIAL
- 1027 PHYSICAL @ PLEASANT ST
- 101 END TWO HOOROUND ROADS

- 102 NE CORNER OF BURNING AND PLEASANT
- 102 END BENT IRON ST CORNER HARMON & PLEASANT
- 103 END BENT MON LOT 4 HARMON SUB
- 1025 FENCE ON PC LINE
- 1029 FENCE ON PC LINE
- 104 TWO MON, E SIDE OF GROWS, S OF ELKINS ON P. 1 LIFE

- 1031 BEDS CORNER ON PC LINE
- 1032 BEDS CORNER ON PC LINE
- 105 REMON MON, INTERPC LINE AND 9" LINE

- 113 END PIPE @ NE COR JOHNSON SPRING
- 114 END MON @ NW COR "
- 115 END PIPE SW COR LOT 80, EASTLAND NORTH
- 1038 CHECK DISTANCE
- 116 EP
- 117 FI
- 119 REMON CAP IN MON MON, E SIDE OF GROWS S OF ELKINS

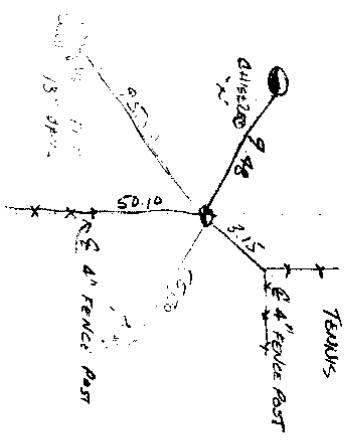

3A2

K @ 114 → 113
 114) 0°00'00"
 2) 0°00'02"
 4) 0°00'01"

115) 73°20'34"
 2) 73°20'31"
 4) 73°20'32"

1039 269-54-22 2634340
 267-54-16

N. 90.

Table of claim

Description No. 624 Confirmed to
Gaget Herible commencing at a post
standing on the border of Lake St. Clair
between this tract and a tract -
confirmed to Joseph Campbell, thence
north seventy five degrees west one
hundred and seventy eight chains six
ty six links, to a post thence north -
fifteen degrees east thirty three chains
and seventeen links, to a Black Ash
tree standing on the south west line
of a tract confirmed to the legal heirs
James Abbott, thence south seventy
five degrees east one hundred and
thirty chains, to a post standing on the
west border of Milk River, thence south
sixty nine degrees east one chain -
crosses Milk River, thence north six -
ty four degrees east two chains fifty links
along the east border of Milk River
to the Lake, thence down the border of
the Lake, south forty seven degrees East
nine chains fifty links, thence south forty
four degrees east nine chains, thence south
forty two degrees east, twenty five chains
fifty links, thence south fifty one -
degrees east eight chains, thence south
nine degrees east five chains seventy
five links, thence south thirty eight
degrees west three chains forty nine
links, to the place of beginning, con -
taining five hundred and thirty
eight acres, and twenty seven hund.
reds of an acre.

Detroit January 4. 1810

Asaon Greeley Surveyor
of private Claims.

1.34

4A2

"LAKE PARK SUBDIVISION No. 1

OF OUTLOT "A" OF LAKE PARK SUBDIVISION OF LOT MARKED DANIEL
OF THE DENNIS J. GANPAUS SUB. P.G. 624, T.1N., R.13E.
LAKE TWP. MACOMB COUNTY


Examined and Approved
Oct 16-1924
Chas. E. Harwood
Registered Civil Engineer

20058

Register's Office
Macomb County
Lake Park Subd No. 1
Filed for Record
Oct 16-1924
Chas. E. Harwood
Deputy Auditor General

MICHIGAN

SCALE: 1"=50'
ALL DIMENSIONS IN FEET AND DECIMAL THEREOF

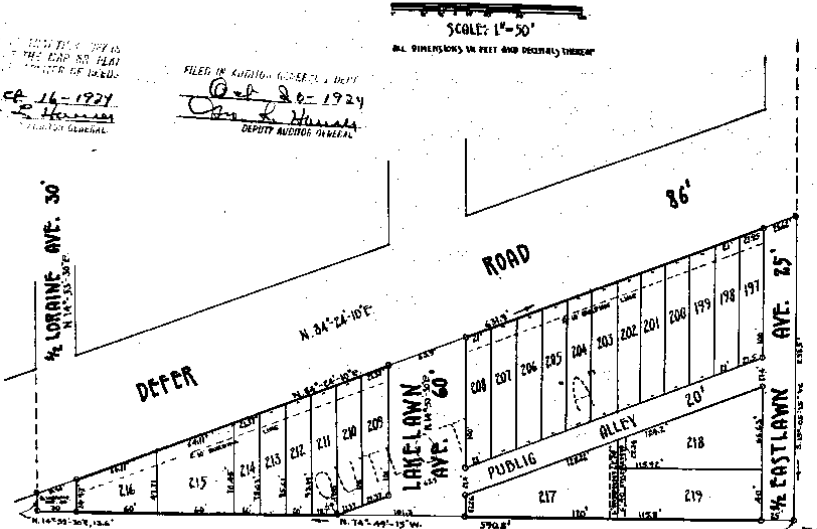

FILED IN REGISTRATION OFFICE
Oct 16-1924
Chas. E. Harwood
DEPUTY AUDITOR GENERAL

FILED IN REGISTRATION OFFICE
Oct 16-1924
Chas. E. Harwood
DEPUTY AUDITOR GENERAL

PT. OF SEC. 31 E. COR. OUTLOT "A"
200 5/8 COR. 1ST REAR CORNER

DEDICATION

KNOW ALL MEN BY THESE PRESENTS that we Bernard Aulerich, a single man, and Otto Rosenbach and Harold Rosenbach, his wife, and Oswald Kullweiss, and Paulie Kullweiss, his wife, and Adolf Wendner and Barbara Wendner, his wife, as proprietors, have caused the land embraced in the attached plat to be surveyed, laid out and divided to be known as "Lake Park Subdivision No. 1 of Outlot "A" of Lake Park Subdivision of Lot marked DANIEL of the Dennis J. Ganpaus Sub., P. G. 624, T. 1 N., R. 13 E., Lake Twp., Macomb County, Michigan, and that the streets and alleys as shown on said plat are hereby dedicated to the use of the public.

Signed and sealed in Presence of:
Bernard Aulerich (s)
Oswald Kullweiss (s)
Paulie Kullweiss (s)
Adolf Wendner (s)
Barbara Wendner (s)
Otto Rosenbach (s)

DESCRIPTION

The land embraced in the approved plat of "Lake Park Subdivision No. 1 of Outlot "A" of Lake Park Subdivision of Lot marked DANIEL of the Dennis J. Ganpaus Sub., P. G. 624, T. 1 N., R. 13 E., Lake Twp., Macomb County, Michigan, is described as follows: Beginning at the S. E. corner of Outlot "A" of Lake Park Subdivision of Lot marked DANIEL of the Dennis J. Ganpaus Sub., P. G. 624, T. 1 N., R. 13 E., Lake Twp., Macomb County, Michigan, said point being also the S. E. corner of said lot marked DANIEL of the said Dennis J. Ganpaus Sub., P. G. 624, T. 1 N., R. 13 E., 200 5/8 ft.; thence N. 74° 25' - 30" E. 132.5 ft.; thence N. 84° 24' - 10" E., 211.5 ft.; thence S. 12° 05' - 15" W., 227.5 ft., to the point of beginning.

SURVEYOR'S CERTIFICATE

I hereby certify that the plat herein delineated is a correct and true and correct representation of the land as shown on all angles in the boundaries of the land platted and at all intersections of streets or streets and alleys.

Chas. E. Harwood
Registered Civil Engineer

TOWNSHIP APPROVAL

This plat was approved by the Township Board of Lake Township, Macomb County, Michigan at a meeting held Oct. 16, 1924.

Chas. E. Harwood
Township Clerk

STATE OF MICHIGAN
County of Wayne

On this 17th day of Oct. 1924 before me a Notary Public in and for said county personally came the above named Bernard Aulerich, a single man, and Otto Rosenbach and Harold Rosenbach, his wife, and Oswald Kullweiss and Paulie Kullweiss, his wife and Adolf Wendner and Barbara Wendner, his wife, known to me to be the persons who executed the above dedication and acknowledged the same to be their free act and deed.

Notary Public, Wayne County, Michigan

My commission expires July 1, 1928

COUNTY TREASURER'S CERTIFICATE
This is to certify that the above plat was duly recorded in the office of the County Treasurer of Macomb County, Michigan, on the 15th day of October, 1924, at 11:15 A.M. and that the same is a correct and true copy of the original as filed for record.

This plat was approved by the County Board No. 10012
County Board, at a meeting held Oct. 15, 1924

Chas. E. Harwood
County Clerk


HARPER-DEFER SUBDIVISION

LAKE TWP PART OF P.C. 624 T1N R13E MACOMB CO. MICHIGAN

SCALE 1" = 100'

W. J. LEHNER REG. C.E.
MOUNT CLEMENS MICH.

July 23-1925
W. J. R. HANNAH

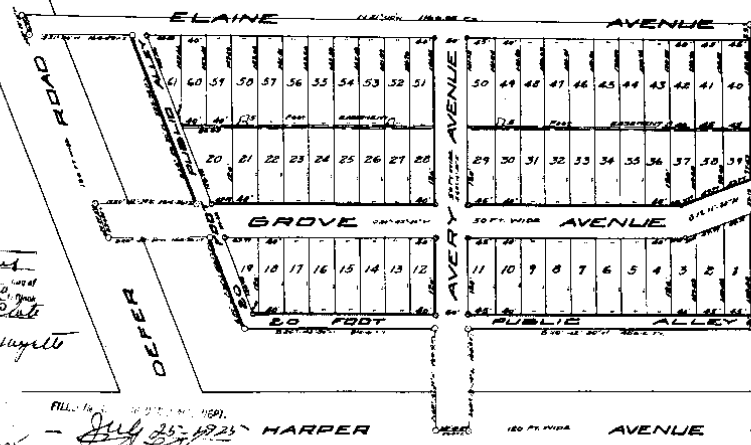

Macomb
Harper Defer Sub
July 23-1925
W. J. R. Hannah

July 23-1925
W. J. R. Hannah

KNOW ALL MEN BY THESE PRESENTS, That Herman Engelhardt, Jr., Lillian Engelhardt, his wife, Sophia Bass, and Emma Engel as owners of legal title, and William R. Hudson, Lilyan Sara Hudson, his wife, Edward K. Munro, and Lorena Munro, his wife, as owners under land contract, have caused the land embraced in the annexed plat to be surveyed, laid out, and platted, to be known as HARPER-DEFER SUBDIVISION, a part of P. C. 624 T1N R13E, Lake Twp., Macomb County, Michigan, and that the streets and alleys as shown on said plat are hereby dedicated to the use of the public.

Description of Land Platted
The Land embraced in the annexed Plat of "HARPER-DEFER SUBDIVISION", a part of P. C. 624, T1N R13E, Lake Twp., Macomb County, Michigan, is described as follows:

Beginning at a point 160.0 ft. E. 69°12'30" W. of the intersection of the N. line of P. C. 624 and the center line of Harper Ave. thence S. 20°42'30" W. a distance of 485.0 ft., thence S. 69°12'30" E. a distance of 160.0 ft., thence S. 20°42'30" W. a distance of 50.0 ft., thence N. 89°12'30" E. a distance of 160.0 ft., thence S. 20°42'30" W. a distance of 310.6 ft., thence S. 69°29'30" W. a distance of 160.17 ft., thence S. 20°42'30" E. a distance of 164.36 ft., thence S. 89°29'30" W. a distance of 55.63 ft., thence S. 20°42'30" E. a distance of 164.36 ft., thence S. 69°29'30" W. a distance of 283.30 ft., thence S. 21°0' W. a distance of 164.49 ft., thence S. 89°29'30" W. a distance of 26.87 ft., thence N. 21°0' E. a distance of 166.19 ft., thence S. 69°12'30" E. a distance of 472.88 ft., to the point of beginning.

This is to certify that the above plat was approved by the Township Board of the Township of Lake Macomb County, Michigan, at a meeting held this 9. day of, APRIL, 1925.

Otto C. E. Weber Township Clerk

- | | | |
|--------------------------------------|------------------------|-------|
| Signed and sealed in the presence of | Herman Engelhardt, Jr. | L. S. |
| | Lillian Engelhardt | S. E. |
| | Sophia Bass | L. S. |
| Paul M. Schilling | her | |
| | Emma Engel | L. S. |
| Catherine Agnes Hurley | William R. Hudson | L. S. |
| | Lilyan Sara Hudson | L. S. |
| | Edward K. Munro | L. S. |
| | Lorena Munro | L. S. |

STATE OF MICHIGAN
S. S.
County of Wayne

On this 13. day of June, 1925, before me, a Notary Public in and for said County, personally came the above named William R. Hudson, Lilyan Sara Hudson, his wife, Edward K. Munro, and Lorena Munro, his wife, known to me to be the persons who executed the above dedication, and acknowledged the same to be their free act and deed.

Catherine Agnes Hurley
Notary Public, Wayne Co., Mich.
My Commission Expires February 24, 1929

I hereby certify that the plat hereon delineated is a correct one and that permanent monuments consisting of 1/2 x 1/8 inch iron stakes have been planted at points marked "o" as thereon shown at all angles in the boundaries of the land platted and at all intersections of streets or streets and alleys.

WALTER J. BUCKNER
Registered Civil Engineer

STATE OF MICHIGAN
S. S.
County of Wayne

On this 13. day of June, 1925, before me, a Notary Public in and for said County, personally came the above named Herman Engelhardt, Lillian Engelhardt, his wife, Sophia Bass, and Emma Engel, known to me to be the persons who executed the above dedication, and acknowledged the same to be their free act and deed.

Catherine Agnes Hurley
Notary Public, Wayne Co., Mich.
My Commission Expires February 24, 1929

This plat was approved by the Township Board of Lake Macomb County, Michigan, at a meeting held this 9. day of, APRIL, 1925.
W. J. R. Hannah
County Clerk

MAY 18 1955

36313


"EASTLAND WOODS SUBDIVISION"

PART OF THE S.W. 1/4 OF SEC. 28 T. 1 N. R. 13 E.
CITY OF EAST DETROIT MACOMB CO. MICH.

SCALE: 1" = 100'

NOTE: ALL MEASUREMENTS ARE IN FEET AND DECIMALS THEREOF

HARRY J. FULLER
REGISTERED CIVIL ENGINEER
MT. CLEMENS, MICH.

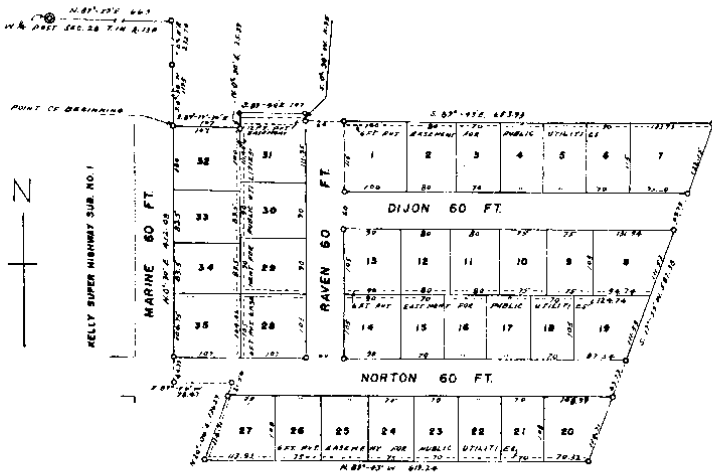

CONTRACT NO. 100-
PLAT NO. 100-
DATE OF RECORDING
BY
RECORDING OFFICE
COUNTY OF MACOMB, MICHIGAN

DEDICATION

KNOW ALL MEN BY THESE PRESENTS, that we James Karros and Ruth Karros, his wife, and Corinne Walker, and Mathew Mayer and Elizabeth Mayer, his wife, and Oliver C. Bokes, a single man, and JOSEPH F. BUFFA INC., a Michigan corporation by Joseph F. Buffa, President and Julia Buffa, Secretary as proprietors have caused the land embraced in the annexed plat to be surveyed, laid out and platted to be known as "EASTLAND WOODS SUBDIVISION" part of the S. W. 1/4 of Sec. 28 T. 1 N. R. 13 E., City of East Detroit, Macomb Co., Michigan and that the streets as shown on said plat are hereby dedicated to the use of the public and that the easements as shown on said plat are hereby reserved for the use of public utilities and no permanent structures are to be erected within the lines of said easements. Regulation of the use thereof is vested in the local governmental authority.

DESCRIPTION OF LAND PLATTED

The land embraced in the annexed plat of "EASTLAND WOODS SUBDIVISION" part of the S.W. 1/4 of Sec. 28 T. 1 N. R. 13 E., City of East Detroit, Macomb Co., Michigan is described as follows:

Commencing at the W. 1/4 post Sec. 28 T. 1 N. R. 13 E., thence N. 89° 30' E. 663 feet, thence S. 0° 11' E. 232.70 feet, thence S. 0° 30' E. 1195 feet to the point of beginning, thence S. 89° 17' 30" E. 107 feet, thence N. 0° 30' E. 25.34 feet, thence S. 89° 47' E. 107 feet, thence S. 0° 30' E. 11.35 feet, thence S. 89° 47' E. 693.97 feet, thence S. 89° 47' E. 507.38 feet, thence N. 89° 47' E. 615.66 feet, thence N. 20° 00' E. 135.27 feet, thence S. 89° 50' E. 98.47 feet, thence N. 0° 30' E. 47.78 feet to the point of beginning.

SURVEYOR'S CERTIFICATE

I hereby certify that the plat hereon delineated is a correct one and that permanent metal monuments consisting of bars not less than one-half inch in diameter and thirty six inches in length encased in a concrete cylinder at least 4 inches in diameter and thirty six inches in depth have been placed at points marked thus (o) as thereon shown at all angles in the boundaries of the land platted, at all the intersections of the streets, intersections of alleys, or of streets and alleys, and at the intersections of streets and alleys with the boundaries of the plat as shown on said plat.

HARRY J. FULLER, Registered Land Surveyor

CERTIFICATE OF MUNICIPAL APPROVAL

This plat was approved by the City Council of the City of East Detroit of Macomb County, Michigan at a meeting held on the 12th day of May, 1955.

CERTIFICATE OF APPROVAL BY COUNTY BOARD

This plat was approved on the 5th day of May, 1955.

ALBERT WALKER (County Register of Deeds)
ALBERT WALKER (County Clerk)
JOHN J. HARRIS (County Treasurer)
FRANK BISHOP (County Drain Commissioner)

Signed and sealed in the presence of:

James Karros
Ruth Karros
Corinne Walker
Mathew Mayer
Oliver C. Bokes
Joseph F. Buffa, Inc.
Joseph F. Buffa, President
Julia Buffa, Secretary
Elizabeth Mayer

ACKNOWLEDGMENT

STATE OF MICHIGAN ss.
County of Macomb ss.

On this 28th day of APRIL A. D. 1955 before me a Notary Public in and for said County appeared James Karros and Ruth Karros, his wife, and Corinne Walker and Mathew Mayer and Elizabeth Mayer, his wife, and Oliver C. Bokes, a single man, known to me to be the persons who executed the above dedication and acknowledged the same to be their free act and deed.

My commission expires Apr. 7, 1956

STATE OF MICHIGAN ss.
County of Macomb ss.

On this 28th day of APRIL A. D. 1955 before me a Notary Public in and for said County appeared Joseph F. Buffa and Julia Buffa to me personally known, who being each by me duly sworn did say that they are the President and Secretary respectively of the Joseph F. Buffa Inc., a Michigan corporation, and that the seal affixed to said instrument is the corporate seal of said corporation, and that said instrument was signed and sealed in behalf of said corporation by authority of its Board of Directors and the said Joseph F. Buffa and Julia Buffa acknowledged said instrument to be the free act and deed of said corporation.

My commission expires 4-7-56

Notary Public WAYNE Co., Mich.

FILED IN BOOK 100-100-100
MAY 18 1955
ALBERT WALKER
COUNTY CLERK
COUNTY OF MACOMB, MICHIGAN

41022

"EASTLAND WOODS SUBD'N. NO.2"
PART OF THE S.W. 1/4 OF SEC. 28 T.1N.R.13 E.
CITY OF EAST DETROIT MACOMB CO. MICH.



SCALE: 1" = 100'



NOTE: ALL MEASUREMENTS ARE IN FEET AND DECIMALS THEREOF.

HARRY J. FULLER
REGISTERED LAND SURVEYOR
MT. CLEMENS MICH.

NEW COR. REC. 628 21/11/18

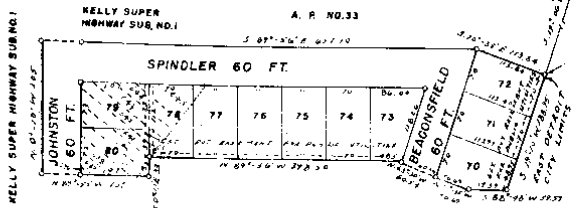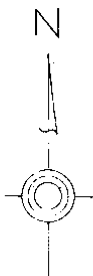

DEDICATION

KNOW ALL MEN BY THESE PRESENTS, that we James Karros and Ruth Karros, his wife and George A. Beauchamp and Lloyd H. Beauchamp, his wife and Irene M. Martone, have caused the land embraced in the annexed plat to be surveyed, laid out and platted to be known as "EASTLAND WOODS SUBD'N. NO. 2", part of the S. W. 1/4 of Section 28, T. 1 N. R. 13 E., City of East Detroit, Macomb County, Michigan, and that the streets as shown on said plat are hereby dedicated to the use of the public and that the easements as shown on said plat are hereby reserved for the use of public utilities and no permanent structures are to be erected within the lines of said easements. Regulation of the use thereof is vested in the local governmental authority.

Signed and Sealed in the presence of:

Paul C. Leach, Notary Public
James Karros, Ruth Karros, George A. Beauchamp, Lloyd H. Beauchamp, Irene M. Martone

DESCRIPTION OF LAND PLATTED

The land embraced in the annexed plat of "EASTLAND WOODS SUBD'N. NO. 2", part of the S. W. 1/4 of Section 28, T. 1 N. R. 13 E., and a replat of all of vacated Lots 640 to 645 inclusive and part of vacated Lots 636 to 639 inclusive and vacated Division Avenue of Kelly Super Highway Subdivision No. 1 and other land, all a part of Section 28, T. 1 N. R. 13 E., City of East Detroit, Macomb County, Michigan, is described as follows:

Commencing at the N. E. corner of P. C. 624, T. 1 N. R. 13 E.; thence S19°-05' E. 240.4 feet to the point of beginning; thence S19°-10' E. 186.95 feet; thence S22°-48' W. 55.53 feet; thence X70°-35' W. 56.59 feet; thence S63°-30' W. 60.54 feet; thence S65°-55' W. 306.50 feet; thence S10°-12' E. 73 feet; thence S29°-55' W. 127 feet; thence S0°-10' W. 205 feet; thence S63°-30' W. 567.90 feet; thence S70°-35' W. 113.34 feet to the point of beginning, consisting of Lots 70 to 80 inclusive, numbering 11 Lots.

SURVEYOR'S CERTIFICATE

I hereby certify that the plat hereto delineated is a correct one and that permanent metal monuments consisting of bars of not less than one-half inch in diameter and thirty-six inches in length encased in a concrete cylinder at least 4 inches in diameter and thirty-six inches in depth have been placed at points marked thus (o) as thereon shown at all angles in the boundaries of the land platted, at all intersections of the streets, intersections of alleys, or of street and alleys, and at the intersections of streets and alleys with the boundaries of the plat as shown on said plat.

Harry J. Fuller, Reg. Land Surveyor

CERTIFICATE OF MUNICIPAL APPROVAL

This plat was approved by the City Council of the City of East Detroit of Macomb County, Michigan, at a meeting held January 20, 1958. All public sewage and water facilities are installed and ready for connection.

Charles Beauchamp, Clerk

CERTIFICATE OF APPROVAL BY COUNTY BOARD

This plat was approved on the 14th day of February, 1958.

Alphon Barr, County Register of Deeds

Alphon Barr, County Clerk

Lloyd Shelton, County Treasurer

STATE OF MICHIGAN
COUNTY OF MACOMB

On this 14th day of February, A.D. 1958, before me a Notary Public in and for said County appeared James Karros and Ruth Karros, his wife, and George A. Beauchamp and Lloyd H. Beauchamp, his wife, and Irene M. Martone, known to me to be the persons who executed the above dedication and acknowledged the same to be their free act and deed.

Robert Redmond, Notary Public

My Commission expires February 10, 1962

COPY

Notary's Office
Notary Public
Notary Seal

THIS IS TO CERTIFY THAT ACCORDING TO THE COUNTY TREASURER'S RECORDS THERE ARE NO TAX LIENS ON THE PROPERTY AND THAT THIS IS THE ONLY FILED RECORD FOR THIS PROPERTY EXCEPT AS NOTED



FILED IN THE OFFICE OF THE COUNTY REGISTER OF DEEDS
MICHIGAN
COUNTY OF MACOMB

"EASTLAND WOODS SUBD'N. NO. 3"
PART OF THE S.W. 1/4 OF SEC. 28 T. 1 N. R. 13 E.
CITY OF EAST DETROIT MACOMB CO. MICH.

SCALE: 1" = 100'

NOTE: ALL MEASUREMENTS ARE IN FEET AND DECIMALS THEREOF.

HARRY J. FULLER
REGISTERED LAND SURVEYOR
MT. CLEMENS MICH.

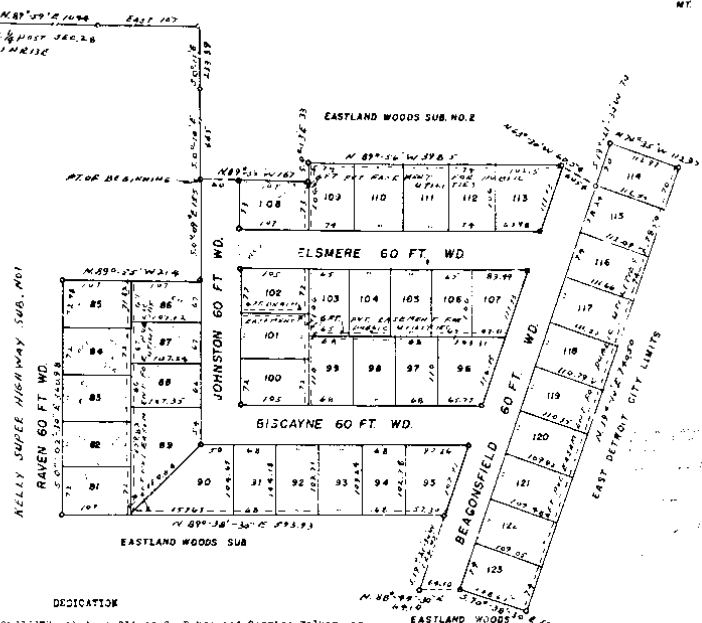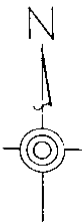

DEDICATION

KNOW ALL MEN BY THESE PRESENTS, that we Oliver C. Boksa and Corinne Walker, as joint tenants with full right of survivorship and not as tenants in common, and James Karros and Ruth Karros, his wife and George A. Beauchamp and Lloyd H. Beauchamp, his wife and Irene M. Martone and Kitchen Bros. Builders Michigan Corporation by James Ronald D. Kitchen and Walter B. Kitchen as proprietors have caused the land embraced in the annexed plat to be surveyed, laid out and platted to be known as "EASTLAND WOODS SUBD'N. NO. 3", part of the S. W. 1/4 of Section 28 T. 1 N. R. 13 E., City of East Detroit, Macomb County, Michigan and that the streets as shown on said plat are hereby dedicated to the use of the public and that the easements as shown on said plat are hereby reserved for the lines of said easements. Regulation of the use thereof is vested in the local governmental authority.

Signed and Sealed in the presence of:
Oliver C. Boksa
Corinne Walker
James Karros
Ruth Karros
George A. Beauchamp
Lloyd H. Beauchamp
Irene M. Martone

DESCRIPTION OF LAND PLATTED

The land embraced in the annexed plat of "EASTLAND WOODS SUBD'N. NO. 3" of part of the S. W. 1/4 of Section 28 T. 1 N. R. 13 E., and a replat of Lot 70 of Eastland Woods Subd'n No. 2, and a replat of part of vacated Lots 550 to 559 inclusive, and all of vacated Lots 599 to 611 and vacated alley along with vacated Division Avenue of Kelly Super Highway Subd'n No. 1 and other land all a part of Section 28 T. 1 N. R. 13 E. City of East Detroit, Macomb County, Michigan is described as follows:

Commencing at the 1/4 post of Sec. 28 T. 1 N. R. 13 E.; thence N. 89° 59' E. 1084 feet; thence East 107 feet; thence S. 0° 11' E. 231.39 feet; thence S. 0° 09' E. 155 feet; thence N. 89° 55' W. 214 feet; thence S. 0° 02' 30" E. 360.98 feet; thence N. 89° 38' 30" E. 593.93 feet; thence S. 10° 21' 30" W. 126.05 feet; thence N. 88° 44' 30" E. 64.10 feet; thence S. 70° 34' 30" E. 105.62 feet; thence N. 19° 10' E. 740.50 feet; thence N. 70° 35' N. 112.97 feet; thence S. 19° 21' 30" W. 70 feet; thence N. 03° 30' E. 60.58 feet; thence N. 89° 55' W. 396.5 feet; thence S. 0° 13' E. 53 feet; thence N. 89° 55' W. 167 feet to the point of beginning.

SURVEYOR'S CERTIFICATE

I hereby certify that the plat hereon delineated is a correct one and that permanent metal monuments consisting of bars of not less than one-half inch in diameter and thirty-six inches in length encased in a concrete cylinder at least 4 inches in diameter and thirty-six inches in depth have been placed at points marked thus (a) as thereon shown at all angles in the boundaries of the land platted, at all intersections of the streets, intersections of alleys, or of street and alleys, and at the intersections of streets and alleys with the boundaries of the plat as shown on said plat.

Harry J. Fuller
Harry J. Fuller, Reg. Land Surveyor

CERTIFICATE OF MUNICIPAL APPROVAL

This plat was approved by the City Council of the City of East Detroit of Macomb County, Michigan, at a meeting held on the 15th day of August, 1959. All public sewage and water facilities are installed and ready for connection.

Charles Beaudoin
Charles Beaudoin, Clerk

CERTIFICATE OF APPROVAL BY COUNTY BOARD

This plat was approved on the 15th day of August, 1959.

Albert Sumner, County Clerk
Frank Lohr, County Drain Commissioner
Lynd L. Allen, County Treasurer

ACKNOWLEDGEMENT
STATE OF MICHIGAN)
COUNTY OF MACOMB) ss

On this 10th day of August, AD., 1959 before me a Notary Public in and for said County personally came the above named Kitchen Bros. Builders, a Michigan Corporation by owners Ronald D. Kitchen and Walter B. Kitchen, Oliver C. Boksa and partnership by owners Ronald D. Kitchen and Walter B. Kitchen, James Karros and Corinne Walker and James Karros and Ruth Karros, his wife, and George A. Beauchamp and Lloyd H. Beauchamp, his wife, and Irene M. Martone, known to me to be the persons who executed the above dedication and acknowledged the same to be their free act and deed.


Notary Public John W. Smith, Esq., Michigan
John W. Smith

By Commission expires April 26, 1962

"BOCK FARMS URBAN RENEWAL PLAT

OF PARTS OF P.C. 624 & SE 1/4 OF SEC. 28, T14, R13E,
CITY OF ST. CLAIR SHORES, MACOMB COUNTY, MICHIGAN "


SAMUEL A. WALKER, JR.
REGISTERED SURVEYOR
MICHIGAN

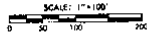

ALL DIMENSIONS ARE IN FEET & DECIMALS THEREOF.
LOT DIMENSIONS ON CURVES ARE MEASURED ALONG ARC.

645043

This plat was approved by the Macomb County Plat Board on this 14th day of August, 1963.
Carroll Burt
Carroll Burt, Register of Deeds
Arthur J. Miller
Arthur J. Miller, County Clerk
Thomas S. Walsh
Thomas S. Walsh, County Treasurer
Thomas S. Walsh
Thomas S. Walsh, Drain Commissioner

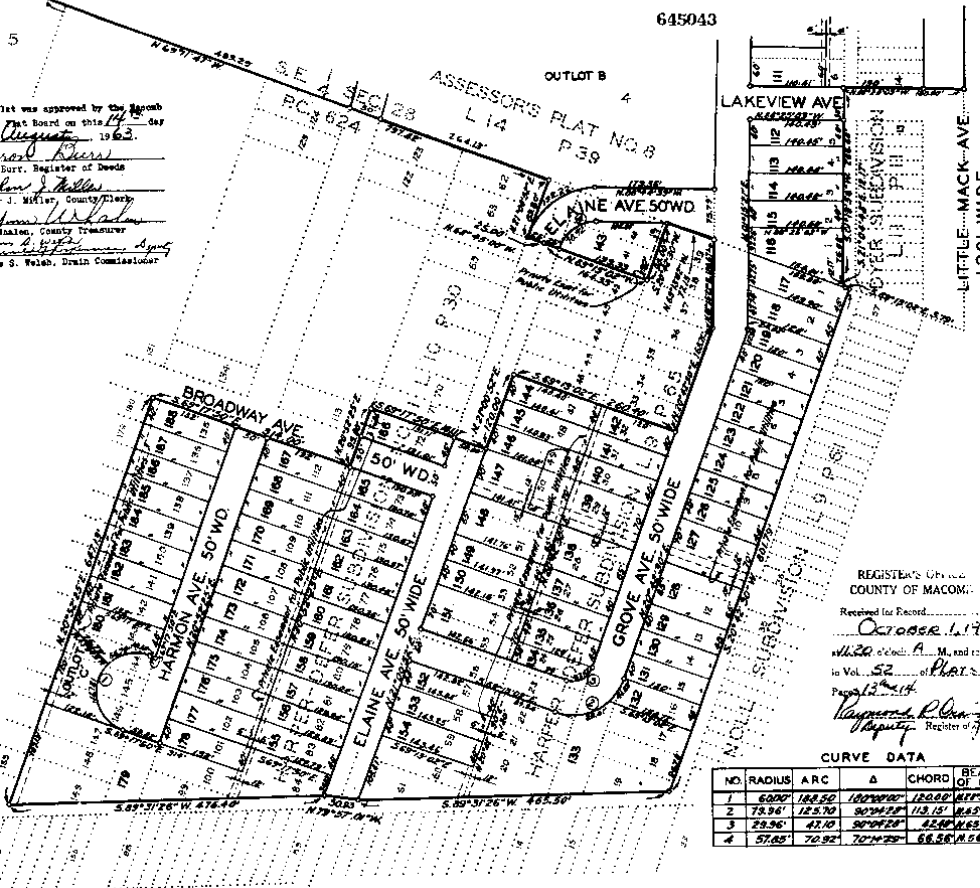

REGISTER'S OFFICE
COUNTY OF MACOMB
Received for Record
OCTOBER 1, 1963
Vol. 52 of PLATS on Page 12-14
Raymond R. ...
Register of Deeds

NO.	RADIUS	ARC	Δ	CHORD	BEARING OF CHORD
1	600'	188.50'	102°00'	1200'	N100°00'00"E
2	75.96'	12.570'	90°00'	113.15'	N85°00'00"E
3	28.96'	47.10'	90°00'	52.00'	N85°00'00"E
4	57.02'	70.92'	70°00'	66.58'	N66°00'00"E

See subdivision of 645043
in subdivision file 173 page 516
See subdivision of 645043
in subdivision file 173 page 516
See subdivision of 645043
in subdivision file 173 page 516

DEDICATION

KNOW ALL MEN BY THESE PRESENTS, that we, Eugene J. Ellison, Mayor for the City of St. Clair Shores, and Richard Garono, Director of Urban Renewal for Macomb County, Michigan, State of Michigan, by virtue of authority in us vested by Section 5A of Act 344, of the Public Acts of 1945, having been duly authorized by the City Council of the City of St. Clair Shores, have caused the land described in the annexed Plat to be surveyed, laid out and platted, to be known as "Bock Farms Urban Renewal Plat of parts of P.C. 624 & SE 1/4 of Sec. 28, T14, R13E, Macomb County, Michigan; that title to the streets, alleys, and public places shown on said Plat are hereby reserved for the use of the Public Utilities, and that no permanent structures are to be erected within the boundaries of said easements.

WITNESSES:
Francis J. Kelly
Francis J. Kelly
Richard Garono
Richard Garono, Director of Urban Renewal
Eugene J. Ellison
Eugene J. Ellison, Mayor
Leita M. Foust
Leita M. Foust

EXAMINED AND APPROVED

Billie S. Fairman
Billie S. Fairman
Notary Public
Richard B. ...
Richard B. ...

Approved By

City of St. Clair Shores
Planning Commission
July 1, 1963
George C. Stodolka
George C. Stodolka
Kenneth E. Mason
Kenneth E. Mason

ACKNOWLEDGMENT

STATE OF MICHIGAN)
COUNTY OF MACOMB) ss.
On this 26 day of July, A.D. 1963, before me a Notary Public in and for said County, personally came the above named Eugene J. Ellison, Mayor of the City of St. Clair Shores, and Richard Garono, Director of Urban Renewal for the City of St. Clair Shores, and acknowledged to me to be the persons who executed the above dedication, and acknowledged the same to be their free act and deed as City Mayor and City Director of Urban Renewal respectively.
Leita M. Foust
Notary Public, in and for Macomb County, Michigan
My Commission expires January 27, 1964
LEITA M. FOUST

DEDICATION

KNOW ALL MEN BY THESE PRESENTS, that we, Oscar Frasco as proprietor, and Lillian Frasco his wife, have caused the land described in the annexed Plat to be surveyed, laid out and platted, to be known as "Bock Farms Urban Renewal Plat of parts of P.C. 624 & SE 1/4 of Sec. 28, T14, R13E, Macomb County, Michigan; that title to the streets, alleys, and public places shown on said Plat are hereby reserved for the use of the Public Utilities, and that no permanent structures are to be erected within the boundaries of said easements.

WITNESSES:
Dolores M. Coyne
Dolores M. Coyne
Robert M. Frasco
Robert M. Frasco
Oscar Frasco
Oscar Frasco
Lillian Frasco
Lillian Frasco

ACKNOWLEDGMENT

STATE OF MICHIGAN)
COUNTY OF MACOMB) ss.
On this 26 day of July, A.D. 1963, before me a Notary Public in and for said County, personally came the above named Oscar Frasco, and Lillian Frasco, known to me to be the persons who executed the above dedication, and acknowledged the same to be their free act and deed.
Dolores M. Coyne
Notary Public, in and for Macomb County, Michigan
My Commission expires FEB. 14, 1962
DOLORES M. COYNE

"FREEWAY INDUSTRIAL URBAN RENEWAL PLAT

OF PART OF PC. 624, T1N, R13E,
CITY OF ST. CLAIR SHORES, MACOMB COUNTY, MICHIGAN"

793072

N.W. Corner
PC 624
S 60° N 47' E 468.08'

Point of Beginning
PLEASANT AVENUE 50 FT W.D.
S 89° 26' 47" E 1107.15'

ALL DIMENSIONS ARE IN FEET & DECIMALS THEREOF
LOT DIMENSIONS ON CURVES ARE MEASURED ALONG ARC.

SCALE 1"=100'




SAMUEL A. WALKER, JR.
PROFESSIONAL SURVEYOR
MICHIGAN, 1963

REGISTER'S OFFICE
COUNTY OF MACOMB

Received for Record
May 24, 1966
in Book A
in Vol. 56 of PLATS
By *Raymond R. Davis*
Register of Deeds

INTERSTATE FREEWAY I-94
NO DIRECT INTERFERENCE WITH SERVICE PERMITTED

L. 56 P. 43

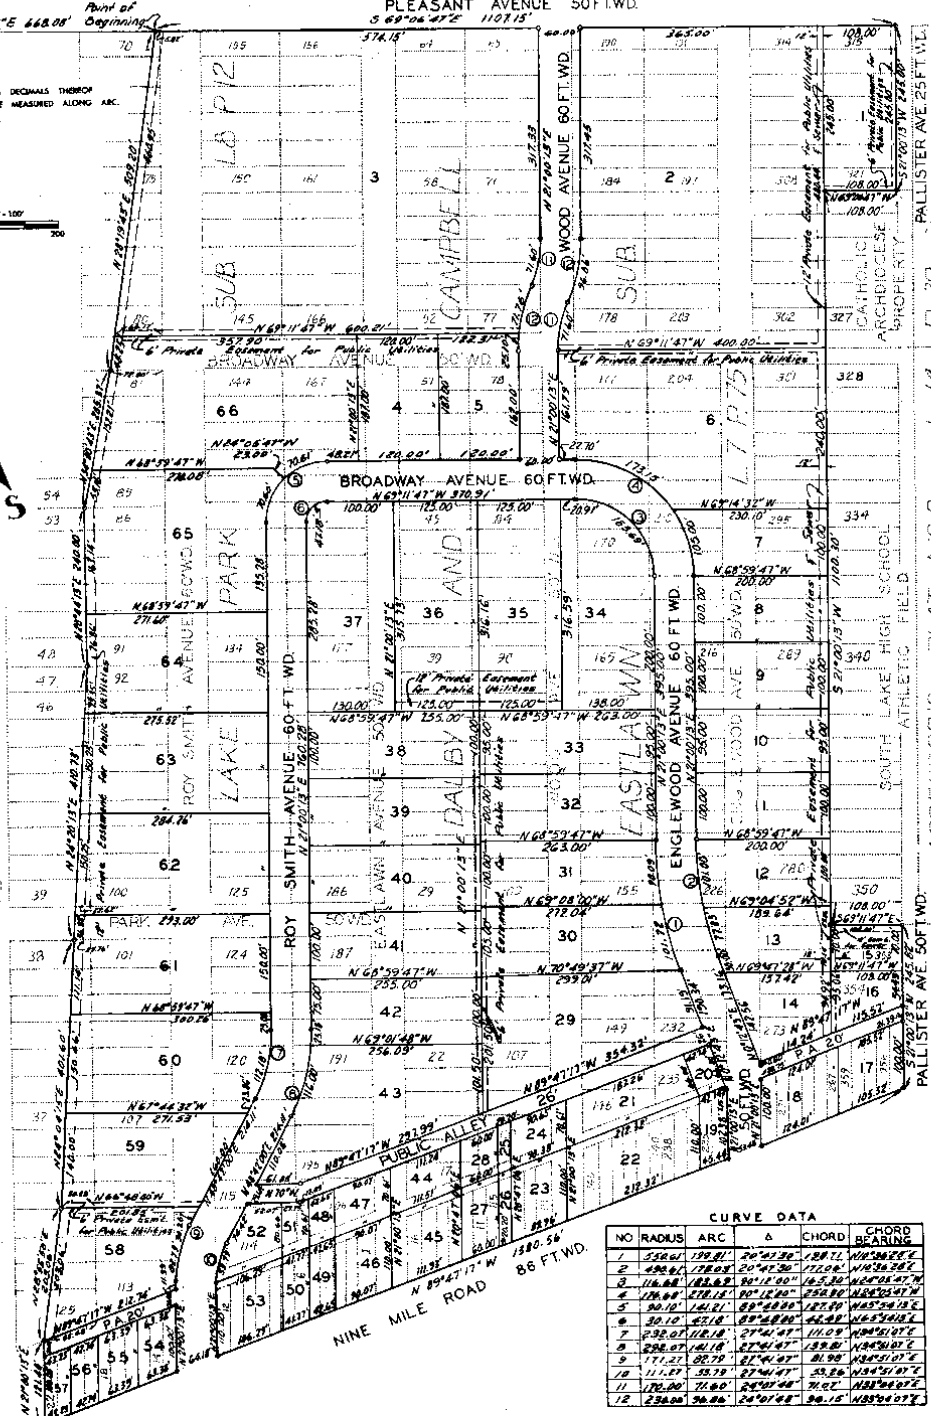

CURVE DATA

NO	RADIUS	ARC	Δ	CHORD	CHORD BEARING
1	350.00	178.81	20° 02' 30"	120.71	N 89° 57' 30" E
2	450.00	225.00	26° 33' 54"	157.88	N 89° 57' 30" E
3	1100.00	550.00	28° 11' 00"	365.80	N 89° 57' 30" E
4	1200.00	600.00	28° 45' 00"	391.75	N 89° 57' 30" E
5	20.10	141.81	89° 58' 00"	127.89	N 89° 57' 30" E
6	20.10	141.81	89° 58' 00"	127.89	N 89° 57' 30" E
7	20.10	141.81	89° 58' 00"	127.89	N 89° 57' 30" E
8	20.10	141.81	89° 58' 00"	127.89	N 89° 57' 30" E
9	111.21	82.20	87° 04' 47"	61.98	N 89° 57' 30" E
10	111.21	82.20	87° 04' 47"	61.98	N 89° 57' 30" E
11	170.00	71.60	24° 07' 00"	31.07	N 89° 57' 30" E
12	230.00	96.86	24° 07' 00"	39.15	N 89° 57' 30" E

Vertical text on the right side of the map: PALLISTER AVE 25 FT W.D., PALLISTER AVE 50 FT W.D., SOUTH LAKE HIGH SCHOOL ATHLETIC FIELD, EASTLAKE AVE 50 FT W.D., ENGLEWOOD AVENUE 60 FT W.D., BROADWAY AVENUE 60 FT W.D., PARK AVENUE 60 FT W.D., ROY SMITH AVENUE 60 FT W.D., NINE MILE ROAD 86 FT W.D., L. 56 P. 43, ASSESSOR'S PLAT NO. 63

Original

SHEET 2 OF 2

"FREEWAY INDUSTRIAL URBAN RENEWAL PLAT OF PART OF P.C. 624, T.1N. R.13E, CITY OF ST. CLAIR SHORES, MACOMB COUNTY, MICHIGAN"

739072

The land embraced in the annexed plat of "Freeway Industrial Urban Renewal Plat of part of P. C. 624, T.1N. R.13E, City of St. Clair Shores, Macomb County, Michigan", being a replat of Lots 1 through 22, parts of Lots 23 through 47, parts of Lots 70 through 85, all of Lots 86 through 186 of Lake Park Subdivision recorded in Liber 8, Page 12 of Plate, Lots 11 through 115, Lots 140 through 238, Lots 267 through 341, Lots 392 through 399, all inclusive, of Holly and Campbell Eastlines Subdivisions, recorded in Liber 7, Page 75, of Plate, is described as follows: Commencing at the N. W. corner of P. C. 624, th along Private Clark line S 69°06'47" E, 666.00' to point of beginning; th along the South line of Pleasant Avenue S 69°06'47" E, 1107.15' to the N. E. corner of Lot 315, Holly and Campbell Eastlines Subdivisions, recorded in Liber 7, Page 75, th along line of Lots 315 through 321 of said Holly and Campbell Eastlines Subdivisions, S 21°00'13" N, 240.00' to the N. E. corner of Lot 321; th along South line of said lot, S 69°06'47" N, 108.00' to the S. W. corner of said Lot 321, which is the N. E. corner of Lot 307 of said Subdivisions; th along the Southeastery line of Lots 278 through 307, S 21°00'13" N, 1100.20' to the S. W. corner of Lot 278, which is the S. W. corner of Lot 352, said Holly and Campbell Eastlines Subdivisions; th along the North line of said Lot 352, S 69°11'47" E, 108.00' to the Westerly line of Pallister Avenue; th along this line S 21°00'13" N, 245.82' to the Northerly line of Nine Mile Road; th along this line S 89°47'17" N, 1380.36' to the Southeastery corner of Lot 22, Lake Park Subdivision, recorded in Liber 8, Page 12, of Plate, th along the Westerly line of said Lot 22, S 21°00'13" N, 121.40' to a point in the Southeastery line of Lot 23, said Subdivisions, which is S 89°47'17" N, 85.40' from the Southeastery corner of said Lot 23, th across Lots 23 through 28, S 28°23'50" E, 203.06' to a point on the Northerly line of Lot 28, which is Northwesterly 30.88' from its Northwesterly corner; th across Lots 29 through 38, S 24°04'15" E, 401.60' to a point on the Northerly line of Lot 38, which is 25.76' Northwesterly from its Northwesterly corner; th across vacant Park Avenue and through a point on its Northerly line which is 22.62' Northwesterly from the Southeastery corner of Lot 39, and across Lots 39 through 47 of said Subdivisions, S 24°20'13" N, 410.73' to the Northwesterly corner of Lot 47, which is the Southeastery corner of Lot 81, th along the Westerly line of Lots 86 through 91 of said Subdivisions, S 80°46'13" E, 240.00' to the Northwesterly corner of Lot 85, which is the Southeastery corner of Lot 85, th across Lots 81 through 85 of said Subdivisions, S 21°00'13" N, 1140.20' to a point on the Northerly line of Lot 81, 72.80' Northwesterly from its Northwesterly corner, th across vacant Broadway Avenue and through a point on its Northerly line 66.17' Northwesterly from the Northwesterly corner of Lot 80, and across Lots 70 through 80 of said Subdivisions, S 28°19'43" N, 509.80' to the point of beginning on the Northerly line of Pleasant Avenue, which is the Northerly line of Lot 70, and which point line 5.82' Northwesterly from the Northwesterly corner of said Lot 70, comprising Lots 1 through 66, and so on outsets.

KNOW ALL MEN BY THESE PRESENTS, that we, Roy M. Gear, Mayor for the City of St. Clair Shores, and Richard Curran, Director of Urban Renewal for the City of St. Clair Shores, Macomb County, State of Michigan, by virtue of Authority in us vested by Section 5a of Act 344, of the Public Acts of 1945, having been fully authorized by the City Council of the City of St. Clair Shores, have caused the land described in the annexed Plat to be surveyed, laid out and platted, to be known as "Freeway Industrial Urban Renewal Plat of Part of P. C. 624, T.1N. R.13E, City of St. Clair Shores, Macomb County, Michigan"; that titles to the streets, alleys, and public places have been acquired by purchase, dedication, or condemnation, ^{for public use,} and that the private easements as shown on said Plat are hereby reserved for the use of the Public Utilities, and that no permanent structures are to be erected within the boundaries of said easements.

CITY OF ST. CLAIR SHORES
2700 JEFFERSON ST. CLAIR SHORES, MICH.
Roy M. Gear, Mayor
Richard Curran, Director of Urban Renewal

STATE OF MICHIGAN)
COUNTY OF MACOMB) ss.
On this 27 day of FEB, A.D., 1966, before me a Notary Public in and for said County, personally came the above named Roy M. Gear, Mayor of the City of St. Clair Shores, and Richard Curran, Director of Urban Renewal for the City of St. Clair Shores, known to me to be the persons who executed the above dedication, and acknowledged the same to be their free act and deed as City Mayor and City Director of Urban Renewal respectively.

My Commission expires January 29, 1967
Notary Public, in and for Macomb County, Michigan
LEITA H. RUST

MUNICIPAL APPROVAL
This Plat was approved by the City Council of the City of St. Clair Shores at a meeting held FEB. 7, 1966, and complies with Section 134, Act 172, of 1929, as amended.

ENGINEER'S CERTIFICATE
I hereby certify that the Plat herein delineated is a correct one, and that permanent monuments consisting of metal bars not less than 1/2" in diameter and 36" in length, encased in concrete cylinders 4" in diameter and 36" in length have been set at points marked thus (a) as shown thereon at all angles in the boundaries of the land platted, at all intersections of the lines of streets, intersections of the lines of streets and alleys, and the intersections of the lines of streets and alleys with the boundaries of the Plat.

Prepared and Drafted by: Samuel A. Walker, Jr., F.L.S.
735 Forest Ave., St. Clair, Michigan
Registered Land Surveyor #5390

EXAMINED AND APPROVED
Date: MAY 2, 1966
Allison Green
STAFF TREASURER
Richard L. Lomax, Plat Examiner

Approved By
City of St. Clair Shores
Planning Commission
George C. Strode, Chairman
Sidney A. Swamp, Secretary
Steven G. Suro

REGISTER'S OFFICE
COUNTY OF MACOMB
Received for Record
May 24, 1966
1140 BOOK A, M, and recorded
in Vol. 56 of PLATS, on
Page 43 of 44
Raymond R. Davis
Deputy Register of Deeds

APPROVED
MICHIGAN STATE HIGHWAY COMMISSION
Howard E. Hill
State Highway Director

This plat was approved by the Macomb County Plat Board on Dec. 22, 1965
MARCH 1966
Checked by: Raymond R. Davis, Deputy
John H. Burt, Register of Deeds
Edward J. ...
Thomas J. ...


L-56 P.44

See Plat Book - Show 1831 P.417

HARMON SUBDIVISION

PART OF P.C. 624 B, SE 1/4 OF SEC. 28, T1N, R13E.,
CITY OF ST. CLAIR SHORES, MACOMB COUNTY, MICHIGAN

SHEET 1 OF 2 SHEETS

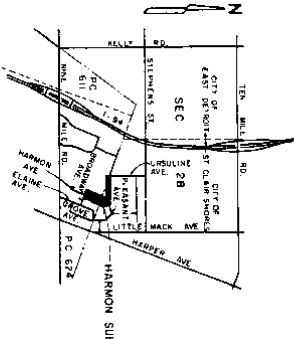

LOCATION MAP
SCALE 1" = 200'

PLAT LEGEND

1. ALL DIMENSIONS ARE IN FEET.
2. ALL DIMENSIONAL DIMENSIONS ARE SHOWN ALONG THE ARC.
3. R. DENOTES RADIAL LOCATIONS & CONCRETE MONUMENTS.
4. U. DENOTES UTILITY LOCATIONS.
5. ALL LOT MARKERS ARE 1/2" HIGH IRON PINS AND ARE 1 1/2" LONG.
6. ALL RECORDS ARE IN RECLAMATION TO BEYOND HARMON URBAN RENEWAL PLAT.
7. AS RECORDED IN T1N, R13E, S28, P13 B 14.

CURVE DATA


NO.	RADIUS	ARC	DELTA	CHORD	CHORD BEARING
1	350.00	125.07	97.91	102.57	N 117° 02' 52" E
2	350.00	125.08	97.91	102.58	N 117° 02' 52" E

CERTIFIED TRUE COPY OF
RECORDED PLAT

John E. Harmon
LARRY E. HARMON
STATE TREASURER
OF MICHIGAN

Robert J. Harmon
Notary Public
for Michigan

PAUL HIRN & BOOKE, INC.
REGISTERED CIVIL ENGINEERS
AND LAND SURVEYORS
1000 W. WASHINGTON ST.
ANN ARBOR, MICHIGAN 48106

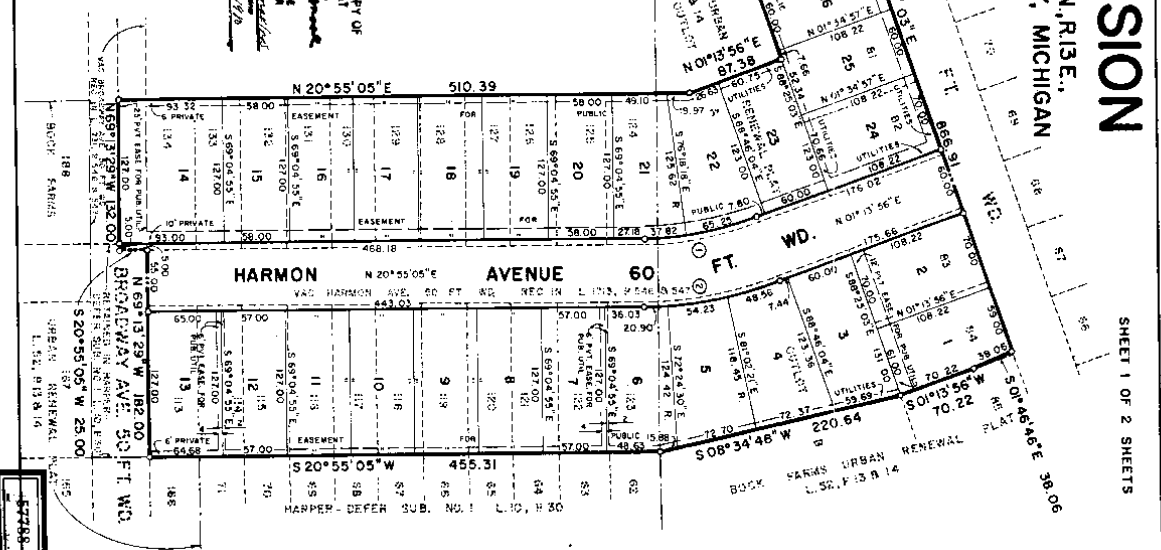

57288