

# ANDERSON, ECKSTEIN AND WESTRICK, INC.

51301 Schoenherr Road, Shelby Township, Michigan 48315  
Civil Engineers • Surveyors • Architects 586-726-1234

## 2013 Remonumentation

Corner: PC-033:.. Northeast corner of PC 630, Section 11, Town 1 North, Range 13 East

### Index

- I. Section 1
  - A. Index
  - B. Photographs
  
- II. Section 2
  - A. LCRC
  - B. Surveyor's Report
  
- III. Section 3
  - A. Field Notes
    - 1. Corner Witnesses
    - 2. GPS Notes
    - 3. Sketch
    - 4. Composite Maps
  
- IV. Section 4
  - A. GLO Notes and Plats
    - 1. 1810 Private Claim Description – Greeley
    - 2. 1810 Private Claim Notes - Greeley
    - 3. 1817 Township Plat – Preston
    - 4. 1895 GLO Atlas
    - 5. Plats

MACOMB COUNTY  
ENGINEERING DEPARTMENT  
PROJECT NO. 100-100-100  
FACT #34567890













**LAND CORNER RECORDATION CERTIFICATE**  
**Filing Requirement of Act 74, Mich. P.A. 1970 as Amended**

For corners in

<u>Macomb</u> (County)	Located in: City of St. Clair Shores	Corner Code # PC 033
1. Public Land Survey	T <u>1N</u> R <u>13E</u>	_____
	T _____ R _____	_____
	T _____ R _____	_____
	T _____ R _____	_____
2. Property Controlling In Section	S _____ T _____ R _____	_____
	s _____ T _____ R _____	_____
3. Miscellaneous Property in Sec.	S _____ T _____ R _____	_____
	S _____ T _____ R _____	_____

3174035 PAGE 1 OF 1  
 LIBER 22555 PAGE 941  
 11/21/2013 12:41:52 P.M.  
 MACOMB COUNTY, MI SEAL  
 CARMELLA SABAUGH, REGISTER OF DEEDS


Register of Deeds Stamp & File Number

4. Lot No. \_\_\_\_\_, Recorded Plat  
 5. Private Claims Northeast corner of PC 630

I, Craig P. Amey, in a field survey on August 13, 2013 do hereby state that under requirements of P.A. 74, Michigan P.A. of 1970, the corner points mentioned in lines 1 and 2 above were in conformance with regulations and rules therefore as required in the current manual of survey instructions of the United States Department of the Interior, Bureau of Land Management or by a decree of a Court of Law and /or that the corner points mentioned in lines 3, 4 and 5 above were in conformance with the rules of the Michigan Board of Land Surveyors or by a Decree of a Court of Law; established, re-established, monumented, recovered, found as expressed below:

NOTE: Not more than 2 corners, all in the same town and range, may be recorded on this certificate.

A. Description of original monument and accessories and/or subsequent restoration:

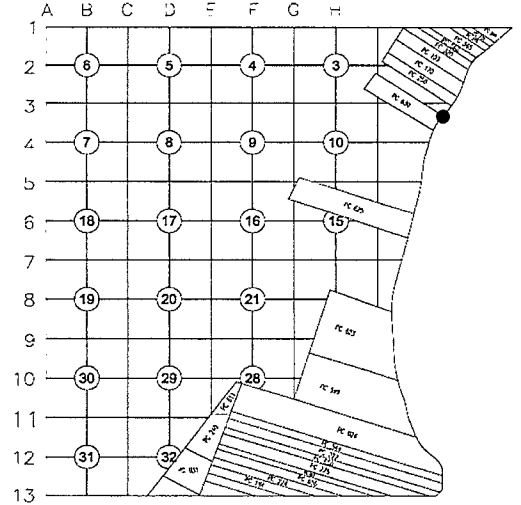

Item	Date	L	P	Document	Name	#	Cor. Desc.
1	1810	--	--	Private Claim Description	Greeley	---	Post
2	1810	--	--	Private Claim Notes	Greeley	---	Post
3	1817	--	--	Township Plat	Preston	---	Not Indicated
4	1915	3	4	Middlebay Park Subdivision	Lehner	123	-----

B. Description of corner evidence found and/or method applied in restoring or reestablishing corner:

PC-033 is the Northeast corner of PC 630, Town 1 North, Range 13 East. A research of the public records and a request sent to all area surveyors provided no recorded surveys that reference this corner. To locate the position, I found pipes and irons in various locations along the right of way on Detour Road, as defined by Middlebay Park Subdivision Liber 3 Page 4 Macomb County Records. Using a best fit analysis with the found monumentation along the right of way of Detour Road I was able to determine a the right of way with a maximum deviation of 0.26'. I then oriented the subdivision to these found irons and pipes. Middlebay Park Subdivision defines the location of the northerly and westerly line of PC 630. The intersection of these lines is the northwest corner of PC 630. By using the record distance along the north line from the northwest corner of 630, as described in Item 1 above, the northeast corner of PC 630 lies approximately 437' out in Lake St. Clair. Therefore, I set a monument at the intersection of the Northerly Line of PC 630 and the easterly right of way of Jefferson Ave. The distance from the monument on the easterly right of way line of Jefferson Avenue to the northeast corner of PC-630 is 916.74'.

Distance Comparisons	GLO	AEW	Diff
PC 033 NE cor. PC630 to PC 032 NW cor. PC630	80.14 ch. (5289.24')	4851.49' to shore	437.75'

C. Description of monument for corner and accessories established to perpetuate locating the position of the corner:

PC 630 Northeast Corner of PC 630. I set a 4" x 36" concrete monument with an embedded remonumentation disk stamped, "MACOMB COUNTY REMONUMENTATION ACT 345, PC-033 REF PT, PS 34970" at the intersection of the easterly right of way line of Jefferson Avenue and the northerly line of PC 630.


- AZ 19° 57.26' Set a chiseled "X" on the east rim of a sanitary manhole
- AZ 178° 10.62' Set a 1/2" x 18" iron with cap stamped "CPA 34970"
- AZ 188° 31.22' NGS steel rod in box, box stamped "P 235 1980"
- AZ 224° 147.59' Top of hydrant on west side of Jefferson Avenue
- AZ 335° 4.85' Set a chiseled "X" on the southwest rim of a storm manhole
- AZ 120° 916.74' Calculated position of the Northeast Corner of PC 630 (437,75' into Lake St. Clair)



THE SELECTED LOCATION IS ACCEPTED BY ME AND IS GENERALLY ACCEPTED BY PROFESSIONAL SURVEYORS AS THE BEST AVAILABLE EVIDENCE OF THE POSITION OF THIS CORNER.

Signed by Craig P. Amey ACCEPTED BY THE MACOMB COUNTY SURVEY PEER GROUP AS THE OFFICIAL CORNER UNDER MICHIGAN PUBLIC ACT 345 OF 1990 AT A MEETING HELD ON 8-20-2013 Date 10-23-13  
 Surveyor's Michigan License No. 34970



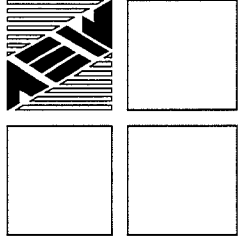

## ANDERSON, ECKSTEIN AND WESTRICK, INC.

51301 Schoenherr Road, Shelby Township, Michigan 48315  
Civil Engineers • Surveyors • Architects 586-726-1234

### 2013 Remonumentation

Corner: PC-033 Northeast corner of PC 630, Section 11, Town 1 North, Range 13 East

### Surveyor's Report

PC-033 is the Northeast corner of PC 630, Section 11, Town 1 North, Range 13 East. In 1810, Aaron Greeley, D.S. was contracted to subdivide section 11. PC 630 lies diagonally across Section 3 and Fractional Section 2 in a northwest/southeast orientation, extending from the southeasterly region of Section 3 thru Fractional Section 2 to Lake St. Clair. We have been contracted by Macomb County to locate and, if necessary, remonument this position.

PC-033 is the Northeast corner of PC 630, Town 1 North, Range 13 East. A research of the public records and a request sent to all area surveyors provided no recorded surveys that reference this corner. To locate the position, I found pipes and irons in various locations along the right of way on Detour Road, as defined by Middlebay Park Subdivision Liber 3 Page 4 Macomb County Records. Using a best fit analysis with the found monumentation along the right of way of Detour Road I was able to determine a the right of way with a maximum deviation of 0.26'. I then oriented the subdivision to these found irons and pipes. Middlebay Park Subdivision defines the location of the northerly and westerly line of PC 630. The intersection of these lines is the northwest corner of PC 630. By using the record distance along the north line from the northwest corner of 630, as described in Item 1 above, the northeast corner of PC 630 lies approximately 437' out in Lake St. Clair. Therefore, I set a monument at the intersection of the Northerly Line of PC 630 and the easterly right of way of Jefferson Ave. The distance from the monument on the easterly right of way line of Jefferson Avenue to the northeast corner of PC-630 is 916.74'.

I believe that the method described above has determined the best location of the Northeast corner of PC 630, Section 11, Town 1 North, Range 13 East

Respectfully Submitted,


Craig P. Amey, PS

02250037  
8-13-13  
MAT-KMD

SCS  
2013 REMON

800 -	Falls 300' EAST of Physical E of HARPER	
PC-033		
DIST	AZ	WITNESSES
51.30'	64°	8016 CHIS "X" ON NW COR of STM RB
24.36'	147°	8017 @ NE COR DETOUR B HARPER CHIS "X" ON SW COR of STM RB
47.95'	276°	8018 IN N.B. HARPER CHIS "X" IN N. RM. of G.V.W
49.96'	355°	8019 IN WEST ROW of HARPER CHIS "X" IN SE COR of STM RB
		IN SE HARPER

3005 40

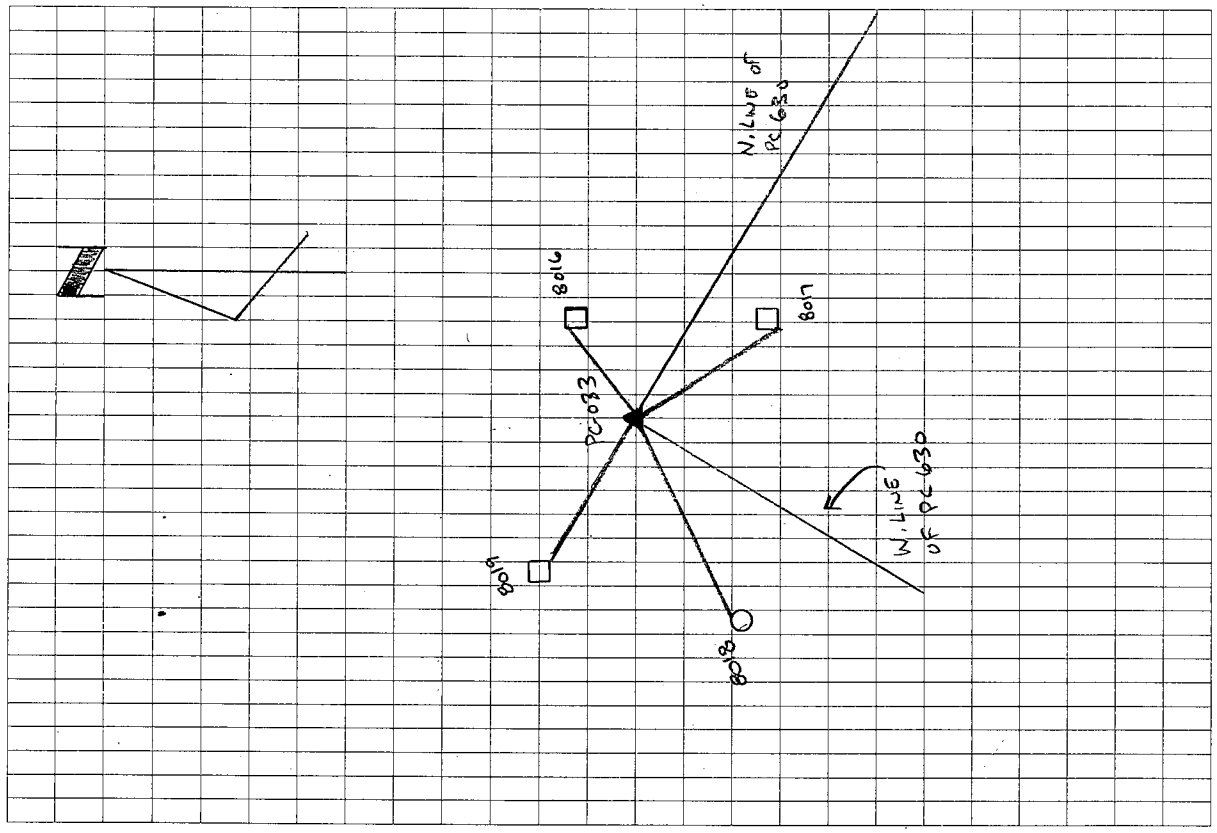


0223-0037  
2-18-13  
MHT-MSL

SCS

2013 REMON

BASED LAKE SHELF

PT#	DESCRIPTION
100	Found IRON
101	"
102	"
103	"
104	Found PIPE
105	Found IRON
106	Found PIPE
107	Found IRON
108	Found CRIPPLE IRON
109	"
110	Found IRON
111	"
112	"
113	Found PIPE
114	Found IRON
115	"
116	"
117	"
118	"
119	Found PIPE
120	"
121	Found IRON
122	"

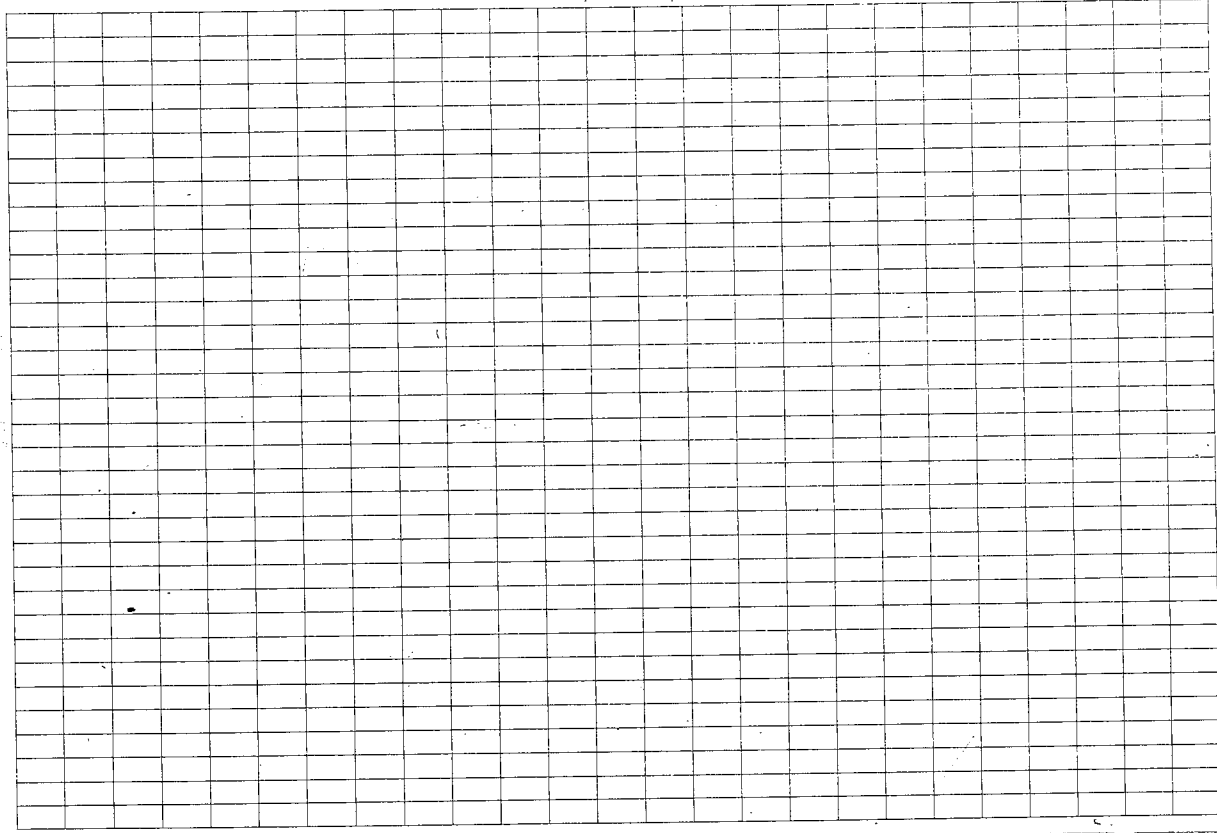

0223-0087  
2-18-13  
MAT-MEL

SCS  
2013 REMON

PT#	DESCRIPTION
123	Found PIPE
124	"
125	"
126	Found IRON
127	"
128	"
129	"
130	Found CAPPER IRON (SWIM)
131	Found IRON
132	"
133	Found PIPE
134	Found IRON
135	"
136	Found PIPE
137	"
138	"
139	"
140	Found IRON
141	"
142	"
143	"
144	Found PIPE
145	Found IRON

3005 37

0223-0037  
2-18-13  
MAT-MTL

SCS  
2013 REMON

PT#	DESCRIPTION
146	Found PIPE
147	" "
148	Found IRON @ 22910 SOC/A
149	Found PIPE @ 22400 SOC/A
150	Found PIPE @ 22420 SOC/A
151	Found PIPE @ SW CORNER SOC/A P. 6/19
152	Found FOUND PIPE @ SE CORNER
6-13-15	PTS
153-213	Found PILES OR IRONS

3005 38



Date of Photography: April 2004  
 100 50 0 100 200 Feet



11,200

**SOUTH EAST SHEET INDEX**

AREA NUMBER	SUB AREA NUMBER	BLOCK NUMBER	PARCEL NUMBER
14-03C	14-03D	14-03E	14-03F
14-03G	14-03H	14-03I	14-03J
14-03K	14-03L	14-03M	14-03N
14-03O	14-03P	14-03Q	14-03R
14-03S	14-03T	14-03U	14-03V
14-03W	14-03X	14-03Y	14-03Z
14-03AA	14-03AB	14-03AC	14-03AD
14-03AE	14-03AF	14-03AG	14-03AH
14-03AI	14-03AJ	14-03AK	14-03AL
14-03AM	14-03AN	14-03AO	14-03AP
14-03AQ	14-03AR	14-03AS	14-03AT
14-03AU	14-03AV	14-03AW	14-03AX
14-03AY	14-03AZ	14-03BA	14-03BB
14-03BC	14-03BD	14-03BE	14-03BF
14-03BG	14-03BH	14-03BI	14-03BJ
14-03BK	14-03BL	14-03BM	14-03BN
14-03BO	14-03BP	14-03BQ	14-03BR
14-03BS	14-03BT	14-03BU	14-03BV
14-03BW	14-03BX	14-03BY	14-03BZ
14-03CA	14-03CB	14-03CC	14-03CD
14-03CE	14-03CF	14-03CG	14-03CH
14-03CI	14-03CJ	14-03CK	14-03CL
14-03CM	14-03CN	14-03CO	14-03CP
14-03CQ	14-03CR	14-03CS	14-03CT
14-03CU	14-03CV	14-03CW	14-03CX
14-03CY	14-03CZ	14-03DA	14-03DB
14-03DC	14-03DD	14-03DE	14-03DF
14-03DG	14-03DH	14-03DI	14-03DJ
14-03DK	14-03DL	14-03DM	14-03DN
14-03DO	14-03DP	14-03DQ	14-03DR
14-03DS	14-03DT	14-03DU	14-03DV
14-03DW	14-03DX	14-03DY	14-03DZ
14-03EA	14-03EB	14-03EC	14-03ED
14-03EE	14-03EF	14-03EG	14-03EH
14-03EI	14-03EJ	14-03EK	14-03EL
14-03EM	14-03EN	14-03EO	14-03EP
14-03EQ	14-03ER	14-03ES	14-03ET
14-03EU	14-03EV	14-03EW	14-03EX
14-03EY	14-03EZ	14-03FA	14-03FB
14-03FC	14-03FD	14-03FE	14-03FF
14-03FG	14-03FH	14-03FI	14-03FJ
14-03FK	14-03FL	14-03FM	14-03FN
14-03FO	14-03FP	14-03FQ	14-03FR
14-03FS	14-03FT	14-03FU	14-03FV
14-03FW	14-03FX	14-03FY	14-03FZ
14-03GA	14-03GB	14-03GC	14-03GD
14-03GE	14-03GF	14-03GG	14-03GH
14-03GI	14-03GJ	14-03GK	14-03GL
14-03GM	14-03GN	14-03GO	14-03GP
14-03GQ	14-03GR	14-03GS	14-03GT
14-03GU	14-03GV	14-03GW	14-03GX
14-03GY	14-03GZ	14-03HA	14-03HB
14-03HC	14-03HD	14-03HE	14-03HF
14-03HG	14-03HH	14-03HI	14-03HJ
14-03HK	14-03HL	14-03HM	14-03HN
14-03HO	14-03HP	14-03HQ	14-03HR
14-03HS	14-03HT	14-03HU	14-03HV
14-03HW	14-03HX	14-03HY	14-03HZ
14-03IA	14-03IB	14-03IC	14-03ID
14-03IE	14-03IF	14-03IG	14-03IH
14-03II	14-03IJ	14-03IK	14-03IL
14-03IM	14-03IN	14-03IO	14-03IP
14-03IQ	14-03IR	14-03IS	14-03IT
14-03IU	14-03IV	14-03IW	14-03IX
14-03IY	14-03IZ	14-03JA	14-03JB
14-03JC	14-03JD	14-03JE	14-03JF
14-03JG	14-03JH	14-03JI	14-03JJ
14-03JK	14-03JL	14-03JM	14-03JN
14-03JO	14-03JP	14-03JQ	14-03JR
14-03JS	14-03JT	14-03JU	14-03JV
14-03JW	14-03JX	14-03JY	14-03JZ
14-03KA	14-03KB	14-03KC	14-03KD
14-03KE	14-03KF	14-03KG	14-03KH
14-03KI	14-03KJ	14-03KK	14-03KL
14-03KM	14-03KN	14-03KO	14-03KP
14-03KQ	14-03KR	14-03KS	14-03KT
14-03KU	14-03KV	14-03KW	14-03KX
14-03KY	14-03KZ	14-03LA	14-03LB
14-03LC	14-03LD	14-03LE	14-03LF
14-03LG	14-03LH	14-03LI	14-03LJ
14-03LK	14-03LL	14-03LM	14-03LN
14-03LO	14-03LP	14-03LQ	14-03LR
14-03LS	14-03LT	14-03LU	14-03LV
14-03LW	14-03LX	14-03LY	14-03LZ
14-03MA	14-03MB	14-03MC	14-03MD
14-03ME	14-03MF	14-03MG	14-03MH
14-03MI	14-03MJ	14-03MK	14-03ML
14-03MM	14-03MN	14-03MO	14-03MP
14-03MQ	14-03MR	14-03MS	14-03MT
14-03MU	14-03MV	14-03MW	14-03MX
14-03MY	14-03MZ	14-03NA	14-03NB
14-03NC	14-03ND	14-03NE	14-03NF
14-03NG	14-03NH	14-03NI	14-03NJ
14-03NK	14-03NL	14-03NM	14-03NN
14-03NO	14-03NP	14-03NQ	14-03NR
14-03NS	14-03NT	14-03NU	14-03NV
14-03NW	14-03NX	14-03NY	14-03NZ
14-03OA	14-03OB	14-03OC	14-03OD
14-03OE	14-03OF	14-03OG	14-03OH
14-03OI	14-03OJ	14-03OK	14-03OL
14-03OM	14-03ON	14-03OO	14-03OP
14-03OQ	14-03OR	14-03OS	14-03OT
14-03OU	14-03OV	14-03OW	14-03OX
14-03OY	14-03OZ	14-03PA	14-03PB
14-03PC	14-03PD	14-03PE	14-03PF
14-03PG	14-03PH	14-03PI	14-03PJ
14-03PK	14-03PL	14-03PM	14-03PN
14-03PO	14-03PP	14-03PQ	14-03PR
14-03PS	14-03PT	14-03PU	14-03PV
14-03PW	14-03PX	14-03PY	14-03PZ
14-03QA	14-03QB	14-03QC	14-03QD
14-03QE	14-03QF	14-03QG	14-03QH
14-03QI	14-03QJ	14-03QK	14-03QL
14-03QM	14-03QN	14-03QO	14-03QP
14-03QQ	14-03QR	14-03QS	14-03QT
14-03QU	14-03QV	14-03QW	14-03QX
14-03QY	14-03QZ	14-03RA	14-03RB
14-03RC	14-03RD	14-03RE	14-03RF
14-03RG	14-03RH	14-03RI	14-03RJ
14-03RK	14-03RL	14-03RM	14-03RN
14-03RO	14-03RP	14-03RQ	14-03RR
14-03RS	14-03RT	14-03RU	14-03RV
14-03RW	14-03RX	14-03RY	14-03RZ
14-03SA	14-03SB	14-03SC	14-03SD
14-03SE	14-03SF	14-03SG	14-03SH
14-03SI	14-03SJ	14-03SK	14-03SL
14-03SM	14-03SN	14-03SO	14-03SP
14-03SQ	14-03SR	14-03SS	14-03ST
14-03SU	14-03SV	14-03SW	14-03SX
14-03SY	14-03SZ	14-03TA	14-03TB
14-03TC	14-03TD	14-03TE	14-03TF
14-03TG	14-03TH	14-03TI	14-03TJ
14-03TK	14-03TL	14-03TM	14-03TN
14-03TO	14-03TP	14-03TQ	14-03TR
14-03TS	14-03TT	14-03TU	14-03TV
14-03TW	14-03TX	14-03TY	14-03TZ
14-03UA	14-03UB	14-03UC	14-03UD
14-03UE	14-03UF	14-03UG	14-03UH
14-03UI	14-03UJ	14-03UK	14-03UL
14-03UM	14-03UN	14-03UO	14-03UP
14-03UQ	14-03UR	14-03US	14-03UT
14-03UU	14-03UV	14-03UW	14-03UX
14-03UY	14-03UZ	14-03VA	14-03VB
14-03VC	14-03VD	14-03VE	14-03VF
14-03VG	14-03VH	14-03VI	14-03VJ
14-03VK	14-03VL	14-03VM	14-03VN
14-03VO	14-03VP	14-03VQ	14-03VR
14-03VS	14-03VT	14-03VU	14-03VV
14-03VW	14-03VX	14-03VY	14-03VZ
14-03WA	14-03WB	14-03WC	14-03WD
14-03WE	14-03WF	14-03WG	14-03WH
14-03WI	14-03WJ	14-03WK	14-03WL
14-03WM	14-03WN	14-03WO	14-03WP
14-03WQ	14-03WR	14-03WS	14-03WT
14-03WU	14-03WV	14-03WW	14-03WX
14-03WY	14-03WZ	14-03XA	14-03XB
14-03XC	14-03XD	14-03XE	14-03XF
14-03XG	14-03XH	14-03XI	14-03XJ
14-03XK	14-03XL	14-03XM	14-03XN
14-03XO	14-03XP	14-03XQ	14-03XR
14-03XS	14-03XT	14-03XU	14-03XV
14-03XW	14-03XX	14-03XY	14-03XZ
14-03YA	14-03YB	14-03YC	14-03YD
14-03YE	14-03YF	14-03YG	14-03YH
14-03YI	14-03YJ	14-03YK	14-03YL
14-03YM	14-03YN	14-03YO	14-03YP
14-03YQ	14-03YR	14-03YS	14-03YT
14-03YU	14-03YV	14-03YW	14-03YX
14-03YY	14-03YZ	14-03ZA	14-03ZB
14-03ZC	14-03ZD	14-03ZE	14-03ZF
14-03ZG	14-03ZH	14-03ZI	14-03ZJ
14-03ZK	14-03ZL	14-03ZM	14-03ZN
14-03ZO	14-03ZP	14-03ZQ	14-03ZR
14-03ZS	14-03ZT	14-03ZU	14-03ZV
14-03ZW	14-03ZX	14-03ZY	14-03ZZ

DESCRIPTION OF PERMANENT REAL ESTATE INDEX NUMBER  
**13-19-302-018**

**Legend**

- Platted Area Boundary Line
- Property Line
- Property Spill Line
- Property Combined Line
- Township Boundary Line
- Traverse Line
- Dimension Extent Marks
- Dimension Start Marks

**14-03H**

ST. CLAIR SHORES  
 E. 1/2 S.E. 1/4 SEC. 3 T. 1N. R. 13E.

Source: Macomb County Department of Planning and Economic Development  
 - 2004 Digital Orthophotography Project  
 - Parcel Conversion Project

Note:  
 Digital Orthophotography horizontal positioning accuracy is 3 feet. Parcel boundary lines should be considered a graphical representation and not in any way a legal survey or engineering document. In general, the horizontal positioning and length accuracy is within 15 feet.  
 This map is intended for general planning purposes. Site specific evaluation should be verified by field inspectors. This is a work in progress and may contain errors and omissions. Please report any potential revisions to (586)469-5035.




**GIS MACOMB COUNTY**  
 Planning and Economic Development Department

Published: Sep 23, 2005



Date of Photography: April 2004  
 100 50 0 100 200 Feet

1:1,200

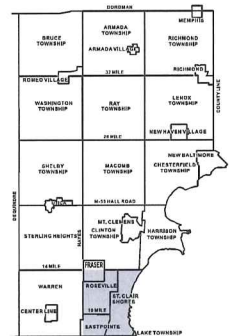


**SOUTH EAST SHEET INDEX**

14-03D	14-03E	14-03F	14-03G	14-03H	14-03I	14-03J	14-03K	14-03L	14-03M	14-03N	14-03O	14-03P	14-03Q	14-03R	14-03S	14-03T	14-03U	14-03V	14-03W	14-03X	14-03Y	14-03Z
14-04D	14-04E	14-04F	14-04G	14-04H	14-04I	14-04J	14-04K	14-04L	14-04M	14-04N	14-04O	14-04P	14-04Q	14-04R	14-04S	14-04T	14-04U	14-04V	14-04W	14-04X	14-04Y	14-04Z
14-05D	14-05E	14-05F	14-05G	14-05H	14-05I	14-05J	14-05K	14-05L	14-05M	14-05N	14-05O	14-05P	14-05Q	14-05R	14-05S	14-05T	14-05U	14-05V	14-05W	14-05X	14-05Y	14-05Z
14-06D	14-06E	14-06F	14-06G	14-06H	14-06I	14-06J	14-06K	14-06L	14-06M	14-06N	14-06O	14-06P	14-06Q	14-06R	14-06S	14-06T	14-06U	14-06V	14-06W	14-06X	14-06Y	14-06Z
14-07D	14-07E	14-07F	14-07G	14-07H	14-07I	14-07J	14-07K	14-07L	14-07M	14-07N	14-07O	14-07P	14-07Q	14-07R	14-07S	14-07T	14-07U	14-07V	14-07W	14-07X	14-07Y	14-07Z
14-08D	14-08E	14-08F	14-08G	14-08H	14-08I	14-08J	14-08K	14-08L	14-08M	14-08N	14-08O	14-08P	14-08Q	14-08R	14-08S	14-08T	14-08U	14-08V	14-08W	14-08X	14-08Y	14-08Z
14-09D	14-09E	14-09F	14-09G	14-09H	14-09I	14-09J	14-09K	14-09L	14-09M	14-09N	14-09O	14-09P	14-09Q	14-09R	14-09S	14-09T	14-09U	14-09V	14-09W	14-09X	14-09Y	14-09Z
14-10D	14-10E	14-10F	14-10G	14-10H	14-10I	14-10J	14-10K	14-10L	14-10M	14-10N	14-10O	14-10P	14-10Q	14-10R	14-10S	14-10T	14-10U	14-10V	14-10W	14-10X	14-10Y	14-10Z
14-11D	14-11E	14-11F	14-11G	14-11H	14-11I	14-11J	14-11K	14-11L	14-11M	14-11N	14-11O	14-11P	14-11Q	14-11R	14-11S	14-11T	14-11U	14-11V	14-11W	14-11X	14-11Y	14-11Z
14-12D	14-12E	14-12F	14-12G	14-12H	14-12I	14-12J	14-12K	14-12L	14-12M	14-12N	14-12O	14-12P	14-12Q	14-12R	14-12S	14-12T	14-12U	14-12V	14-12W	14-12X	14-12Y	14-12Z

**DESCRIPTION OF PERMANENT REAL ESTATE INDEX NUMBER**

**13-19-302-018**

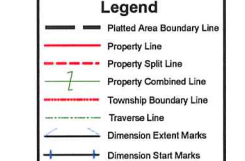

**14-02E**

**ST. CLAIR SHORES**  
 W.1/2 S.W.1/4 SEC.2 T.1N. R.13E.

Source: Macomb County Department of Planning and Economic Development  
 - 2004 Digital Orthophoto Project  
 - Parcel Conversion Project


Note:  
 Digital Orthophoto horizontal positioning accuracy is 3 feet. Parcel boundary lines should be considered a graphical representation and not in any way a legal survey or engineering document. In general, the horizontal positioning and length accuracy is within 15 feet.

This map is intended for general planning purposes. Site specific evaluation should be verified by field inspection. This is a work in progress and may contain errors and omissions. Please report any potential revisions to (586)469-5285.

**GIS** MACOMB COUNTY  
 Planning and Economic  
 Development Department  
 Published: Feb 05, 2007



Date of Photography: April 2004  
 100 50 0 100 200 Feet

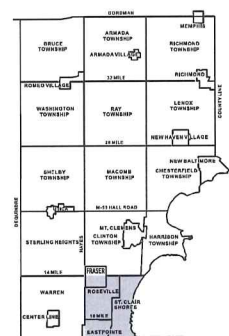

**SOUTH EAST SHEET INDEX**

1/4 MILE

14-02A	14-02B	14-02C	14-02D	14-02E	14-02F
14-02G	14-02H	14-02I	14-02J	14-02K	14-02L
14-02M	14-02N	14-02O	14-02P	14-02Q	14-02R
14-02S	14-02T	14-02U	14-02V	14-02W	14-02X
14-02Y	14-02Z	14-02AA	14-02AB	14-02AC	14-02AD
14-02AE	14-02AF	14-02AG	14-02AH	14-02AI	14-02AJ
14-02AK	14-02AL	14-02AM	14-02AN	14-02AO	14-02AP
14-02AQ	14-02AR	14-02AS	14-02AT	14-02AU	14-02AV
14-02AW	14-02AX	14-02AY	14-02AZ	14-02BA	14-02BB
14-02BC	14-02BD	14-02BE	14-02BF	14-02BG	14-02BH
14-02BI	14-02BJ	14-02BK	14-02BL	14-02BM	14-02BN
14-02BO	14-02BP	14-02BQ	14-02BR	14-02BS	14-02BT
14-02BU	14-02BV	14-02BW	14-02BX	14-02BY	14-02BZ
14-02CA	14-02CB	14-02CC	14-02CD	14-02CE	14-02CF
14-02CG	14-02CH	14-02CI	14-02CJ	14-02CK	14-02CL
14-02CM	14-02CN	14-02CO	14-02CP	14-02CQ	14-02CR
14-02CS	14-02CT	14-02CU	14-02CV	14-02CW	14-02CX
14-02CY	14-02CZ	14-02DA	14-02DB	14-02DC	14-02DD
14-02DE	14-02DF	14-02DG	14-02DH	14-02DI	14-02DJ
14-02DK	14-02DL	14-02DM	14-02DN	14-02DO	14-02DP
14-02DQ	14-02DR	14-02DS	14-02DT	14-02DU	14-02DV
14-02DW	14-02DX	14-02DY	14-02DZ	14-02EA	14-02EB
14-02EC	14-02ED	14-02EE	14-02EF	14-02EG	14-02EH
14-02EI	14-02EJ	14-02EK	14-02EL	14-02EM	14-02EN
14-02EO	14-02EP	14-02EQ	14-02ER	14-02ES	14-02ET
14-02EU	14-02EV	14-02EW	14-02EX	14-02EY	14-02EZ
14-02FA	14-02FB	14-02FC	14-02FD	14-02FE	14-02FF
14-02FG	14-02FH	14-02FI	14-02FJ	14-02FK	14-02FL
14-02FM	14-02FN	14-02FO	14-02FP	14-02FQ	14-02FR
14-02FS	14-02FT	14-02FU	14-02FV	14-02FW	14-02FX
14-02FY	14-02FZ	14-02GA	14-02GB	14-02GC	14-02GD
14-02GE	14-02GF	14-02GG	14-02GH	14-02GI	14-02GJ
14-02GK	14-02GL	14-02GM	14-02GN	14-02GO	14-02GP
14-02GQ	14-02GR	14-02GS	14-02GT	14-02GU	14-02GV
14-02GW	14-02GX	14-02GY	14-02GZ	14-02HA	14-02HB
14-02HC	14-02HD	14-02HE	14-02HF	14-02HG	14-02HH
14-02HI	14-02HJ	14-02HK	14-02HL	14-02HM	14-02HN
14-02HO	14-02HP	14-02HQ	14-02HR	14-02HS	14-02HT
14-02HU	14-02HV	14-02HW	14-02HX	14-02HY	14-02HZ
14-02IA	14-02IB	14-02IC	14-02ID	14-02IE	14-02IF
14-02IG	14-02IH	14-02II	14-02IJ	14-02IK	14-02IL
14-02IM	14-02IN	14-02IO	14-02IP	14-02IQ	14-02IR
14-02IS	14-02IT	14-02IU	14-02IV	14-02IW	14-02IX
14-02IY	14-02IZ	14-02JA	14-02JB	14-02JC	14-02JD
14-02JE	14-02JF	14-02JG	14-02JH	14-02JI	14-02JJ
14-02JK	14-02JL	14-02JM	14-02JN	14-02JO	14-02JP
14-02JQ	14-02JR	14-02JS	14-02JT	14-02JU	14-02JV
14-02JW	14-02JX	14-02JY	14-02JZ	14-02KA	14-02KB
14-02KC	14-02KD	14-02KE	14-02KF	14-02KG	14-02KH
14-02KI	14-02KJ	14-02KK	14-02KL	14-02KM	14-02KN
14-02KO	14-02KP	14-02KQ	14-02KR	14-02KS	14-02KT
14-02KU	14-02KV	14-02KW	14-02KX	14-02KY	14-02KZ
14-02LA	14-02LB	14-02LC	14-02LD	14-02LE	14-02LF
14-02LG	14-02LH	14-02LI	14-02LJ	14-02LK	14-02LL
14-02LM	14-02LN	14-02LO	14-02LP	14-02LQ	14-02LR
14-02LS	14-02LT	14-02LU	14-02LV	14-02LW	14-02LX
14-02LY	14-02LZ	14-02MA	14-02MB	14-02MC	14-02MD
14-02ME	14-02MF	14-02MG	14-02MH	14-02MI	14-02MJ
14-02MK	14-02ML	14-02MN	14-02MO	14-02MP	14-02MQ
14-02MR	14-02MS	14-02MT	14-02MU	14-02MV	14-02MW
14-02MX	14-02MY	14-02MZ	14-02NA	14-02NB	14-02NC
14-02ND	14-02NE	14-02NF	14-02NG	14-02NH	14-02NI
14-02NJ	14-02NK	14-02NL	14-02NM	14-02NO	14-02NP
14-02NQ	14-02NR	14-02NS	14-02NT	14-02NU	14-02NV
14-02NW	14-02NX	14-02NY	14-02NZ	14-02OA	14-02OB
14-02OC	14-02OD	14-02OE	14-02OF	14-02OG	14-02OH
14-02OI	14-02OJ	14-02OK	14-02OL	14-02OM	14-02ON
14-02OO	14-02OP	14-02OQ	14-02OR	14-02OS	14-02OT
14-02OU	14-02OV	14-02OW	14-02OX	14-02OY	14-02OZ
14-02PA	14-02PB	14-02PC	14-02PD	14-02PE	14-02PF
14-02PG	14-02PH	14-02PI	14-02PJ	14-02PK	14-02PL
14-02PM	14-02PN	14-02PO	14-02PP	14-02PQ	14-02PR
14-02PS	14-02PT	14-02PU	14-02PV	14-02PW	14-02PX
14-02PY	14-02PZ	14-02QA	14-02QB	14-02QC	14-02QD
14-02QE	14-02QF	14-02QG	14-02QH	14-02QI	14-02QJ
14-02QK	14-02QL	14-02QM	14-02QN	14-02QO	14-02QP
14-02QQ	14-02QR	14-02QS	14-02QT	14-02QU	14-02QV
14-02QW	14-02QX	14-02QY	14-02QZ	14-02RA	14-02RB
14-02RC	14-02RD	14-02RE	14-02RF	14-02RG	14-02RH
14-02RI	14-02RJ	14-02RK	14-02RL	14-02RM	14-02RN
14-02RO	14-02RP	14-02RQ	14-02RR	14-02RS	14-02RT
14-02RU	14-02RV	14-02RW	14-02RX	14-02RY	14-02RZ
14-02SA	14-02SB	14-02SC	14-02SD	14-02SE	14-02SF
14-02SG	14-02SH	14-02SI	14-02SJ	14-02SK	14-02SL
14-02SM	14-02SN	14-02SO	14-02SP	14-02SQ	14-02SR
14-02SS	14-02ST	14-02SU	14-02SV	14-02SW	14-02SX
14-02SY	14-02SZ	14-02TA	14-02TB	14-02TC	14-02TD
14-02TE	14-02TF	14-02TG	14-02TH	14-02TI	14-02TJ
14-02TK	14-02TL	14-02TM	14-02TN	14-02TO	14-02TP
14-02TQ	14-02TR	14-02TS	14-02TT	14-02TU	14-02TV
14-02TW	14-02TX	14-02TY	14-02TZ	14-02UA	14-02UB
14-02UC	14-02UD	14-02UE	14-02UF	14-02UG	14-02UH
14-02UI	14-02UJ	14-02UK	14-02UL	14-02UM	14-02UN
14-02UO	14-02UP	14-02UQ	14-02UR	14-02US	14-02UT
14-02UU	14-02UV	14-02UW	14-02UX	14-02UY	14-02UZ
14-02VA	14-02VB	14-02VC	14-02VD	14-02VE	14-02VF
14-02VG	14-02VH	14-02VI	14-02VJ	14-02VK	14-02VL
14-02VM	14-02VN	14-02VO	14-02VP	14-02VQ	14-02VR
14-02VS	14-02VT	14-02VU	14-02VV	14-02VW	14-02VX
14-02VY	14-02VZ	14-02WA	14-02WB	14-02WC	14-02WD
14-02WE	14-02WF	14-02WG	14-02WH	14-02WI	14-02WJ
14-02WK	14-02WL	14-02WM	14-02WN	14-02WO	14-02WP
14-02WQ	14-02WR	14-02WS	14-02WT	14-02WU	14-02WV
14-02WW	14-02WX	14-02WY	14-02WZ	14-02XA	14-02XB
14-02XC	14-02XD	14-02XE	14-02XF	14-02XG	14-02XH
14-02XI	14-02XJ	14-02XK	14-02XL	14-02XM	14-02XN
14-02XO	14-02XP	14-02XQ	14-02XR	14-02XS	14-02XT
14-02XU	14-02XV	14-02XW	14-02XX	14-02XY	14-02XZ
14-02YA	14-02YB	14-02YC	14-02YD	14-02YE	14-02YF
14-02YG	14-02YH	14-02YI	14-02YJ	14-02YK	14-02YL
14-02YM	14-02YN	14-02YO	14-02YP	14-02YQ	14-02YR
14-02YS	14-02YT	14-02YU	14-02YV	14-02YW	14-02YX
14-02YY	14-02YZ	14-02ZA	14-02ZB	14-02ZC	14-02ZD
14-02ZE	14-02ZF	14-02ZG	14-02ZH	14-02ZI	14-02ZJ
14-02ZK	14-02ZL	14-02ZM	14-02ZN	14-02ZO	14-02ZP
14-02ZQ	14-02ZR	14-02ZS	14-02ZT	14-02ZU	14-02ZV
14-02ZW	14-02ZX	14-02ZY	14-02ZZ		

8 MILE

DESCRIPTION OF PERMANENT REAL ESTATE INDEX NUMBER

**13-19-302-018**

AREA NUMBER (TOWNSHIP AND RANGE)	SUB AREA NUMBER (BLOCK)	BLOCK NUMBER (PROPERTY IDENTIFICATION)	PARCEL NUMBER (UNIQUELY IDENTIFIED PARCEL)
----------------------------------	-------------------------	--	--

**Legend**

- Platted Area Boundary Line
- Property Line
- Property Spill Line
- Property Combined Line
- Township Boundary Line
- Traverse Line
- Dimension Extent Marks
- Dimension Start Marks

**14-02F**

ST. CLAIR SHORES  
 E. 1/2 S.W. 1/4 SEC. 2 T. 1N. R. 13E.

Source: Macomb County Department of Planning and Economic Development  
 - 2004 Digital Orthophotography Project - Parcel Conversion Project

Note:  
 Digital Orthophotography horizontal positioning accuracy is 3 feet. Parcel boundary lines should be considered a graphical representation and not in any way a legal survey or engineering document. In general, the horizontal positioning and length accuracy is within 15 feet.


This map is intended for general planning purposes. Site specific evaluation should be verified by field inspection. This is a work in progress and may contain errors and omissions. Please report any potential revisions to (586)469-5266.






Date of Photography: April 2004  
 100 50 0 100 200 Feet

1:1,200

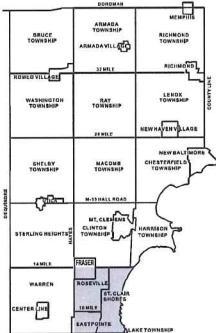

**SOUTH EAST SHEET INDEX**

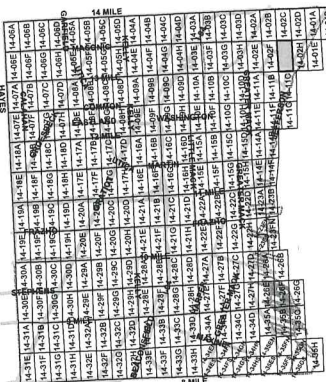

DESCRIPTION OF PERMANENT REAL ESTATE INDEX NUMBER  
**13-19-302-018**

INDEX NUMBER (TOWNSHIP AND RANGE)	PARCEL NUMBER (WITH SECTION)	BLOCK NUMBER (WITH SECTION)	PARCEL NUMBER (WITH SECTION)
-----------------------------------	------------------------------	-----------------------------	------------------------------

**Legend**

- Platted Area Boundary Line
- Property Line
- Property Split Line
- Property Combined Line
- Township Boundary Line
- Traverse Line
- Dimension Extent Marks
- Dimension Start Marks

# 14-02G

**ST. CLAIR SHORES**  
 W. 1/2 S.E. 1/4 SEC. 2 T. 1N. R. 13E.

Source: Macomb County Department of Planning and Economic Development  
 - 2004 Digital Orthophotography Project  
 - Parcel Conversion Project

Note:  
 Digital Orthophotography horizontal positioning accuracy is 3 feet. Parcel boundary lines should be considered a graphical representation and not in any way a legal survey or engineering document. In general, the horizontal positioning and length accuracy is within 15 feet.

This map is intended for general planning purposes. Site specific evaluation should be verified by field inspection. This is a work in progress and may contain errors and omissions. Please report any potential revisions to (586)469-5285.




**GIS** MACOMB COUNTY  
 Planning and Economic  
 Development Department  
 Published: Sep 21, 2007



Date of Photography: April 2004  
 100 50 0 100 200 Feet

1:1,200

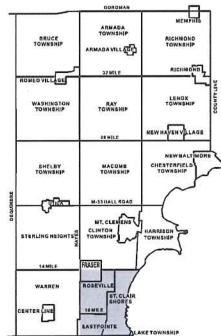

**SOUTH EAST SHEET INDEX**

14-03H	14-04H	14-05H	14-06H	14-07H	14-08H	14-09H	14-10H	14-11H
14-10D	14-11D	14-12D	14-13D	14-14D	14-15D	14-16D	14-17D	14-18D
14-10E	14-11E	14-12E	14-13E	14-14E	14-15E	14-16E	14-17E	14-18E
14-10F	14-11F	14-12F	14-13F	14-14F	14-15F	14-16F	14-17F	14-18F
14-10G	14-11G	14-12G	14-13G	14-14G	14-15G	14-16G	14-17G	14-18G
14-10H	14-11H	14-12H	14-13H	14-14H	14-15H	14-16H	14-17H	14-18H
14-10I	14-11I	14-12I	14-13I	14-14I	14-15I	14-16I	14-17I	14-18I
14-10J	14-11J	14-12J	14-13J	14-14J	14-15J	14-16J	14-17J	14-18J
14-10K	14-11K	14-12K	14-13K	14-14K	14-15K	14-16K	14-17K	14-18K
14-10L	14-11L	14-12L	14-13L	14-14L	14-15L	14-16L	14-17L	14-18L
14-10M	14-11M	14-12M	14-13M	14-14M	14-15M	14-16M	14-17M	14-18M
14-10N	14-11N	14-12N	14-13N	14-14N	14-15N	14-16N	14-17N	14-18N
14-10O	14-11O	14-12O	14-13O	14-14O	14-15O	14-16O	14-17O	14-18O
14-10P	14-11P	14-12P	14-13P	14-14P	14-15P	14-16P	14-17P	14-18P
14-10Q	14-11Q	14-12Q	14-13Q	14-14Q	14-15Q	14-16Q	14-17Q	14-18Q
14-10R	14-11R	14-12R	14-13R	14-14R	14-15R	14-16R	14-17R	14-18R
14-10S	14-11S	14-12S	14-13S	14-14S	14-15S	14-16S	14-17S	14-18S
14-10T	14-11T	14-12T	14-13T	14-14T	14-15T	14-16T	14-17T	14-18T
14-10U	14-11U	14-12U	14-13U	14-14U	14-15U	14-16U	14-17U	14-18U
14-10V	14-11V	14-12V	14-13V	14-14V	14-15V	14-16V	14-17V	14-18V
14-10W	14-11W	14-12W	14-13W	14-14W	14-15W	14-16W	14-17W	14-18W
14-10X	14-11X	14-12X	14-13X	14-14X	14-15X	14-16X	14-17X	14-18X
14-10Y	14-11Y	14-12Y	14-13Y	14-14Y	14-15Y	14-16Y	14-17Y	14-18Y
14-10Z	14-11Z	14-12Z	14-13Z	14-14Z	14-15Z	14-16Z	14-17Z	14-18Z

**DESCRIPTION OF PERMANENT REAL ESTATE INDEX NUMBER**

**13-19-302-018**

<b>AREA NUMBER</b> Governmental jurisdiction with existing property	<b>SUB AREA NUMBER</b> Subdivision	<b>BLOCK NUMBER</b> Block	<b>PARCEL NUMBER</b> Parcel
--	---------------------------------------	------------------------------	--------------------------------

**Legend**

- Platted Area Boundary Line
- Property Line
- Property Split Line
- Property Combined Line
- Township Boundary Line
- Traverse Line
- Dimension Extent Marks
- Dimension Start Marks

**14-11A**


**ST. CLAIR SHORES**  
 W.1/2 N.W.1/4 SEC.11 T.1N. R.13E.

Source: Macomb County Department of Planning and Economic Development  
 - 2004 Digital Orthophotography Project  
 - Parcel Conversion Project


Note:  
 Digital Orthophotography horizontal positioning accuracy is 3 feet. Parcel boundary lines should be considered a graphical representation and not in any way a legal survey or engineering document. In general, the horizontal positioning and length accuracy is within 15 feet.  
 This map is intended for general planning purposes. Site specific evaluation should be verified by field inspection. This is a work in progress and may contain errors and omissions. Please report any potential revisions to (586)469-5285.



**GIS** MACOMB COUNTY  
 Planning and Economic  
 Development Department  
 Published: Feb 08, 2007

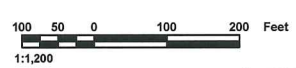

COPYRIGHT 2001  
MACOMB COUNTY, MI  
All Rights Reserved

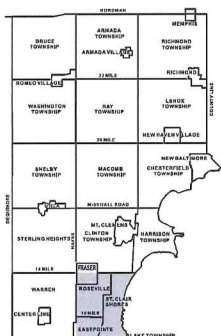

SOUTH EAST SHEET INDEX

AREA NUMBER (TOWNSHIP AND RANGE)	SUB AREA NUMBER (BLOCK OR LOT)	BLOCK NUMBER (PROPERTY NUMBER)	PARCEL NUMBER (PROPERTY NUMBER)
14-11A	14-11A-1	14-11A-1-1	14-11A-1-1-1
14-11A	14-11A-1	14-11A-1-2	14-11A-1-2-1
14-11A	14-11A-1	14-11A-1-3	14-11A-1-3-1
14-11A	14-11A-1	14-11A-1-100	14-11A-1-100-1

DESCRIPTION OF PERMANENT REAL ESTATE INDEX NUMBER  
**13-19-302-018**

**Legend**

- Platted Area Boundary Line
- Property Line
- Property Split Line
- Property Combined Line
- Township Boundary Line
- Traverse Line
- Dimension Extent Marks
- Dimension Start Marks

# 14-11B

ST. CLAIR SHORES  
E.1/2 N.W.1/4 SEC.11 T.1N. R.13E.



Source: Macomb County Department of Planning and Economic Development  
- 2004 Digital Orthophotography Project  
- Parcel Conversion Project

Note:  
Digital Orthophotography horizontal positioning accuracy is 3 feet. Parcel boundary lines should be considered a graphical representation and not in any way a legal survey or engineering document. In general, the horizontal positioning and length accuracy is within 15 feet.  
This map is intended for general planning purposes. Site specific evaluation should be verified by field inspection. This is a work in progress and may contain errors and omissions. Please report any potential revisions to (568)469-5255.




GIS MACOMB COUNTY  
Planning and Economic  
Development Department

Published: Mar 09, 2005

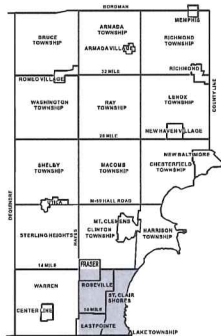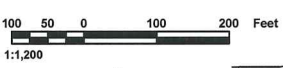


SOUTH EAST SHEET INDEX

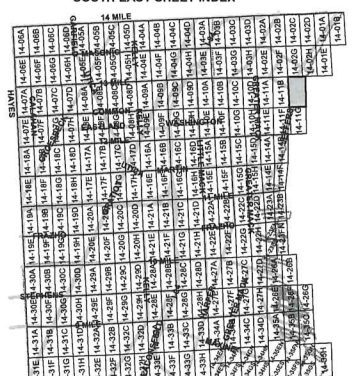

DESCRIPTION OF PERMANENT REAL ESTATE INDEX NUMBER  
**13-19-302-018**

AREA NUMBER: 13  
 SUB AREA NUMBER: 19  
 BLOCK NUMBER: 302  
 PARCEL NUMBER: 018

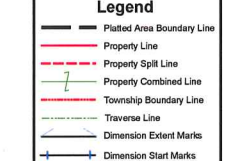

# 14-11C

ST. CLAIR SHORES  
 W.1/2 N.E.1/4 SEC.11 T.1N. R.13E.

Source: Macomb County Department of Planning and Economic Development  
 - 2004 Digital Orthophotography Project  
 - Parcel Conversion Project

Note: Digital Orthophotography horizontal positioning accuracy is 3 feet. Parcel boundary lines should be considered a graphical representation and not in any way a legal survey or engineering document. In general, the horizontal positioning and length accuracy is within 15 feet.

This map is intended for general planning purposes. Site specific evaluation should be verified by field inspection. This is a work in progress and may contain errors and omissions. Please report any potential revisions to (586)469-5285.



GIS MACOMB COUNTY  
 Planning and Economic  
 Development  
 Published: Mar 09, 2005

No. 436

No. 630 Confirmed to  
Baptist Socier

LAKE ST. CLAIR

Description No. 630, Confirmed to Baptist Socier commencing at a post standing on the border of Lake St. Clair between this tract and a tract of unconceded land thence north sixty one degrees thirty minutes west eighty chains fourteen links links to a post thence north twenty eight degrees thirty minutes east seventeen chains forty six links to a post the southwest corner of a tract claimed by Charles Chovin thence south sixty one degrees thirty minutes east eighty chains fourteen links to post standing on the border of Lake St. Clair thence along the border of said lake south twenty eight degrees thirty minutes west seventeen chains forty six links to the place of beginning, containing one hundred and thirty nine acres ninety two hundredths of an acre \_\_\_\_

Detroit July 18th, 1810

Aaron Greeley Surveyor  
of private claims

N<sup>o</sup>. 436 "

Lake St. Clair


Description N<sup>o</sup>. 630. Confirmed to Baptist Societ commencing at a post standing on the <sup>bank</sup> of Lake St. Clair between this tract and a tract of unconceded Land, thence north sixty one degrees thirty minutes west Eighty chains fourteen links to a post thence north - twenty eight degrees thirty minutes East seventeen Chains forty six links, to a post the south west corner of a tract Claimed by Charles Choivin thence south sixty one degrees thirty minutes East Eighty chains fourteen links, to post standing on the border of Lake St. Clair thence along the border of Lake St. Clair, south twenty eight degrees thirty minutes west seventeen chains forty six links, to the place of beginning Containing one hundred and thirty nine acres ninety two hundredths of an acre. —

Detroit July 18<sup>th</sup> 1810

Aaron Greeley Surveyor  
of private Claims.

630

Township N. 1 North, Range N. 11 East of Mer. (Mich. Ter.)

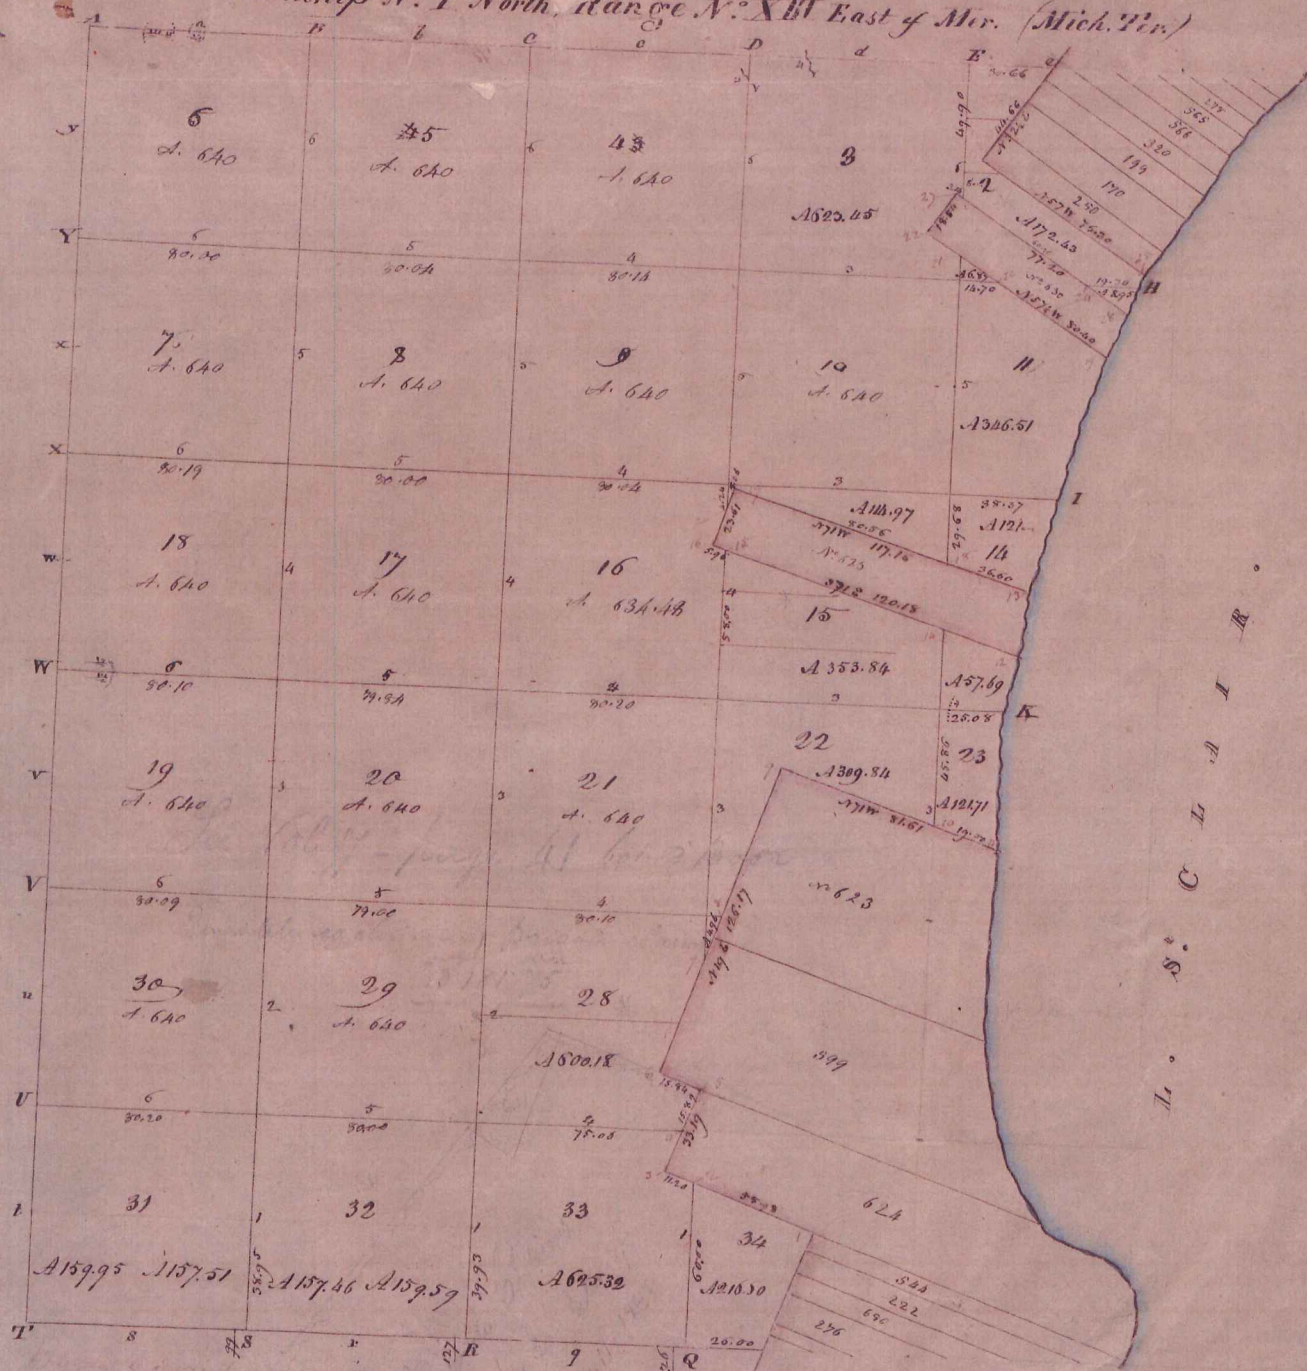


A true Copy from the Original on file in this Office

Surveyor General's Office  
 Feb 20 - 1854

Delmaria Tiffin  
 Surveyor General

copy

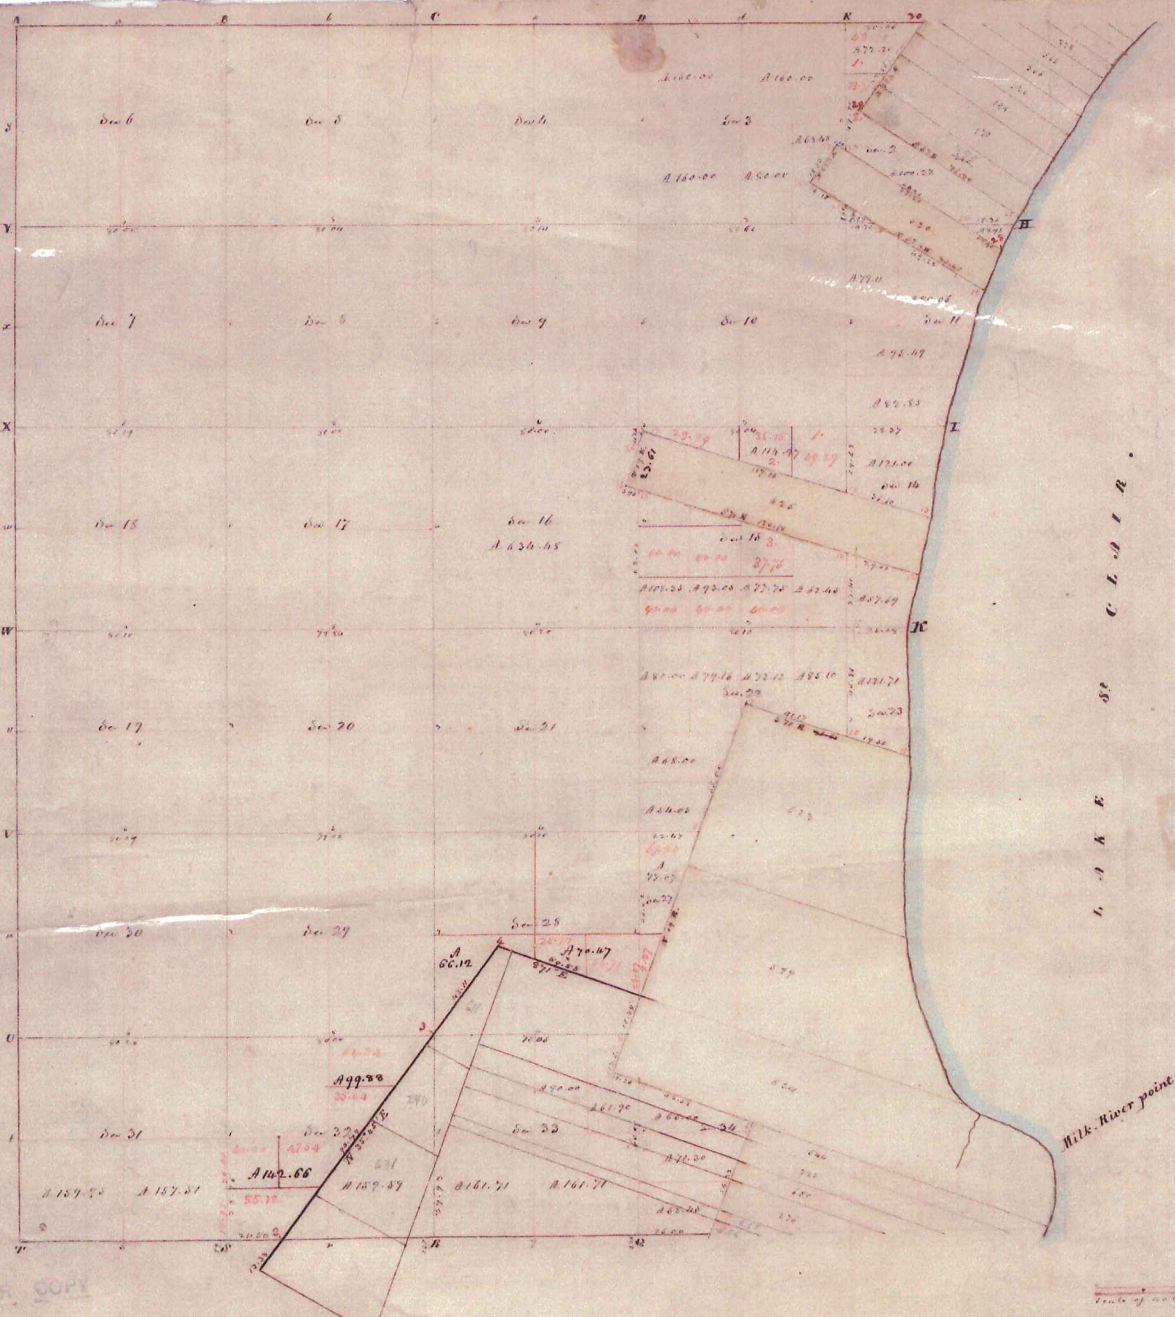

LOOR COPY

Scale of one centimetre = one inch

Township N: I North . Range N: XIII East of Mer. (Mich. Ter)

Surveyed by Wm. Preston .

1877

Description of the soil &c on the interior sectional lines .

Between Sections	Quality &c	Between Sections	Quality &c
5, 6	2 <sup>nd</sup> rate - part wet, W. Oak, Buck, Elm, Spruce	14, 9	2 <sup>nd</sup> rate level & dry; W. Oak, Buck, Sugar, Elm, Spruce
6, 7	3 <sup>rd</sup> rate, level & wet; B. Ash, Buck, Elm	3, 14	Same
7, 8	2 <sup>nd</sup> rate, part dry; B. Ash, Buck, Sugar, Spruce	9, 10	Same
7, 18	Same	9, 16	Same
17, 18	2 <sup>nd</sup> rate, good, level & dry; W. Oak, Poplar, Sugar, Elm	18, 16	2 <sup>nd</sup> rate level, wet; B. Ash, Buck, Elm, Spruce
18, 19	Same	16, 21	2 <sup>nd</sup> rate part dry; timber same
19, 20	Same	21, 22	2 <sup>nd</sup> rate; W. Oak, Poplar, Buck, Sugar, Spruce
29, 30	Same	21, 28	Same
30, 31	Same	27, 28	Same
31, 32	Same	28, 33	Same (part wet)
4, 5	Same	33, 34	Same
5, 8	3 <sup>rd</sup> rate level & wet; B. Ash, Buck, Elm &	2, 3	Same
8, 9	3 <sup>rd</sup> rate 1 <sup>st</sup> 1/2 mile, level & part dry 1/2 mile; B. Ash, Buck	2, 11	Same
16, 17	Same	10, 11	2 <sup>nd</sup> rate; W. Oak, Buck, Sugar, W. Spruce
17, 20	Same	14, 15	2 <sup>nd</sup> rate part dry; Buck, Elm &
20, 21	Same	14, 23	2 <sup>nd</sup> rate level & levelish
20, 29	Same	10, 15	2 <sup>nd</sup> rate part wet; Buck, Elm &
21, 22	Same	11, 14	Same



# MAP OF ERIN

Township 1 North Range 13 East

Scale 2 Inches to one Mile.

of the Meridian of Michigan.



# AVONDALE GARDENS

Examined and Approved


OF PART OF

June 25, 1920

J. S. Johnson  
Deputy Auditor General

P. C. 630, T. 1 N. R. 13 E.

## MACOMB COUNTY MICHIGAN

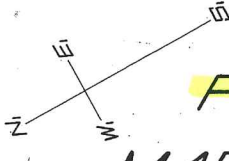

L. 4  
P. 91

SCALE 200' = 1"



### DEDICATION.

KNOW ALL MEN BY THESE PRESENTS, That we The Arcadia Land Company a Michigan corporation by John H. Meyering President and T. Ralph Meyering Treasurer and Noah Meloché a widower, as proprietors, have caused the land embraced in the annexed plat to be surveyed, laid out and platted to be known as AVONDALE GARDENS of part of P. C. 630, T. 1 N. R. 13 E., Macomb County, Michigan and that the streets as shown on said plat are hereby dedicated to the use of the public.

Signed and Sealed in the Presence of  
The Arcadia Land Company.  
John H. Meyering (President)  
T. Ralph Meyering (Treasurer)  
William F. Miller  
Noah Meloché (L.S.)

STATE OF MICHIGAN, ss.  
County of Macomb.

On this 15th day of April A.D. 1920 before me, a Notary Public in and for said county appeared John H. Meyering and J. Ralph Meyering to me personally known, who being each by me duly sworn did say that they are the President and Treasurer, respectively of the Arcadia Land Company a Michigan corporation, and that the seal affixed to said instrument is the corporate seal of said corporation and that said instrument was signed and sealed in behalf of said corporation by authority of its Board of Directors and the said John H. Meyering and J. Ralph Meyering acknowledged said instrument to be the free act and deed of said corporation.

John H. Meyering  
Notary Public, Macomb Co., Mich.

My Commission expires Dec. 30 - 1921.

STATE OF MICHIGAN, ss.  
County of Macomb.

On this 15th day of April 1920 before me, a Notary Public in and for said county, personally came the above named Noah Meloché a widower, known to me to be the person who executed the above dedication, and acknowledged the same to be his free act and deed.

John H. Meyering  
Notary Public, Macomb Co., Mich.

My Commission expires December 30, 1922

### DESCRIPTION.

The land embraced in the annexed plat of AVONDALE GARDENS of part of P. C. 630, T. 1 N. R. 13 E., Macomb County, Michigan is described as lands lying in P. C. 630, T. 1 N. R. 13 E., Macomb County, Michigan and more particularly described as follows, to wit: Beginning at a point on the northwesterly side line of Jefferson Avenue where the same is intersected by the southwesterly line of "Lake Boulevard Subdivision, of part of P. C. 630, T. 1 N. R. 13 E., Macomb County, Michigan"; thence N. 61° 15' W. a distance of 4502.25 feet to the northwesterly line of P. C. 630; thence S. 30° 23' W. a distance of 380.98 feet to the southwesterly line of said P. C. 630; thence S. 61° 05' 30" E. a distance of 4640.62 feet to the northwesterly side line of Jefferson Avenue; thence N. 10° 48' 30" E. a distance of 413.80 feet to place of beginning.

### ENGINEER'S CERTIFICATE.

I hereby certify that the plat hereon delineated is a correct one, and that permanent monuments, consisting of 1/2" iron gaspipe, 15" long have been planted at points marked thus (o) as thereon shown at all angles in the boundaries of the land platted, and at all intersections of streets.

John H. Meyering  
Registered Civil Engineer.

### CERTIFICATE OF TOWNSHIP BOARD.

This plat was approved by the Township Board of the Township of Lake at a meeting held April 22, 1920.

Peter Lehman  
Treasurer

### CERTIFICATE OF COUNTY BOARD.

This plat was approved on the 15th day of May 1920.

Neil Ericson  
Judge of Probate.

Walter C. Steffen  
County Clerk.

Hermon J. Bickel  
County Treasurer.

### CERTIFICATE OF COUNTY TREASURER.


Office of County Treasurer, Macomb County, May 15th 1920.

I hereby certify, That there are no tax liens or titles held by the State on the lands described above, and that there are no tax liens or titles held by individuals on said lands, for the five years preceding the 15th day of April 1920, and that the taxes for said period of five years have been paid, as shown by the records of this office.

Hermon J. Bickel  
County Treasurer.

1	172	173
2	172	174
3	171	175
4	170	176
100	74	272


REGISTER'S OFFICE  
COUNTY OF MACOMB  
Received for Record this 28th day  
June A.D. 1920 at  
P. 30 of Book A. Map Record  
to Part 4 of Plat  
page 91  
Jesse R. Ketchum

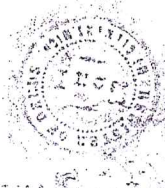

Sept 28-1915  
J. W. Miller

# MIDDLEBAY PARK SUBDIVISION

OF PART OF FR SECS 2, 3, 11 & P.C.  
630, T. 1 N. R. 13 E., LAKE TOWNSHIP,  
MACOMB COUNTY, MICH.

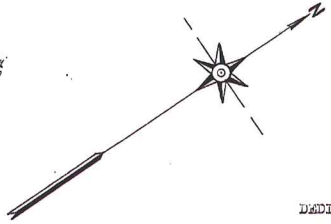

Scale: 1 inch = 200 feet

### DEDICATION

KNOW ALL MEN BY THESE PRESENTS, That we William Detour and Emily Detour, his wife, as mortgagees have caused the land embraced in the annexed plat to be surveyed, laid out and platted, to be known as Middlebay Park Subdivision of part of Fr. Sec's. 2, 3, 11 & P.C. 630, T. 1 N. R. 13 E., Lake Township, Macomb County, Mich. and that the streets and alleys as shown on said plat are hereby dedicated to the use of the public.

SIGNED AND SEALED IN THE PRESENCE OF

William Detour (L.S.)  
Emily Detour (L.S.)

### SURVEYORS CERTIFICATE

I hereby certify that the plat hereon delineated is a correct one, and that permanent monuments, consisting of 1 1/2" galvanized gas pipe 12" inches long have been planted at points marked thus (o) as thereon shown at all angles in the boundaries of the land platted, and at all intersections of streets or streets and alleys.

Walter J. Schaefer  
Surveyor

### TOWNSHIP APPROVAL

This plat was approved by the Township Board of the Township of Lake, Macomb County, Mich. at a meeting held Sept. 1915.

John Wilson  
Supervisor  
Edward C. ...  
Clerk

### CERTIFICATE OF APPROVAL BY COUNTY BOARD

This plat was approved on the 8th day of September, 1915.  
Neil E. Reed  
County Clerk  
William W. ...  
County Treasurer

### COUNTY TREASURER'S CERTIFICATE

Office of the County Treasurer, Mt. Clemens, Mich. Sept. 8, 1915  
I hereby certify that there are no tax liens or titles held by the State on the lands described below, and that there are no tax liens held by individuals for the five years preceding the 8th day of Sept. 1915 and that the taxes for said period of five years are paid as shown by the records of this office.

William W. ...  
County Treasurer

### DESCRIPTION

The land embraced in the annexed plat of Middlebay Park Subdivision of part of Fr. Sec's. 2, 3, 11 & P.C. 630 T. 1 N. R. 13 E., Lake Township, Macomb County, Mich. is described as follows: Commencing at the intersection of the northeasterly line of P.C. 630 and the westerly side line of Jefferson Ave. (so called); thence S. 15° 55' W. 179.00' along westerly side line of Jefferson Ave to a stake; thence N. 61° 31' W. 434.50 ft. to a stake; thence N. 29° 39' E. 429.50 ft. to a stake on the westerly line of said Jefferson Ave; thence S. 15° 55' W. 211.30 ft. to the place of beginning, containing 37 acres of land - Excepting a strip of land 15 ft. wide along the southwesternly side.

### DEDICATION

KNOW ALL MEN BY THESE PRESENTS, That we, The Meyerling Land Company, a Michigan Corporation, by John H. Meyerling, President and J. Ralph Meyerling, Treasurer, as proprietor, have caused the land embraced in the annexed plat to be surveyed, laid out and platted to be known as the Middlebay Park Subdivision of part of Fr. Sec's 2, 3, 11 and P.C. 630, T. 1 N. R. 13 E., Lake Township, Macomb County, Mich. and that the streets and alleys as shown on said plat are hereby dedicated to the use of the public.

Signed and Sealed in the Presence of

John H. Meyerling (President)  
J. Ralph Meyerling (Treasurer)  
THE MEYERLING LAND COMPANY.

STATE OF MICHIGAN )  
COUNTY OF MACOMB ) ss

On this 20th day of August, A.D. 1915 before me, a Notary Public in and for said county appeared John H. Meyerling and J. Ralph Meyerling to me personally known, who being each by me duly sworn did say that they are the President and Treasurer respectively of The Meyerling Land Company, a Michigan Corporation, and that the seal affixed to said instrument is the corporate seal of said corporation and that said instrument was signed and sealed in behalf of said corporation and that said instrument was signed and sealed by the Board of Directors and the said John H. Meyerling, and that J. Ralph Meyerling acknowledged said instrument to be the free act and deed of said corporation.

My Commission expires December 20th 1918. J. W. Miller  
Notary Public, Macomb County.

FR Sec 3	
170	86
169	85
168	84
85	1

L. 3  
P. 4  
By Commission (L.S. 1915) Surveyor for Fr. Sec's 2, 3, 11 & P.C. 630, T. 1 N. R. 13 E., Lake Township, Macomb County, Mich. at a meeting held Sept. 1915. J. W. Miller, Surveyor.



9281

Examined and Approved  
11/19/1931  
J. W. H. H. H.  
Deputy Auditor General

# ASSESSORS PLAT N<sup>o</sup> 31

A PART OF SEC. 11, T. 14 N. 13 E. & PART OF T. C. 630

VILLAGE OF ST CLAIR SHORES MACOMB CO. MICH.

SCALE 1"=200'

WALTER J. LEHNER - REG. C.E.  
MT. CLEMENS MICH.

L 15  
P 22  
See Grant of 8-30-31-51  
to Board of Health

### DEDICATION

KNOW ALL MEN BY THESE PRESENTS, that I, Adrian A. Lingsmann, Assessor of the Village of St. Clair Shores, Macomb County, State of Michigan, by virtue of authority in me vested by Section 51 Act 172 of P.A. 1929, having been duly authorized by the Village Commission, have caused the land described in the annexed plat to be surveyed, laid out and platted, to be known as "ASSESSORS PLAT NO. 31" a part of sec. 11, T. 14 N. 13 E. a part of T. C. 630 Village of St. Clair Shores, Macomb Co., Mich., and that the streets and alleys as shown on said plat have been dedicated to the use of the public.

Witnesses

Edith Allen  
Elizabeth Warner

STATE OF MICHIGAN }  
COUNTY OF MACOMB } SS

On this 21st day of Feb. 1931 before me a Notary Public in and for said county personally came the above named Adrian A. Lingsmann, Assessor of the Village of St. Clair Shores, known to me to be the person who executed the above dedication and acknowledged the same to be his free act and deed as such Assessor.

Chas. J. Diderich  
Notary Public in and for Macomb Co.

My Commission expires Feb 28 1932

### DESCRIPTION

The land embraced in the annexed plat of "ASSESSORS PLAT NO. 31" a part of sec. 11 T. 14 N. 13 E. a part of T. C. 630, Village of St. Clair Shores Macomb Co., Mich. is more fully described as follows:

Beginning at the intersection of the centerline of Jefferson Avenue and the south line of P.C. 630 thence S. 18° 57' E. 420.35 ft., thence N. 82° 20' E. 647.07 ft., thence S. 15° 44' E. 820.87 ft., thence southerly along the border of Lake St. Clair 1752.04 ft., thence N. 71° 17' W. 315.25 ft., thence N. 15° 47' E. 821.41 ft. to the point of beginning.

This plat was approved by the Village Commission of the Village of St. Clair Shores at a meeting held Feb 17-1931

Chas. J. Diderich  
Clerk

### SURVEYOR'S CERTIFICATE


I hereby certify that the plat hereon delineated is a correct one and that permanent metal monuments of not less than one inch in diameter and fifteen inches in length set in a concrete base at least ten inches in diameter and forty eight inches in length have been placed at points marked thus "M" as shown shown at all angles in the boundaries of the land, limited at all the intersections of streets, intersect one or alleys, or of streets and alleys, and at the intersections of streets and alleys with the boundaries of the plat as shown on said plat.

Walter J. Lehner  
Registered Civil Engineer

REGISTER'S OFFICE  
County of Macomb

Received for Record this 20 day of March A.D. 1931 at 4:30 o'clock P.M. and Recorded in Liber 158 of Plate on Page 27.  
Walter J. Lehner

This plat was approved by the County Board for Macomb County, Michigan, at a meeting held July 24, 1931  
Charles H. Hummel County Probate  
Walter J. Lehner County Clerk  
Walter J. Lehner County Treasurer

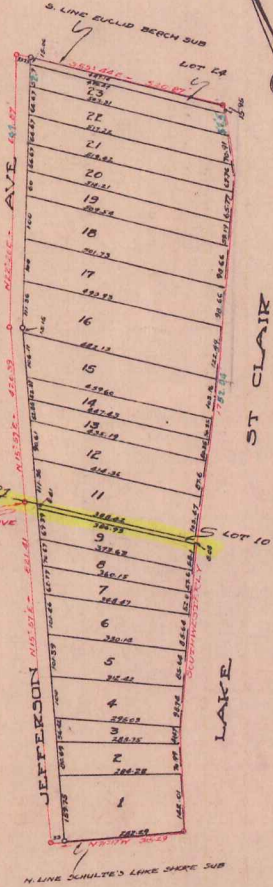

See right of way of 1562 P. 297