

LAND CORNER RECORDATION CERTIFICATE
Filing Requirement of Act 74, Mich. P.A. 1970

For corners in ERIN TOWNSHIP

<u>MACOMB</u> <small>(County)</small>	Located In:	Corner Code #
1. Public Land Survey	T <u>1N</u> R <u>13E</u>	<u>C-02</u>
	T _____ R _____	_____
	T _____ R _____	_____
2. Property Controlling	S _____ T _____ R _____	_____
in Section	S _____ T _____ R _____	_____
3. Miscellaneous	S _____ T _____ R _____	_____
Property in Sec.	S _____ T _____ R _____	_____

205063
 LIBER 9942 PAGE 528
 12/26/2000 09:19:20 A.M.
 MACOMB COUNTY, MI
 CARMELLA SABAUGH, REG/DEEDS

Register of Deeds Stamp & File Number

4. Lot No. _____, Recorded Plat _____

5. Private Claims _____

	A	B	C	D	E	F	G	H	I	J	K	L	M
1													
2	6		5		4		3		2		1		
3													
4	7		8		9		10		11		12		
5													
6	18		17		16		15		14		13		
7													
8	19		20		21		22		23		24		
9													
10	30		29		28		27		26		25		
11													
12	31		32		33		34		35		36		


I, JOHN R. FENN in a field survey on September 25, 2000 do hereby certify that under requirements of P.A. 74, Michigan P.A. of 1970, the corner points mentioned in lines 1 and 2 above were in conformance with regulations and rules therefore as required in the current manual of survey instructions of the United States Department of the Interior, Bureau of Land Management or by a decree of a Court of Law and /or that the corner points mentioned in lines 3, 4 and 5 above were in conformance with the rules of the Michigan Board of Land Surveyors or by a Decree of a Court of Law; established, re-established, monumented, re-monumented, recovered, found as expressed below:

NOTE: Not more than 4 corners, all in the same town and range, may be recorded on this certificate.

A. Description of original monument and accessories and/or subsequent restoration:

Glo 1817 Wampler No evidence of original corner
 1991 LCRC Frank DeDecker 8386 L5055, P837 Found PK with washer
 AZ 299° 55.74' nail w/MSHD tag in SW face U.P. Found
 AZ 219° 95.23' NE corner house #16758 (block) Found

- Plats
- 1930 Assessor's Plat No. 5 Village of Fraser L14, P29
 - 1930 Assessor's Plat No. 6 Village of Fraser L14, P30
 - 1949 Assessor's Plat No. 8 Village of Fraser L25, P10
 - 1954 Greer Subdivision L31, P13
 - 1955 Hartsig Manor L32, P29
 - 1958 Buttenshaw Subdivision L41, P7
 - 1990 York Gardens Subdivision L93, P36

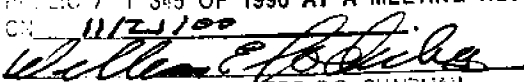ACCEPTED BY THE MACOMB COUNTY SURVEY BOARD AS THE OFFICIAL CORNER UNDER MICHIGAN PUBLIC ACT 345 OF 1990 AT A MEETING HELD ON 11/23/00

 WILLIAM E. SCDERBERG, P.S., CHAIRMAN

B. Description of corner evidence found and/or method applied in restoring or reestablishing corner:

I found an iron near the centerline of Masonic (asphalt) West of Utica Road. The Iron matches iron in several of the Subdivision tied to this corner. Two witnesses from the above LCRC verify the location.

Distances: C-01 to C-02 C-02 to C-03
 GLO 40 Chains or 2640 feet GLO 40 Chains or 2640 Feet
 Measure 2695.25 feet Measure 2711.28 feet


C. Description of monument for corner and accessories established to perpetuate locating the position of the corner:

I recommend that a standard 3/4" Iron Rod with a standard Macomb County Remonumentation Cap marked Act 345 - 23505 in a new monument box be located at the determined position.

- N60°E 79.91' Set PK with Macomb County Remon tag in Southeast face Utility Pole
- N25°E 50.04' Southeast corner garage at #32019 Masonic
- N65°W 55.79' Found nail with MSHD tag in Southwest face Utility Pole
- S35°W 95.05' Northeast corner of house #16758 Masonic (vinyl siding).

The selected location is accepted by me and is generally accepted by Professional Surveyors as the best position of the original corner.

Signed by John R. Fenn
 Surveyor's Michigan License No. 23505

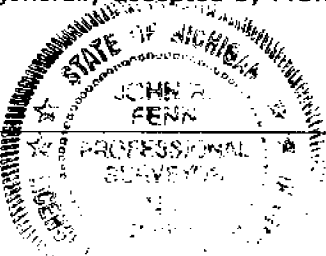

Date 12-19-2000

C-02

ERIN TOWNSHIP

T.1N.,R.13E.

WEST QUARTER CORNER SECTION 5

EAST QUARTER CORNER SECTION 6

C-02 ERIN TOWNSHIP

RECORDED INFORMATION:

GLO: 1817 Wampler No evidence of original corner

LCRC'S

1991 Frank DeDecker 8386 L.5055,P.837 Fd PK with washer

PLATS

1930 Assessor's Plat No. 5 Village of Fraser L14, P29

1930 Assessor's Plat No. 6 Village of Fraser L14, P30

1949 Assessor's Plat No. 8 Village of Fraser L25, P10

1954 Greer Subdivision L31, P13

1955 Hartsig Manor L32,P.29

1958 Buttenshaw Subdivision L41, P7

1991 York Gardens Subdivision L00, P000

FIELD

1991 LCRC DeDecker 8386 L5055, P837 Found PK with washer

AZ 66° 51.30' Nail w/MSHD tag in SE face UP

AZ 219° 95.23' NE corner of house #16738 (block) Found

AZ 299° 55.74' Nail w/MSHD tag in SW face U.P. Found

Az 349° 90.62' PK w/SDA tag in West face guy pole

FIELD EVIDENCE:

The corner has been perpetuated by a 1/2" Iron near the centerline of Masonic Boulevard, West of Utica Road. Irons found to the West and East confirmed the location. Masonic Boulevard is an asphalt surface. No occupation North or South from this corner.

RECOMMENDATION:

We recommend setting the standard 3/4" rerod with the standard Macomb County Remonumentation Cap stamped 23505 at the found position in a new monument box

DISTANCES:

C-01 TO C-02

GLO 40 chains or 2640 feet

Measure 2695.25 feet

C-02 to C-03

GLO 40 chains or 2640'

Measure 2711.28 feet

WITNESSES:

N60°E 79.91'

N25°E 50.04'

N65°W 55.79'

S35°W 95.05'

Set PK with MC Remon tag in SE face Utility Pole

Southeast corner garage at # 32019 Masonic

Found nail/tag MSHD in SW face Utility pole

Found Northeast corner house #16758 Masonic

LAND CORNER RECORDATION CERTIFICATE
Filing Requirement of Act 74, Mich. P.A. 1970

ERIN TOWNSHIP

For corners in

<u>MACOMB</u> <small>(County)</small>	Located In:	Corner Code #
1. Public Land Survey	T <u>1N</u> R <u>13E</u>	<u>C-02</u>
	T _____ R _____	_____
	T _____ R _____	_____
2. Property Controlling	S _____ T _____ R _____	_____
in Section	S _____ T _____ R _____	_____
3. Miscellaneous	S _____ T _____ R _____	_____
Property in Sec.	S _____ T _____ R _____	_____

Register of Deeds Stamp & File Number

4. Lot No. _____, Recorded Plat _____

5. Private Claims _____

1	A	B	C	D	E	F	G	H	I	J	K	L	M
2		6		5		4		3		2		1	
3													
4		7		8		9		10		11		12	
5													
6		18		17		16		15		14		13	
7													
8		19		20		21		22		23		24	
9													
10		30		29		28		27		26		25	
11													
12		31		32		33		34		35		36	

I, JOHN R. FENN in a field survey on September 25, 2000 do hereby certify that under requirements of P.A. 74, Michigan P.A. of 1970, the corner points mentioned in lines 1 and 2 above were in conformance with regulations and rules therefore as required in the current manual of survey instructions of the United States Department of the Interior, Bureau of Land Management or by a decree of a Court of Law and /or that the corner points mentioned in lines 3, 4 and 5 above were in conformance with the rules of the Michigan Board of Land Surveyors or by a Decree of a Court of Law; established, re-established, monumented, re-monumented, recovered, found as expressed below:

NOTE: Not more than 4 corners, all in the same town and range, may be recorded on this certificate.

A. Description of original monument and accessories and/or subsequent restoration:

Glo 1817 Wampler No evidence of original corner
 1991 LCRC Frank DeDecker 8386 L5055, P837 Found PK with washer
 AZ 299° 55.74' nail w/MSHD tag in SW face U.P. Found
 AZ 219° 95.23' NE corner house #16758 (block) Found

Plats
 1930 Assessor's Plat No. 5 Village of Fraser L14, P29
 1930 Assessor's Plat No. 6 Village of Fraser L14, P30
 1949 Assessor's Plat No. 8 Village of Fraser L25, P10
 1954 Greer Subdivision L31, P13
 1955 Hartsig Manor L32, P29
 1958 Buttenshaw Subdivision L41, P7

John R. Fenn

B. Description of corner evidence found and/or method applied in restoring or reestablishing corner:

I found an iron near the centerline of Masonic (asphalt) West of Utica Road. The Iron matches iron in several of the Subdivision tied to this corner. Two witnesses from the above LCRC verify the location.

Distances: C-01 to C-02 C-02 to C-03
 GLO 40 Chains or 2640 feet GLO 40 Chains or 2640 Feet
 Measure 2695.25 feet Measure 2711.28 feet

C. Description of monument for corner and accessories established to perpetuate locating the position of the corner:

I recommend that a standard 3/4" Iron Rod with a standard Macomb County Remonumentation Cap marked Act 345 - 23505 in a new monument box be located at the determined position.

N60°E 79.91' Set PK with Macomb County Remon tag in Southeast face Utility Pole
 N25°E 50.04' Southeast corner garage at #32019 Masonic
 N65°W 55.79' Found nail with MSHD tag in Southwest face Utility Pole
 S35°W 95.05' Northeast corner of house #16758 Masonic (vinyl siding).

The selected location is accepted by me and is generally accepted by Professional Surveyors as the best position of the original corner.

Signed by _____ Date _____

Surveyor's Michigan License No. 23505