

LAND CORNER RECORDATION CERTIFICATE
Filing Requirement of Act 74, Mich. P.A. 1970

For corners in

ERIN TOWNSHIP

<u>MACOMB</u> <small>(County)</small>	Located In:	Corner Code #
1. Public Land Survey	T <u>1N.</u> R <u>13E</u>	<u>C-04</u>
	T _____ R _____	_____
	T _____ R _____	_____
2. Property Controlling	S _____ T _____ R _____	_____
in Section	S _____ T _____ R _____	_____
3. Miscellaneous	S _____ T _____ R _____	_____
Property in Sec.	S _____ T _____ R _____	_____
4. Lot No. _____, Recorded Plat _____		
5. Private Claims _____		

205064
 LIBER 9942 PAGE 529
 12/26/2000 09:19:20 A.M.
 MACOMB COUNTY, MI
 CARMELLA SABAUGH, REG/DEEDS

Register of Deeds Stamp & File Number

	A	B	C	D	E	F	G	H	I	J	K	L	M
1													
2	6			5		4		3		2		1	
3													
4	7			8		9		10		11		12	
5													
6	18			17		16		15		14		13	
7													
8	19			20		21		22		23		24	
9													
10	30			29		28		27		26		25	
11													
12	31			32		33		34		35		36	


I, JOHN R. FENN in a field survey on September 25, 2000 do hereby certify that under requirements of P.A. 74, Michigan P.A. of 1970, the corner points mentioned in lines 1 and 2 above were in conformance with regulations and rules therefore as required in the current manual of survey instructions of the United States Department of the Interior, Bureau of Land Management or by a decree of a Court of Law and /or that the corner points mentioned in lines 3, 4 and 5 above were in conformance with the rules of the Michigan Board of Land Surveyors or by a Decree of a Court of Law; established, re-established, monumented, re-monumented, recovered, found as expressed below:

NOTE: Not more than 4 corners, all in the same town and range, may be recorded on this certificate.

A. Description of original monument and accessories and/or subsequent restoration:

Glo 1817 Wampler No evidence of original corner
 1986 LCRC Robert L. Smith 16052 L3928, P217 Found Iron
 N45°E 76.55' PK nail in power pole found
 N45°W 74.54' Top nut on hydrant Found
 South 34.0' PK nail in power pole

Plats
 1934 Supervisor's Plat No. 1 L16, P25
 1973 Eastland Industrial Park Sub. No. 1 L63, P38-41
 1973 East Pointe Subdivision L64, P29-30

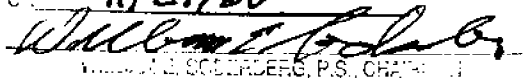ACCEPTED BY THE MACOMB COUNTY SURVEY PEER BOARD AS THE OFFICIAL CORNER UNDER MICHIGAN ACT 345 OF 1990 AT A MEETING HELD ON 11/21/00

 WILLIAM E. SCERDERS, P.S., CHAIRMAN

B. Description of corner evidence found and/or method applied in restoring or reestablishing corner:

I found an 1/2" iron in a monument box at the centerline of Common Road (concrete) East and West and Garfield Road (concrete) South. The found iron matches irons in several of the Subdivision tied to this corner. Three witnesses from the above LCRC verify the location.
 Distances: C-04 to C-03 C-04 to C-05
 GLO 40 Chains or 2640 feet GLO 40 Chains or 2640 Feet
 Measure 2642.15 feet Measure 2697.76 feet

C. Description of monument for corner and accessories established to perpetuate locating the position of the corner:

I recommend that a standard Macomb County Remonumentation Cap marked Act 345 23505 be placed on the found 1/2" iron in the existing monument box.

N20°W 74.83' Top of hydrant
 N45°E 76.48' Set PK with Macomb County remon tag in Southeast face Utility Pole
 S40°W 84.05' Northeast corner of house # 29969
 N40°W 184.40' Southeast corner of Turri's Italian Food building

The selected location is accepted by me and is generally accepted by Professional Surveyors as the best position of the original corner.

Signed by 
 Surveyor's Michigan License No. 23505



Date 12-19-2000

C-04

ERIN TOWNSHIP

T.1N.,R.13E.

WEST QUARTER CORNER SECTION 7

EAST QUARTER CORNER SECTION 8

C-04 ERIN TOWNSHIP

RECORDED INFORMATION:

GLO: 1817 Wampler No evidence of original corner

LCRC'S

1986	Robert L. Smith 16052	L.3928,P.217	Found Iron
	N45°E	76.55'*	PK nail in power pole found
	N45°W	74.54'*	Top nut on hydrant found
	South	34.0'*	PK nail in power pole found

PLATS

1934	Supervisor's Plat No. 1	L16, P25
1973	Eastland Industrial Park Sub. No. 1	L63, P38-41
1973	East Pointe Subdivision	L64, P29-30

FIELD EVIDENCE:

The corner has been perpetuated by a ½" Iron in a monument box at the intersection of Common Road (concrete) East and West and Garfield Road (concrete) to the North. Irons found to the West and East confirmed the location.

RECOMMENDATION:

I recommend setting the standard Macomb County Remonumentation Cap stamped 23505 on the found ½" iron in the existing monument box

DISTANCES:

C-04 TO C-03	C-04 to C-05
GLO 40 chains or 2640 feet	GLO 40 chains or 2640'
Measure 2642.15 feet	Measure 2697.76 feet

WITNESSES:

N20°W	74.83'	Top of Hydrant
N45°E	76.48'	Set PK with MC remon tag in SE face Utility Pole
S40°W	84.05'	Northeast corner Brick house # 29969
N40°W	184.40'	Southeast corner building Turri's Italian Food

LAND CORNER RECORDATION CERTIFICATE
Filing Requirement of Act 74, Mich. P.A. 1970
 ERIN TOWNSHIP

For corners in

<u>MACOMB</u> <small>(County)</small>	Located In:	Corner Code #
1. Public Land Survey	T <u>1N.</u> R <u>13E</u>	<u>C-04</u>
	T _____ R _____	_____
	T _____ R _____	_____
2. Property Controlling	S _____ T _____ R _____	_____
in Section	S _____ T _____ R _____	_____
3. Miscellaneous	S _____ T _____ R _____	_____
Property in Sec.	S _____ T _____ R _____	_____
4. Lot No. _____, Recorded Plat _____		
5. Private Claims _____		

Register of Deeds Stamp & File Number

I, JOHN R. FENN in a field survey on September 25, 2000 do hereby certify that under requirements of P.A. 74, Michigan P.A. of 1970, the corner points mentioned in lines 1 and 2 above were in conformance with regulations and rules therefore as required in the current manual of survey instructions of the United States Department of the Interior, Bureau of Land Management or by a decree of a Court of Law and /or that the corner points mentioned in lines 3, 4 and 5 above were in conformance with the rules of the Michigan Board of Land Surveyors or by a Decree of a Court of Law; established, re-established, monumented, re-monumented, recovered, found as expressed below:

	A	B	C	D	E	F	G	H	I	J	K	L	M
1													
2		6		5		4		3		2		1	
3													
4		3	●	8		9		10		11		12	
5													
6		18		17		16		15		14		13	
7													
8		19		20		21		22		23		24	
9													
10		30		29		28		27		26		25	
11													
12		31		32		33		34		35		36	

NOTE: Not more than 4 corners, all in the same town and range, may be recorded on this certificate.

A. Description of original monument and accessories and/or subsequent restoration:

Glo 1817 Wampler No evidence of original corner
 1986 LCRC Robert L. Smith 16052 L3928, P217 Found Iron
 N45°E 76.55' PK nail in power pole found
 N45°W 74.54' Top nut on hydrant Found
 South 34.0' PK nail in power pole

Plats
 1934 Supervisor's Plat No. 1 L16, P25
 1973 Eastland Industrial Park Sub. No. 1 L63, P38-41
 1973 East Pointe Subdivision L64, P29-30

B. Description of corner evidence found and/or method applied in restoring or reestablishing corner:

I found an 1/2" iron in a monument box at the centerline of Common Road (concrete) East and West and Garfield Road (concrete) South. The found Iron matches iron in several of the Subdivision tied to this corner. Three witnesses from the above LCRC verify the location.

Distances: C-04 to C-03 C-04 to C-05
 GLO 40 Chains or 2640 feet GLO 40 Chains or 2640 Feet
 Measure 2642.15 feet Measure 2697.76 feet

C. Description of monument for corner and accessories established to perpetuate locating the position of the corner:

I recommend that a standard Macomb County Remonumentation Cap marked Act 345 23505 be placed on the found 1/2" iron in the existing monument box.

N20°W 74.83' Top of hydrant
 N45°E 76.48' Set PK with Macomb County remon tag in Southeast face Utility Pole
 S40°W 84.05' Northeast corner of house # 29969
 N40°W 184.40' Southeast corner of Turri's Italian Food building

The selected location is accepted by me and is generally accepted by Professional Surveyors as the best position of the original corner.

Signed by _____ Date _____

Surveyor's Michigan License No. 23505

LAND CORNER RECORDATION CERTIFICATE

Filing Requirement of Act 74, Mich. P.A. 1970 RECORDED IN MACOMB COUNTY

RECORDS AT: 12:30 P.M.

For corners in

Macomb
(County)

Located In: Roseville Corner Code ##
Section 8

APR 16 1986

Edna Miller

CLERK - REGISTER OF DEEDS
MACOMB COUNTY, MICHIGAN

BC16300

Register of Deeds Stamp & File Number

- | | | | | | | | |
|-------------------------|---|---|----|---|----|----|-----|
| 1. Public Land Survey | T | 1 | N. | R | 13 | E. | C-4 |
| W. 1/4 corner | T | | | R | | | |
| | T | | | R | | | |
| | T | | | R | | | |
| | T | | | R | | | |
| 2. Property Controlling | S | | T | | R | | |
| in Section | S | | T | | R | | |
| 3. Miscellaneous | S | | T | | R | | |
| Property in Sec. | S | | T | | R | | |

4. Lot No. _____, Recorded Plat _____
5. Private Claims _____

	A	B	C	D	E	F	G	H	I	J	K
2	6		5		4		3		2		
3											
4	7		8		9		10		11		
5											
6	18		17		16		15		14		
7											
8	19		20		21		22		23		
9											
10	30		29		28		27		26		
11											
12	31		32		33		34		35		
13											

I, Robert L. Smith, in a field survey on February 7, 1986, do hereby certify that under requirements of P.A. 74, Michigan P.A. of 1970, the corner points mentioned in lines 1 and 2 above were in conformance with regulations and rules therefore as required in the current manual of survey instructions of the United States Department of the Interior, Bureau of Land Management or by a decree of a Court of Law and/or that the corner points mentioned in lines 3, 4 and 5 above were in conformance with the rules of the Michigan Board of Land Surveyors or by a Decree of a Court of Law; established, re-established, monumented, re-monumented, recovered, found as expressed below:

NOTE: Not more than 4 corners, all in the same town and range, may be recorded on this certificate.

A. Description of original monument and accessories and/or subsequent restoration:


B. Description of corner evidence found and/or method applied in restoring or reestablishing corner:

C-4 Found iron

C. Description of monument for corner and accessories established to perpetuate locating the position of the corner:

- Shot # 111 C-4 P.K. nail in power pole N.45°E. 76.'55 FOUND DECC. WIT
- Shot # 110 Top nut on hydrant N.45°W. 74.'54 FOUND DECC. WIT
- Shot # 112 P.K. nail in power pole South 34.'0 FOUND DECC WIT

NOTING
WRITTEN ON
IT.

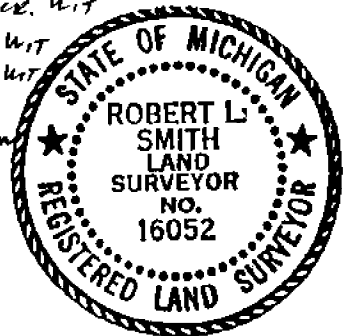

Signed by Robert L. Smith

Date 2/20/86

01197

Surveyor's Michigan License No. 15052

500
MISC