

LAND CORNER RECORDATION CERTIFICATE
Filing Requirement of Act 74, Mich. P.A. 1970
 ERIN TOWNSHIP

For corners in

MACOMB Located In: _____ Corner Code # _____
(County)

1. Public Land Survey T 1N. R 13E _____ I-03 _____
 T _____ R _____
 T _____ R _____
 T _____ R _____

2. Property Controlling S _____ T _____ R _____
 in Section S _____ T _____ R _____

3. Miscellaneous S _____ T _____ R _____
 Property in Sec. S _____ T _____ R _____

4. Lot No. _____, Recorded Plat _____

5. Private Claims _____

205070
 LIBER 9942 PAGE 535
 12/26/2000 09:19:20 A.M.
 MACOMB COUNTY, MI
 CARMELLA SABAGH, REG/DEEDS

Register of Deeds Stamp & File Number

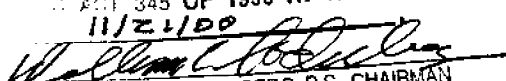
	A	B	C	D	E	F	G	H	I	J	K	L	M
1													
2	6			5			4		3		2		1
3													
4	7			8			9		10		11		12
5													
6	18			17			16		15		14		13
7													
8	19			20			21		22		23		24
9													
10	30			29			28		27		26		25
11													
12	31			32			33		34		35		36

I, JOHN R. FENN in a field survey on September 16, 2000 do hereby certify that under requirements of P.A. 74, Michigan P.A. of 1970, the corner points mentioned in lines 1 and 2 above were in conformance with regulations and rules therefore as required in the current manual of survey instructions of the United States Department of the Interior, Bureau of Land Management or by a decree of a Court of Law and /or that the corner points mentioned in lines 3, 4 and 5 above were in conformance with the rules of the Michigan Board of Land Surveyors or by a Decree of a Court of Law; established, re-established, monumented, re-monumented, recovered, found as expressed below:

NOTE: Not more than 4 corners, all in the same town and range, may be recorded on this certificate.

A. Description of original monument and accessories and/or subsequent restoration:

- Glo 1817 Wampler No evidence of original corner
- No Recorded LCRC's for this corner
- Plats:
 - 1920 Lake Shore Little Farms Annex No. 3 L4, P89
 - 1920 Everts' Subdivision L5, P10
 - 1931 Assessor's Plat No. 34 L15, P25
 - 1955 William P. Hull Subdivision No. 1 L31, P35

ACCEPTED BY THE MACOMB COUNTY SURVEY PEAR
 AS THE OFFICIAL CORNER UNDER MICHIGAN
 ACT 345 OF 1990 AT A MEETING HELD
 11/21/00

 WILLIAM E. SCERBERG, P.S., CHAIRMAN

B. Description of corner evidence found and/or method applied in restoring or reestablishing corner:

I found nothing at this location. This corner is at the intersection of 13 Mile Road (concrete) and Greater Mack (concrete) in St. Clair Shores. We found Irons in all four directions. We used Irons in Lake Shore Little Farms Annex No. 3 to the Southeast to establish the corner location. The position was verified by Irons from the Subdivisions. This position requires a new monument box.

Distances:
 I-03 to I-02 I-03 to H-03
 GLO 40 chains or 2640 feet GLO 40 chains or 2640 feet
 Measure 2784.89 feet Measure 2716.04 feet

C. Description of monument for corner and accessories established to perpetuate locating the position of the corner:

I recommend that a standard 3/4" Iron Rod with a standard Macomb County Remonumentation Cap marked Act 345 23505 in a new monument box be located at the determined position.

S40°W 42.59' Set PK nail with Macomb County Remon tag in Southeast face Utility Pole
 N30°W 76.04' Set PK nail with Macomb County Remon tag in Southwest face 22" Maple
 N40°E 41.21' Set PK nail with Macomb County Remon tag in West face Utility Pole
 S40°E 79.75' Northwest corner of house #22450

The selected location is accepted by me and is generally accepted by Professional Surveyors as the best position of the original corner.

Signed by 



Date 12-19-2000

Surveyor's Michigan License No. 23505

I-03

ERIN TOWNSHIP

T.1N.,R.13E.

SOUTHWEST CORNER SECTION 2

SOUTHEAST CORNER SECTION 3

NORTHEAST CORNER SECTION 10

NORTHWEST CORNER SECTION 11

I-02 ERIN TOWNSHIP

RECORDED INFORMATION:

GLO: 1817 Wampler No evidence of original corner

LCRC'S

None previously recorded

PLATS

1920 Lake Shore Little Farms Annex No. 3 L4, P89

1920 Everts' Subdivision L5, P10

1931 Assessor's Plat No. 34 L15, P25

1955 William P. Hull Subdivision No. 1 L31, P35

FIELD EVIDENCE:

This corner is located at the intersection of 13 Mile Road (concrete) and Greater Mack (concrete). There was nothing found at this corner location. We found irons in all four directions. We used the Irons in "Lake Shore Little Farms Annex No. 3" to the Southeast to establish the corner location. We then used irons in other Subdivision to verify the location.

RECOMMENDATION:

After evaluating the found irons I recommend setting the corner from the above mentioned Irons. This corner would require a new monument box.

DISTANCES:

I-03 TO I-02

GLO 40 chains or 2640 feet

Measure 2784.78 feet

I-03 to H-03

GLO 40 chains or 2640'

Measure 2716.04 Feet

WITNESSES:

S40°W 42.59'

Set PK nail/remon tag in SE face utility pole

N30°W 76.04'

Set PK nail/remon tag in SW face 22" Maple

N40°E 41.21'

Set PK nail/remon tag in West face utility pole

S40°E 79.75'

NW corner House #22450