

LAND CORNER RECORDATION CERTIFICATE
Filing Requirement of Act 74, Mich. P.A. 1970 as Amended

For corners in


Table with columns: Macomb (County), Located In: City of St. Clair Shores, Corner Code #, and a list of survey types (Public Land Survey, Property Controlling, etc.) with corresponding T/R/E/S codes.

8128282
LIBER 19566 PAGE 4
11/20/2008 09:24:57 A.M.
MACOMB COUNTY, MI
CARNELLA SABAUGH, REGISTER OF DEEDS

Register of Deeds Stamp & File Number

- 4. Lot No. , Recorded Plat
5. Private Claims

I, Craig P. Amey, in a field survey on May 08, 2008 do hereby state that under requirements of P.A. 74, Michigan P.A. of 1970, the corner points mentioned in lines 1 and 2 above were in conformance with regulations and rules therefore as required in the current manual of survey instructions of the United States Department of the Interior, Bureau of Land Management or by a decree of a Court of Law and /or that the corner points mentioned in lines 3, 4 and 5 above were in conformance with the rules of the Michigan Board of Land Surveyors or by a Decree of a Court of Law; established, re-established, monumented, recovered, found as expressed below:

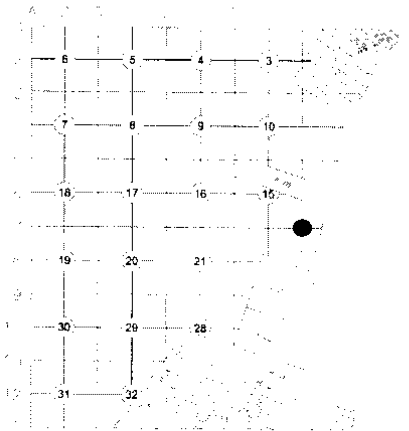

NOTE: Not more than 2 corners, all in the same town and range, may be recorded on this certificate.

ACCEPTED BY THE MACOMB COUNTY SURVEY PEER GROUP AS THE OFFICIAL CORNER UNDER MICHIGAN PUBLIC ACT 345 OF 1990 AT A MEETING HELD ON 8-26-08

MARTIN C. DUNN, P.S. CHAIRMAN

A. Description of original monument and accessories and/or subsequent restoration:

Table with columns: Item, Date, L, P, Document, Name, #, Cor. Desc., Witnesses Found. Contains 6 rows of survey data.

B. Description of corner evidence found and/or method applied in restoring or reestablishing corner: We did not find the PK as recorded in Item #6. We did find all of the witnesses from item #6 and we reestablished I-07 from the witnesses. This position agrees with found monumentation in Shorewood Manor (Item 5). Monumentation in Item 2 reestablished a position 26' feet west and 10' south of the chiseled "X". Monumentation in Item 3 reestablished a position 1.9' east and 2.1' south of the chiseled "X". Since the position established from the LCRC agrees with the monumentation in Shorewood Manor, and it is within 0.1' of the physical centerline of 11 Mile Rd, we believe this position is the best location for the perpetuation of I-07.

Distances

Table with columns: I-7 to I-5, I-7 to I-8, I-7 to H-7, I-7 to J7. Contains distance measurements in feet and GLO (Globe Offset) in feet and inches.

C. Description of monument for corner and accessories established to perpetuate locating the position of the corner:

I replaced the chiseled "X" with a 3/4" x 24" iron with 2" aluminum cap stamped "MACOMB COUNTY MONUMENT MI ACT 345 1990 MCL I-07 PS 34970" in a new monument box.

Table with columns: Az, Distance, Description. Lists bearings and distances to various corners of a garage and library.




THE SELECTED LOCATION IS ACCEPTED BY ME AND IS GENERALLY ACCEPTED BY PROFESSIONAL SURVEYORS AS THE BEST AVAILABLE EVIDENCE OF THE POSITION OF THIS CORNER.

Signed by [Signature] Surveyor's Michigan License No. 34970

Date Nov 12, 2008



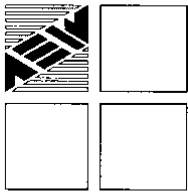


ANDERSON, ECKSTEIN AND WESTRICK, INC.

51301 Schoenherr Road, Shelby Township, Michigan 48315
Civil Engineers • Surveyors • Architects 586-726-1234

2008 Remonumentation
Corner: I-07

Index

- I. Section 1
 - A. Index
 - B. Photographs
- II. Section 2
 - A. LCRC
 - B. Surveyor's Report
- III. Section 3
 - A. Field Notes
 - 1. Corner Witnesses
 - B. Sketch
 - C. Composites
 - 1. 14E
 - 2. 15G
 - 3. 22D
 - 4. 23A
- IV. Section 4
 - A. GLO Notes and Plats
 - 1. Page 240 GLO
 - 2. Grove Pointe Gardens
 - 3. Miller and Tanner Subdivision
 - 4. A. P. No. 22
 - 5. Shorewood Manor
 - 6. LCRC L8893 P500

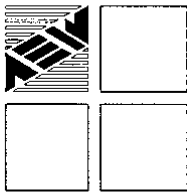

A. J. DERSON, ECKSTEIN AND WESTRICK, INC.

51301 Schoenherr Road, Shelby Township, Michigan 48315
Civil Engineers • Surveyors • Architects 586-726-1234

2008 Remonumentation Corner: I-07

Surveyor's Report

In 2008, we were contracted by Macomb County to remonument I-07, which is the section corner common to section 14, 15, 22 and 23, pursuant to ACT 345 of 1990.

In early February, we solicited information from area surveyors. None of the surveyors contacted had any unrecorded information pertinent to this corner. We also researched the public records. We only found 1 LCRC.

During a field survey for this corner, conducted on May 8, 2008, we found nothing at the corner. 11 Mile has been replaced recently and the section corner was not perpetuated.

Corners H-07 was previously remonumented. J-07, which is the intersection of the section line with Lake St. Clair has not been remonumented. I-06 falls within a private claim and was never established during the GLO surveys. Corners set at the intersections of Private Claim 625 and the section line have not been remonumented. I-08 and I-09 also have not been remonumented.

Using the recorded LCRC, we were able to reestablish I-07. We chiseled an "X" in the center of 11 Mile Road (concrete), 0.1' north of the centerline joint.

LCRC	L. 8893 P. 500	Robert Smith	Found P.K.
N.30° E.	68.85	SW corner of garage #22501 11 Mile Rd. (68.85)	
N.45°W.	79.50	SE Corner of garage #27700 Jefferson (79.50)	
S. 45°W.	72.95	NW Corner of SCS Library (72.89)	
S.10°E	70.95	NE Corner of SCS Library (70.86)	

We then attempted to verify the location of the point using adjacent subdivisions. The found monumentation in Shorewood Manor agreed with the chiseled "X". The found monumentation in Grove Point Gardens established a position 26.1' west and 10.4' south. Subdivisions to the south are not aligned with the section line. Instead, they are aligned with PC 625. Miller and Tanner Subdivision is the closest subdivision in which we could find monumentation. However, the legal description of the plat does not close by more than 20 feet. We did use the found monumentation in this sub and attempted to reestablish a position of I-07 and the location was 1.9' east and 2.1 feet south of the chiseled "X".

Since Shorewood Manor was the only subdivision that incorporated I-07 in its boundary, and since it also agrees with the LCRC, I believe the chiseled "X" is the best location for the perpetuation of I-07.

Respectfully Submitted,

Craig P. Amey, PS

223-032
8-7-88

2009 REV. 1.1

I-7

SET X 0.10' N. OF
E JOINT SH. 11 MILE

Ac DIST DIST
N 30° E 19.50' SE COR. GATE # 22501 11 MILE
(SEE 68.85')

N 45° W 77.50' SE COR. GATE # 27700 11 MILE
(SEE 70.95')


S 45° W 72.95' NW COR. SCS LIBRARY
(SEE 72.95')

SIDE TO 86 NE COR. SCS LIBRARY
(SEE 70.95')


SEE TOP 11.5, 12.1 W

#30 24574.028 24574.691

No 2705 39

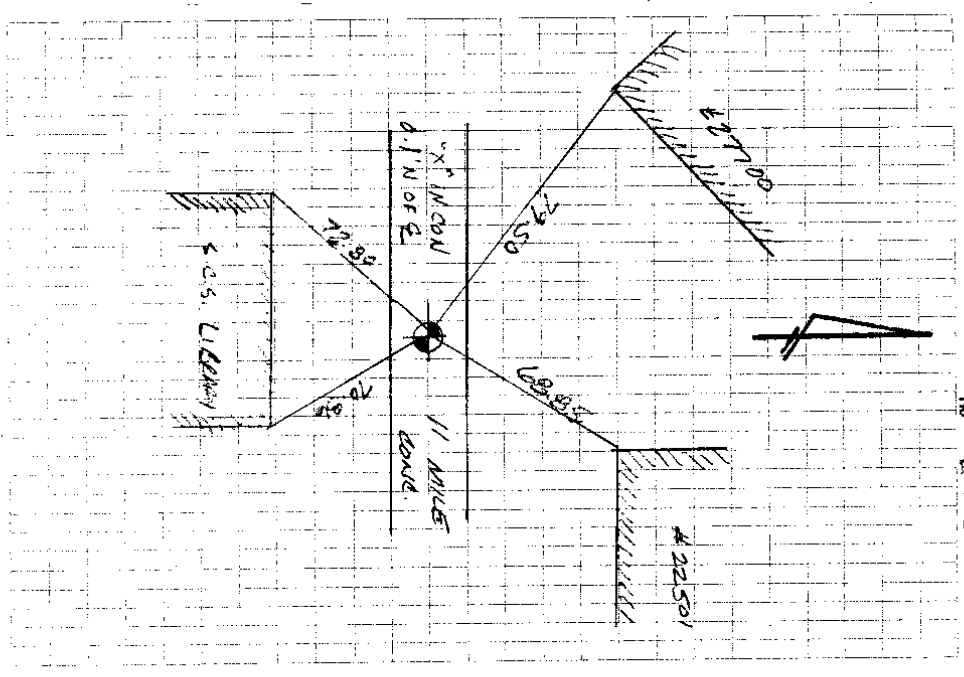

Corner Code: I-07
 Town: 01N
 Range: 13E
 Object Found: None


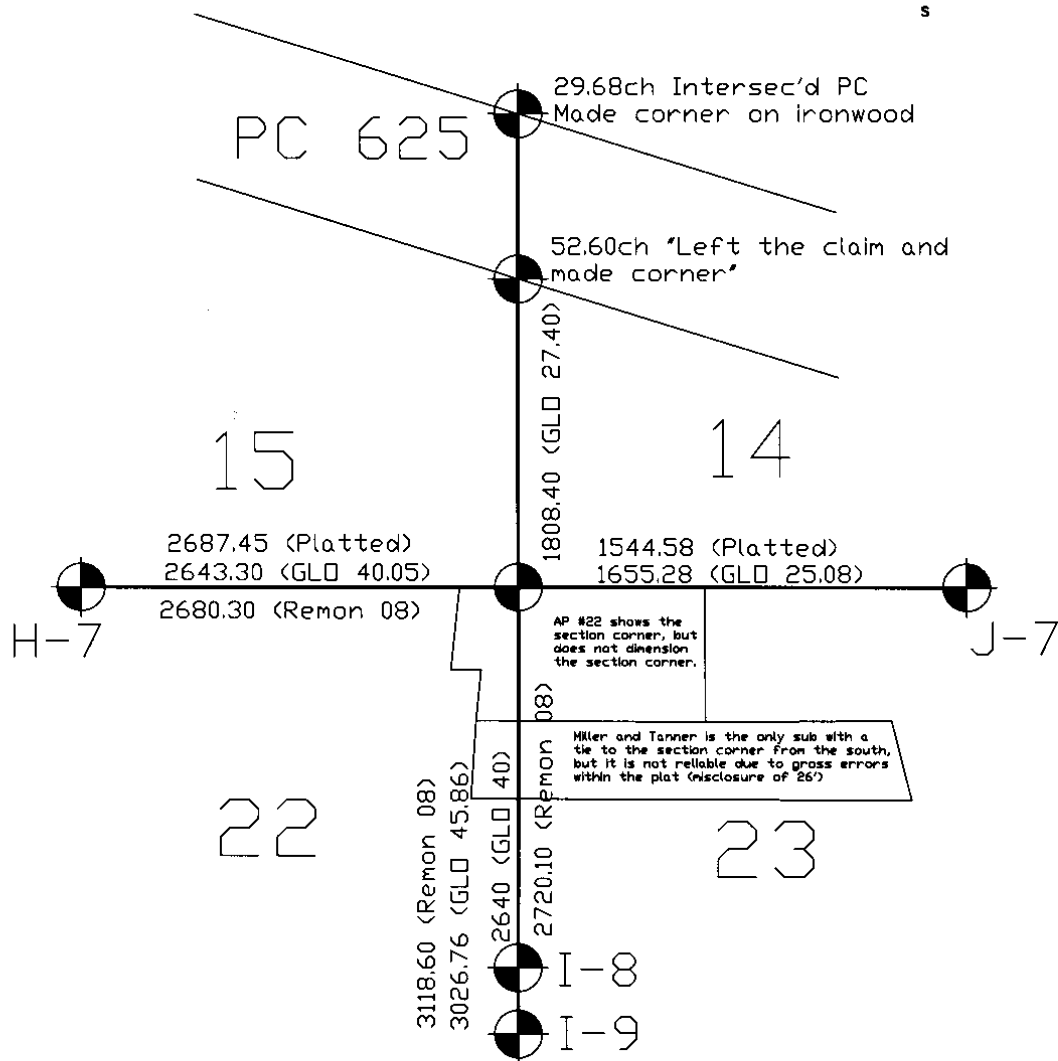


**ANDERSON, ECKSTEIN
 AND WESTRICK, INC.**
 Civil Engineers • Surveyors • Architects
 51301 Schoenherr Road, Shelby Township, Michigan 48315
 Phone 586•726•1234 Fax 586•726•8780

PROJECT



**Macomb Co.
 Remon
 2008**

DATE	PROJECT NO.
05/08	223-032
DRAWN BY	SHEET No.
cpa	
CHECKED BY	I-07
cpa	

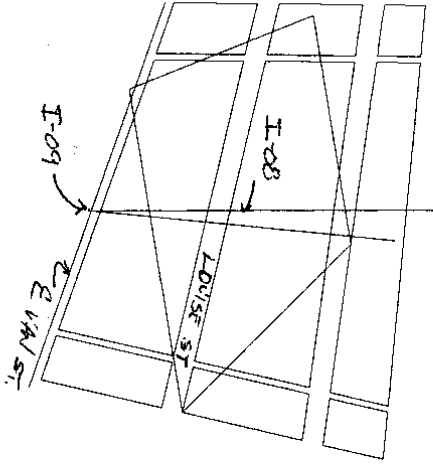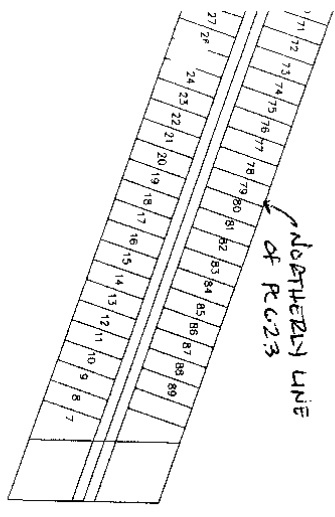

030-192

030-191

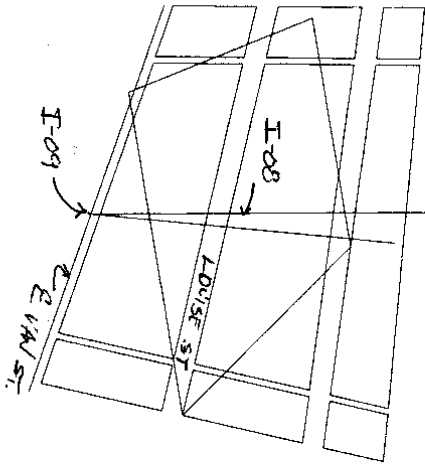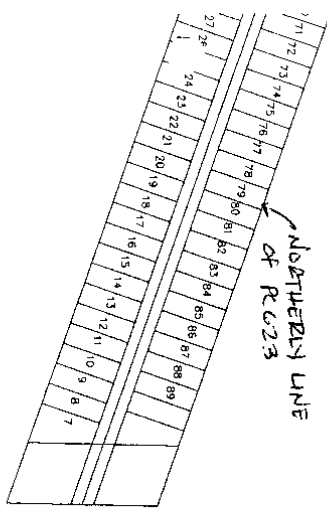


MAP OF ERIN

Township 1 North Range 13 East

Scale 2 inches to one Mile.


of the Meritons of Minnesota

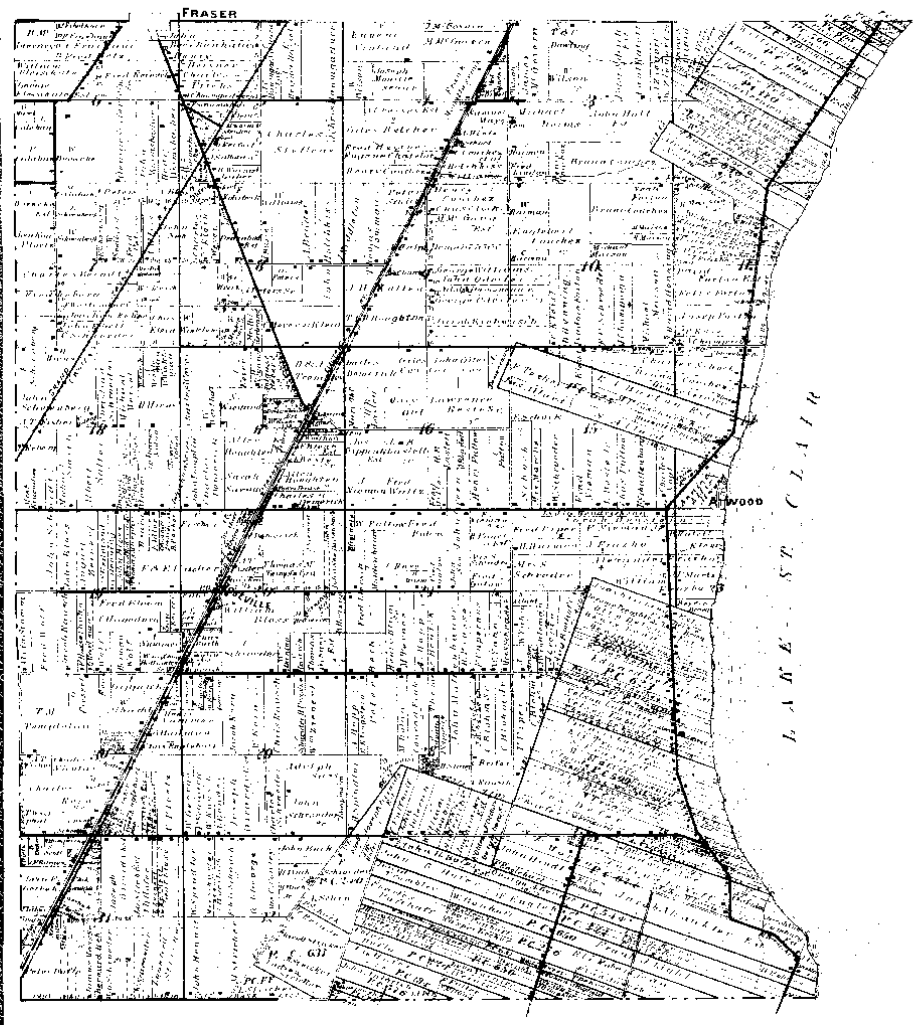

L A N E S T. C L A I R

1895


Scanned By
METCO
Engineers, Architects & Surveyors

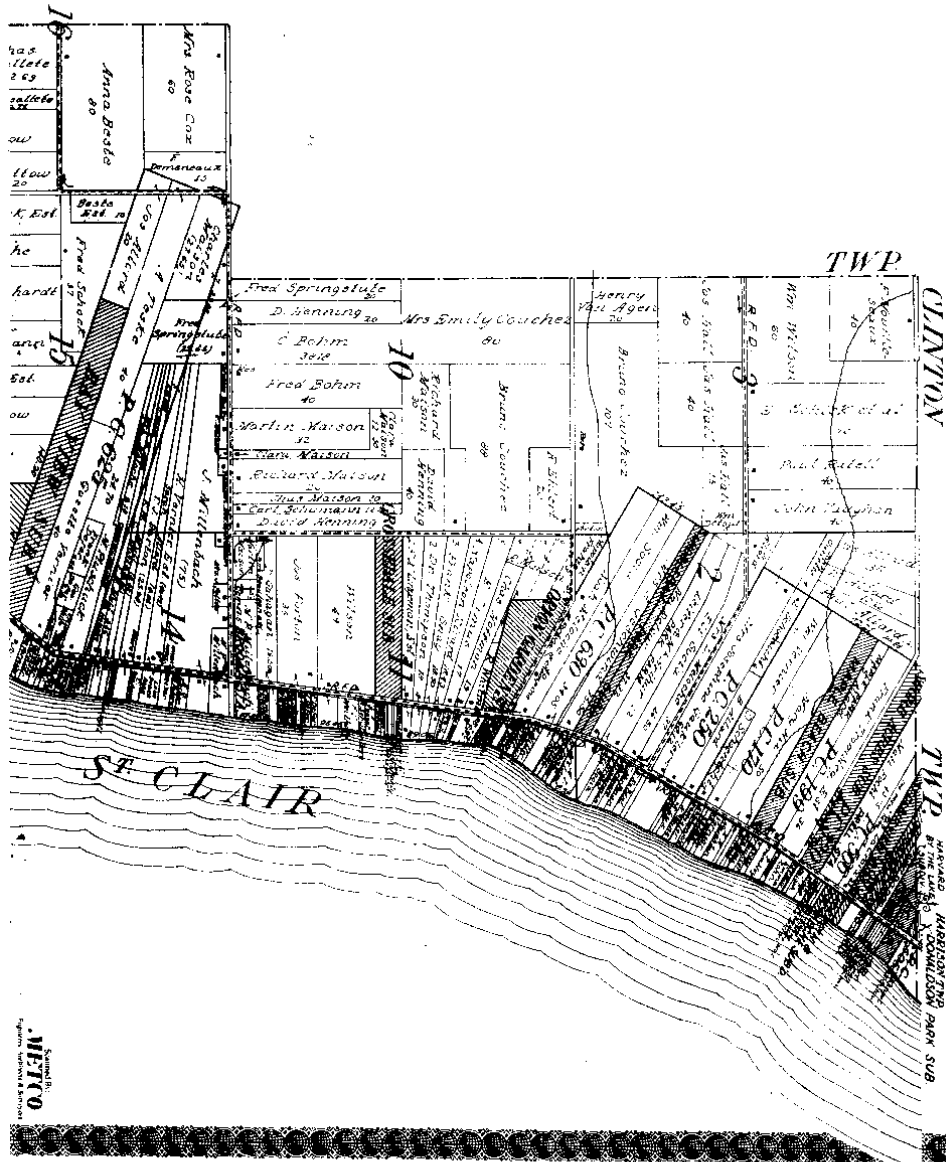

Part of Sectional Township 36 North, Range 18 East of the Skagitton Meridian



1916-1

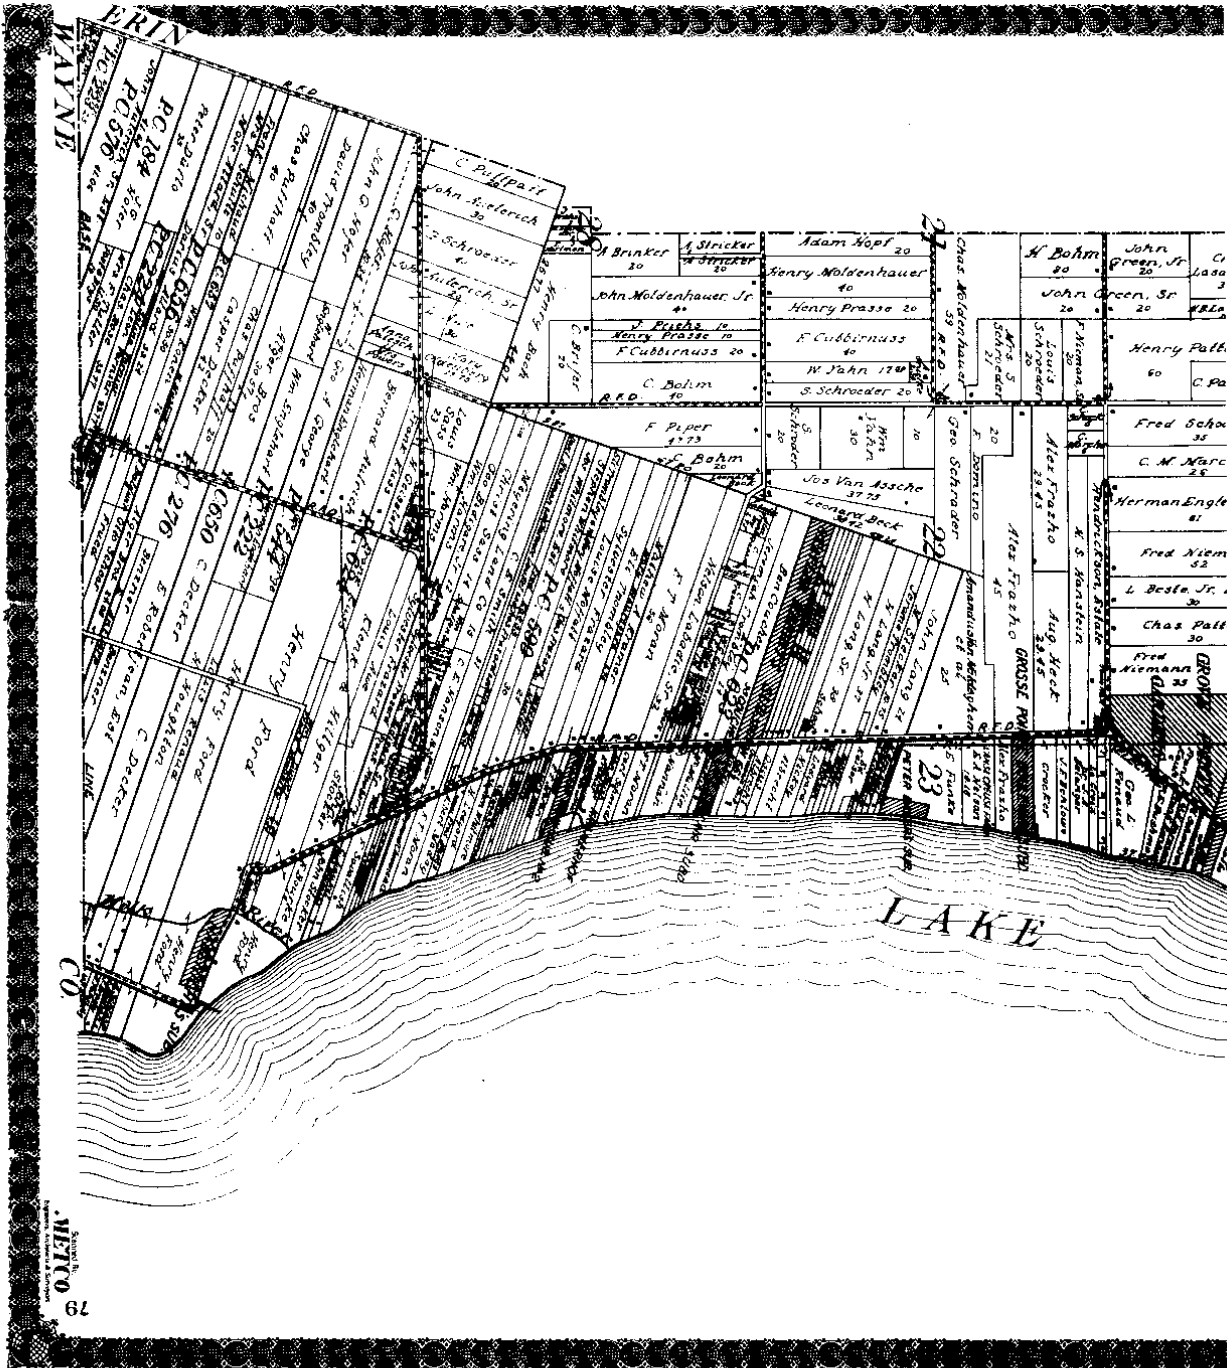

1916-2

Tran 1 North Range 13 East.

the claim and made corner for
frac sections 14 + 15

Buck 12 N 71 E 17

Do. 9 S 9 W 15

20.00 Set post for frac sections 14 + 15 + 22 + 23
from which two Elm 24 in dia bears
N 111 E 11 links dia also an Elm 22
in dia bears S 24 E 13 links dist
Part dry 2^d rate timber Buck Elm
40.

East Between sections 14 + 23

3.50 Enter a Prairie

25.08 Put Lake St Clair and set post
for fraction sections 14 + 23

from which a Sycamore 24 in dia
bears S. 10 W 6.50 also a Baldpate
Yilliad 30 in dia bears North
177 links dist

Wet and marshy 3rd rate

West On Random between Sec. 15 + 22

40.00 Set temporary post

80.10 Intersected N + S line at sec. cor.

East On True line between Sec. 15 + 22

40.05 Set 4 sec corner with 10 S 4 W 7


Sym 12 N 50 W 12

Generally low wet land well timbered

GROVE POINTE GARDENS

A SUBDIVISION OF PART OF FRACTIONAL SECTIONS 14 AND 15 LAKE TOWNSHIP MACOMBS CO, MICH.

SCALE 200 FT. = 1 IN.

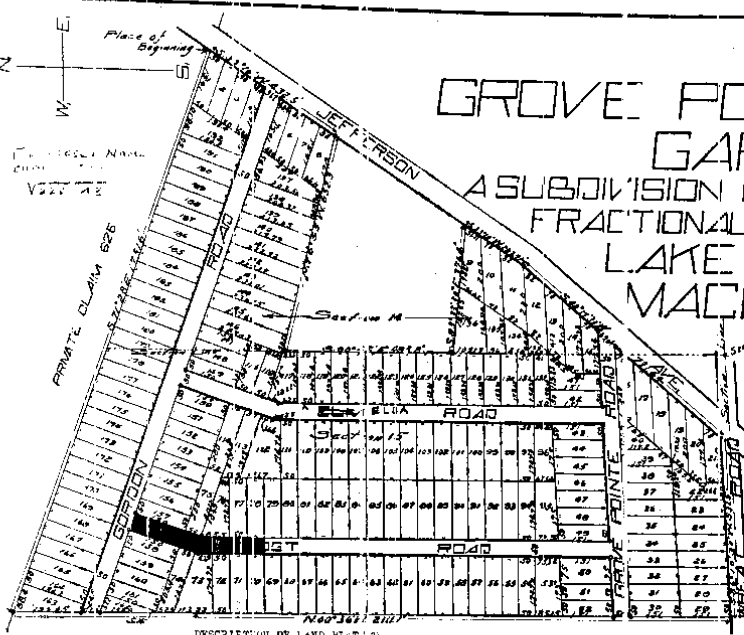

Witness
John H. Meyer
J. Ralph Meyer
Charles H. Webb

VACATED BY RESOLUTION OF CITY COUNCIL
MARCH 5 1915
VOUCHER NO. 638-57

Note: - All dimensions shown on this plat are in feet and decimals of a foot.

DESCRIPTION OF LAND PLATING.
The land embraced in the annexed plat of Grove Pointe Gardens A Subdivision of part of Fractional Sections 14 and 15, Lake Township, Macomb Co., Mich., is described as follows: - Beginning at a point on the northwesterly side line of Jefferson Avenue (so called) where the same is intersected by the line between Private Claim 625 and the northerly line of the southeast fractional quarter section of Section 14, T. 1 N. R. 13 E.; thence S. 33° 10' W. along the northwesterly side of said Jefferson Avenue a distance of four hundred thirty-two and five tenths (432.5) feet; thence N. 76° 50' W. a distance of six hundred fifty-two and three tenths (652.3) feet to the easterly line of Section 15; thence S. 00° 45' E. along said section line a distance of four hundred twenty-five and eight tenths (425.8) feet; thence S. 63° 35' 30" E. a distance of nine hundred seventy-six and four tenths (976.4) feet to the northwesterly side of said Jefferson Avenue; thence S. 22° 20' W. along the northwesterly side of said Jefferson Avenue a distance of two hundred three and seventy-one hundredths (203.71) feet; thence S. 40° 17' 30" W. along the northwesterly side of said Jefferson Avenue a distance of seven hundred eighty-one and sixty-four hundredths (781.64) feet to the northerly side line of the Wheat Road (so called); thence S. 86° 10' 30" E. along the northerly side of said Wheat Road a distance of five hundred thirty-one and five tenths (531.5) feet; thence N. 00° 30' W. a distance of twenty-one hundred eleven and one tenth (2111.1) feet to the line between Private Claim 625 and the northerly line of the southeast fractional quarter section of Section 15; thence S. 71° 28' E. a distance of seventeen hundred fifty-one and six tenths (1751.6) feet to place of beginning, lying all in the southeast fractional quarter section of Section 14 and the southeast fractional quarter section of Section 15, T. 1 N. R. 13 E.

KNOW ALL MEN BY THESE PRESENTS, That we, The Meyerling Land Company, a Michigan corporation, by John H. Meyerling President and J. Ralph Meyerling Treasurer and Carl Vogt and Dora Vogt his wife, as proprietors, have caused the land embraced in the annexed plat to be surveyed, laid out and platted to be known as Grove Pointe Gardens A Subdivision of part of Fractional Sections 14 and 15, Lake Township, Macomb Co., Mich. and that the streets as shown on said plat are hereby dedicated to the use of the public.

SIGNED AND SEALED IN THE PRESENCE OF
.....
.....
.....
.....

STATE OF MICHIGAN
County of Macomb) ss.
On this 11th day of March A.D. 1915, before me, a Notary Public in and for said county, personally came the above named Carl Vogt and Dora Vogt his wife, known to me to be the persons who executed the above dedication, and acknowledged the same to be their free act and deed.

STATE OF MICHIGAN
County of Macomb) ss.
On this 11th day of March A.D. 1915, before me, a Notary Public in and for said county, personally came the above named Carl Vogt and Dora Vogt his wife, known to me to be the persons who executed the above dedication, and acknowledged the same to be their free act and deed.

ENGINEER'S CERTIFICATE.
I hereby certify that the plat herein delineated is a correct one, and that permanent monuments, consisting of 4" x 24" gas pipe have been planted at points marked thereon at all angles in the boundaries of the land platted, and at all intersections of streets.
J. W. Irwin Civil Engineer.

COUNTY TREASURER'S CERTIFICATE.
Office of County Treasurer, Macomb County, State of Mich., March 10, 1915.
I HEREBY CERTIFY that there are no tax liens or titles held by the State on the lands described above, and that there are no tax liens or titles held by individuals on said lands, for the five years preceding the 10th day of March 1915, and that the taxes for said period of five years are paid as shown by the records of this office.
William H. Gruse County Treasurer.

CERTIFICATE OF TOWNSHIP BOARD.
This plat was approved by the Town Board of the Township of Lake, Macomb County, Michigan at a meeting held March 13, 1915.
Howard C. Hindt Clerk.

CERTIFICATE OF BOARD OF SUPERVISORS.
This plat was approved by the Board of Supervisors of the County of Macomb and State of Michigan at a meeting held March 15, 1915.

Filed in Auditor General's Dep't
MAR 22 1915
Charles H. Webb

Miller and Tanner Subdiv.
of
Part of Section 22 and Part Sect.
23 T.1.N.R.13.E. Township of Lake
Macomb Co. Mich.

Examined and J...
Mar 14 1917
C. L. Haines

9313

Scale 1" = 100

I hereby certify that the plat hereon delineated is a correct one, and that permanent monuments consisting of 3/4 by 1 1/2 iron pipe have been placed at points marked thus "M" as shown shown at all angles in the boundaries of the land platted, and at all intersections of streets or alleys and alleys

W. J. Miller
Surveyor

The land embraced in the annexed plat of Miller and Tanner Subdiv. of part of Section 22 and Part Sect 23 T.1.N.R.13.E. Township of Lake Macomb Co. Mich. is described as follows:—beginning at a point S. 1° 30' W. 582.05 feet from the north-east corner of Section 22, thence N. 88° 30' E. 1355.41 feet to a point thence S. 1° 30' W. 272.60 feet to a point thence S. 89° 30' W. 1752.91 feet to a point in the corner line of Jefferson Ave. thence N. 11° E. 1660 feet along the center line of Jefferson Ave. to a stake thence N. 03° 30' E. 347.47 feet to the point of beginning.

Know All Men By These Presents, That we Francis J. Miller } as proprietors
John A. Tanner } Sophia Miller his wife
John F. Bohler } Christine M. Tanner his wife
as Natyons }
have caused the land embraced in the annexed plat to be surveyed, laid out and platted, to be known as "Miller and Tanner Subdiv." of part of Section 22 and Part Sect. 23 T.1.N.R.13.E. Township of Lake Macomb Co. Mich. and that the streets and alleys as shown on said plat are hereby dedicated to the use of the lot owners only, in said subdivision.


Signed and Sealed in presence of
W. J. Miller
John A. Tanner
Christine M. Tanner
John F. Bohler

This plat was approved by the Township Board of the Township of Lake at a meeting held on Jan 22nd 1917
Edward C. Schmidt
Clerk.

(State of Michigan) }
County of Wayne } ss.
On this 9th day of January A. D. 1917 before me, a Notary Public in and for said county, personally came the above named Francis J. Miller, John A. Tanner, John F. Bohler, Sophia Miller, Christine M. Tanner, and I caused them to sign and swear to me to be the persons who executed the above dedication, and acknowledged the same to be their free act and deed.
William C. Schmidt
Notary Public, Wayne Co. Mich.
My Commission expires April 10 - 1920

This Plat was approved by the County Board of Macomb County, this 9th day of February 4 1917

W. J. Miller, Probate
John A. Tanner, Clerk
Christine M. Tanner, Attorney

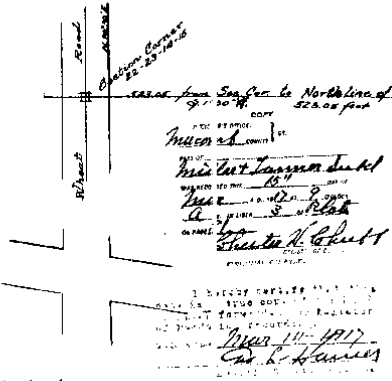

This is to certify that there exists no prior title held by the State, any individual agent, and that all title on lands described in this plat is derived from the State of Michigan, and that the same is in full compliance with the record of this State.
MAR 21 - 1917
W. J. Miller, Surveyor

Filed in Auditor General's Office
Mar 16 1917
C. L. Haines


ASSESSORS PLAT N^o 22

OF PART OF FRL. SECS. 14, 15, 22 & 23 T.14. R. 13E.
VILLAGE OF ST CLAIR SHORES MACOMB CO. MICH.

Aug 7 1930
Chas. J. Hansen

SCALE 1"=100'

WALTER J. LENNER, REG. C.E.
ST. CLEMENS, MICH.

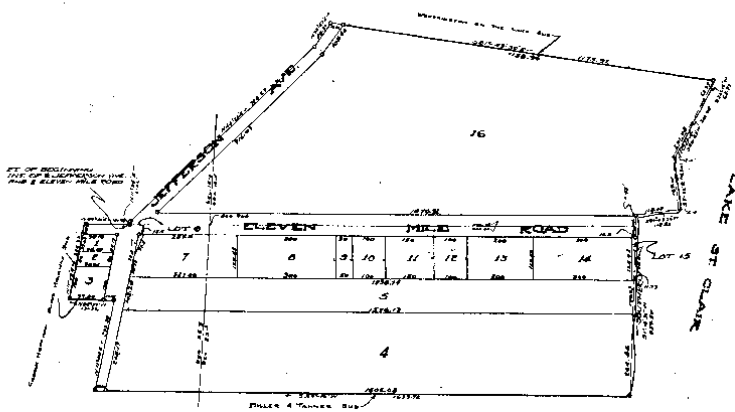

DESCRIPTION

KNOW ALL MEN BY THESE PRESENTS, That I, ADRIAN A. LINGGEMAN, assessor of the village of St. Clair Shores, Macomb County, State of Michigan, by virtue of authority in me vested by Section 51, Act 192 P. A. 1929 having been duly authorized by the Village Commission have caused the herein enclosed plat of "ASSESSORS PLAT NO. 22" of part of Frl. Secs. 14, 15, 22 & 23, T. 14, R. 13E. of the Village of St. Clair Shores, Macomb Co., Michigan, and that therein and all ways on said plat are hereby dedicated to the use of the public.

Witnessed
Chas. J. Hansen
ASSESSOR OF THE VILLAGE OF ST. CLAIR SHORES

Gold M. Allen
Elizabeth Warner

STATE OF MICHIGAN)
COUNTY OF MACOMB) SS

On this 15th day of July, A.D. 1930 before me a Notary Public in and for said county personally by and in the name of ADRIAN A. LINGGEMAN, Assessor of the Village of St. Clair Shores, known to me to be the party who executed the above dedication and acknowledged the same to be his freewill and deed as such Assessor.

Chas. J. Hansen
Notary Public in and for _____ Co.

My Commission expires July 28 1932

DESCRIPTION

The land embraced in the annexed plat of "ASSESSORS PLAT NO. 22" of part of Frl. Secs. 14, 15, 22 & 23 T. 14, R. 13E. of the village of St. Clair Shores, Macomb Co., Mich., is described as follows:

Beginning at the intersection of the centerline of Canton Ave., with the center line of Seven Hills Road thence S. 11°04' E. 6.52 ft., thence S. 44°20' E. 784.23 ft., thence S. 34°57' E. 88.97 ft., thence S. 51°49'30" E. 1175.92 ft., thence easterly along the shore of Lake St. Clair 1105.4 ft., thence S. 85°18' W. 1625.74 ft., thence S. 11°04' W. 243.34 ft., thence S. 85°21' W. 131.32 ft., thence S. 11°09' E. 236.53 ft., thence S. 09°02' E. 131.92 ft., to the point of beginning.

This plat was approved by the Village Commission of the Village of St. Clair Shores, at a meeting held July 15 1930

Chas. J. Hansen
CLERK

SURVEYORS CERTIFICATE

I hereby certify that the plat herein delineated is a correct one and that permanent metal monuments of not less than one inch in diameter and fifteen inches in length set at a concrete base at least four inches in diameter and forty eight inches in depth have been placed at points marked thus "0" or thereon shown at all angles in the boundaries of the land platted, at all the intersections of streets, intersections of alleys, or of streets and alleys, and at the intersections of streets and alleys with the boundaries of the plat as shown on said plat.

This plat was approved by the Village Board for Macomb County, Michigan, at a meeting held July 28 1930
Walter J. Lenner Village Engineer
John E. Hansen County Clerk
Adrian A. Linggeman County Treasurer


REGISTER'S OFFICE
County of Macomb

Received for Record this 7th day of AUG 1930 A.D. 1930 at 10:15 o'clock AM and Recorded in Liber 157 of St. Clair on Page 4
Walter J. Lenner Register

See Report of part of plat 16, Assessment, Macomb and Lewis of Plat. Copy 1/4

SHOREWOOD MANOR
BEING A SUBDIVISION OF PART OF FRACTIONAL SECTIONS 14 AND 15,
T.14N. R.13E.
CITY OF ST. CLAIR SHORES, MACOMB COUNTY, MICHIGAN
SCALE 1"=150'

Note: All dimensions shown are shown in feet and decimal thereof. Curved line
dimensions are given along the arc.

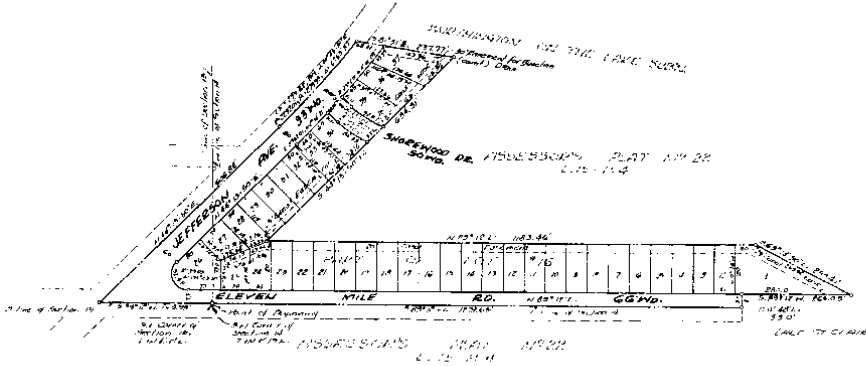

Description

The land embraced in the annexed plat of "Shorewood Manor being a subd'n. of parts of fractional sections 14 and 15, T.14N. R.13E., City of St. Clair Shores, Macomb County, Michigan," being part of Lot 15 of Assessor's Plat No. 12 as reported in Liber 15 Page 3 of Plat, Macomb County records, is described as follows: Beginning at the southeast corner of section 15, T.14N. R.13E.; thence S. 89°-12' W., along the south line of Section 15, 209.59'; thence N. 81°-59' E., along the center line of Jefferson Avenue (20' wide), 404.84'; thence northerly, along the center line of Jefferson Avenue, 279.99'; and thence along a radius of 1292.01', whose central angle is 6°-59'-59" and whose chord bears N. 60°-40'-17" W., 229.82'; thence S. 81°-59' E., 237.71'; thence S. 46°-11'-10" W., 314.31'; thence N. 79°-42' E., 1183.66'; thence S. 63°-11'-13" E., 259.12'; thence S. 67°-12' W., 205.01'; S. 67°-28' E., 334.0'; thence S. 89°-12' W., along the south line of Section 14, 1277.51' to the point of beginning.

Dedication

Know all men by these presents, that we, Irma S. Constantine, as principal, and Alfred Faubus and Son, a co-partnership consisting of Alfred Faubus and George Faubus, copartners, as witnesses, have caused the land embraced in the annexed plat to be surveyed, laid out and divided to be known as "Shorewood Manor being a subd'n. of parts of fractional sections 14 and 15, T.14N. R.13E., City of St. Clair Shores, Macomb County, Michigan," and that the streets as shown on said plat are hereby dedicated to the use of the public and that the easements indicated are hereby reserved for the use of the lot owners.

Signed and Sealed

In the presence of:
[Signature] [Signature]
Edna L. A. Stover Irma S. Constantine
Alfred Faubus and Son

Witnessed by:
[Signature] [Signature]
Alfred Faubus and Son George Faubus, partner

Acknowledgment

State of Michigan) ss
County of Macomb)
On this 7 day of April, 1951, before me, a Notary Public in and for said county, personally appeared the above named Irma S. Constantine and Alfred Faubus and Son, a co-partnership consisting of Alfred Faubus and George Faubus, copartners, known to me to be the persons who executed the above dedication and acknowledged the same to be their free act and deed.

[Signature]
Notary Public for Macomb County
My Commission expires 12/31/52

Approved by City of St. Clair Shores Planning Commission on the _____ day of _____ 1951.

[Signature]
Chairman R.M. Pitts
[Signature]
Secretary R.H. Jones

Municipal Approval

This plat was approved by the Council of the City of St. Clair Shores as a reading held _____ 1951.

[Signature]
City Manager

Approval of County Plat Board

This plat was approved on the _____ day of _____ 1951 by the Macomb County Plat Board.

Register of Deeds, Macomb County
[Signature]
Notary Public
[Signature]
Frank E. Lohr
Deputy Commissioner, Frank E. Lohr

Surveyor's Certificate

I hereby certify that the true boundaries of the land shown on the plat herein are as shown and as indicated by the lines shown thereon, and that the same are in accordance with the original survey of the land shown on the plat herein, and that the same are in accordance with the original survey of the land shown on the plat herein, and that the same are in accordance with the original survey of the land shown on the plat herein.

[Signature]
Notary Public
Notarized Land Surveyor

THIS CERTIFICATE WAS PREPARED BY THE COUNTY REGISTER OF DEEDS IN ACCORDANCE WITH THE ACTS OF THE LEGISLATURE OF THE STATE OF MICHIGAN, PASSED APRIL 1, 1915, AND APRIL 1, 1916, AND IS VALID FOR THE TERM OF FIVE YEARS PREVIOUS TO DATE OF THIS INSTRUMENT.

APPROVE
[Signature]
Notary Public
Notarized Land Surveyor

LAND CORNER RECORDATION CERTIFICATE
Filing Requirement of Act 74, Mich. P.A. 1970

For corners in

<u>MACOMB</u>	Located In:	Corner Code <u>##</u>
<small>(County)</small>	<u>ST. CLAIR SHORES</u>	
1. Public Land Survey	<u>T 1N R 13E</u>	<u>I-7</u>
	T ___ R ___	_____
	T ___ R ___	_____
	T ___ R ___	_____
2. Property Controlling in Section	<u>S 14 T 1N R 13E</u>	_____
	S ___ T ___ R ___	_____
3. Miscellaneous Property in Sec.	S ___ T ___ R ___	_____
	S ___ T ___ R ___	_____
4. Lot No. _____	Recorded Plat _____	
5. Private Claims _____		

Register of Deeds Stamp & File Number

I, ROBERT L. SMITH, in a field survey on JUNE 2, 1999
do hereby certify that under requirements of P.A. 74, Michigan P.A. of 1970, the corner points mentioned
in lines 1 and 2 above were in conformance with regulations and rules therefore as required in the
current manual of survey instructions of the United States Department of the Interior, Bureau of Land
Management or by a decree of a Court of Law and/or that the corner points mentioned in lines 3, 4 and 5
above were in conformance with the rules of the Michigan Board of Land Surveyors or by a Decree of a
Court of Law; established, re-established, monumented, re-monumented, recovered, found as
expressed below:

**NOTE: Not more than 4 corners, all in the same town and range, may be recorded
on this certificate.**

	A	B	C	D	E	F	G	H	I	J	K	L	M
2	6	5	4	3	2	1							
3													
4	7	8	9	10	11	12							
5													
6	18	17	16	15	14	13							
7													
8	19	20	21	22	23	24							
9													
10	30	29	28	27	26	25							
11													
12	31	32	33	34	35	36							
13													


A. Description of original monument and accessories and/or subsequent restoration:

B. Description of corner evidence found and/or method applied in restoring or reestablishing corner:

FOUND P.K. NAIL IN CENTERLINE ± OF 11 MILE ROAD
 AGREES WITH RE-ESTABLISHMENT OF "GROVE POINTE GARDENS SUB.," LIBER 2, PAGE 237,
 MACOMB COUNTY RECORDS AND "SHOREWOOD MANOR SUB.," LIBER 81, PAGE 14, MACOMB COUNTY RECORDS

C. Description of monument for corner and accessories established to perpetuate locating the position of the corner:

FOUND P.K. NAIL IN CENTERLINE OF 11 MILE ROAD
 N.30°E. 68.85' S.W. CORNER OF GARAGE OF #22501 11 MILE RD.
 N.45°W. 79.50' S.E. CORNER OF GARAGE OF #27700 JEFFERSON
 S.45°W. 72.95' N.W. CORNER OF ST. CLAIR SHORES LIBRARY
 S.10°E. 70.95' N.E. CORNER OF ST. CLAIR SHORES LIBRARY

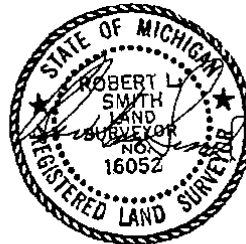

Signed by Robert L. Smith Date JUNE 2, 1999
 Surveyor's Michigan License No. 16052