

RECD MACOMB CO *18JUL12AM 8 48

8078533 PAGE 1 OF 3
LIBER 25463 PAGE 769
07/12/2018 10:56:49 A.M.
MACOMB COUNTY, MI SEAL
KATHY SMITH, REGISTER OF DEEDS

**Land Corner Recordation Certificate
2018 Annual Grant Agreement**
Authority: MICH. 1970 PA 74, MCL 54.205


"LCRC BEING RECORDED FOR THE PURPOSE OF PUBLISHING MICHIGAN STATE PLANE COORDINATE DATA"

Surveyor's Name: Steven E. Dunn, P.S.
For Corner(s) in: Macomb County

Field Survey Date: May 4, 2018
Municipality: Clinton Township

Corner Type	Section Private Claim	Clinton Township	Corner Code	Other Code
Original Public Land Survey Corner	PC 164/173	T 02 N R 13 E		PC 037

Other Code Corner Description: Southwest corner of Private Claim 173 Common with the Northwest corner of Private Claim 164

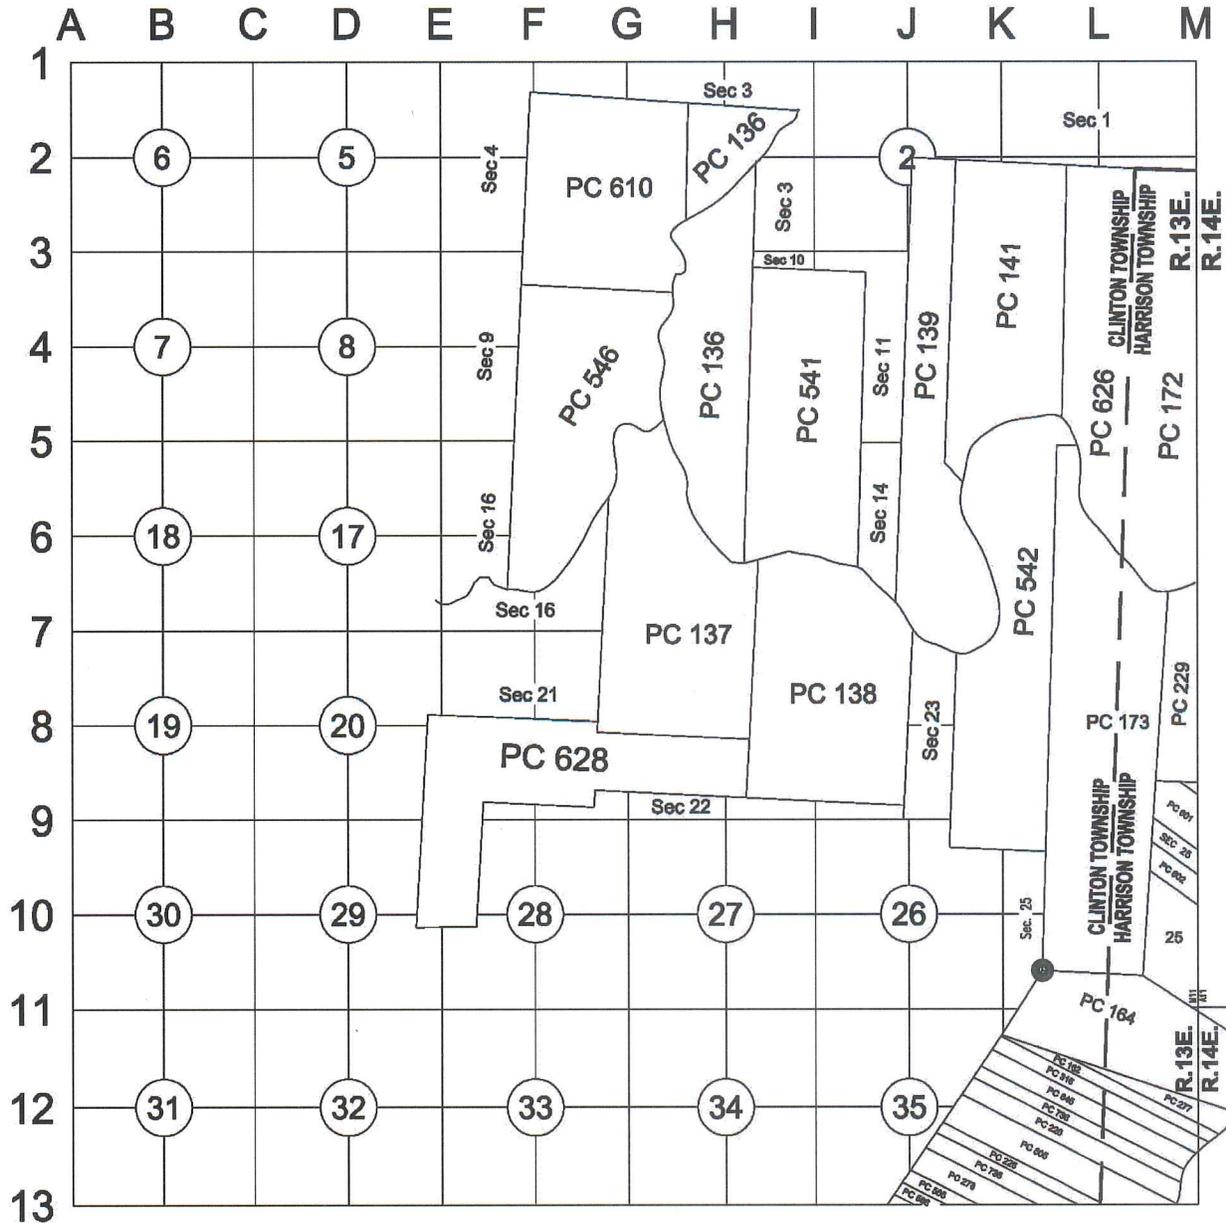

3

C

Part A: Corner History: Southwest corner of Private Claim 173 Common with the Northwest corner of Private Claim 164. Set Post Original GLO Survey Notes – 1810.

12-18-2014 LCRC for Remonumentation Corner by Christopher A. Asiala, PS #49376 PC 037 recorded in L. 23164 of Deeds on P. 808-810. "The corner falls within the front concrete porch of house #35627 Shook Lane and cannot be set. I set Reference Corner (Witness Monument) S87°32'47"E, 28.00' from the corner's position on the south line of Private Claim 173 in the public concrete sidewalk."

Witness Monument: Placed a new ½"x18" iron rod with a 2" aluminum cap stamped "MACOMB COUNTY MONUMENT MI ACT 345 CAA 49376 RC PC-037" flush with concrete pavement S87°32'47"E, 28.00' from the corner's position with 4 accessories.
Peer Review Group Approval: October 14, 2014

Part B: Surveyor's Report on Perpetuation, Restoration, Reestablishment or Monumentation of Corner: Southwest corner of Private Claim 173 Common with the Northwest corner of Private Claim 164.

Refer to: 12-18-2014 LCRC for Remonumentation Corner by Christopher A. Asiala, PS #49376 PC 037 recorded in L. 23164 of Deeds on P. 808-810. "The corner falls within the front concrete porch of house 335627 Shook Lane and cannot be set. I set Reference Corner (Witness Monument) S87°32'47"E, 28.00' from the corner's position on the south line of Private Claim 173 in the public concrete sidewalk."

Witness Monument: Placed a new ½"x18" iron rod with a 2" aluminum cap stamped "MACOMB COUNTY MONUMENT MI ACT 345 CAA 49376 RC PC-037" flush with concrete pavement S87°32'47"E, 28.00' from the corner's position with 4 accessories.

Part C: Field Evidence of Perpetuation or Monumentation of Corner: Southwest corner of Private Claim 173 Common with the Northwest corner of Private Claim 164.

5-04-2018 Found the Witness Monument. A ½"x18" iron rod with a 2" aluminum cap stamped "MACOMB COUNTY MONUMENT MI ACT 345 CAA 49376 WITCOR (RC) PC-037" flush with concrete pavement S87°32'47"E, 28.00' from the corner's position with 4 of 4 matching accessories from the LCRC listed in Part A. Occupied witness monument with GPS to obtain Geodetic Coordinate Data.

Accessories:

N80°E 62.98' M Found MAG nail with MCR washer in South face of 14" Maple (62.88' R)
S45°E 48.85' M Found "+" cut in NW bolt of light pole (48.75' R)
S70°W 48.39' R&M SE corner of brick house #35627 Shook Lane
N10°W 40.38' M SE corner of brick house #35639 Shook Lane (40.30' R)

	Date of Observation	Latitude	Longitude	Datum and Adjustment Year	Epoch Date
PC 037	Calc.	N 42D33'31.92228"	W 82D52'04.64167"	NAD83 (2011)	2010
Witness Monument	5-04-2018	N 42D33'31.90538"	W 82D52'04.25484"	NAD83 (2011)	2010

Method for Latitude-Longitude determination: NGS OPUS-RS Solution

Witness Monument:

State Plane Coordinates in international feet: N-389472.23', E-13527131.77'
Standard Deviation: 0.14' N, 0.03' W
Zone: South
Combined Factor: 0.99990046
NGSPID: AB5951
Survey Method: MC GPS
Orthometric Height: 585.25'
Elev. Datum: NAVD88

Witness Monument to Northwest Corner Private Claim 164 common with the Southwest Corner Private Claim 173: N87°32'47"W 28.00'

Northwest Corner Private Claim 164 common with the Southwest Corner Private Claim 173 (calculated): State Plane Coordinates in international feet: N-389473.43', E-13527102.80'

I, Steven E. Dunn, P.S., in a field survey on May 4, 2018, certify under the requirements of the State Survey and Remonumentation Act, 1990 PA 345, MCL 54.261 to 54.279, and the Corner Recordation Act, 1970 PA 74, MCL 54.201 to 54.210d, that the corner identified and described hereon has been perpetuated or monumented as described in Parts A, B, and C above, pursuant to the laws and rules of the State of Michigan.

Steven E. Dunn

May 16, 2018

Steven E. Dunn, P.S.

Date

Professional Surveyor's License No.: 28408

Prepared By:
Steven E. Dunn, P.S.
Great Lakes Geomatics, LLC
76 S. Main Street
Mt. Clemens, Mi. 48043



I, Martin C. Dunn, P.S., Macomb County Surveyor Representative, have reviewed the corner perpetuated in parts A, B and C above for the purpose of publishing its Michigan State Plane Coordinate values and relative data and is accepted for filing in the Macomb County Remonumentation Program.

Martin C. Dunn

6-26-2018

Martin C. Dunn, P.S.

Date

Macomb County Surveyor Representative
License No. 30081

MACOMB COUNTY
INDEX OF SUPPORTING DOCUMENTS FOR

PC-037

**SOUTHWEST CORNER OF PRIVATE CLAIM 173 COMMON WITH THE
NORTHWEST CORNER OF PRIVATE CLAIM 164**

CLINTON TOWNSHIP
T. 02 N., R. 13 E.

SECTION 1

<u>ITEM & DATE</u>	<u>ITEM DESCRIPTION</u>
1) 2014	PHOTOS OF CORNER

SECTION 2

<u>ITEM & DATE</u>	<u>ITEM DESCRIPTION</u>
1) 2014	LCRC
2) 2014	SURVEYOR'S REPORT

SECTION 3

<u>ITEM & DATE</u>	<u>ITEM DESCRIPTION</u>
1) 2014	FIELD NOTES
2) 1995	PLAT MAP
3) 2014	COMPOSITE MAP WITH AERIAL IMAGE & TAX MAP

SECTION 4

<u>ITEM & DATE</u>	<u>ITEM DESCRIPTION</u>	<u>SURVEYOR</u>	<u>LICENSE</u>	<u>SOURCE</u>
(1) 1810	Private Claim Notes	A. Greeley		
(2) 1818	GLO Notes	J. Fletcher		
(3) 1818	GLO plats	W. Preston		
(4) 1875	1875 Atlas			County Records
(5) 1895	1895 Atlas			County Records
(6) 1916	1916 Atlas			County Records
(7) 1920s	Map of PC542			County Records
(8) 1920s	Map of Sec 32			County Records
(9) 1920s	Map of PC173			County Records
(10) 1881	Don M Dickinson's Add			L2, P16
(11) 1894	Sub of OL3 of Don M Dickinson's Add	M. Brown		L2, P53
(12) 1918	Union Lake Sub	John W Irvine		L3, P145
(13) 1925	Charbeneau's Gardens	John W Irvine		L8, P71
(14) 1925	Francis Harper Drive Sub	J McMahan	4018	L10, P28
(15) 1926	Liverpool Sub	HR Omara		
(16) 1926	Rosecroft Shores	HR Omara		L11, P5-6
(17) 1929	AP No27	Burt Howey?		L13, P46
(18) 1929	AP No28	Burt Howey?		L14, P4
(19) 1929	AP No29	Burt Howey?		L14, P5
(20) 1932	Supervisor's Plat No2	W Lehner	123	L16, P8
(21) 1937	Supervisors Plat No7	Burt Howey?		L18, P49
(22) 1955	Gruner Sub	JD Lehner	5787	L34, P1
(23) 1956	Asbury Park Sub No2	HS Fuller	1645	L35, P24
(24) 1959	Taubitz Manor	Richard Postiff		L45, P39


(25)1960	Jefferson Villa Sub No2	VB Spaulding	L47, P31
(26)1978	MDOT ROW P130		
(27)1978	MDOT ROW P131		
(28)1994	Union Lake Meadows	D. Pawlaczyk	17632 L105, P39


Reference Corner to PC-037







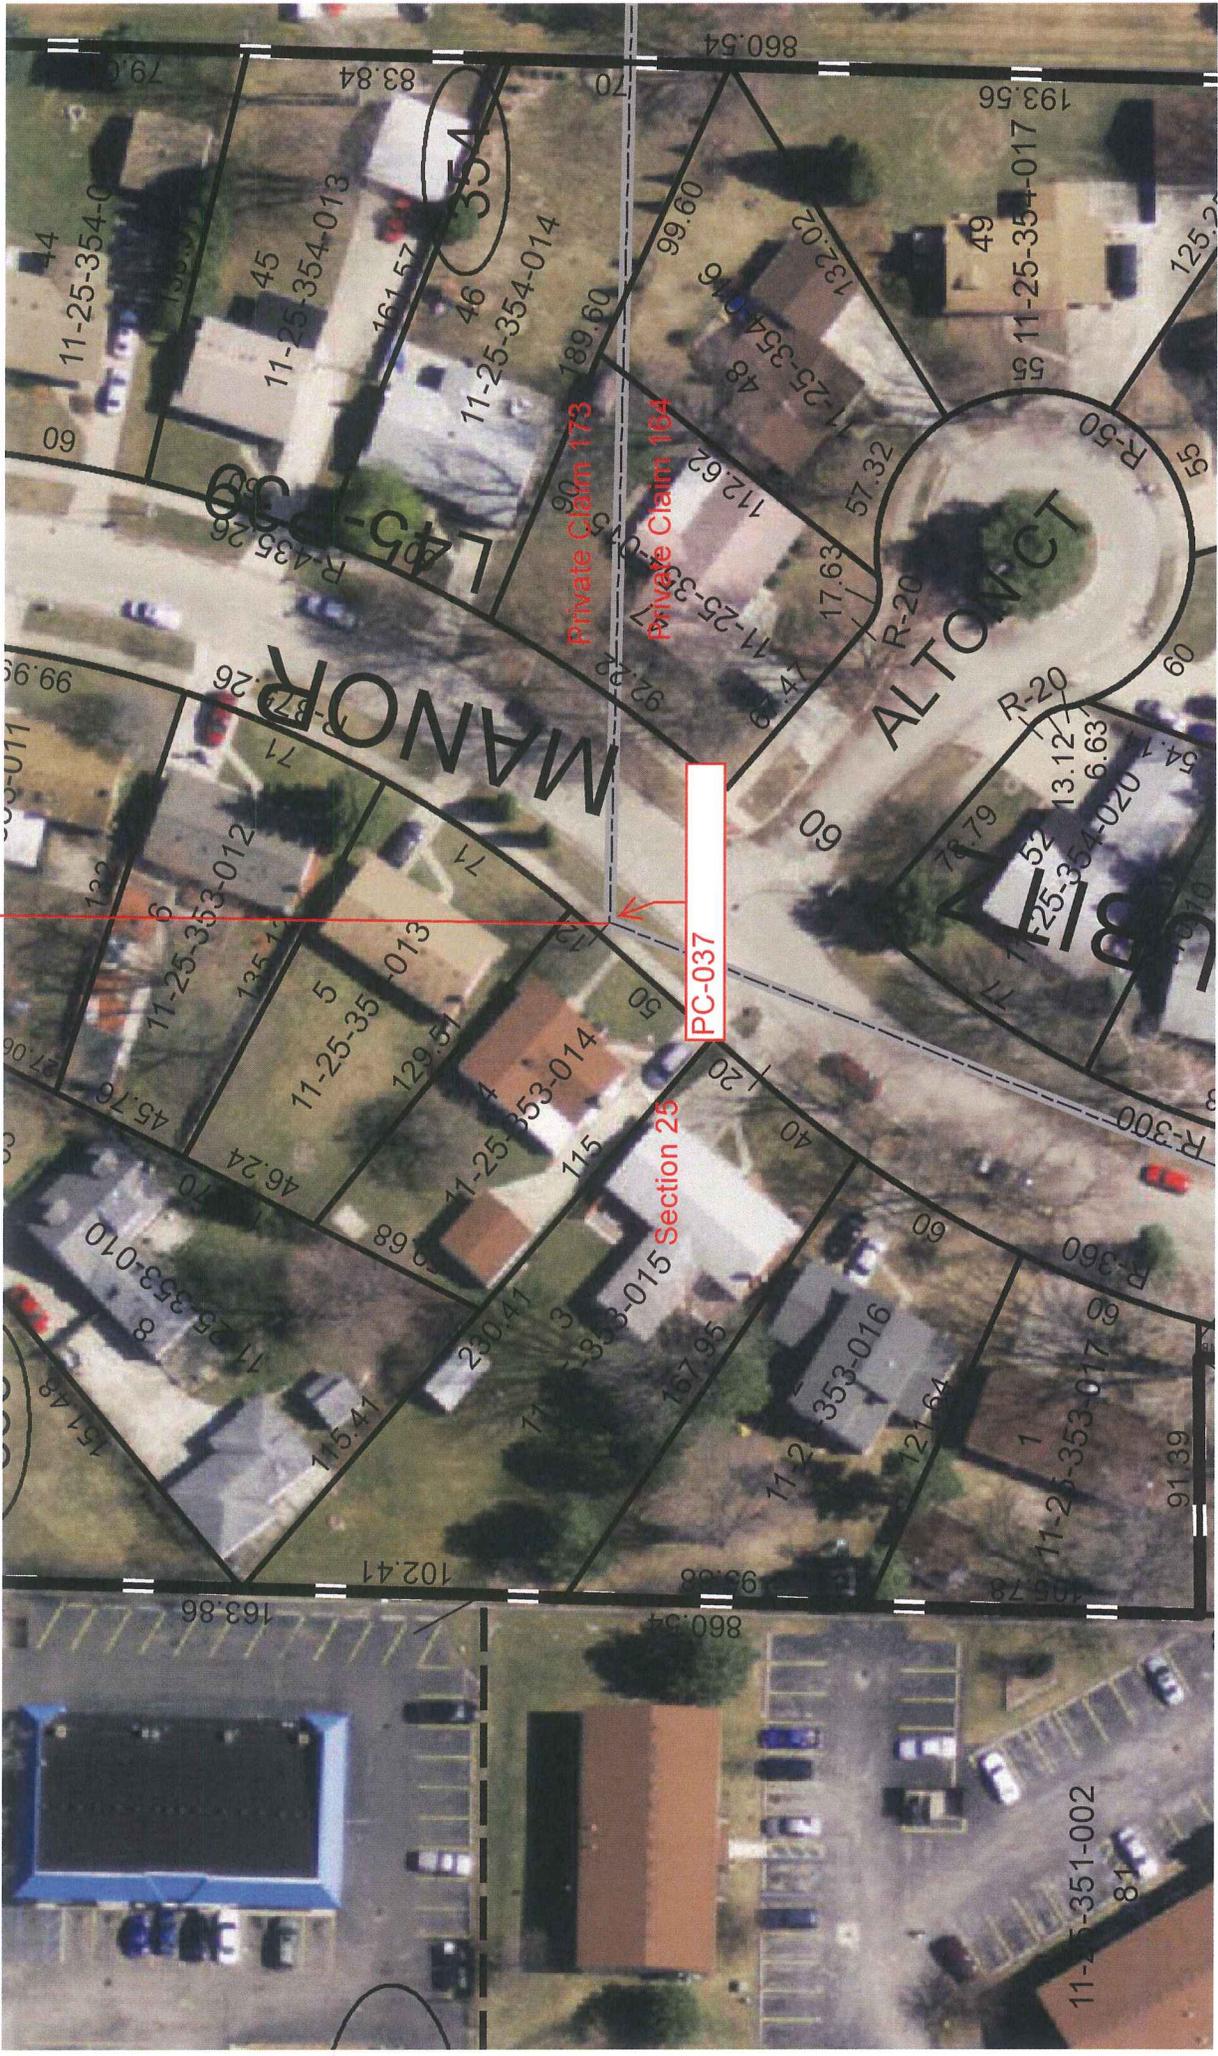

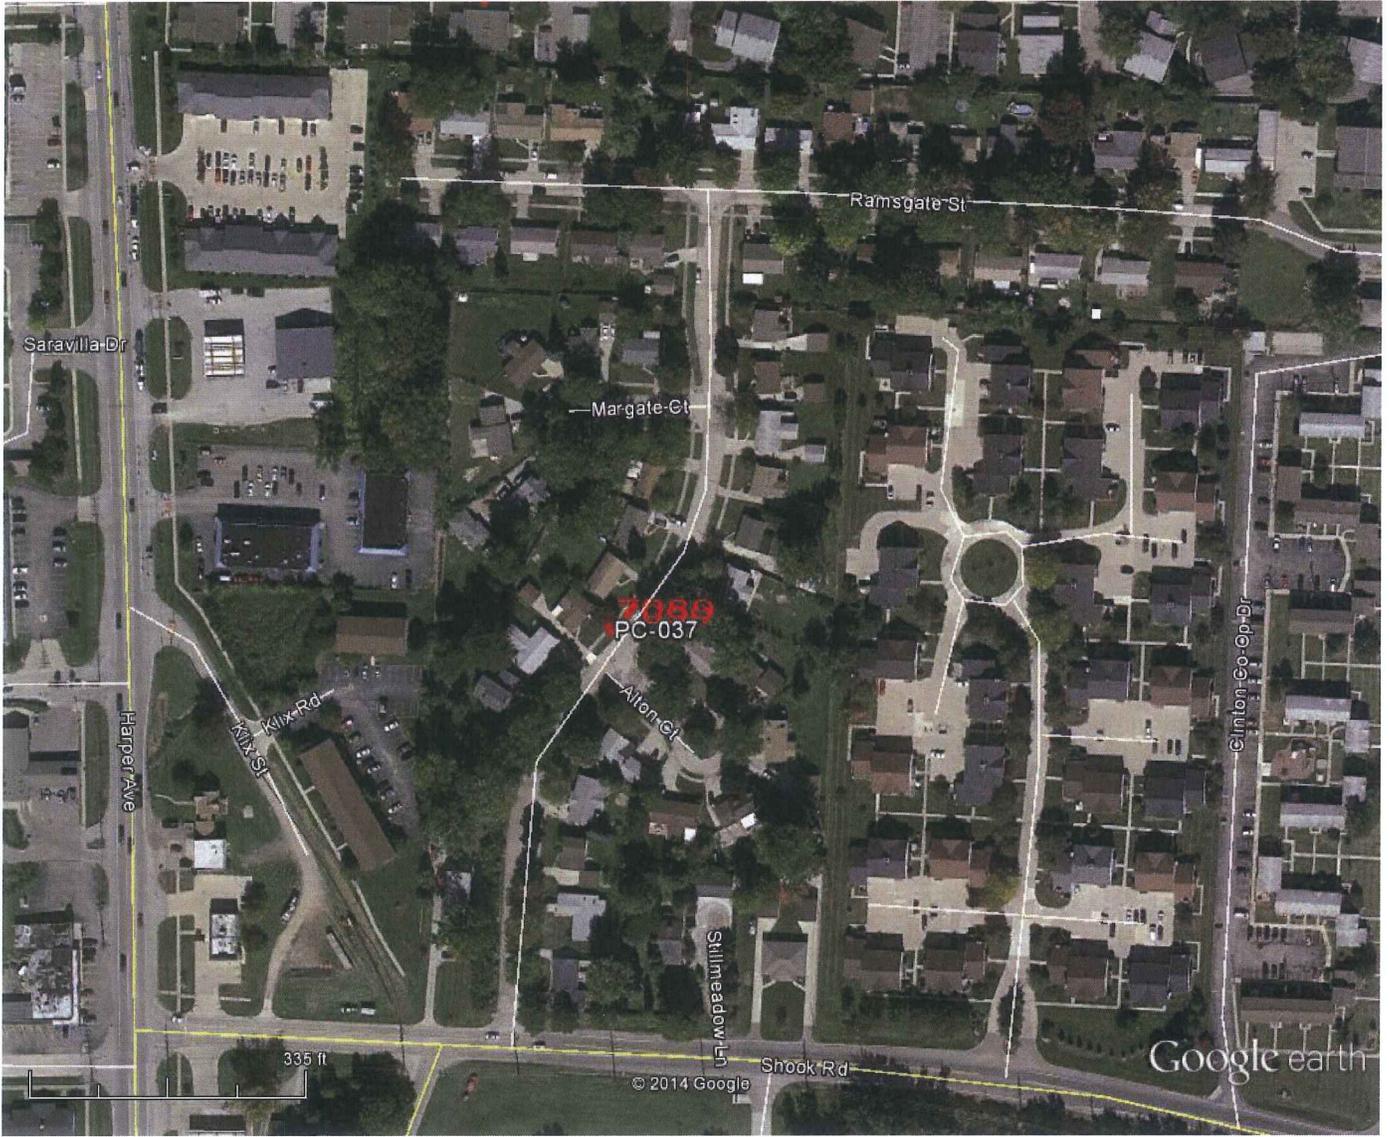

Google earth



LAND CORNER RECORDATION CERTIFICATE
Filing Requirement of Act 74, Mich. P.A. 1970

For corners in

Macomb Located In: Clinton Twp. Corner Code # _____
(County)

1. Public Land Survey	T <u>2N</u> R <u>13E</u>	<u>PC-037</u>
	T _____ R _____	_____
	T _____ R _____	_____
	T _____ R _____	_____
2. Property Controlling in Section	S _____ T _____ R _____	_____
	S _____ T _____ R _____	_____
3. Miscellaneous Property in Sec.	S _____ T _____ R _____	_____
	S _____ T _____ R _____	_____

4151686 PAGE 1 OF 3
LIBER 23164 PAGE 808
12/18/2014 02:48:41 P.M.
MACOMB COUNTY, MI SEAL
CARMELLA SABAUGH, REGISTER OF DEEDS

Register of Deeds Stamp & File Number

4. Lot No. _____, Recorded Plat _____
5. Private Claims Reference Corner to Southwest corner of Private Claim 173
Common with the Northwest corner of Private Claim 164

I, Christopher A. Asiala in a field survey on Aug. 26, 2014 do hereby state that under requirements of P.A. 74, Michigan P.A. of 1970, the corner points mentioned in lines 1 and 2 above were in conformance with regulations and rules therefore as required in the current manual of survey instructions of the United States Department of the Interior, Bureau of Land Management or be a decree of a Court of Law and/or that the corner points mentioned in lines 3, 4 and 5 above were in conformance with the rules of the Michigan Board of Land Surveyors or by a Decree of a Court of Law; established, re-established, monumented, recovered, found as expressed below.

NOTE: Not more than 2 corners, all in the same town and range, may be recorded on this certificate.

a. Description of original monument and accessories and/or subsequent restoration: 13

See page 2 of 3 for list of supporting documentation.

b. Description of corner evidence found and/or method applied in restoring or reestablishing corner:

The corner is described in the Private Claim notes as a "Post". Nothing was found at the corner's position within Taubitz Manor Subdivision. Taubitz Manor Sub depicts the corners location, but does not give any dimensions to it. It does define the west line of Private Claim 164 at the intersection of Shook Road. There is no physical occupation within the immediate vicinity. The corner falls approximately 30' West of Shook Lane and 500' North of Shook Road.

Supervisor's Plat No.7 defines the west line of Private Claim 173. However, there are several deflections shown on said Supervisor's Plat No. 7 as well as inconsistencies amongst the found physical evidence along the plat and lot lines. I did find several irons along the east line of lots 17 thru 22 which I held as the best location of the east-west position of the west line of Private Claim 173 in this area. There is no further evidence south of lot 16 (S.P. No. 7 was replatted as Quad Estates Condo and Taubitz Manor South of lot 16). I extended this line south to intersect with the west line of Private Claim 164.

A point on the west line of Private Claim 164 was determined by offsetting a found monument at the east line of Klix Street 33' to establish the centerline of Klix. This point was then held thru the calculated position of the intersection of Shook Rd and the west line of Private Claim 164 as shown on Taubitz Manor Sub.

The corner falls within the front concrete porch of house #35627 Shook Lane and cannot be set. I set a Reference Corner S87° 32' 47"E, 28.00' from the corner's position on the south line of Private Claim 173 in the public concrete sidewalk.

c. Description of monument for corner and accessories established to perpetuate locating the position of the corner:

I placed a new 1/2" x 18" iron rod with a 2" aluminum cap stamped "MACOMB COUNTY MONUMENT MI ACT 345 CAA 49376 RC PC-037" flush with concrete sidewalk pavement S87° 32' 47"E, 28.00' from the corner's position.

Witness ties to the Reference Corner are as follows:

- N80°E 62.88' Set MAG nail with M.C.R. washer in south face of 14" Maple.
- S45°E 48.75' Set cut "+" in NW bolt of light pole base.
- S70°W 48.39' SE corner of brick house #35627 Shook Lane.
- N10°W 40.30' SE corner of brick house #35639 Shook Lane.

The selected location is accepted by me and generally accepted by professional surveyors as the best available evidence of the position of the original corner.

Signed by [Signature]
Surveyor's Michigan License No. 49376

Date 12-8-14



ACCEPTED BY THE MACOMB COUNTY SURVEY PEER GROUP AS THE OFFICIAL CORNER UNDER MICHIGAN PUBLIC ACT 945 OF 1990 AT A MEETING HELD ON 10-14-2014
[Signature]
MARTIN C. DUNN, P.S. CHAIRMAN

PC-037, CLINTON TWP, T-02-N, R-13-E

Section A:

A. Description of original monument and accessories and/or subsequent restoration:

<u>ITEM & DATE</u>	<u>ITEM DESCRIPTION</u>	<u>SURVEYOR</u>	<u>LICENSE</u>	<u>SOURCE</u>
(1) 1810	Private Claim Notes	A. Greeley		
(2) 1818	GLO Notes	J Fletcher		
(3) 1818	GLO plats	W. Preston		
(4) 1875	1875 Atlas			County Records
(5) 1895	1895 Atlas			County Records
(6) 1916	1916 Atlas			County Records
(7) 1920s	Map of PC542			County Records
(8) 1920s	Map of Sec 32			County Records
(9) 1920s	Map of PC173			County Records
(10) 1881	Don M Dickinson's Add			L2, P16
(11) 1894	Sub of OL3 of Don M Dickinson's Add	M Brown		L2, P53
(12) 1918	Union Lake Sub	John W Irvine		L3, P145
(13) 1925	Charbeneau's Gardens	John W Irvine		L8, P71
(14) 1925	Francis Harper Drive Sub	J McMahon	4018	L10, P28
(15) 1926	Liverpool Sub	HR Omara		
(16) 1926	Rosecroft Shores	HR Omara		L11, P5-6
(17) 1929	AP No27	Burt Howey?		L13, P46
(18) 1929	AP No28	Burt Howey?		L14, P4
(19) 1929	AP No29	Burt Howey?		L14, P5
(20) 1932	Supervisor's Plat No2	W Lehner	123	L16, P8
(21) 1937	Supervisors Plat No7	Burt Howey?		L18, P49
(22) 1955	Gruner Sub	JD Lehner	5787	L34, P1
(23) 1956	Asbury Park Sub No2	HS Fuller	1645	L35, P24
(24) 1959	Taubitz Manor	Richard Postiff		L45, P39
(25) 1960	Jefferson Villa Sub No2	VB Spaulding		L47, P31
(26) 1978	MDOT ROW P130			
(27) 1978	MDOT ROW P131			
(28) 1994	Union Lake Meadows	D. Pawlaczyk	17632	L105, P39

*see next page for sketch:

Private Claim 173

The description for Private Claim 173 commences at the NE corner at a ***“Post (not Remonumented) standing on the border of River Huron”***. The description then proceeds south and runs in a clockwise manor and does not close by 39’.

The first course of the description reads ***“South 162 chains, 83 links to a post”*** (PC-008, Remonumented in 2007).

The second course of the private claim description is ***“West 33 chains, eighteen links to a post”*** (PC-037). This line is not currently occupied or monumented. There is no record evidence showing this the exact position of this south private claim line or PC-037. The following plats and condo do depict the approximate position of the south line:

Supervisor’s Plat No. 2
Stillmeadows Condominium
Taubitz Manor Sub
Supervisor’s Plat No. 7

The third course of the private claim reads ***“North 188 chains, 40 links to an Elm Tree”*** (not remonumented). This line is occupied and monumented for most of it’s course, excepting the first 900’(+/-). The following plats and condos either specifically show or depict the line’s position:

Taubitz Manor Sub (depicts the line location only)
Quad Estates Condo, MCCP #60
Supervisor’s Plat No. 7 (shows 2 deflection points along the line)
Union Lake Sub
Asbury Park Sub No.2
Liverpool Sub
Gruners Sub
Sub of Don M Dickerson’s Addition
Sub of Outlot 3 of Don M Dickerson’s Addition
Assessor’s Plat No. 28
Charbeneau’s Plat
Charbeneau’s Gardens

The fourth course reads ***“East 6 chains 48 links to a Buttonwood Tree (not Remonumented) standing on the border of the River Huron”***. The description continues several courses downstream to the POB.

Private Claim 542

The description for Private Claim 542 commences at ***“Butternut tree (PC-038) standing on the border of River Huron”*** The description then runs south and proceeds in a counter-clockwise manor.

The first course reads ***“South 83 chains, 59 links to a post”*** (PC-034). This line is monumented and occupied along much of it’s length by:

Liverpool Subdivision
Rivercrest Subdivision
Rivercrest Subdivision No.3
Supervisor’s Plat No.3
Stonegate Condo

The northern-most part of the line and PC-038 (north of the Clinton Cut-off Canal) is occupied and determined by the west line of Liverpool Sub. Whereas the southern-most portion near PCC-033 and PC-034 is occupied and determined by Supervisor's Plat No. 3.

The second course reads "**East 34 chains to a post (PC-036) standing on the west line of a tract confirmed to James Abbott**". (Private Claim:173) There is no current occupation of this line. The south line of Supervisor's Plat No. 3 occupies the westerly portion of the line.

The third Course reads "**North 148 chains, 40 links to an Elm Tree**" (not Remonumented).

GLO survey notes

PCC-033. The GLO course **East between Sections 23 & 26** intersects the west line of Private Claim 542 at 59.50 chains, 8.11 chains from SW corner of Lot No. 542. Set post.

PCC-035. The GLO course **North between Sections 26 & 25** intersects the south line of Private Claim 542 at 76.93 chains, 12.11 chains west of SE corner of Lot No. 542. Made corner for Post on a Beech 17in dia.

REMONUMENTATION FIELD REPORT

DATE: 12-5-14

CREW: DA SOLO

WEATHER: 30° CLOUDY

TOWNSHIP: CLINTON

TOWN OWEN


RANGE 13 E

CORNER CODE: PC-037
Witness corner to:


DEPTH: FLUSH


LOCATION OF CORNER WITHIN SIDEWALK

AT DRIVEWAY TO HOUSE # 35627 SHOOK LANE

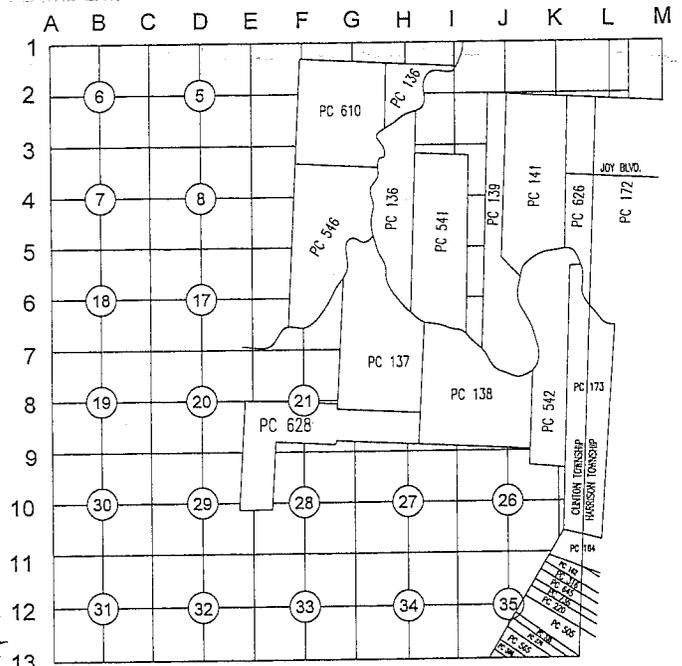

WHAT WAS FOUND? FD. NOTHING Set 1/2" x 18" Iron w/cap

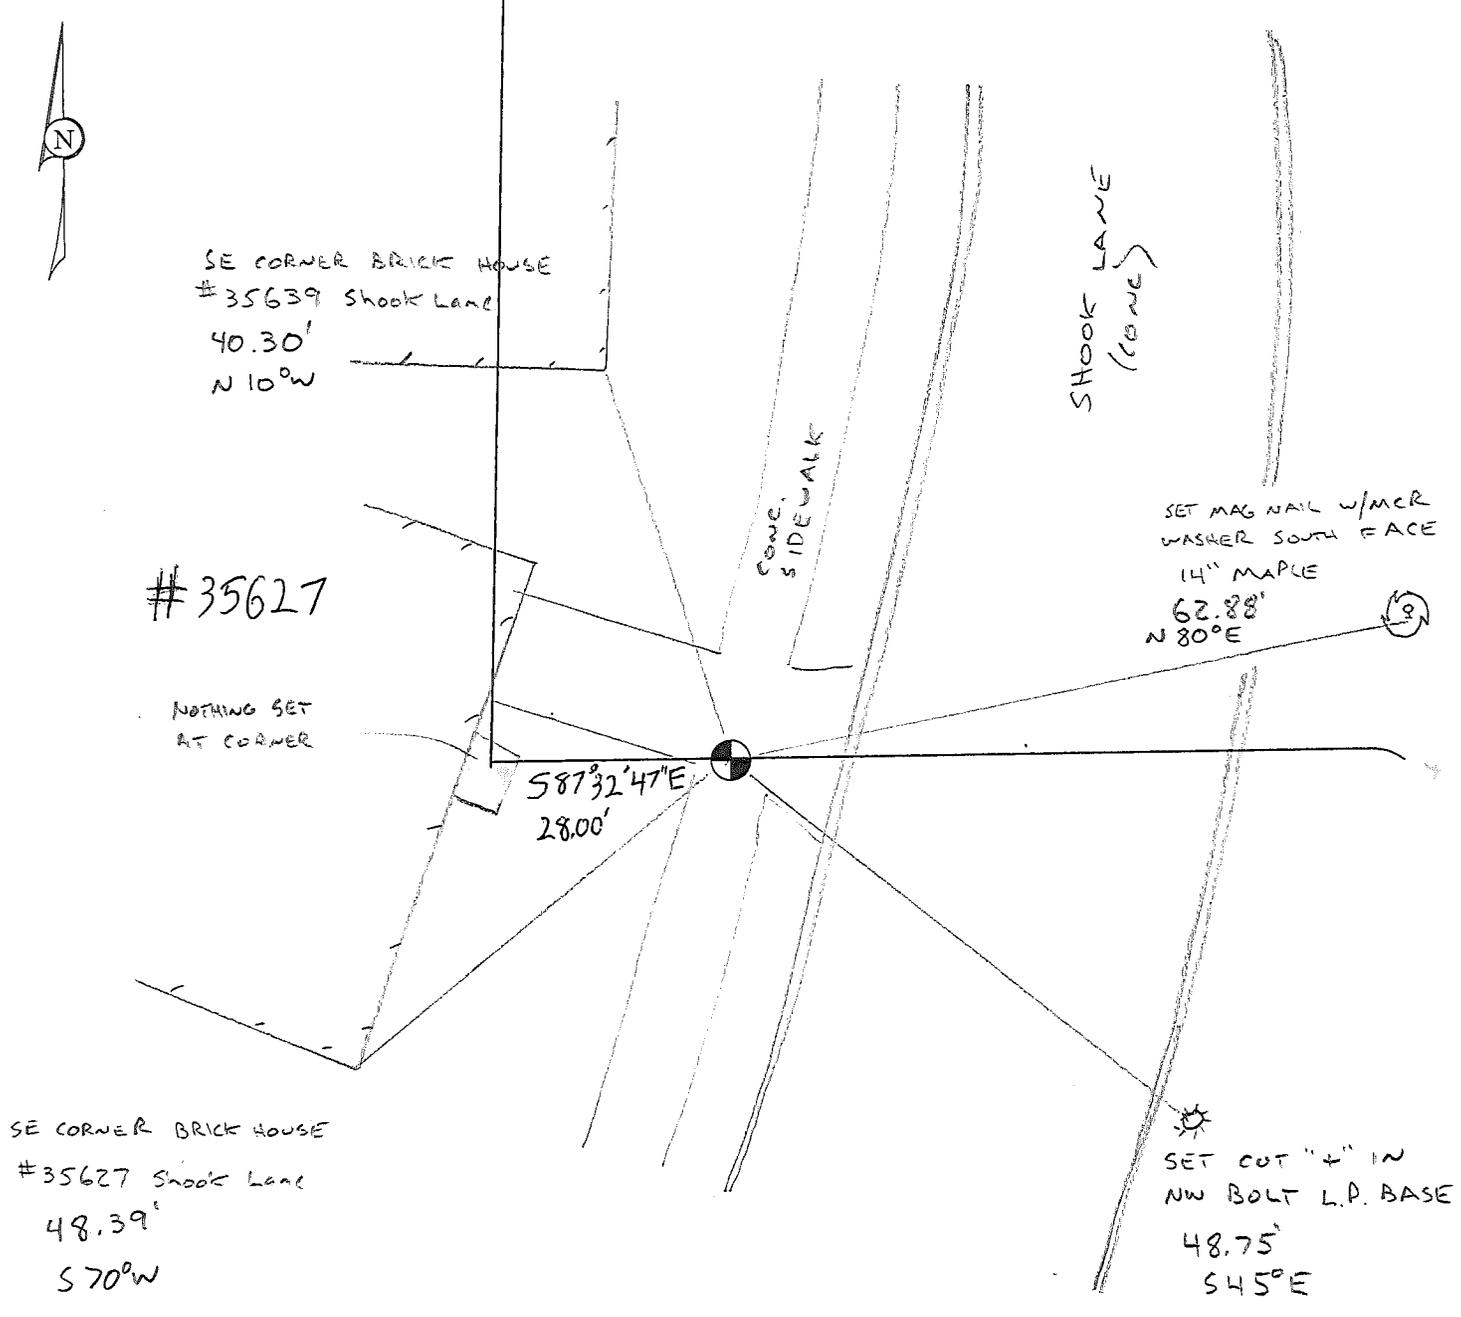

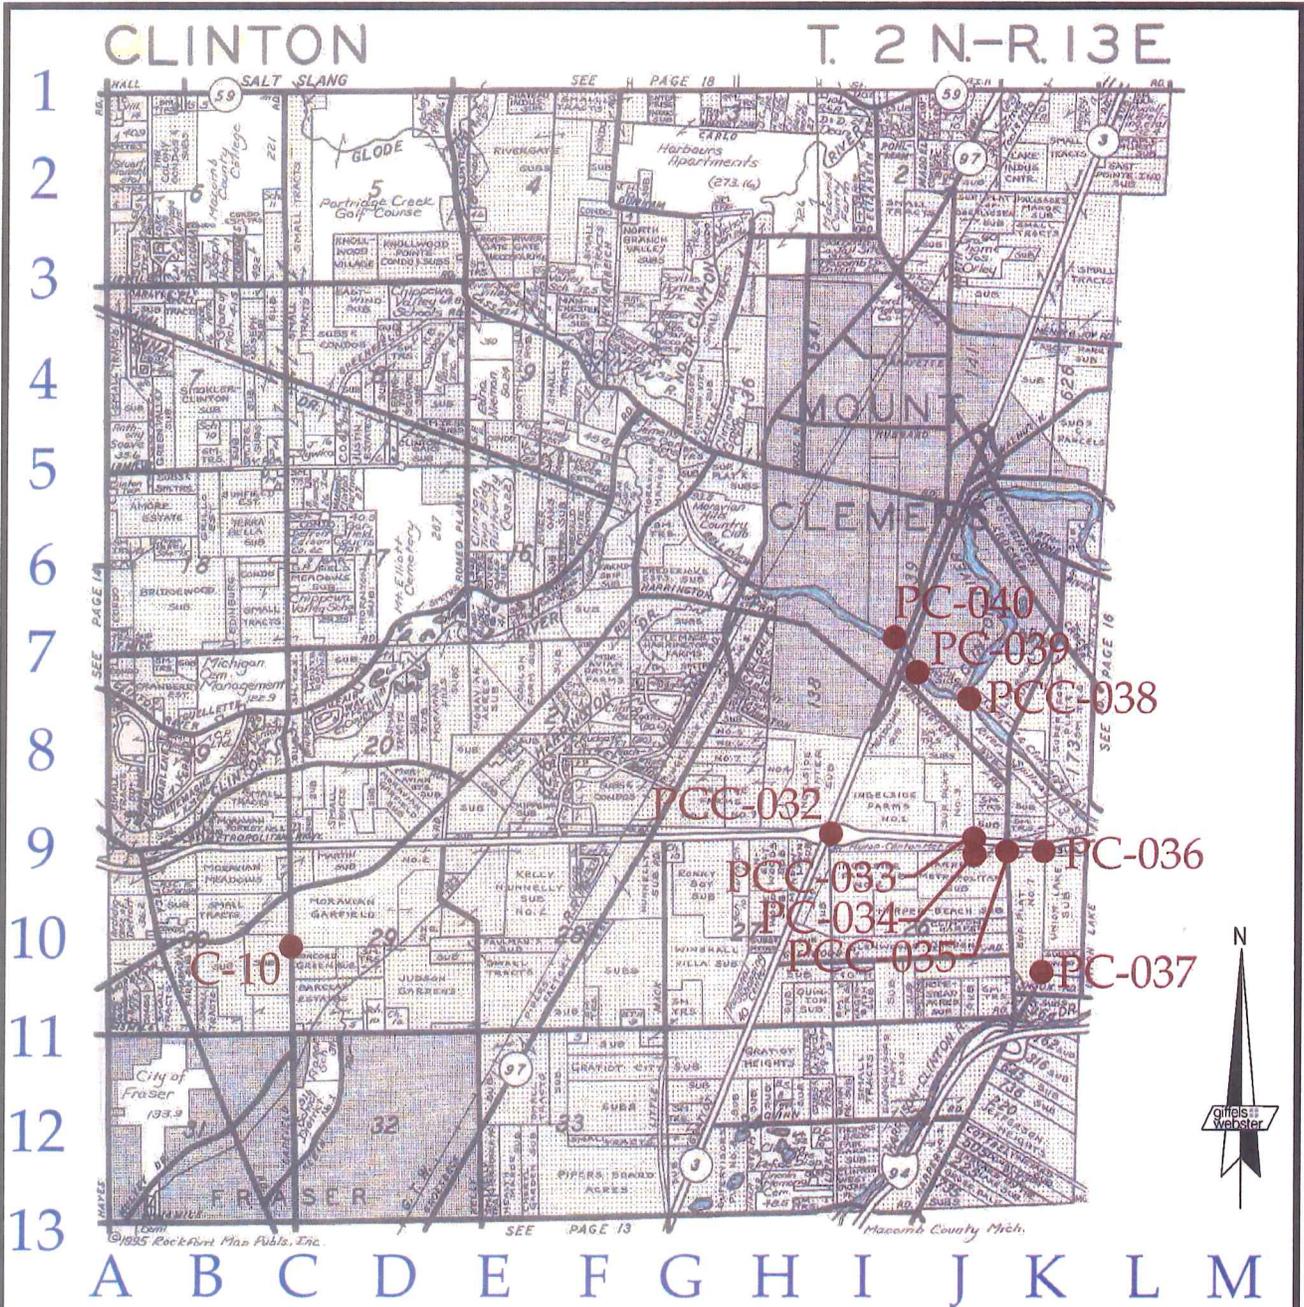

C10

- Other Code PCC-032: Intersection of the south line of **Private Claim 138** with the section line common to **Fractional Sections 22 and 23**
- Other Code PCC-033: Intersection of the westerly line of **Private Claim 542** with the section line common to **Fractional Sections 23 and 26**
- Other Code PC-034: Southwest corner of **Private Claim 542**
- Other Code PCC-035: Intersection of the South line of **Private Claim 542** with the section line common to **Fractional Sections 25 and 26**
- Other Code PC-036: Southeast corner of **Private Claim 542**
- Other Code PC-037: Southwest corner of **Private Claim 173** common with the Northwest corner of **Private Claim 164**
- Other Code PC-038: Northwest corner of **Private Claim 542** common with the Northeast corner of **Fractional Section 23**
- Other Code PC-039: Northeast corner of **Private Claim 138** common with the Northwest corner of **Fractional Section 23**
- Other Code PC-040: Southwest corner of **Private Claim 139** common with the Southeast corner of **Fractional Section 14**

giffels webster
 Engineers Surveyors Planners
 Landscape Architects
 Environmental Specialists

6303 26 Mile Road
 Suite 100
 Washington, MI 48094
 p (586) 781-8950
 f (586) 781-8951
 www.giffelswebster.com

Executive:	J.N.R.
Manager:	C.A.A.
Designer:	J.Z.B.
Quality Control:	C.A.A.
PC 138, PC 542, PC 173, PC 139, SEC. 14, SEC. 22, SEC. 23, SEC. 25, SEC. 26, SEC. 29, SEC. 30 T-02-N R-13-E	

**MACOMB COUNTY
 REMONUMENTATION
 PROGRAM 2014**

Date:	04/03/14
Scale:	N.T.S.
Sheet:	1 OF 1
Project:	13784.62

Copyright © 2013 Giffels Webster.
 No reproduction shall be made
 without the prior written consent
 of Giffels Webster.

N:\13137001\13784.62 - Macomb 2014\Drawings\Macomb County Localions 2014.dwg





Date of Photography: Spring 2012
 100 50 0 100 200 Feet
 1:1,200

CLINTON TWP SHEET INDEX

DESCRIPTION OF PERMANENT REAL ESTATE INDEX NUMBER
13-19-302-018

11-25A
 CLINTON TWP.
 W. 1/2 N.W. 1/4 SEC. 25 T. 2N. R. 13E.

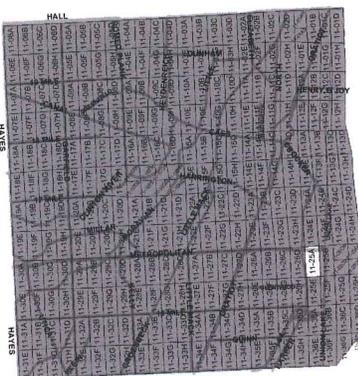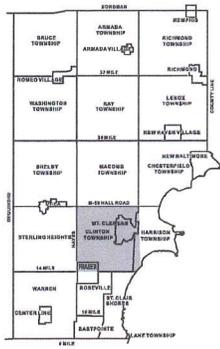

- Legend**
- Platted Area Boundary Line
 - Property Line
 - Property Split Line
 - Property Combined Line
 - Township Boundary Line
 - Traverse Line
 - Dimension Extent Marks
 - Dimension Start Marks

Source: Macomb County Department of Planning and Economic Development
 - 2008 Digital Orthophotography Project
 - Parcel Conversion Project

Note: Digital Orthophotography horizontal positioning accuracy is 3 feet. Parcel boundary lines should be considered a graphical representation and not in any way a legal survey or engineering document. In general, the horizontal positioning and length accuracy is within 15 feet.

This map is intended for general planning purposes. Site specific evaluation should be verified by field inspection. This is a work in progress and may contain errors and omissions. Please report any potential revisions to (586)469-5285.







Date of Photography: Spring 2012
 100 50 0 100 200 Feet
 1:1,200

CLINTON TWP SHEET INDEX

DESCRIPTION OF PERMANENT REAL ESTATE INDEX NUMBER
13-19-302-018

11-26D
 CLINTON TWP.

E. 1/2 N.E. 1/4 SEC. 26 T. 2N. R. 13E.

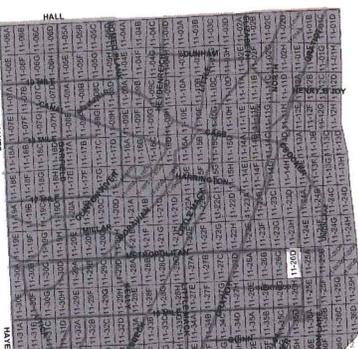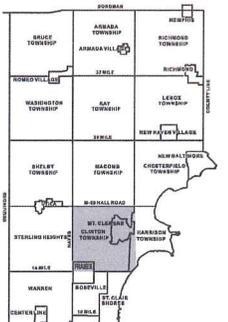

Legend

- Flatted Area Boundary Line
- Property Line
- Property Split Line
- Property Combined Line
- Township Boundary Line
- Traverse Line
- Dimension Extent Marks
- Dimension Start Marks

Note:
 Digital Orthophotography horizontal positioning accuracy is 3 feet. Parcel boundary lines should be considered a graphical representation and not in any way a legal survey or engineering document. In general, the horizontal positioning and length accuracy is within 15 feet.

This map is intended for general planning purposes. Site specific evaluation should be verified by field inspection. This is a work in progress and may contain errors and omissions. Please report any potential revisions to (586)469-5285.



No. 501

No. 173 Confirmed to
James Abbott

SOUTH SIDE OF RIVER HURON

Description No. 173 Confirmed to James Abbott commencing at a post standing on the border of River Huron between this tract and a tract confirmed to Joseph Robertjean thence south one hundred and sixty two chains eighty three links to a post thence west thirty three chains eighteen links to a post the northwest corner of a tract confirmed to Joseph Sansfacon on Lake St. Clair, thence north one hundred and eighty eight chains forty links to an Elm Tree, thence east six chains forty eight links to a Buttonwood Tree standing on the border of River Huron between this tract and a tract confirmed to Christian Clemans, thence along the border of said River down stream south twenty six degrees west eight chains forty links thence south three chains thence south forty one degrees east six chains, thence south eighty eight degrees east eighteen chains forty five links thence south sixty seven degrees east three chains thence south seventeen degrees west nine chains thence south seventy one degrees east four chains thence north sixty six degrees east four chains forty nine links to the place of beginning, containing five hundred and seventy seven acres ninety four hundredths of an acre ____

Detroit, July 18, 1810

Aaron Greeley Surveyor
of private claims

N^o. 501. South Side of River Huron

Description N^o. 178 Confirmed to James Albott commencing at a post standing on the border of River Huron between this tract and a tract confirmed to Joseph Robertson, thence south one hundred and sixty two chains eighty three links, to a post thence west thirty three chains eighteen links, to a post the north west corner of a tract confirmed to Joseph Sanson on Lake St-Clair thence north one hundred and eighty eight chains forty links to an Elm tree, thence East six chains forty eight links, to a Buttonwood tree standing on the border of River Huron between this tract and a tract confirmed to Christian Coleman, thence along the border of said River down stream South twenty six degrees west eight chains forty links, thence South, three chains thence South forty -

one degree east six chains, thence South Eighty eight degrees East Eighteen chains forty five links, thence South sixty seven degrees East three chains, thence South Seventeen degrees west nine chains, thence South Seventy one degrees East four chains, thence north thirty six degrees East four chains forty nine links to the place of beginning, containing five hundred and seventy seven acres and ninety four hundredths of an acre . . .

Detroit July 18. 1810

Huron Greeley Surveyor
of private Claims.

No. 504

No. 542 Confirmed to
Christian Clemens

SOUTH SIDE OF RIVER HURON

Description No. 542 Confirmed to Christian Clemens commencing at a butter nut tree standing on the border of River Huron between this tract and a tract and a tract of unlocated land thence south eighty three chains fifty nine links to a post thence east thirty four chains to a post standing on the west line of a tract confirmed to James Abbott thence north one hundred and forty eight chains forty links to an elm tree thence east six chains forty eight links to a buttonwood tree standing on the border of River Huron between this tract and a tract confirmed to James Abbott, thence along the border of said river up stream north twenty six degrees east eight chains sixty links thence north forty one degrees west seven chains thence south eighty one degrees thirty minutes west eighteen chains thence south seventy five degrees west seven chains thence north eighty five degrees west nineteen chains thence south forty degrees west eleven chains thence south twelve degrees west eleven chains fifty links thence south twenty eight degrees east seven chains thence south twelve degrees east ten chains thence south seventy nine degrees east twelve chains thence south twelve degrees east three chains thence south seven degrees west ten chains thence south fifty degrees west three chains thence north eighty five degrees east eight chains thence south thirteen degrees east four chains thence south seventy three degrees thirty minutes west eleven chains thence

N^o. 504,, North Side of River Huron.

Description N^o. 542, Confirmed to
Christian Clemans commencing at a
Butter nut tree standing on the border
of River Huron between this tract and
a tract of unconceded land, thence south
Eighty three chains fifty nine links, to a
post, thence East thirty four chains, to a
post standing on the west line of a tract
confirmed to James Abbott. Thence north
one hundred and forty eight chains, forty
links, to an Elm tree, thence East six
chains forty eight links, to a Buttonwood
tree standing on the border of River
Huron between this tract and a tract
confirmed to James Abbott, thence along
the border of said River up stream north
twenty six degrees East Eight chains -
sixty links, thence north forty one degree
west seven chains, thence south Eighty one
degrees thirty minutes west Eighteen
chains, thence south Seventy five degrees
west seven chains thence north Eighty five
degrees west nineteen chains thence south
forty degrees west Eleven chains, thence
south twelve degrees west Eleven chains,
fifty links, thence south twenty eight de-
grees East seven chains, thence south -
twelve degrees East ten chains thence
north Seventy nine degrees East twelve
chains, thence south twelve degrees -
East three chains, thence south seven
degrees west ten chains, thence south

Form 2 North Range 13 East.

East	Corrected between <u>S. 27 + 34</u>
37.92	Made 1/4 Section Corner on a Beech 10 ins dia at average distance on true line
79.85	To Section Corner
North	Between <u>Sections 26 + 27</u>
2.40	a W. Oak 12 in dia
40.00	Made half mile corner on B. Oak 18 in dia
66.40	a B. Oak 18 in dia
80.00	Set post for <u>Sections 26, 27, 22, 23</u> from which a Lymn 18 in dia bears S 16° E 12 links also a Lymn 12 in dia bears N 35° E 17 links dist 1 st half mile post along 2 ^d rate last half mile same Timber similar Lymn Beech Elm B. Oak & Undergrowth Spice &
West	On Random between <u>22 + 27</u>
40.00	Set temporary half mile post
80.10	Intersect West boundary at the Corner Land level old dry Very good 2 ^d rate Timber W. Oak W. Oak Beech Sugar & Undergrowth Spice &
East	Corrected between <u>S. 22 + 27</u>
40.05	Made 1/4 Section Corner on a Hickory 14 ins dia at average distance
80.10	To Section Corner

Town 2 North Range 13 East

North Between Sections 22 & 23

747 Interest Private Claims 3625' West
of East corner of Lot N^o 158 confirmed
to N. Cannon. Made corner for part
Sections 22 & 23 on a Hornbeam 7 in dia
Land 2¹/₂ rate Timber Lynn Beech
W Cab 42

East Between Sections 23 & 26

4000 made half mile corner on a W Oak
8 in dia
5750 Interest Private Claims 811 from S.M.
Corner Lot N^o 542 confirmed to C. Coleman
and set part for part Sections 23 & 26
from which a Maple 8 in dia bears
N 57 W 12 in also a gnarling Asp 28 in
bears N 72 W 28 like dia
Land 2¹/₂ rate part day
Timber W. Oak Asp Elm Lynn Edna

East Between Sections 26 & 33

4000 made half mile corner on a W Ash
8 in dia
7200 a Marsh
7400 left the marsh
8000 made corner for Sections 26, 33, 25, 36
on an Ironwood 10 in dia
Land part day 2¹/₂ rate
Timber Buck B. Ash Elm Sugar

North Between Sections 26 & 25

1125 a Sycamore 20 in dia
4000 Set half mile part from which an
Ironwood 8 in dia bears North 20 like
dia also a Sycamore 24 in dia bears N 68 W like


Township N.° II North, Range N.° XIII East of Mer. (Mich. Ter.)



A true copy from the Original on file in this Office Acord Dec
 Quantity exclusive of private claims 14,203.99
 Charles J. General Office }
 Feb 20th 1818 }

Edward Tiffin
 Surveyor General

POOR COPY

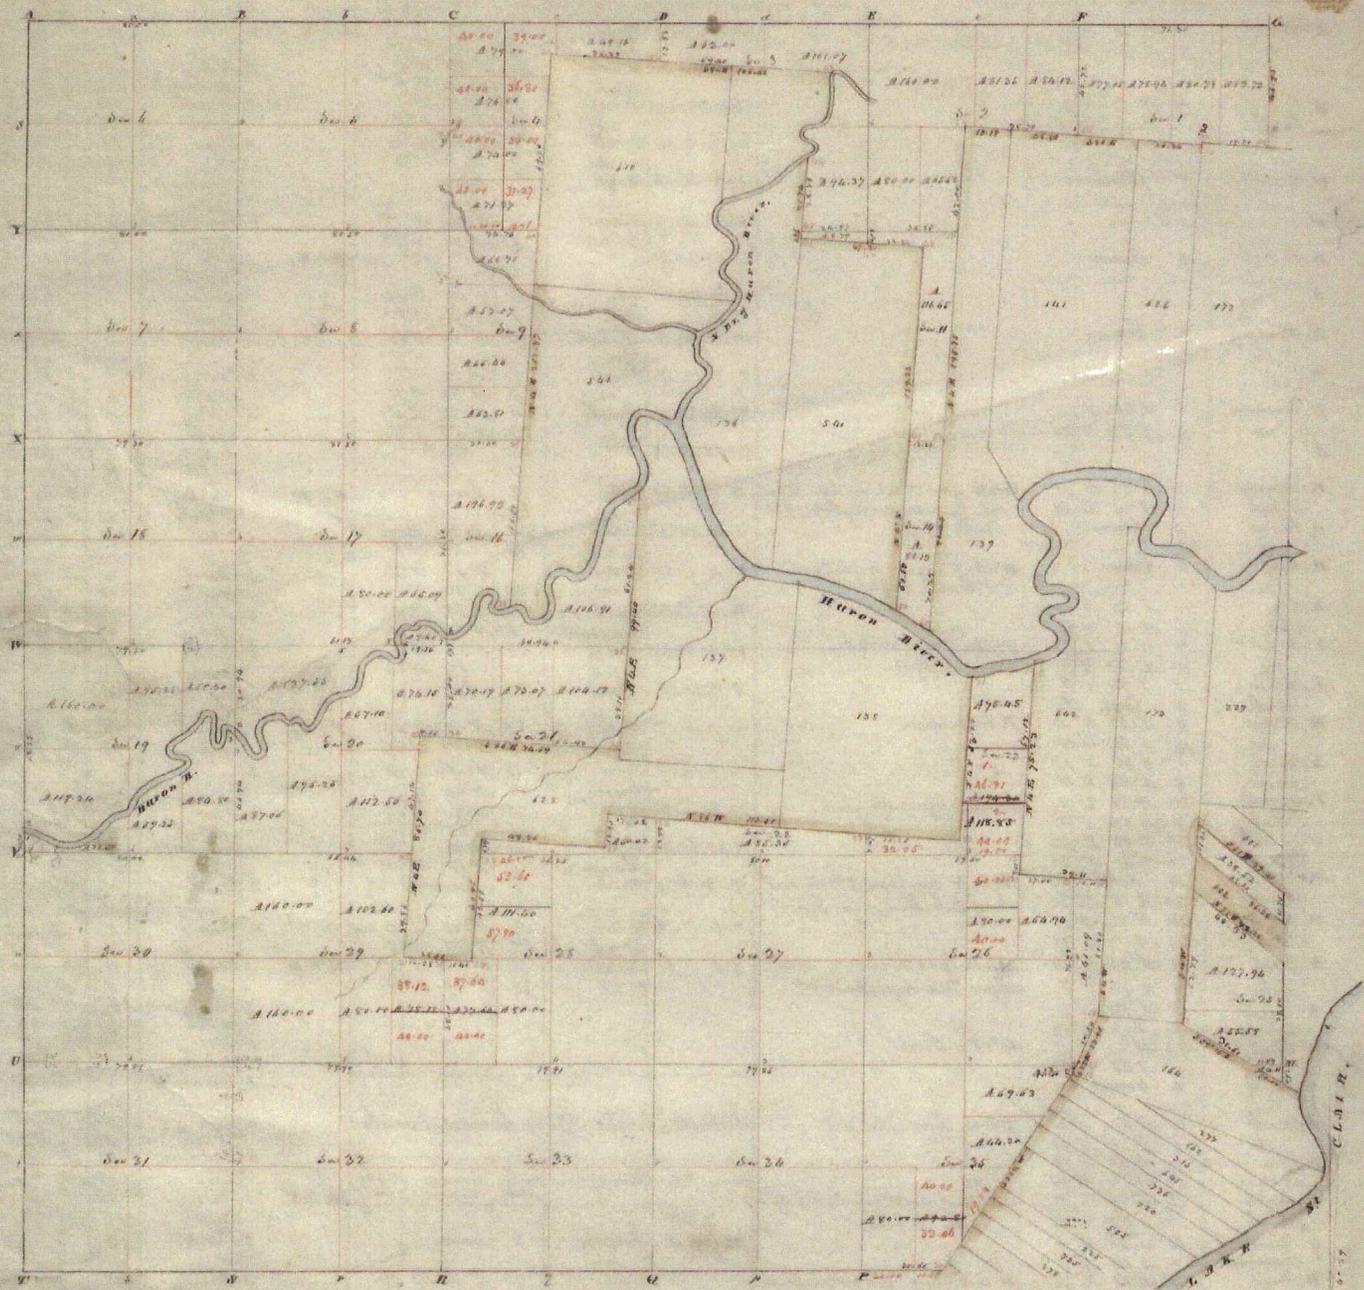

Township N: II North, Range N: XIII East of Mer. (Mich. Ter)

surveyed by W. Preston.


1817

Description of the soil on the interior sectional lines

Section	Quality &c	Section	Quality &c
1	Whety clay, sh. W. Oak, B. Ash, Sugar, Spruce	29	Loam & dry E. rate. W. Oak, B. Ash, Sugar
2	Loam & wet E. rate. B. Ash, B. Oak, Elm, Sugar	19	Same
3	Same - (fast dry)	19	3 of the Elm Same
4	Same	22	1/2 of the Elm Same fast E. with E. rate. W. Oak, B. Ash, Elm
5	Muddy dry E. rate. W. Oak, B. Oak, Sugar, Spruce, Elm, B. Ash	29	Loam, fast dry W. Oak, B. Oak, B. Ash, Spruce & Elm
6	Same	29	Loam W. Oak
7	Loam & E. rate. Loam & dry. W. Oak, B. Oak, B. Ash, Sugar, Elm	20	Same
8	Dry E. rate. Loam Sugar, Spruce	16	Same
9	Same	20	Same
10	Same - (fast dry)	20	Same with B. Oak, Sugar, B. Ash, good land
11	Loam & wet E. rate. B. Ash, Elm, Spruce	25	Same
12	Loam & wet E. rate - 1/2 dry very good. W. Oak, B. Oak, Sugar	25	Same
13	Loam good E. rate. W. Oak, B. Oak, Sugar, Spruce	25	Same
14	Dry E. rate - B. Oak, W. Oak, B. Ash, Sugar	25	Same
15	Same	25	Same
16	Same	26	Same
17	Same	22	Same
18	Loam & Swampy E. rate - Spruce, B. Ash, Elm	22	Same
19	Same	22	Same
20	Loam & dry E. rate - W. Oak, B. Oak, Sugar	22	Same
21	Same	22	Same

MAP OF CLINTON TOWNSHIP

TOWN SHIP

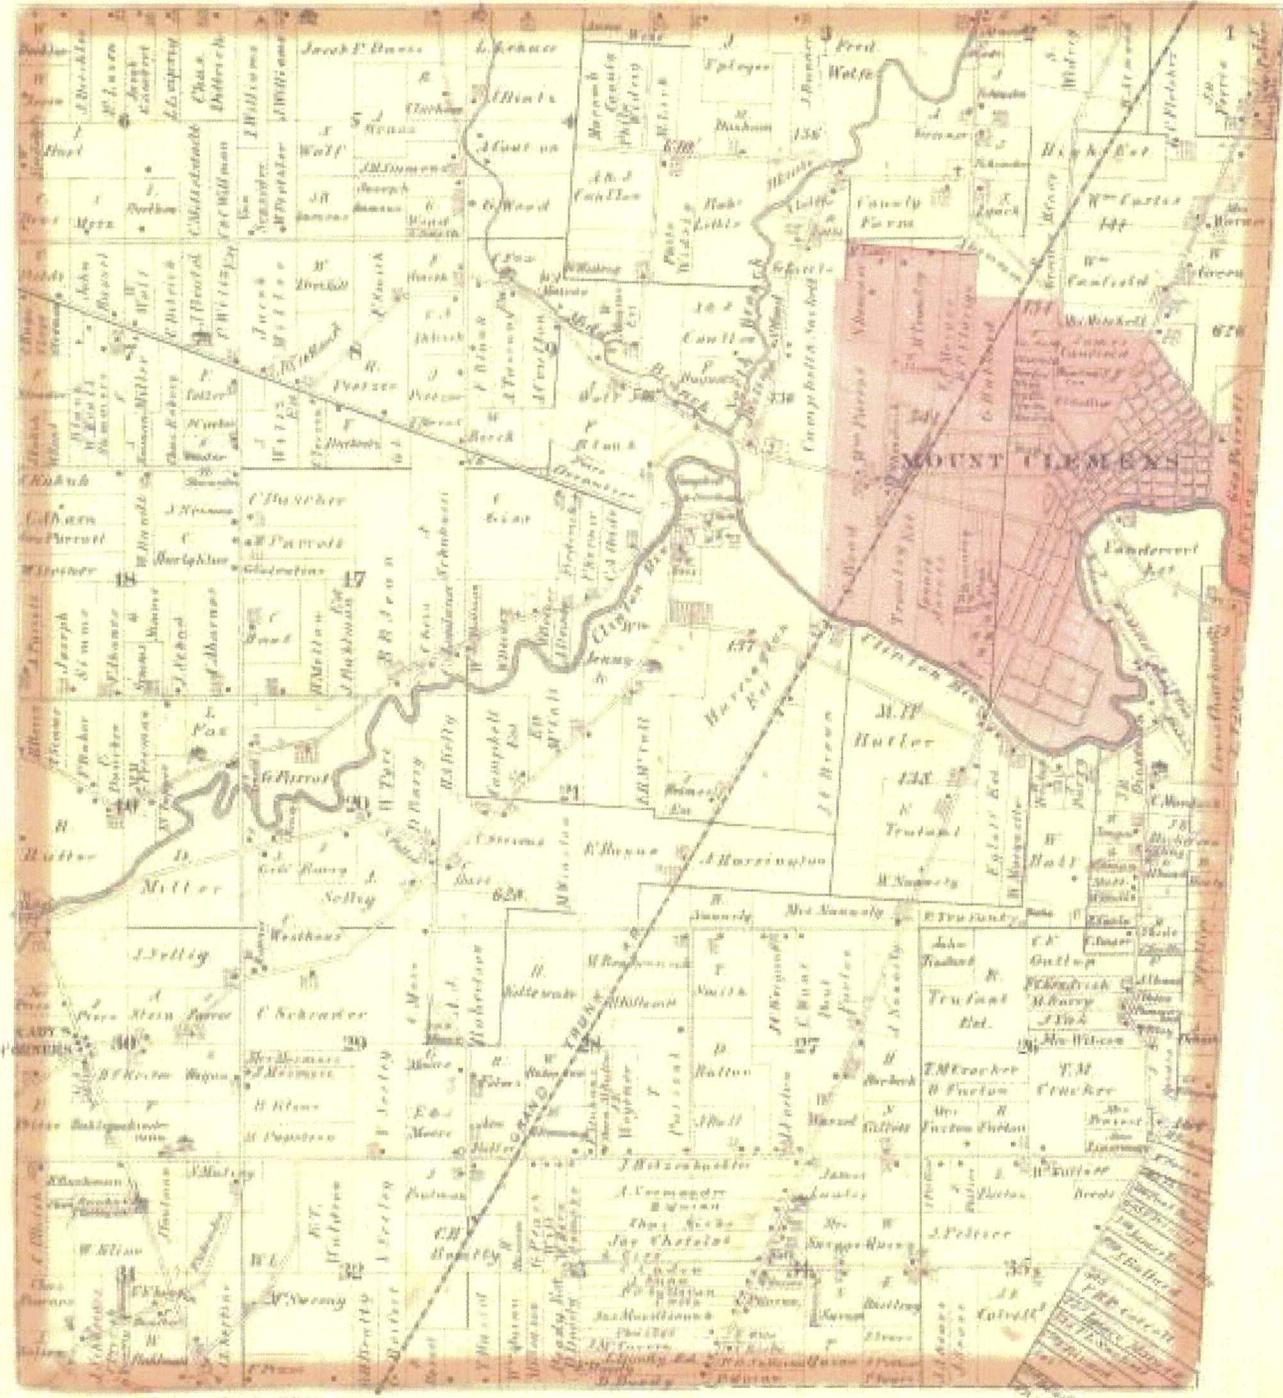


Drawn and Compiled by A. C. Cross


MAP OF
CLINTON
 TOWNSHIP

Scale 2 inches to 1 mile

Fractional Township 2 North, Range 13 East of the Michigan Meridian

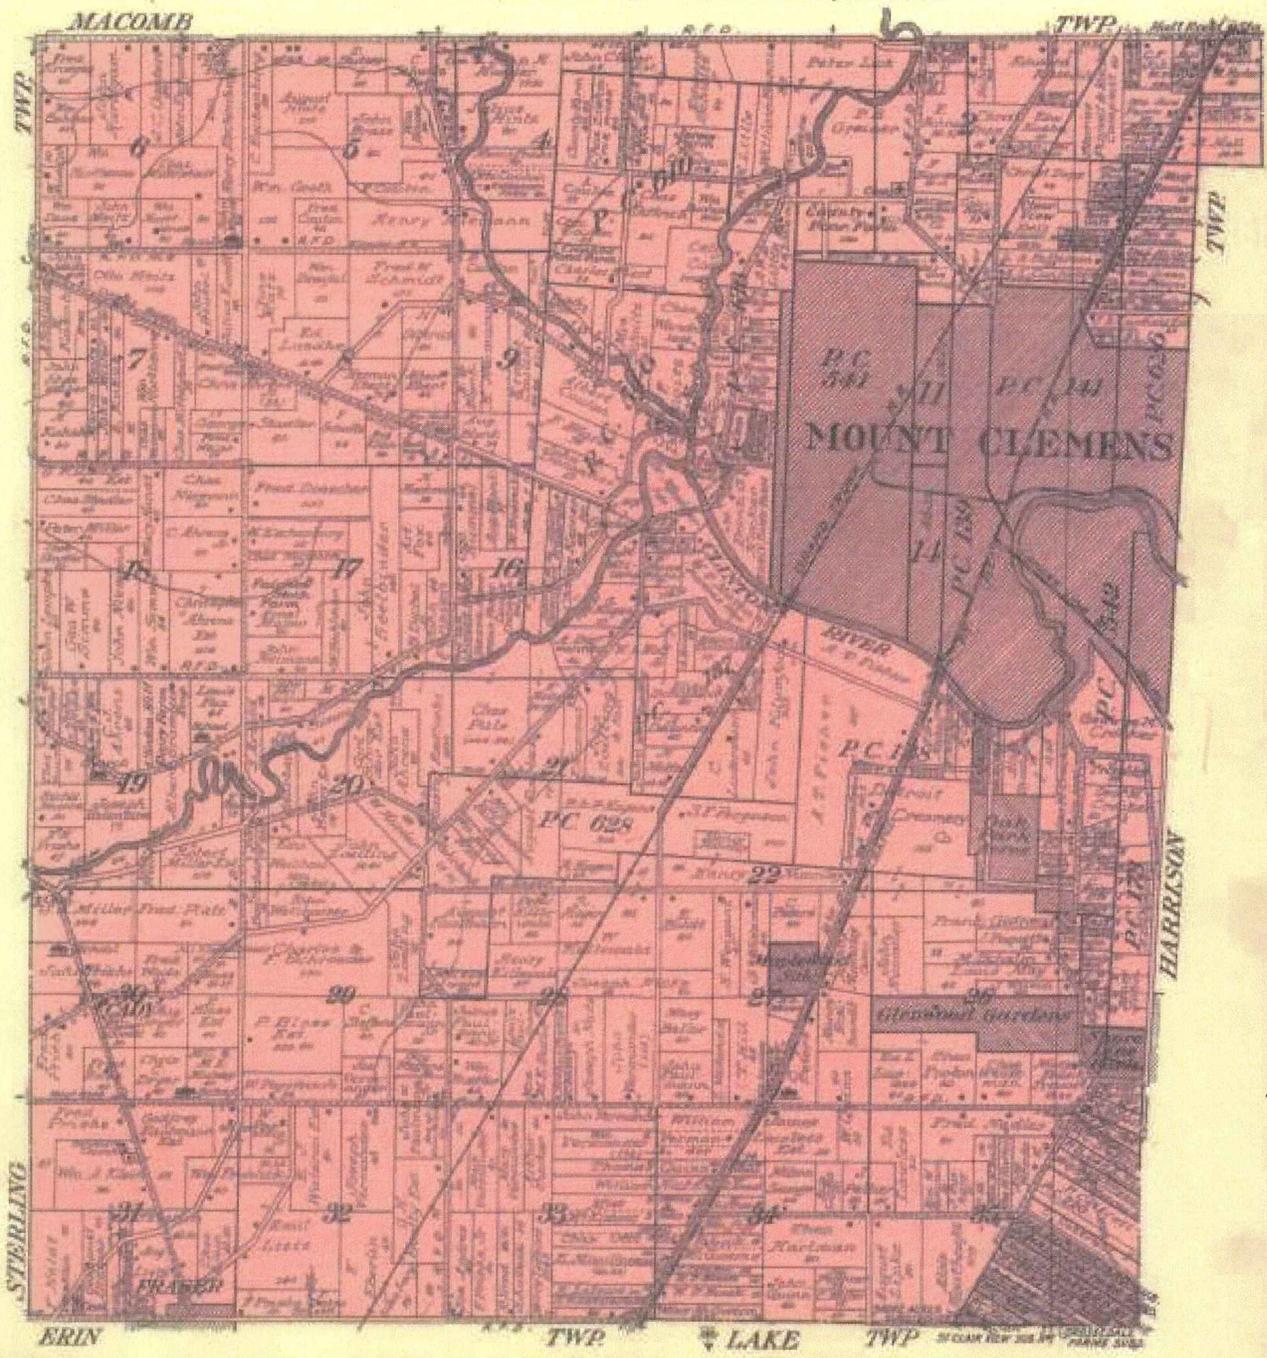


CLINTON TOWNSHIP MACOMB COUNTY
P.C. 542 TOWN 2N RANGE 13E

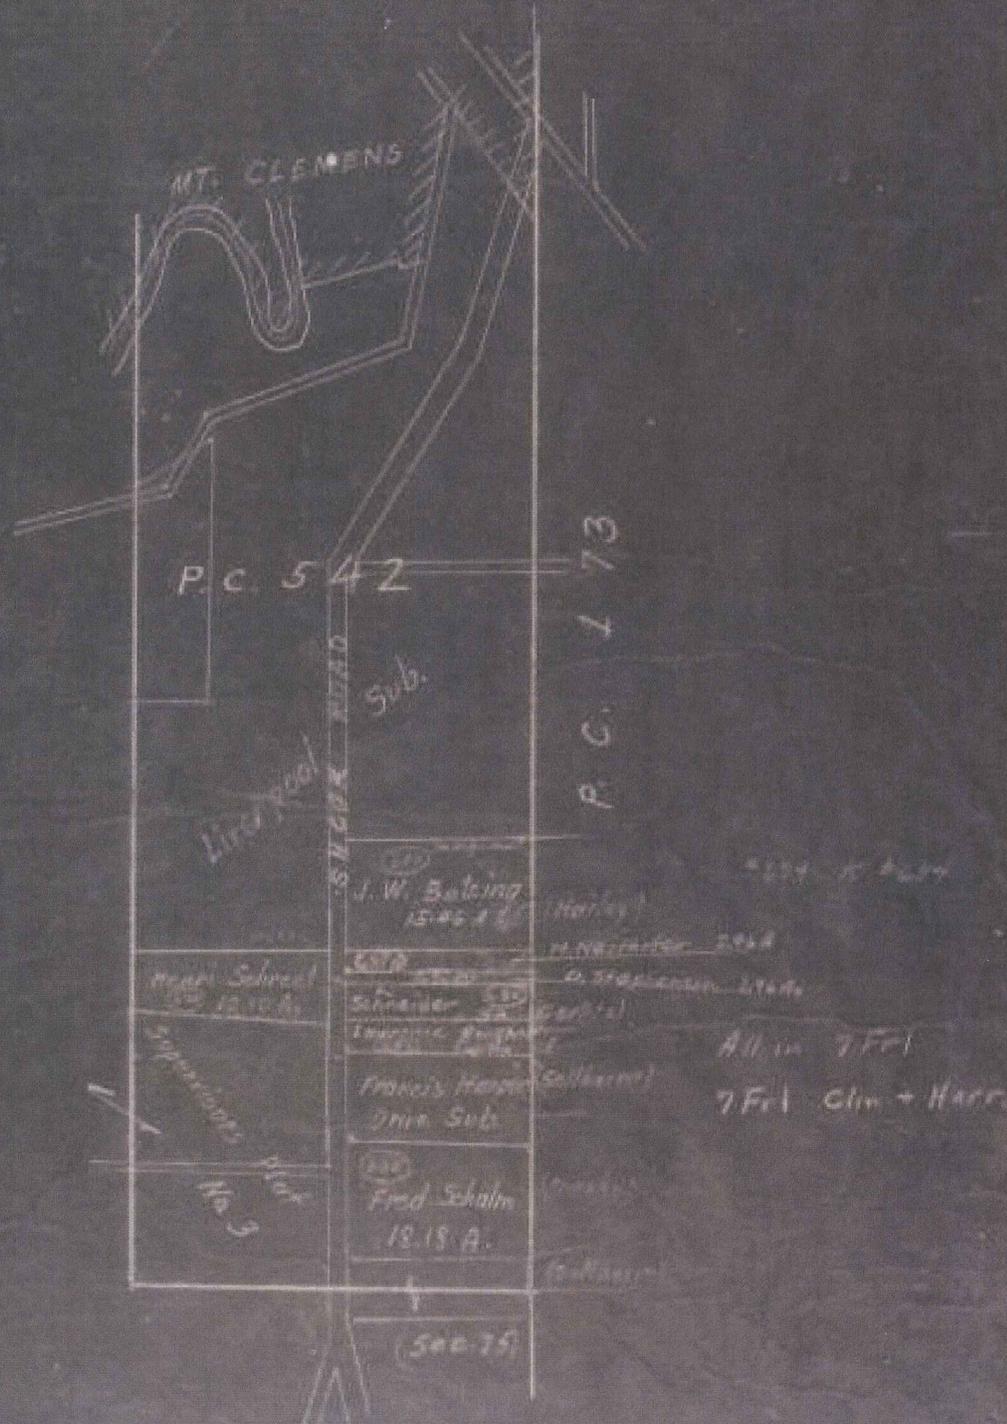

Mt Pleasant


CLINTON TOWNSHIP MACOMB COUNTY
SEC. 23 FRL TOWN 7N RANGE 13E

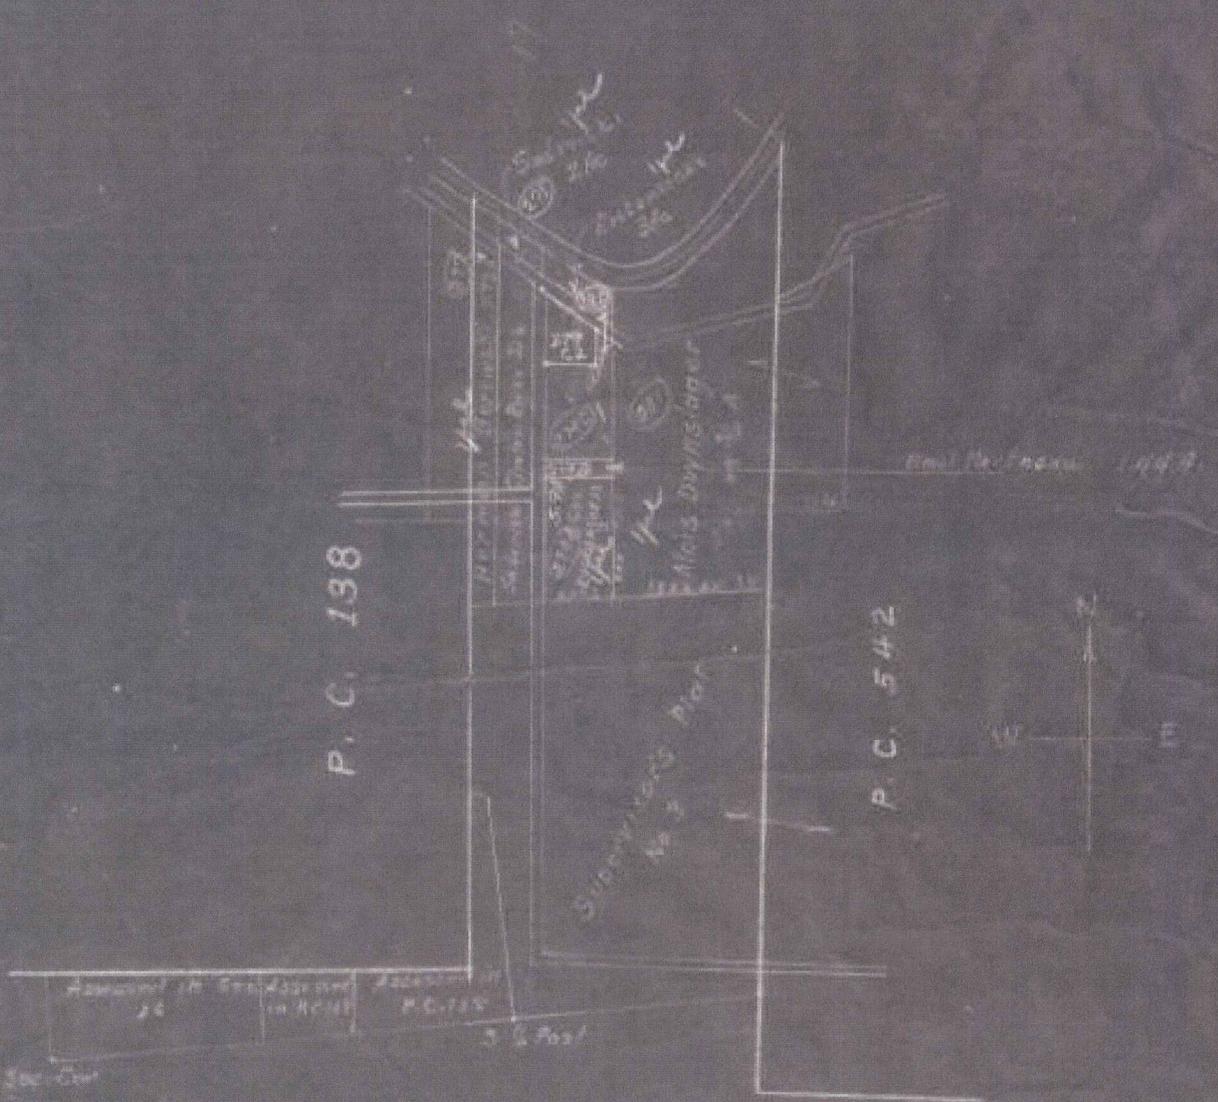

School Dist 14 Black
1 Frt Clin-Harr-Mt Clem.

27902 Geo. N. Pedersen 2A
27901 Geo. C. Pedersen 2A

CLINTON TOWNSHIP MACOMB COUNTY
 P.C. 173 TOWN 2N RANGE 13E

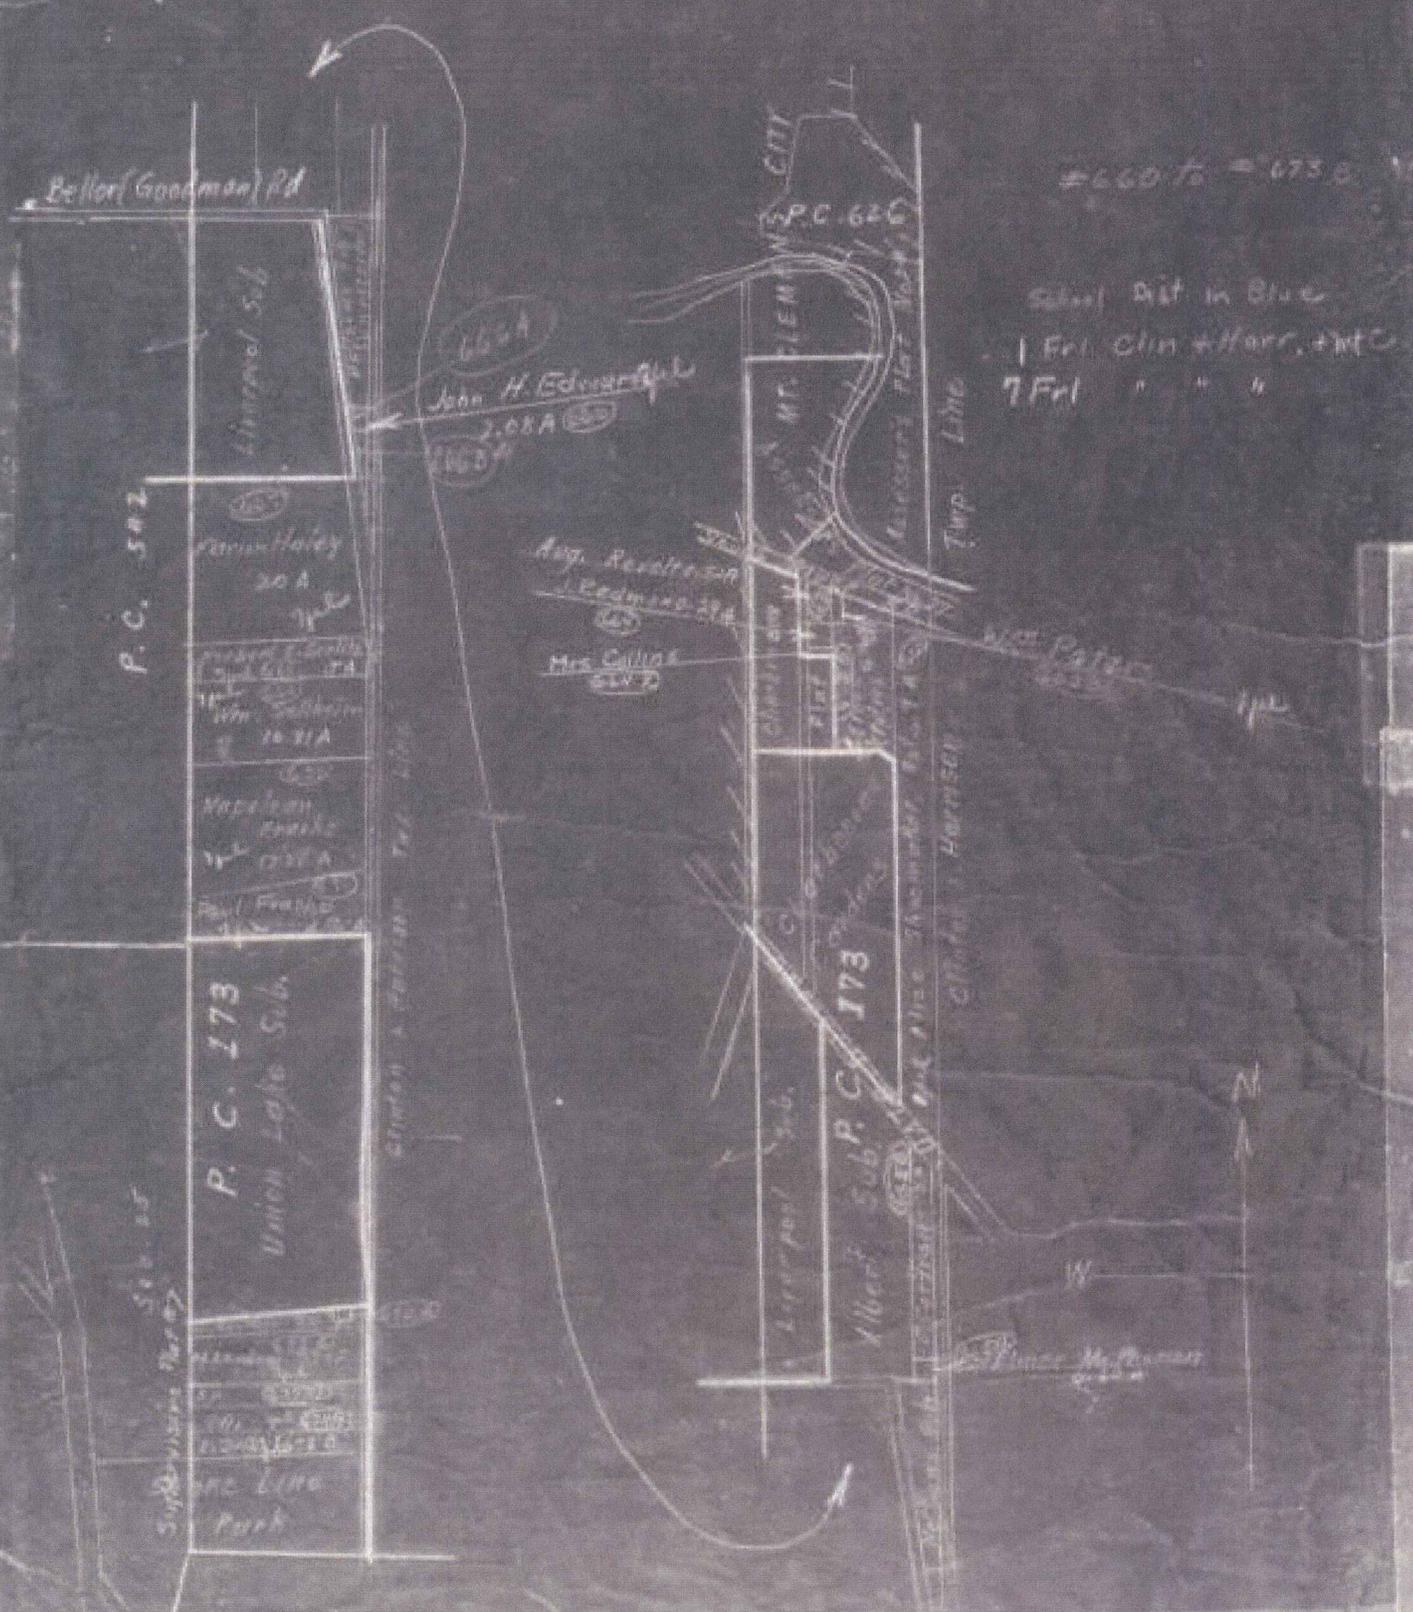


SUBDIVISION OF OUTLOT 3.
OF DON M. DICKINSON'S ADDITION TO THE
CITY OF MT CLEMENS MACOMB CO.
MICHIGAN

Scale 200 feet per inch.

Map L. BROWN C.E.
25-26 Hudson Block
Detroit Mich.

Sec 13-T2N-R13E.

Plot A.

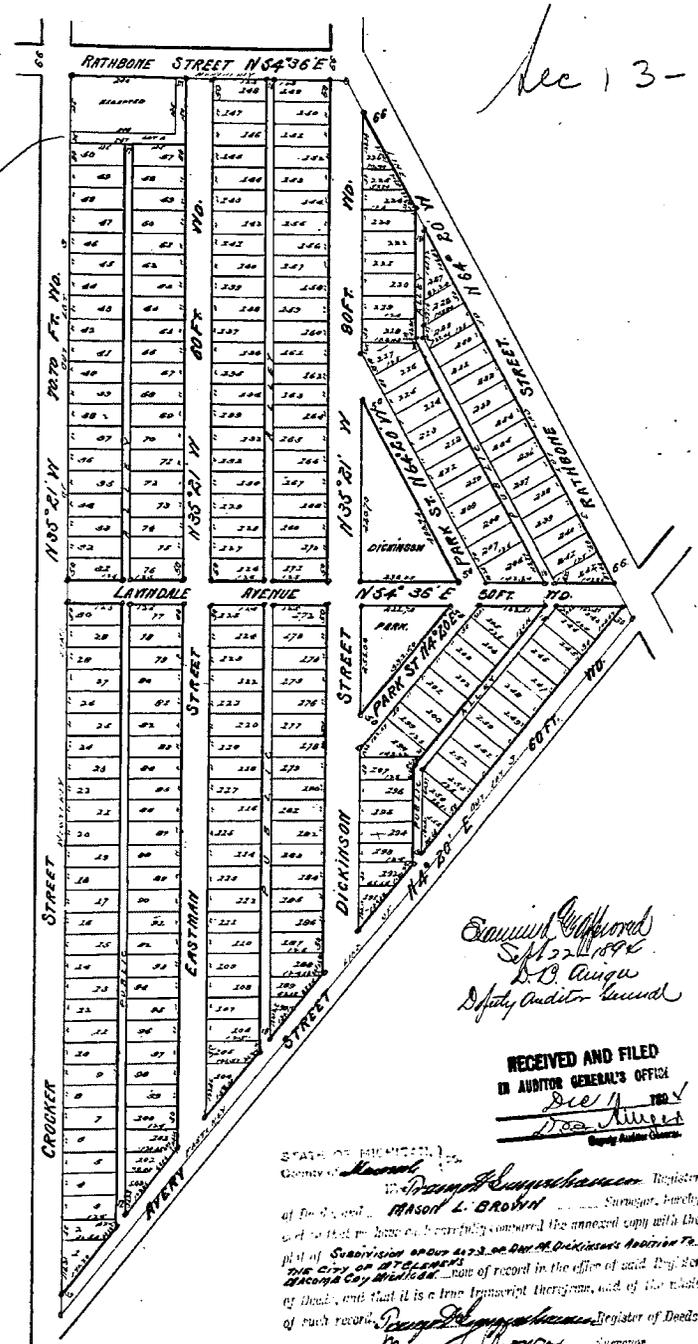

I hereby certify that the above Plat is correct, and that Monuments consisting of Oak Stakes 1 1/2 inches square and 15 inches long have been placed in the Ground at all angles in the Boundaries, and at the intersection of all Streets or Streets and Alleys, as shown on plat by O.
Detroit, July 18th 1894.
Merritt Jones
Engineer and Surveyor.

KNOW ALL MEN BY THESE PRESENTS, that we
Don M. Dickerson and
Frances S. Dickerson (his wife)
Have caused to be surveyed, laid out and plotted, to be known as a Subdivision of Outlot 3 of Don M. Dickerson's Addition to the City of Mt. Clemens, Michigan, and that the Streets and Alleys shown on said plat are hereby dedicated to the use of the public.
Witness our hands and seals this the 21st day of July A. D. Eighteen Hundred and Ninety four
In presence of:
James H. Hall
Richard J. Fleming
Merritt Jones
Francis S. Dickerson

Examined & found correct
Sept 22, 1894
D. B. Angus
Deputy Auditor General

RECEIVED AND FILED
IN AUDITOR GENERAL'S OFFICE
Dec 11 1894
D. B. Angus
Deputy Auditor General

STATE OF MICHIGAN,
County of Macomb.
We, Donald Cunningham, Register of Deeds, and Mason L. Brown, Surveyor, hereby certify that we have carefully compared the annexed copy with the plat of Subdivision of Outlot 3 of Don M. Dickerson's Addition to the City of Mt. Clemens, Michigan, and that it is an exact copy thereof and of the whole of such original map or plat.
Donald Cunningham, Register of Deeds.
Mason L. Brown, Surveyor.

STATE OF MICHIGAN,
County of Macomb.
On this, the 11th day of August 1894, before me, a Notary Public in and for said county, personally appeared the above named Don M. Dickerson and Frances S. Dickerson (his wife), known to me to be the same persons who executed the above dedication, and who acknowledged the same to be their free act and deed.
James H. Hall, Notary Public.
Macomb County, Michigan.

STATE OF MICHIGAN,
County of Macomb.
We, Donald Cunningham, Register of Deeds, and Mason L. Brown, Surveyor, hereby certify that we have each carefully compared this copy with the original plat of Subdivision of Outlot 3 of Don M. Dickerson's Addition to the City of Mt. Clemens, Michigan, and that it is an exact copy thereof and of the whole of such original map or plat.
Donald Cunningham, Register of Deeds.
Merritt Jones, Surveyor.


SEARCHING OFFICE,
Macomb County, Mich.
Received for Record the 11th day of December, A. D. 1894.
Notary Public, M. L. and Francis S. Dickerson.
Liberty, Mich.
Page 1 of 1
Donald Cunningham, Register.

UNIONLAKE SUBDIVISION OF LOTS 10, 11, 12, 13 AND 14 OF SUBDIVISION OF SOUTH PART OF PRIVATE CLAIM 173 T. 2 N. R. 13 E. MACOMB CO., MICHIGAN

6/14/18

June 13-1918
Geo. L. Houser

Scale 200' = 1"

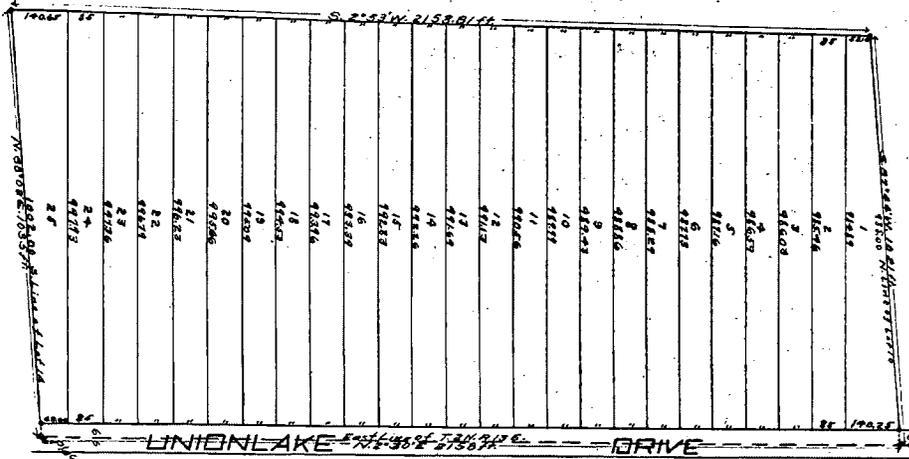

Note: All dimensions on this plat are in feet and tenths of feet.

Sec. 26 T. 2 N. R. 13 E

DEDICATION.

KNOW ALL BY THESE PRESENTS, THAT I Maria John, a woman, as proprietress, have caused the land embraced in the annexed plat to be surveyed, laid out and platted, to be known as UNIONLAKE SUBDIVISION OF LOTS 10, 11, 12, 13 AND 14 OF SUBDIVISION OF SOUTH PART OF PRIVATE CLAIM 173 T. 2 N. R. 13 E. MACOMB CO., MICHIGAN and that the street as shown on said plat is hereby dedicated to the use of the public.

SIGNED AND SEALED IN THE PRESENCE OF
Geo. L. Houser *Maria John* (L. S.)
Geo. W. D. Lewis (L. S.)
 STATE OF MICHIGAN, }
 County of Macomb. } SS.
 On this *fifth* day of *February* 1918 before me, a Notary Public in and for said county, personally came the above named Maria John, known to me to be the person who executed the above dedication, and acknowledged the same to be her free act and deed.
Geo. W. D. Lewis
 Notary Public Macomb Co., Mich.

By Commission expires December 29th, 1918.

DESCRIPTION

The land embraced in the annexed plat of UNIONLAKE SUBDIVISION OF LOTS 10, 11, 12, 13 and 14 OF SUBDIVISION OF SOUTH PART OF PRIVATE CLAIM 173 T. 2 N. R. 13 E. MACOMB CO., MICHIGAN is described as follows:-
 Beginning at a point on the easterly line of T. 2 N. R. 13 E. Macomb Co., Mich.-
 1st: N. 2° 30' E. 235.6 feet from the southerly line of Private Claim 173; thence
 N. 2° 30' E. 219.8 feet; thence S. 37° 44' W. 1021 feet; thence S. 2° 55' W. 2153.81 feet; thence
 N. 88° 02' E. 1000 feet to the place of beginning. All lying and being in Private Claim 173 T. 2 N. R. 13 E. Macomb Co., Michigan.
 And being all of lots 10, 11, 12, 13 and 14 of Subdivision of South part of Private Claim 173 T. 2 N. R. 13 E. Macomb Co., Michigan.

ENGINEER'S CERTIFICATE

I hereby certify that the plat hereon delineated is a correct one, and that permanent monuments, consisting of iron gas pipe 1/2 inch in diameter and 15 inches long have been planted at all points marked thus (c) as thereon shown at all angles in the boundaries of the land platted and at all intersections of said boundaries with the street.
Geo. W. D. Lewis Civil Engineer

CERTIFICATE OF TOWNSHIP APPROVAL

This plat was approved by the Township Board of the Township of Clinton Macomb County Michigan at a meeting held *May 11th* 1918
Walter Williams Clerk

COUNTY TREASURER'S CERTIFICATE RELATING TO TAXES

Office of County Treasurer Macomb County State of Michigan. *May 11th* 1918
 I HEREBY CERTIFY, That there are no tax liens or titles held by the State on the lands described in the annexed plat, and that there are no tax liens or titles held by individuals on said lands, for the five years preceeding the *fifth* day of *February* 1918, and that the taxes for said period of five years are paid, as shown by the records of this office.
Harman J. Schultz County Treasurer

CERTIFICATE OF COUNTY PLATTING BOARD

This plat was approved by the County Platting Board of the County of Macomb State of Michigan at a meeting held *May 11th* 1918
Walter Williams Judge of Probate
Harman J. Schultz County Clerk
Harman J. Schultz County Treasurer

I HEREBY CERTIFY THAT THIS COPY IS A TRUE COPY OF THE MAP OR PLAT FORWARDED THE CLERK OF DEEDS FOR RECORDING.
 COMPARED *June 10 1918*
Geo. L. Houser
 DEPUTY AUDITOR GENERAL

COPY
 RECEIVED BY
Walter Williams
 JUDGE OF PROBATE
 MAY 11 1918
Walter Williams
 CLERK OF DEEDS
 ORIGINAL ON FILE



FILED IN AUDITOR GENERAL'S OFFICE
June 13 1918
Geo. L. Houser
 DEPUTY AUDITOR GENERAL

CHARBENEAU GARDENS

A SUBDIVISION OF PART OF P.C. 173 T. 2 N. R. 13 E,
MACOMB COUNTY MICHIGAN

SCALE 200' = 1"

RECORDED
JUN 6 - 1925
J. L. HURRY
Deputy

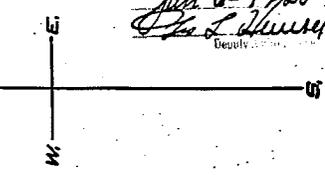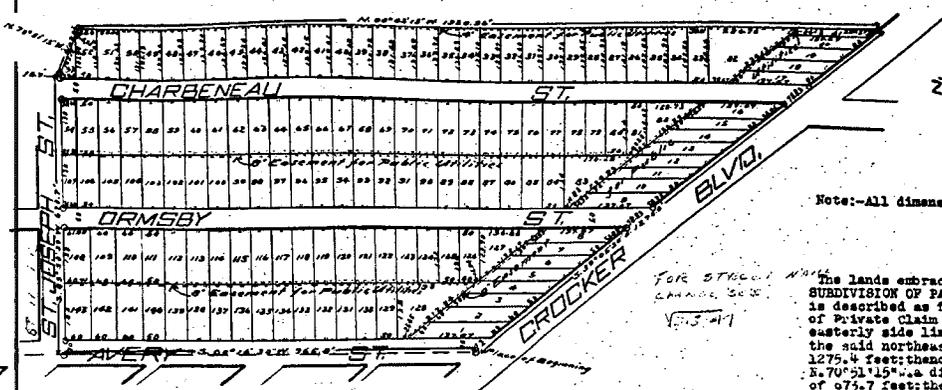

Note:--All dimensions on this plat are in feet and decimals thereof.

DESCRIPTION

The lands embraced in the annexed plat of "CHARBENEAU GARDENS" A SUBDIVISION OF PART OF P.C. 173 T. 2 N. R. 13 E. MACOMB COUNTY, MICHIGAN is described as follows, to wit:--Beginning on the westerly side line of Private Claim No. 173 where the same is intersected by the north-easterly side line of Crocker Boulevard; thence S. 49° 05' 50" E. along the said north-easterly side line of Crocker Boulevard a distance of 1275.4 feet; thence S. 00° 47' 15" W. a distance of 1920.96 feet; thence E. 70° 51' 15" W. a distance of 107.5 feet; thence S. 89° 56' 30" W. a distance of 875.7 feet; thence S. 00° 16' 30" W. to the place of beginning. All of the above described lands are in Private Claim No. 173, T. 2 N. R. 13 E. Macomb County, Michigan.

COUNTY TREASURER'S CERTIFICATE

Office of the County Treasurer, *Dec. 30 - 1924* Macomb Co. Mich. I hereby certify that there are no tax liens or titles held by the State on the lands described on the annexed plat, so that there are no tax liens or titles held by individuals on said lands, for the five years preceding the 29th day of September 1924, and that the taxes for said period of five years have been paid as shown by the records of this office
James C. Hallett
County Treasurer.

CERTIFICATE OF COUNTY PLATTING BOARD

This plat was approved on the *30th* day of *Dec.* 1924.
Clayton A. Hammond Judge of Probate.
Walter J. Huff County Clerk.
James C. Hallett County Treasurer.

CERTIFICATE OF TOWNSHIP BOARD

This plat was approved by the Township Board of the Township of Clinton, Macomb County, Michigan, at a meeting held *November 19th* 1924.
Walter J. Huff
Township Clerk.

DEDICATION
KNOW ALL MEN BY THESE PRESENTS, That we, William Charbeneau and Mary C. Charbeneau his wife, David Charbeneau and Nora Charbeneau his wife, Gilbert Charbeneau (a widower), Louis Charbeneau (a widower), Maud Jock, Joseph Charbeneau and Mary J. Charbeneau his wife, Joseph Young and Mabel Young his wife and Bert Peltier and Ella Peltier his wife as proprietors have caused the land embraced in the annexed plat to be surveyed, laid out and platted to be known as "CHARBENEAU GARDENS" A SUBDIVISION OF PART OF P.C. 173, T. 2 N. R. 13 E. MACOMB COUNTY MICHIGAN and that the streets and easements as shown on said plat are hereby dedicated to the use of the public.

- Signed and Sealed in Presence of:
- John W. Brown* (L.S.)
 - Edna Charbeneau* (L.S.)
 - William Charbeneau* (L.S.)
 - Mary C. Charbeneau* (L.S.)
 - Gilbert Charbeneau* (L.S.)
 - Louis Charbeneau* (L.S.)
 - Nora Charbeneau* (L.S.)
 - Maud Jock* (L.S.)
 - Joseph Charbeneau* (L.S.)
 - Mary J. Charbeneau* (L.S.)
 - Joseph Young* (L.S.)
 - Mabel Young* (L.S.)
 - Bert Peltier* (L.S.)
 - Ella Peltier* (L.S.)

STATE OF MICHIGAN } ss.
County of Macomb }
On this 29th day of September 1924 before me, a Notary Public in and for said county, personally came the above named William Charbeneau and Mary C. Charbeneau his wife, David Charbeneau and Nora Charbeneau his wife, Gilbert Charbeneau (a widower), Louis Charbeneau (a widower), Maud Jock, Joseph Charbeneau and Mary J. Charbeneau his wife, Joseph Young and Mabel Young his wife and Bert Peltier and Ella Peltier his wife known to me to be the persons who executed the above dedication and acknowledged the same to be their free act and deed
John W. Brown
Notary Public Macomb County, Michigan
My commission expires January 3rd 1927

ENGINEER'S CERTIFICATE

I hereby certify that the plat hereon delineated is a correct one, and that permanent monuments consisting of iron gas pipe 1 1/2 inches long and 1/2 inch in diameter have been planted at all points marked thus (o) as thereon shown at all angles in boundaries of the lands platted and at all intersections of streets.
John W. Brown
Registered Civil Engineer

COPY
Macomb County
Charbeneau, J. L.
JUN 6 - 1925
J. L. HURRY
Deputy


JUN 9 - 1925
J. L. HURRY
Deputy

FRANCIS HARPER DRIVE SUB

LYING IN P.C. 542 T.2N, R.13E. TWP. OF CLINTON MACOMB CO. MICH.

Oct 13-1925
J. L. Hurst

Oct 13-1925
J. L. Hurst
Oct 21-1925
J. L. Hurst

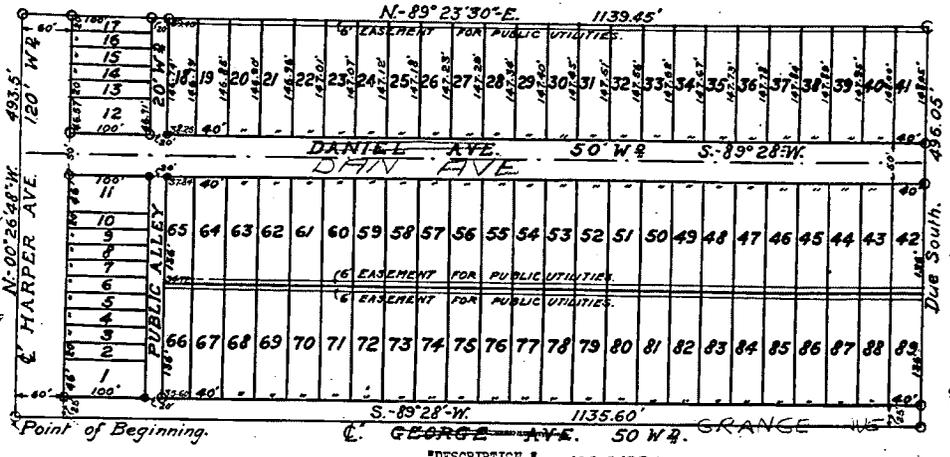

SCALE 1"=100'

Beginning at a point in the Center Line of Harper Ave. distant 5775 feet, measured ~~along~~ along the center line of Harper Ave. from its intersection with the south line of Section 26 T 2 N R 13 E; thence N.00°-26' - 48" W along the center line of Harper Ave. a distance of 493.50 feet to a point; thence N 89° - 23' - 30" E a distance of 1139.45 feet to a point; thence due south 493.05 feet to a point; thence S 89° - 28' W a distance of 1135.60 feet to the point of beginning.

I hereby certify that the Plat hereon delineated, is a correct one and that permanent monuments consisting of 1 inch by 15 inches pipes set in concrete bases 4 inches in diameter, and 48 inches in depth, have been placed in the ground, at all points marked thus (o) as shown thereon at all angles and the boundaries of the land platted, and all intersections of streets, of alleys, or of streets and alleys, or of streets or alleys with the boundaries of the plat.

I hereby certify that this plat has been approved by the Township Board of the Township of Clinton, at a session held Sept 18th 1925.

James J. Mahon
REGISTERED CIVIL ENGINEER - SURVEYOR.

Walter H. Hubert
CLERK

KNOW ALL MEN BY THESE PRESENTS :- Daniel R. Costello & Esther M Costello, his wife, That I, Raymond J. Francis, and Eva B Francis, his wife, the proprietors, have caused the land embraced in the annexed plat to be surveyed, laid out and platted, to be known as "FRANCIS HARPER DRIVE SUB", lying in P.C. 542 T.2 N.R.13 E Twp of Clinton, Macomb Co. Mich., and the streets and alleys shown on said plat are hereby dedicated to the use of the public.

SIGNED AND SEALED IN THE PRESENCE OF

George J. Francis L.S. Daniel R. Costello L.S.
Eva B. Francis L.S. Esther M. Costello L.S.

STATE OF MICHIGAN) Daniel R. Costello & Esther M Costello,
COUNTY OF Washtenaw) SS: Notary Public in and for Washtenaw County, Michigan.
On this 2nd day of October 1925, before me, a Notary Public, personally came the above named Raymond J. Francis, and Eva B Francis, his wife, and his wife, known to me to be the persons who executed the above dedication, and acknowledged the same to be their free act and deed.

KNOW ALL MEN BY THESE PRESENTS:- That we, THE STATE SAVINGS BANK OF NEW BARTIMORE, a MICHIGAN Corporation, by James J. Mahon as Mortgagee, have caused the land embraced in the annexed Plat to be surveyed, laid out and platted, to be known as "FRANCIS HARPER DRIVE SUB" lying in P.C. 542 T.2 N.R.13 E Twp of Clinton, Macomb Co Mich., and that the streets and alleys shown on said plat are hereby dedicated to the use of the PUBLIC.

Signed and Sealed in the Presence of

James J. Mahon L.S. Walter H. Hubert L.S.

STATE OF MICHIGAN) James J. Mahon
COUNTY OF Washtenaw) SS: Notary Public, in and for Washtenaw County, Mich.
On this 2nd day of October 1925, before me, a Notary Public, in and for said County, personally came the above named James J. Mahon and Walter H. Hubert respectively of the State Savings Bank of New Bartimore, a MICHIGAN Corporation, and that the Seal affixed to said instrument is the Corporate Seal of said Corporation, and the said instrument was signed and sealed in behalf of said Corporation, by authority of its Board of Directors, and the said James J. Mahon and Walter H. Hubert acknowledged the said instrument to be the free act and deed of said Corporation.

James J. Mahon
Notary Public, in and for Washtenaw County, Mich.
My commission expires March 31 - 1927.

It is expressly understood and agreed that no lot on this subdivision is to be occupied by a person not of the Caucasian Race.

This plat was approved by the County Board for Macomb County, Michigan, at a meeting held Oct 10-1925.

Charles H. Brown
County Clerk

James J. Mahon
Notary Public

Francis Harper Drive Sub
1925


FRANCIS HARPER DRIVE SUB

LYING IN P.C. 542 T.2N., R.13E. TWP. OF CLINTON
MACOMB CO. MICH.

Oct 7-1925
J. R. Hull

Oct 13-1925
J. R. Hull

Oct 21-1925
J. R. Hull

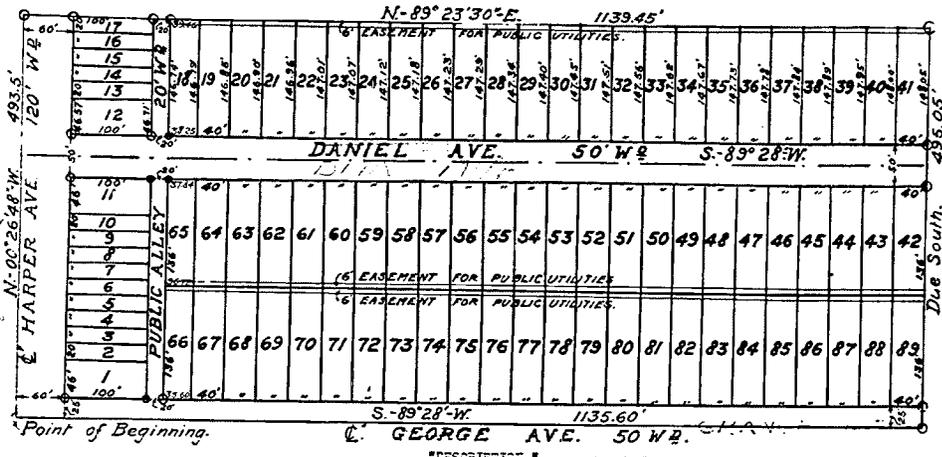

Francis
Harper Nov 1911
Oct 25 1913
10 1913
28
Hugh & W. H. H. H.

Beginning at a point in the center line of Harper Ave. distant 5775 feet, measured ~~along~~ ^{NORTHERLY} along the center line of Harper Ave. from its intersection with the center line of Section 26 T.2 N. R.13 E. thence N-89°-23'-48" W along the center line of Harper Ave. a distance of 457.50 feet to a point; thence N 85°-23'-30" E a distance of 1233.45 feet to a point; thence due south 455.05 feet to a point; thence S 89°-28' W a distance of 1135.60 feet to the point of beginning.

I hereby certify that the Plat hereon delineated, is a correct one and that permanent monuments consisting of 1 inch by 15 inches pipes set in concrete bases 4 inches in diameter, and 46 inches in depth, have been placed in the ground, at all points marked thus (o) as shown thereon at all angles and the boundaries of the land, platted, and all intersections of streets, of alleys, or of streets and alleys, or of streets or alleys with the boundaries of the plat.

I hereby certify that this plat has been approved by the Township Board of the Township of Clinton, at a session held Oct 13 1925 1925.

James J. Mahon
REGISTERED CIVIL ENGINEER - SURVEYOR.
Walter H. Hinchey
CLERK

KNOW ALL MEN BY THESE PRESENTS, that Daniel R. Costello & Esther M. Costello, his wife, that I, Raymond J. Francis, and Eva B. Francis, his wife, proprietors, have caused the land embraced in the annexed plat to be surveyed, laid out and platted, to be known as "FRANCIS HARPER DRIVE SUB," lying in P.C. 542 T.2 N. R.13 E Twp. of Clinton, Macomb Co. Mich., and the streets and alleys shown on said plat are hereby dedicated to the use of the public.

SIGNED AND SEALED IN THE PRESENCE OF
Raymond J. Francis L.S. Daniel R. Costello L.S.
Eva B. Francis L.S. Esther M. Costello L.S.

STATE OF MICHIGAN) Daniel R. Costello & Esther M. Costello, his wife, and
COUNTY OF MACOMB) SS: Raymond J. Francis and Eva B. Francis, his wife, and
On this 2nd day of October 1925, before me, a Notary Public, personally came the above named Daniel R. Costello & Esther M. Costello, his wife, and Raymond J. Francis and Eva B. Francis, his wife, known to me to be the persons who executed the above dedication, and acknowledged the same to be their free act and deed.

Pius A. Walsh
Notary Public in and for Macomb County, Michigan.
My commission expires June 1927 1927

KNOW ALL MEN BY THESE PRESENTS, that we, THE CITIZENS STATE SAVINGS BANK OF NEW ENGLAND, a MICHIGAN Corporation, by Raymond J. Francis and Eva B. Francis as Mortgagees, have caused the land embraced in the annexed Plat to be surveyed, laid out and platted, to be known as "FRANCIS HARPER DRIVE SUB," lying in P.C. 542 T.2 N. R.13 E Twp. of Clinton, Macomb Co. Mich., and that the streets and alleys shown on said plat are hereby dedicated to the use of the PUBLIC.

Signed and Sealed in the Presence of
Raymond J. Francis L.S. Eva B. Francis L.S.
Raymond J. Francis L.S. Eva B. Francis L.S.

STATE OF MICHIGAN) Raymond J. Francis and Eva B. Francis, his wife, and
COUNTY OF MACOMB) SS: Daniel R. Costello & Esther M. Costello, his wife, and
On this 25 day of January 1925, before me, a Notary Public, in and for said County, personally came the above named Raymond J. Francis and Eva B. Francis, his wife, and Daniel R. Costello & Esther M. Costello, his wife, known to me to be the persons who executed the above dedication, and acknowledged the same to be their free act and deed.

Raymond J. Francis
Notary Public, in and for Macomb County, Mich.
My commission expires March 1925 1925

It is expressly understood and agreed that no lot on this subdivision is to be occupied by a person not of the Caucasian Race.

This plat was approved by the County Board for Macomb County, Michigan, at a session held Oct 10-14 1925
Charles H. Hinchey
James J. Mahon
Walter H. Hinchey
James J. Mahon

2058

RECEIVED

NOV - 2 1972

LEGAL DIVISION
DEPT. OF NATURAL RESOURCES

Macomb
22172

STATE OF MICHIGAN
IN THE CIRCUIT COURT FOR THE COUNTY OF MACOMB

Petition of VOGUE MANAGEMENT COMPANY,
a registered co-partnership, to vacate a portion
of the Six (6) Foot Easement for Public Utilities
of the Francis Harper Drive Subdivision in the
Township of Clinton, Macomb County, Michigan,

File No. X 72-4536

Petitioner.

JUDGMENT ORDER VACATING A PORTION OF THE SIX (6) FOOT
EASEMENT FOR PUBLIC UTILITIES OF THE FRANCIS HARPER
DRIVE SUBDIVISION IN THE TOWNSHIP OF CLINTON,
MACOMB COUNTY, MICHIGAN

At a session of said Court, held in the Macomb
County Court Building, City of Mount Clemens,
Macomb County, Michigan, this 30 day of
October, 1972.

PRESENT: HONORABLE EDWARD J. GALLAGHER, Circuit Judge.

This matter having come on for hearing on October 30, 1972, pursuant
to Petitioner's request to vacate a portion of the six (6) foot easement for public
utilities of the Francis Harper Drive Subdivision in the Township of Clinton,
Macomb County, Michigan;

It appearing to the Court after presentment of proofs in open Court and
the filing of consents, affidavits of service, publication and mailing, that the
petition should be granted.

It further appearing to the Court that the form of the statute has been
followed by the Petitioner and that there are good and just reasons for vacating a
portion of the plat in question and there being no objections filed or no appearances
at the hearing to voice objections, therefore,

IT IS ORDERED AND ADJUDGED, that that portion of the six (6) foot
easement for public utilities lying to the south of Lots 58 through 61 and that portion

22172

of the six (6) foot easement for public utilities lying to the north of Lots 70 to 73, inclusive, of Francis Harper Drive Subdivision, Clinton Township, Macomb County, Michigan, be and hereby is vacated.

IT IS FURTHER ORDERED AND ADJUDGED, that a certified copy of this Judgment Order Vacating a Portion of the Six (6) Foot Easement for Public Utilities of the Francis Harper Drive Subdivision in the Township of Clinton, Macomb County, Michigan, be recorded with the Register of Deeds for Macomb County, Michigan.

FBI

CIRCUIT JUDGE

A TRUE COPY

Gerry Craft

Examined and Approved
Oct 8-1926
J. L. House
County Auditor General

LIVERPOOL SUBDIVISION

OF PART OF P.C. 542 AND PART OF P.C. 175

CLINTON TWP. & CITY of MT. CLEMENS MACOMB CO. MICHIGAN

SCALE - 1"=150'


Note: All dimensions hereon are in feet and decimals thereof.

H.R. Omara
Registered Civil Engr
Halfway, Mich.

9175

L. 11
O.H.D.

See Section 8 Vacated Portions of Plat show 257, 258, 259, 999, 1000

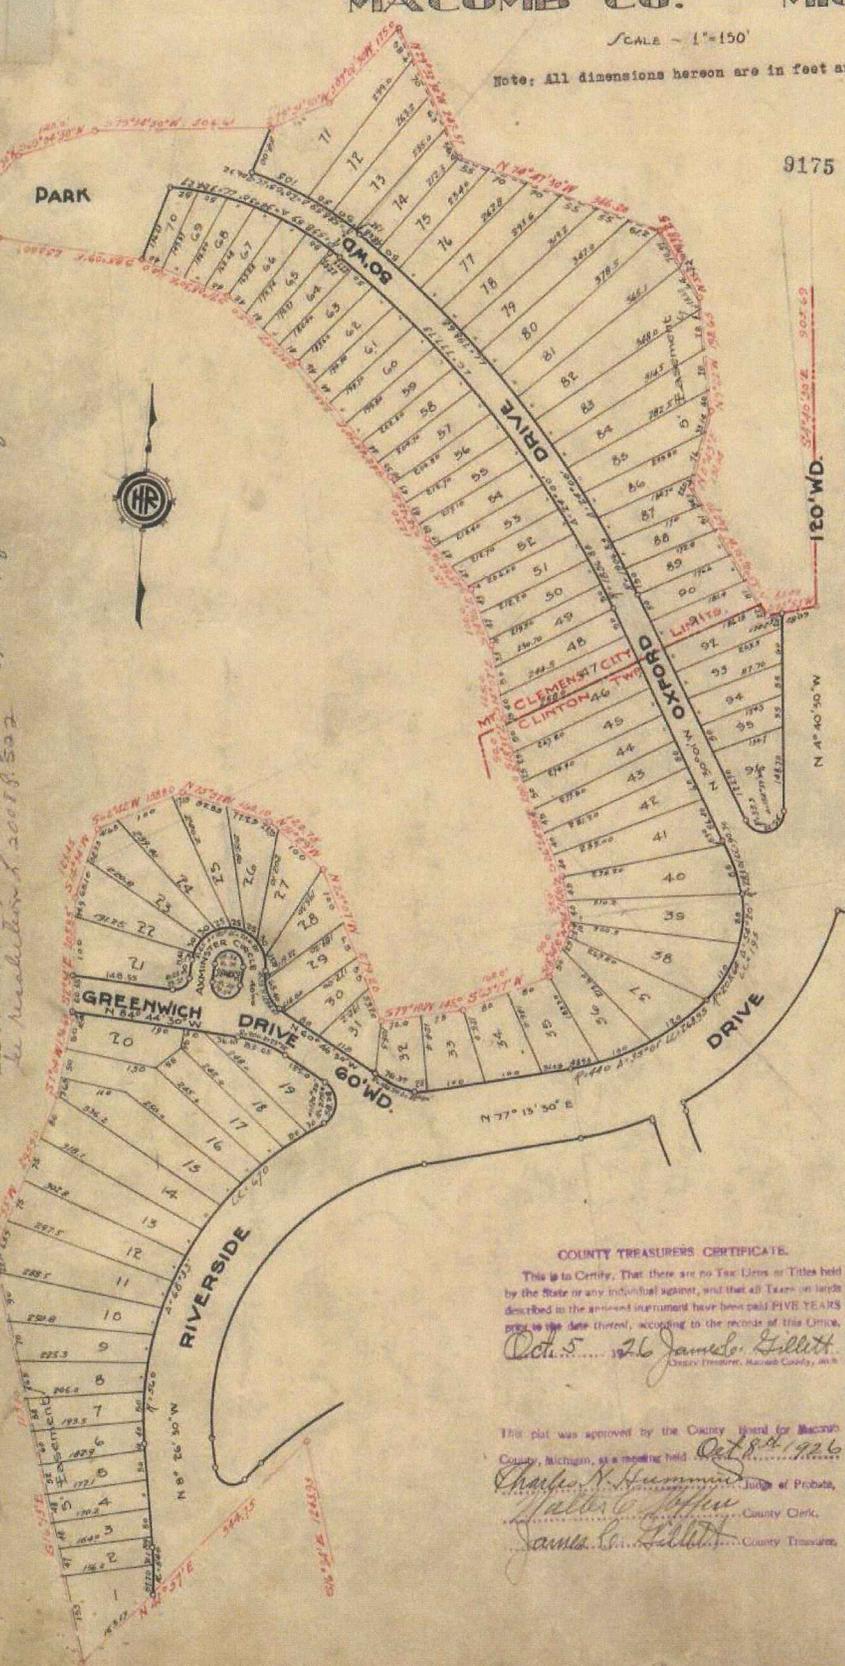

KNOW ALL MEN BY THESE PRESENTS: That we the Joint Development Company, a Michigan corporation, by Roy L. Chapin, President and Lewis A. Garrow, Secretary, our directors, have caused the following plat to be surveyed, laid out and plotted, to be known as "LIVERPOOL SUBDIVISION" of part of P.C. 542 and part of P.C. 175, Clinton Twp., & City of Mt. Clemens, Macomb Co., Michigan, and that the parks, streets and alleys as shown on said plat are hereby dedicated to the use of the public.

Signed and Sealed in Presence of:
J. Ambrose Notary Public
Roy L. Chapin (L.S.) President
Lewis A. Garrow (L.S.) Secretary

STATE OF MICHIGAN
COUNTY OF MACOMB
On this 14th day of September, A.D. 1926, before me, J. Ambrose, Notary Public in and for said County, appeared Roy L. Chapin and Lewis A. Garrow, to me personally known, who claim to be duly sworn and say that they are the President and Secretary respectively of the Joint Development Company a Michigan corporation,

and that said instrument was signed and sealed in behalf of said corporation by authority of its Board of Directors and the said Roy L. Chapin & Lewis A. Garrow acknowledged said instrument to be the true and just debt of said corporation.
Above Corporation does not have a seal.

By Commission expires Jan 14, 1927
J. Ambrose
Notary Public
Macomb Co., Mich.

CERTIFICATE OF MUNICIPAL APPROVAL
I hereby certify that the plat hereon delineated is a correct one and that permanent metal monuments of not less than one inch in diameter and fifteen inches in length set in concrete bases at least four inches in diameter and forty-eight inches in depth have been placed at points marked thereon as shown shown at all the intersections of streets, interchanges of alleys, or of streets and alleys, and at the intersections of streets and alleys with the boundaries of the plat as shown on said plat.

H. Romara
Registered Civil Engineer

CERTIFICATE OF TOWNSHIP APPROVAL
This plat was approved by the City Commission of the City of Mt. Clemens at a meeting held Oct 5, 1926
Adrian
Clerk

CERTIFICATE OF COUNTY APPROVAL
This plat was approved by the Board of the City of Clinton at a meeting held Sept 10, 1926
Walter F. Schubert
Clerk

COUNTY TREASURERS CERTIFICATE
This is to Certify, That there are no Tax Deeds or Titles held by the State or any individual against, and that all Taxes on lands described in the annexed instrument have been paid FIVE YEARS ago to the date thereof, according to the records of this Office.
Oct 5, 1926 James C. Gillett
County Treasurer, Macomb County, Mich.

This plat was approved by the County Board for Macomb County, Michigan, at a meeting held Oct 8, 1926
Charles N. Hummel Judge of Probate
Walter C. Miller County Clerk
James C. Gillett County Treasurer

REGISTER'S OFFICE
County of Macomb, Mich.
Received for Record this 14th day of Sept, A.D. 1926, at 11:15 o'clock A.M. and Recorded in Liber 4 of 1926 on Page 48
Wm. J. G. ...

See Resolution of the Board of Directors of the City of Mt. Clemens, Michigan, passed at a meeting held on the 5th day of October, 1926, and recorded in the minutes of the Board of Directors of the City of Mt. Clemens, Michigan, on page 33 of the minutes.

LIVERPOOL SUBDIVISION

OF PART OF P.C. 542 AND PART OF P.C. 173 9176

CLINTON TWP. & CITY OF MT. CLEMENS MACOMB CO. MICHIGAN

DESCRIPTION OF LAND PLATTED

The land embraced in the annexed plat of LIVERPOOL SUBDIVISION, of part of P.C. 542 and part of P.C. 173, Clinton Twp., & City of Mt. Clemens, Macomb Co., Michigan, is described as follows:

Beginning at the intersection of the West line of P.C. 173 and the centerline of Crocker Blvd. (so-called) 177' 11/2" Clinton Twp., Macomb Co., Mich. Thence N. 54° 30' 30" W. 140.0 ft. Thence S. 85° 19' 30" W. 650.00 ft. Thence S. 30° 23' 30" W. 220.22 ft. Thence S. 15° 39' E. 127.86 ft. Thence S. 04° 40' 00" E. 308.60 ft. Thence S. 75° 12' W. 61.49 ft. Thence N. 25° 18' 30" W. 260.7 ft. Thence N. 11° 47' N. 121.12 ft. Thence S. 09° 22' W. 128.65 ft. Thence N. 35° 32' 50" W. 120.25 ft. Thence N 74° 47' 30" W. 566.20 ft.

N. 29° 32' 30" W. 247.57 ft. Thence S. 59° 01' 50" W. 175.0 ft. Thence S. 79° 31' 30" W. 100.0 ft. Thence S. 79° 14' 30" W. 306.51 ft. Thence S. 69° 04' 30" W. 140.0 ft. Thence S. 39° 19' 30" W. 89.0 ft. Thence S. 27° 19' 30" W. 81.0 ft. Thence S. 85° 02' 30" W. 250.0 ft. Thence S. 71° 08' 30" W. 160.0 ft. Thence S. 51° 16' 4. 166.0 ft. Thence S. 44° 48' 30" W. 255.0 ft. Thence S. 24° 45' E. 185.0 ft. Thence S. 42° 32' 30" W. 115.0 ft. Thence S. 14° 08' E. 100.0 ft. Thence S. 14° 07' E. 185.0 ft. Thence S. 10° 07' N. 20.0 ft. Thence S. 26° 24' 30" E. 200.0 ft. Thence S. 14° 58' 30" W. 34.0 ft. Thence S. 15° 34' 30" W. 90.0 ft. Thence S. 50° 17' W. 160.0 ft. Thence S. 72° 18' W. 145.0 ft. Thence N. 25° 07' W. 379.2 ft. Thence N. 51° 29' W. 122.75 ft. Thence N. 75° 37' W. 150.10 ft. Thence S. 68° 42' W. 168.8 ft. Thence S. 36° 34' W. 125.40 ft. Thence S. 02° 34' E. 200.85 ft. Thence S. 07° 04' W. 126.60 ft. Thence S. 17° 52' W. 225.2 ft. Thence S. 15° 17' E. 713.1 ft. Thence S. 41° 57' 30" W. 224.75 ft. Thence S. 15° 24' E. 1245.95 ft. Thence S. 23° 40' W. 465.0 ft. Thence S. 16° 28' E. 1298.8 ft. Thence N. 73° 24' E. 1144.87 ft. Thence N. 15° 31' W. 200.41 ft. Thence N. 18° 47' W. 143.71 ft. Thence N. 77° 09' 30" W. 1148.88 ft. Thence N. 70° 17' E. 911.48 ft. Thence N. 44° 22' E. 2455.25 ft. Thence S. 12° 38' 30" W. 345.75 ft. Thence N. 16° 27' 30" W. 2073.07 ft. Thence N. 04° 30' 30" W. 286.0 ft. to the point of beginning.


REGISTER'S OFFICE
County of Macomb

Received for Record this
October 14th A.D. 1926
at 11:16 o'clock A.M. and Recorded
in the
of
on page 41

Walter J. ...

141
11

*See order vesting portion of ...
See order vesting portion of ...
See order vesting portion of ...*

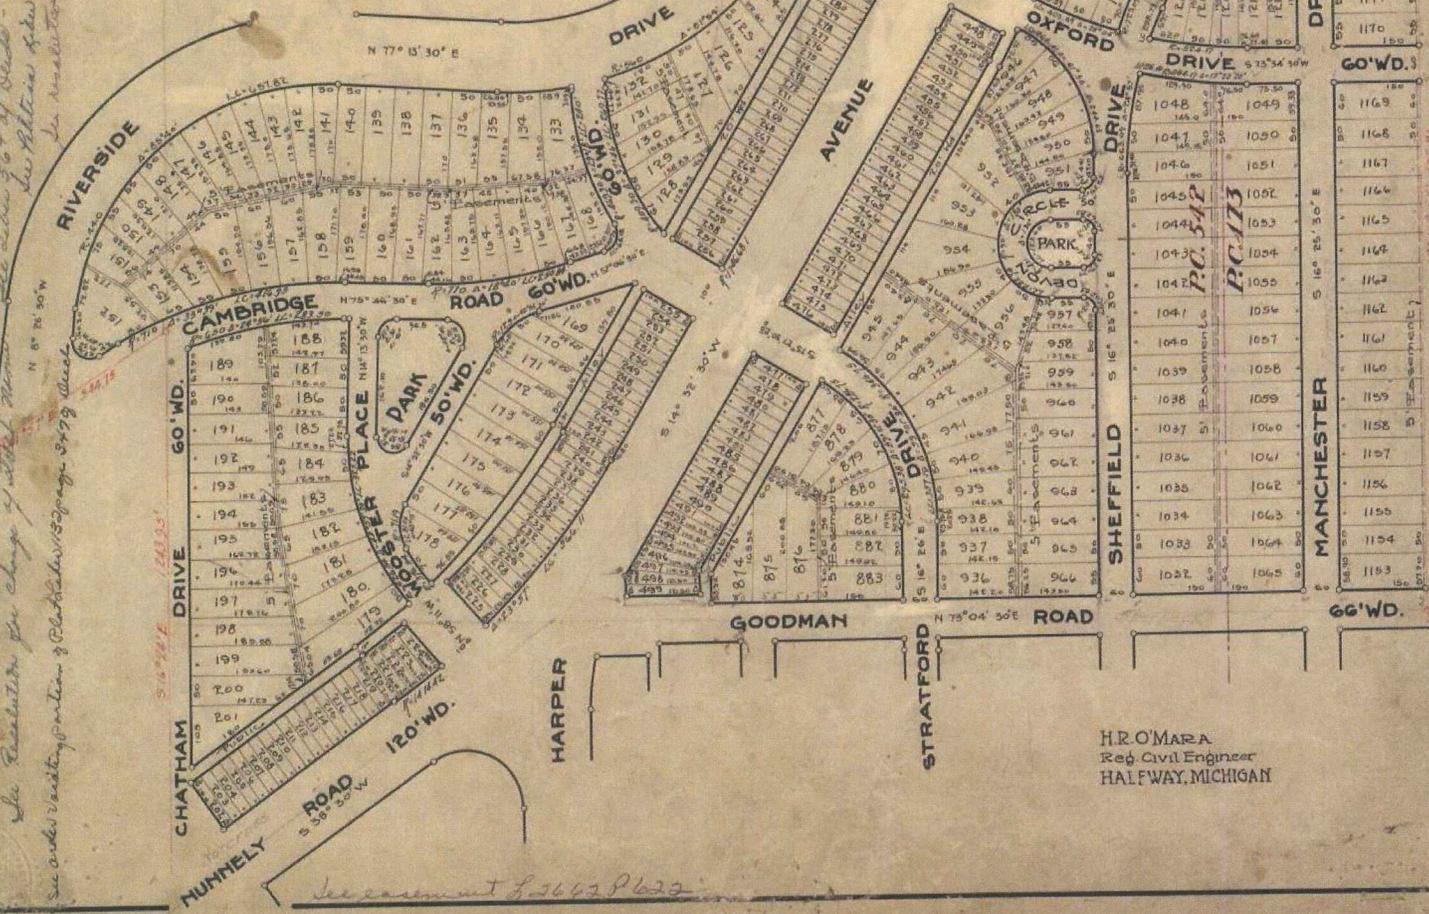

H. O. MARA
Reg. Civil Engineer
HALFWAY, MICHIGAN

LIVERPOOL SUBDIVISION

OF PART OF P.C. 542
AND PART OF P.C. 173

CLINTON TWP. &
CITY OF MT. CLEMENS
MACOMB CO.
MICHIGAN


9177

H.R. O'MARA
Reg. Civil Engineer
HALFWAY, MICHIGAN

RECORDER'S OFFICE
County of Macomb
Received for Record this 14 day
of October, A.D. 1922
at 11:16 o'clock A.M. and Recorded
in Liber 116 of 116
on Page 43
W. J. Kuyper, Register

L. 11
P. 42

*In Production of L. 200, P. 502
See Resolution for change of street name. See also map of L. 200, P. 502
See Resolution L. 200, P. 502*

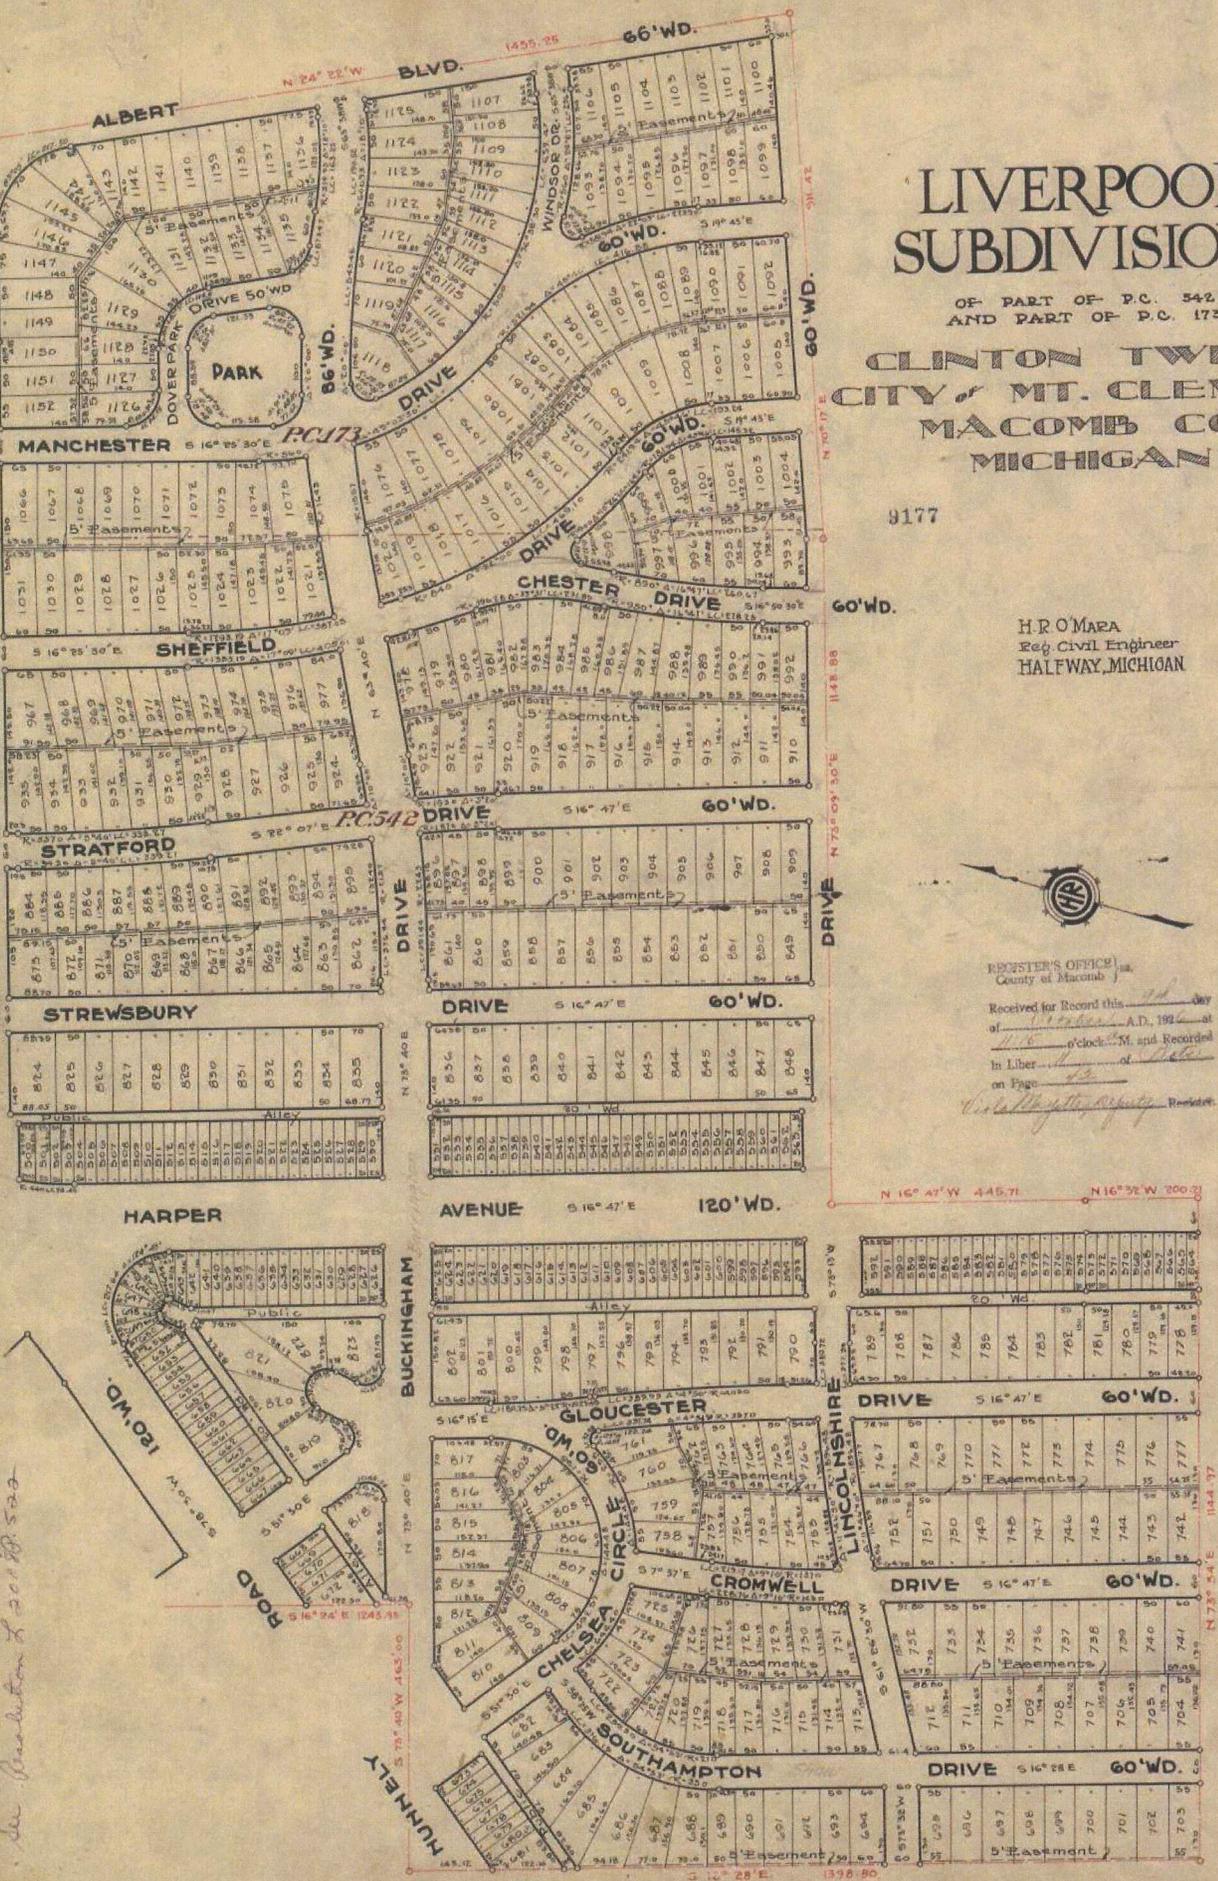

See also map L. 2662 P. 637


See Record to locate the location of Plot. Also see of Record page 17.
See Harrison Township 688 Record 109 321

Map to be corrected
1927
11
1927
11
1927
11
1927
11

DESCRIPTION OF LAND PLATED

The land embraced in the annexed plat of ROSECROFT SHORES SUBDIVISION of the SE₄ of the SE₂ of Section 26 and a part of W₄ of Fractional Section 25, 12E., 112E., Clinton Township and a part of E. 1/2, 164, Harrison Township and Clinton Township, Macomb County, Michigan, is described as follows:
Beginning at the point where the boundary common to Clinton Township, 12E., 112E., Macomb County, Michigan and Harrison Township, 12E., 112E., Macomb County, Michigan, intersects the S'ly line of T. 3. 164, Thence S. 71° 51' E. a distance of 255.1 ft. Thence N. 70° 41' E. a distance of 152.45 ft. Thence S. 72° 04' E. a distance of 766.66 ft. Thence N. 00° 45' W. a distance of 188.60 ft. Thence N. 65° 33' W. a distance of 651.0 ft. Thence N. 30° 41' E. a distance of 299.0 ft. Thence N. 63° 48' W. a distance of 1046.17 ft. Thence S. 04° 17' 20" W. a distance of 1976.22 ft. Thence N. 89° 26' 30" W. a distance of 3269.30 ft. Thence S. 19° 10' 30" W. a distance of 32.88 ft. Thence S. 20° 00' 00" W. a distance of 1392.05 ft. Thence S. 80° 20' 00" W. a distance of 1344.88 ft. Thence S. 00° 48' 00" E. a distance of 1427.65 ft. Thence S. 86° 26' 00" E. a distance of 58.92 ft. Thence S. 19° 10' 30" W. a distance of 1096.60 ft. Thence S. 17° 16' W. a distance of 144.8 ft. Thence S. 71° 51' E. a distance of 509.30 ft. to the point of beginning.

ROSECROFT SHORES SUBDIVISION
OF THE SE₄ OF THE SE₂ OF SECTION 26 AND A PART OF W₄ OF FRACTIONAL SECTION 25 T. 3 N. 13 E. CLINTON TOWNSHIP AND A PART OF P. 164
HARRISON TOWNSHIP AND CLINTON TOWNSHIP
MACOMB COUNTY MICHIGAN
SCALE FOOT = 4 IN.

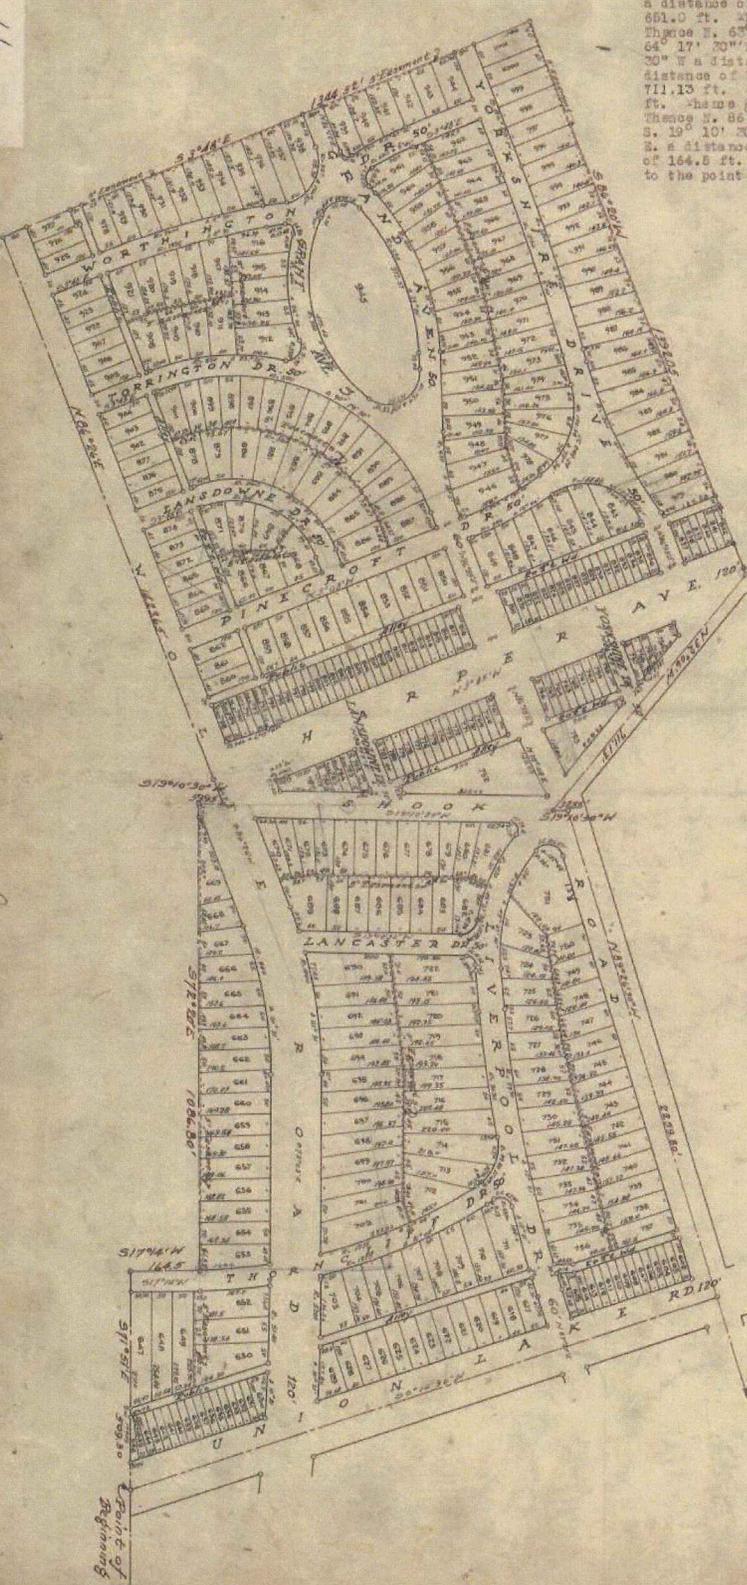

COUNTY TREASURER CARLISK AND
This is to certify that the above plat was filed by the State or any individual applicant in compliance with the laws of Michigan, and that the same is a true and correct copy of the original as filed in the office of the County Clerk, Macomb County, Michigan, on the date thereof, according to the records of this office.
June 8 1926 James A. Gullitt
County Treasurer, Macomb County, Mich.

This plat was approved by the County Board for Macomb County, Michigan, at a meeting held June 8-1926.
Charles H. Hummelbach, Judge of Probate,
James A. Gullitt, County Clerk,
James A. Gullitt, County Treasurer.

L. P. 11
P. 6.

See Macomb County Plat of Harrison Township & Clinton Township & a part of P. 164
See Macomb County Plat of Harrison Township & Clinton Township & a part of P. 164

SHEEN No. 2
OF 2 SHEETS

H. P. O'NEILL
Reg. Civil Engineer
Hawthorn, Michigan


Plat filed and approved
June 9 1926
James A. Gullitt
County Treasurer

ASSESSORS PLAT NO. 27 OF THE CITY OF MT. CLEMENS, MACOMB CO., MICHIGAN.

SCALE 1"=100'

Note:-- All dimensions hereon are in feet and decimals thereof.

640K
 3/16/29
 26
 27
 13
 46
 27-1929
 L. J. ...
 L. J. ...

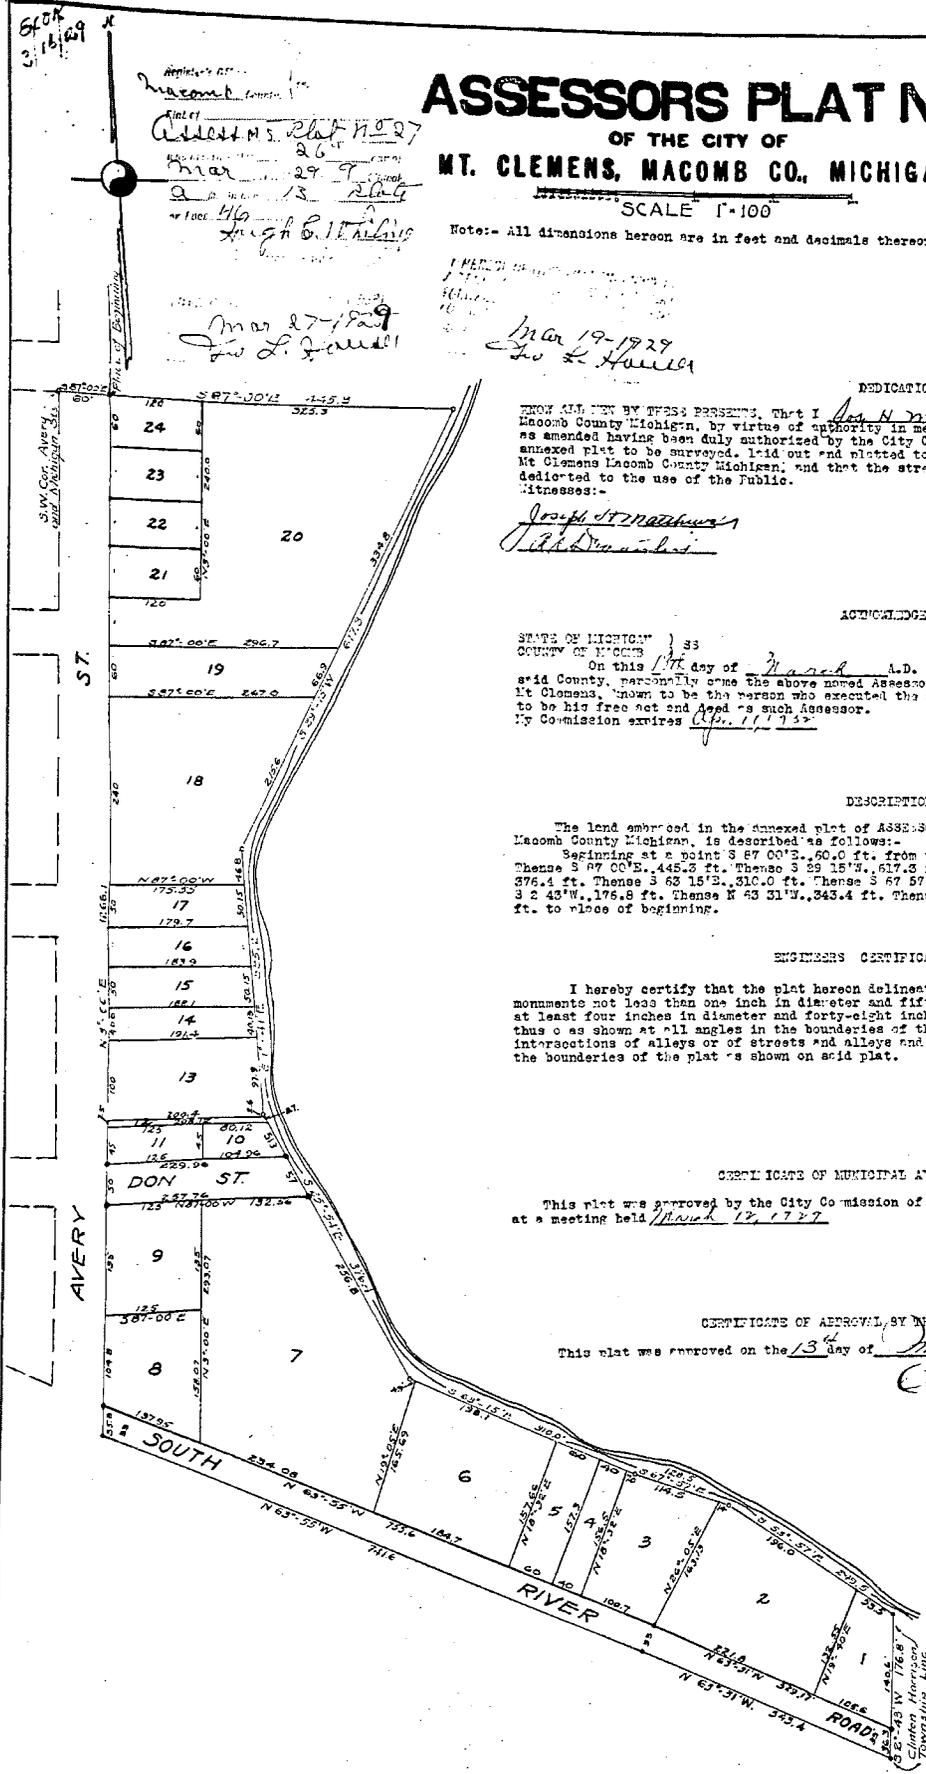

DEDICATION
 KNOW ALL MEN BY THESE PRESENTS, That I Asa H. Miller Assessor of the City of Mt Clemens Macomb County Michigan, by virtue of authority in me vested by section 3760 Compiled Laws of 1915, as amended having been duly authorized by the City Commission, have caused the land described in the annexed plat to be surveyed, laid out and platted to be known as ASSESSORS PLAT NO. 27 of the City of Mt Clemens Macomb County Michigan, and that the streets and alleys as shown on said plat are hereby dedicated to the use of the Public.
 Witnesses:
Joseph H. ...
Asa H. Miller Assessor of the City of Mt Clemens Macomb County Mich.

ACKNOWLEDGMENT
 STATE OF MICHIGAN } ss
 COUNTY OF MACOMB }
 On this 17th day of March A.D. 1929, before me a Notary Public in and for said County, personally came the above named Assessor Asa H. Miller of the City of Mt Clemens, known to be the person who executed the above dedication and acknowledged the same to be his free act and deed as such Assessor.
 My Commission expires Apr. 11, 1932
W. H. ... Notary Public in and for said County

DESCRIPTION
 The land embraced in the annexed plat of ASSESSORS PLAT NO. 27 of the City of Mt Clemens Macomb County Michigan, is described as follows:
 Beginning at a point 3 87 00"E., 60.0 ft. from the S.W. corner of Michigan and Avery Sts. Thence S 87 00"E., 445.3 ft. Thence S 28 15"W., 617.3 ft. Thence S 1 41"E., 376.2 ft. Thence S 25 54"E., 376.4 ft. Thence S 63 15"E., 310.0 ft. Thence S 67 59"E., 128.5 ft. Thence S 53 57"E., 245.5 ft. Thence S 2 43"W., 176.8 ft. Thence N 63 31"W., 343.4 ft. Thence N 63 55"W., 741.6 ft. Thence N 3 00"E., 1266.1 ft. to place of beginning.

ENGINEERS CERTIFICATE
 I hereby certify that the plat hereon delineated is a correct one and that permanent metal monuments not less than one inch in diameter and fifteen inches in length set in a concrete base at least four inches in diameter and forty-eight inches in depth have been placed at points marked thereon as shown at all angles in the boundaries of the land platted at all intersections of streets and intersections of alleys or of streets and alleys and at the intersections of streets and alleys with the boundaries of the plat as shown on said plat.
Robert W. ... Registered Civil Engineer

CERTIFICATE OF MUNICIPAL APPROVAL
 This plat was approved by the City Commission of the City of Mt Clemens Macomb County Michigan, at a meeting held March 12, 1929.
W. H. ... City Clerk

CERTIFICATE OF APPROVAL BY THE COUNTY BOARD
 This plat was approved on the 13th day of March 1929.
Charles H. ... Judge of Probate
Joseph A. ... County Clerk
William M. ... County Treasurer

City of Mt. Clemens
Assessors Plat No. 28 etc.
207
April 18 1929
High C. Whelting

ASSESSORS PLAT NO. 28

A SUBDIVISION OF OUTLOTS 1 & 2 DON M. DICKINSONS ADD
OF THE CITY OF
MT. CLEMENS, MACOMB CO., MICHIGAN.

Examined and Approved
April 18 1929
J. F. Harnett

SCALE 1"=100'

Note: - All dimensions hereon are in feet and decimals thereof

DEDICATION

KNOW ALL MEN BY THESE PRESENTS, That I Don H. Miller, Assessor of the City of Mt. Clemens Macomb County Michigan, by virtue of authority in me vested by section 3350 Compiled Laws of 1915, as amended, having been duly authorized by the City Commission, have caused the land described in the annexed plat to be surveyed, laid out and platted to be known as ASSESSORS PLAT NO. 28 of the City of Mt. Clemens Macomb County Michigan, and that the streets and alleys as shown on said plat are hereby dedicated to the use of the public.

Joseph A. Matthews
Address
Don H. Miller
Assessor of the City of Mt. Clemens

ACKNOWLEDGMENT

STATE OF MICHIGAN) SS
COUNTY OF MACOMB)
On this 20th day of March, A.D. 1929, before me a Notary Public in and for said County, personally came the above named Don H. Miller, Assessor of the City of Mt. Clemens, known to be the person who executed the above dedication and acknowledged the same to be his free act and deed as such Assessor. My Commission expires July 11, 1932.

DESCRIPTION

The land embraced in the annexed plat of ASSESSORS PLAT NO. 28 of the City of Mt. Clemens Macomb County Michigan, is described as follows:-
Beginning at a point S 87° 00' E., 40.0 ft. from the S.W. corner of Michigan and Avery Sts. Thence N 3° 00' E., 208.0 ft. Thence E 87° 00' W., 300.0 ft. Thence N 3° 00' E., 131.8 ft. Thence N 74° 15' E., 477.4 ft. Thence E 49° 44' E., 484.2 ft. Thence E 88° 18' E., 345.9 ft. Thence S 69° 24' E., 420.4 ft. Thence S 41° 00' E., 185.4 ft. Thence S 17° 50' W., 256.7 ft. Thence S 35° 27' W., 300.2 ft. Thence S 25° 15' W., 15.1 ft. Thence E 87° 00' W., 445.2 ft. to place of beginning. Being S.L. 1 & 2 of Don M. Dickinsons Add. to the City of Mt. Clemens.

ENGINEER'S CERTIFICATE

I hereby certify that the plat hereon delineated is a correct one and that permanent metal monuments not less than one inch in diameter and fifteen inches in length set in a concrete base at least four inches in diameter and forty-eight inches in length have been placed at points marked thus o as shown at all angles in the boundaries of the land related, at all intersections of streets, intersections of alleys or of streets and alleys and at the intersections of streets and alleys with the boundaries of the plat as shown on said plat.

Don H. Miller
Registered Civil Engineer

CERTIFICATE OF MUNICIPAL APPROVAL

This plat was approved by the City Commission of the City of Mt. Clemens Macomb County Michigan, at a meeting held March 11, 1929.

W. A. DeWitt City Clerk


CERTIFICATE OF APPROVAL BY THE COUNTY BOARD

This plat was approved on the 13th day of March, 1929.

Charles W. Hamrick Judge of Probate
Joseph A. Matthews County Clerk
William M. House County Treasurer

APR 18 1929
J. F. Harnett

FILED IN AUDITOR GENERAL'S DEPT.
April 22 1929
J. F. Harnett

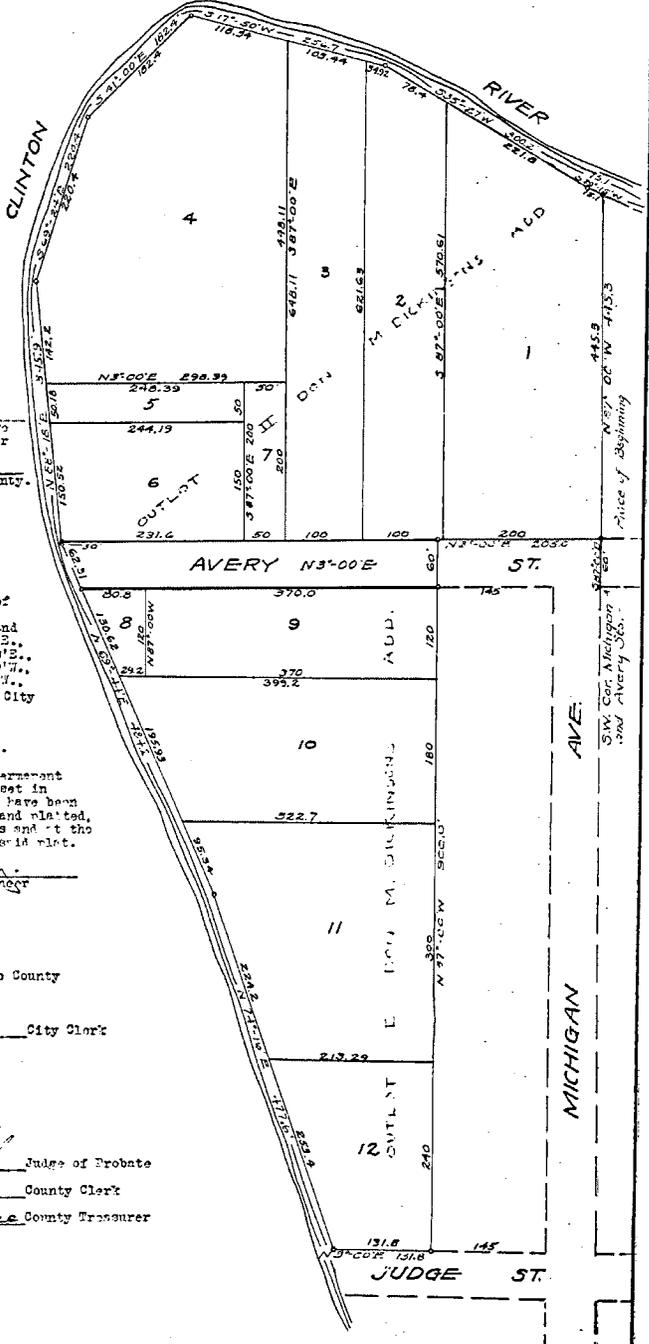

and see


6607
 COPIES
 Registrar's Office
 Macomb County, Mich.
 Date of Assessor's Plat No. 29 etc.
 was recorded this 20th day of April, A.D. 1929
 in Book 14 of Deeds
 Page 2
 Hugh E. Whiting
 FILED IN AUDITOR GENERAL'S DEPT.
 April 22-1929
 J. P. Stanger
 DEPUTY AUDITOR GENERAL

ASSESSORS PLAT NO. 29
 A SUBDIVISION OF LOT 1, BLK. 6, & LOT 1, BLK. 4, DON. M. DICKINSON ADD
 OF THE CITY OF
MT. CLEMENS, MACOMB CO., MICHIGAN.

Examined and Approved
 April 18-1929
 J. P. Stanger
 Deputy Auditor General

SCALE 1"=100'

I HEREBY CERTIFY THAT THE DIMENSIONS HEREON ARE IN FEET AND DECIMALS THEREOF.
 A TRUE COPY OF THIS MAP OR PLAT BEING FILED IN THE OFFICE OF DEEDS
 Macomb County, Michigan
 April 18-1929
 J. P. Stanger
 DEPUTY AUDITOR GENERAL

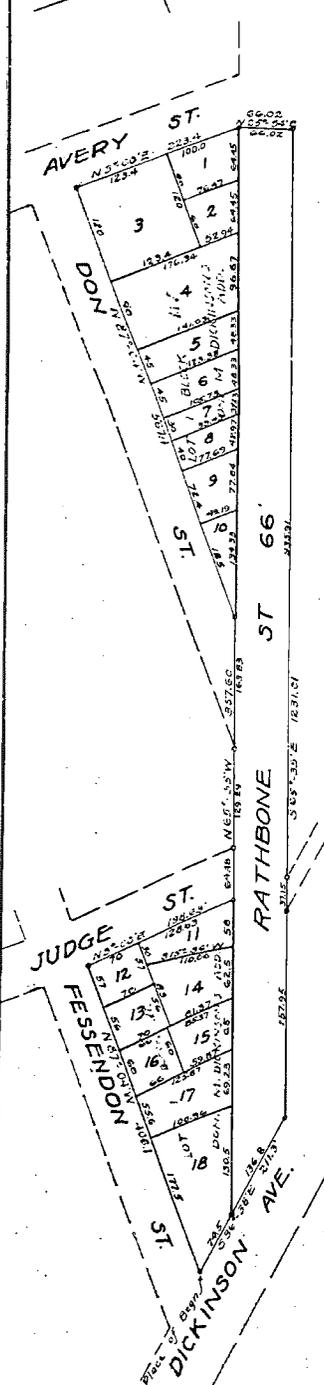

DEDICATION

KNOW ALL MEN BY THESE PRESENTS, That I Jos. H. Mills Assessor of the City of Mt Clemens Macomb County Michigan, by virtue of authority in me vested by section 3350, Compiled Laws of 1916, as amended, having been duly authorized by the City Commission, have caused the land described in the annexed plat to be surveyed, laid out and platted to be known as Assessors Plat No. 29 of the City of Mt Clemens Macomb County Michigan, and that the streets and alleys as shown on said plat are hereby dedicated to the use of the public.
 Witnesses:-
Jos. H. Mills
 Assessor of the City of Mt Clemens Macomb County Mich.

Subdivision of Lot 1 Blk 6 & Lot 1 Blk 4 Don M. Dickinson

ACKNOWLEDGMENT

STATE OF MICHIGAN }
 COUNTY OF MACOMB } SS
 On this 14th day of March, A.D. 1929, before me a Notary Public in and for said County, personally came the above named Jos. H. Mills Assessor of the City of Mt Clemens, known to be the person who executed the above dedication and acknowledged the same to be his free act and deed as such Assessor.
 My Commission Expires Apr 11, 1932
J. P. Stanger
 Notary Public in and For said County.

DESCRIPTION

The land embraced in the annexed plat of ASSESSORS PLAT NO. 29 of the City of Mt Clemens Macomb County Michigan, is described as follows:-
 Beginning at the intersection of the S'ly. line of Fessendon St. with the E'ly. line of Dickinson Ave. Thence S 89°28'E., 211.2 ft. Thence S 69°35'E., 1231.01 ft. Thence S 25°54'E., 454.02 ft. Thence E 89°04'E., 222.4 ft. Thence W 89°04'E., 577.4 ft. Thence E 69°35'W., 337.5 ft. Thence N 29°00'E., 194.23 ft. Thence N 87°04'W., 404.1 ft. to place of beginning. Being lot 1 Block 6 and lot 1 Block 14, of Don M. Dickinsons Add. to the City of Mt Clemens.

ENGINEERS CERTIFICATE

I hereby certify that the plat hereon delineated is a correct one and that permanent metal monuments not less than one inch in diameter and fifteen inches in length set in a concrete base at least four inches in diameter and forty-eight inches in depth have been placed at points marked thus on to show at all angles in the boundaries of the land platted, at all intersections of streets, intersections of streets and alleys, and at the intersections of streets and alleys with the boundaries of the plat as shown on said plat.
Wm. W. Homan
 Registered Civil Engineer

CERTIFICATE OF MUNICIPAL APPROVAL

This plat was approved by the City Commission of the City of Mt Clemens Macomb County Mich. at a meeting held March 12, 1929
J. P. Stanger City Clerk

CERTIFICATE OF APPROVAL BY THE COUNTY BOARD

This plat was approved on the 19th day of March, 1929
Charles H. Hammick Judge of Probate
James A. Hartung County Clerk
William W. Homan County Treasurer

SUPERVISORS PLAT No 2

PART OF TCS 173 & 164 T2N.R. 13 & 14 E.

HARRISON TWP


MACOMB CO, MICH.

SCALE 1"=200'

WALTER J. LENNER REG. CE.
MT. CLEMENS, MICH.

May 10-1932
J. P. Daulton

L. 16
P. 8

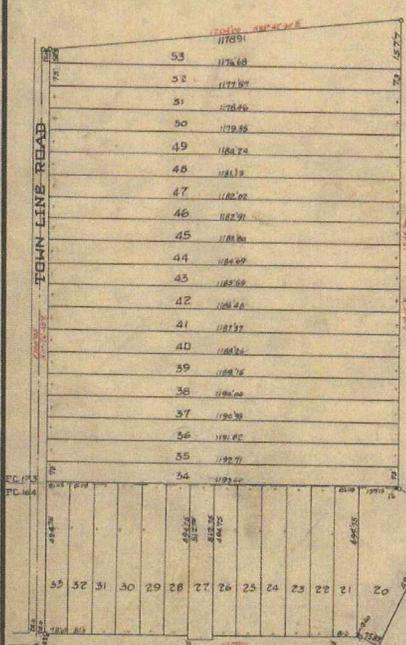

WITNESSES:
George H. ...
W. C. ...

STATE OF MICHIGAN)
COUNTY OF MACOMB)

On this 2nd day of May A.D. 1932 before me a Notary Public in and for said County personally came the above named George H. ... Supervisor of Harrison Twp. ...

Notary Public in and for said Co.
My commission expires March 1933

DESCRIPTION:
The land embraced in the annexed plat of SUPERVISORS PLAT No 2, part of P.M. 173 & 164 T. 2 N. R. 13 & 14 E., Harrison Twp., Macomb County, Mich., is described as follows:

TOWNSHIP BOARD APPROVAL:
This plat was approved by the Township Board of the Township of Harrison at a meeting held March 2, 1932

SURVEYOR'S CERTIFICATE:
I hereby certify that the plat herein delineated is a correct one and that permanent monuments (shown) of not less than one inch in diameter and fifteen inches in length set in concrete base at least four inches in diameter and forty eight inches in depth have been placed at points marked (shown) as therein shown at all angles in the boundaries of the land platted, at all the intersections of streets, and at the intersections of streets with the boundaries of the plat as shown on said plat.

This plat was approved by the Township Board for Harrison
at a meeting held May 4, 1932
Chas. N. Hummel
Walter J. Lenner

See ROW of 359 P. 755
See ROW of 3516 P. 108
See ROW of 3633 P. 288
See ROW of 3669 P. 134
See ROW of 3669 P. 126
See Canal of 3723 P. 74
See Canal of 3764 P. 109

RECORDED IN OFFICE OF
COUNTY CLERK
MAY 11 1932
225 - School, Mt. Clemens
in Lib. 16 - 11/1/32
Page 1



JEFFERSON AVE.

OCT 5 1955

36809

"GRUNER SUBDIVISION"
 A REPLAT OF LOTS 1046, 1047 AND 1048 OF
 "LIVERPOOL SUB" AND PART OF P.C.'S 542 & 173, T.2N., R.13E.
 CLINTON TWP., MACOMB CO., MICHIGAN.

WALTER J. LEHNER & SONS
 REG. CIVIL ENGINEERS & SURVEYORS
 MT. CLEMENS, MICHIGAN.

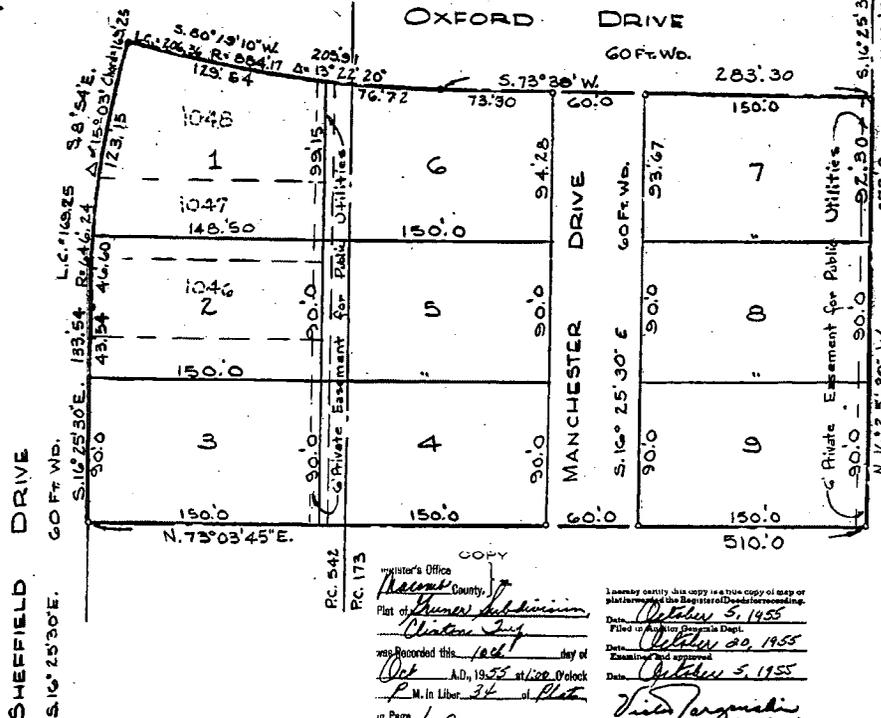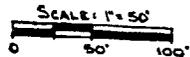

Intersection of Crocker Blvd. and Westerly line of P.C. 173.

Notary's Office
 Macomb County, Michigan
 Plat of Gruner Subdivision
 Clinton Twp.
 Recorded this 10th day of Oct A.D. 1955 at 10:00 o'clock
 P.M. in Liber 34 of Plat
 in Page 1
 I hereby certify this copy is a true copy of map or plat recorded in the Register of Deeds in Macomb County, Michigan.
 Filed in Register of Deeds
 Date October 20, 1955
 Examined and approved
 Date October 5, 1955
 Notary Public
 Walter J. Lehner & Sons

DEDICATION

KNOW ALL MEN BY THESE PRESENTS, That we, First National Bank in Mount Clemens, a Federal Banking Corporation by Charles R. Walters, President, and Allan J. Frasher, Assistant Cashier, as mortgagee, and Paul M. Gruner and Margaret Gruner, his wife, as proprietors, have caused the land embraced in the annexed plat to be surveyed, laid out and platted to be known as "Gruner Subdivision", a Replat of Lots 1046, 1047, and 1048 of "Liverpool Sub." and Part of P.C.'s 542 & 173, T. 2 N., R. 13 E., Clinton Twp., Macomb Co., Michigan, and that the streets as shown on said plat are hereby dedicated to the use of the Public Utilities, or for the use of specific utilities as thereon noted, subject to the regulation and control of the use thereof by the local governmental authorities, and that no permanent structures are to be erected within the lines of said easements.

Signed and Sealed in Presence of:

Paul M. Gruner (L.S.)
Margaret Gruner (L.S.)
 FIRST NATIONAL BANK IN MOUNT CLEMENS
Charles R. Walters, President
Allan J. Frasher, Assistant Cashier

STATE OF MICHIGAN) SS.
 COUNTY OF MACOMB)

On this 19th day of January, 1955, before me, a Notary Public in and for said county, personally came the above named Paul M. Gruner, his wife, and known to me to be the persons who executed the above dedication, and acknowledged the same to be their free act and deed.

My Commission expires: August 5, 1955
Edw. L. Carl
 Notary Public, Macomb County, Michigan

I hereby certify that the plat hereon delineated is a correct one and that permanent metal monuments consisting of bars not less than one-half inch in diameter and 36 inches in length, encased in a concrete cylinder at least 4 inches in diameter and 36 inches in depth have been placed at points marked thus (O) as thereon shown at all angles in the boundaries of the land platted, at all the intersections of the lines of streets, and at the intersections of the lines of streets with the boundaries of the plat as shown on said plat.

John D. Lehner
 Registered Land Surveyor
 No. 5787

CERTIFICATE OF APPROVAL BY COUNTY BOARD
 This plat was approved on the 27th day of Sept., 1955, by the Macomb County Plat Board.
Aaron Burr - Register of Deeds
Lyda Whalen - County Treasurer
Albert A. Wagner - County Clerk
Frank E. Lohr - Drain Commissioner

CERTIFICATE OF APPROVAL BY BOARD OF COUNTY ROAD COMMISSIONERS
 This plat has been examined and was approved on the 20th day of Sept., 1955, by the Macomb County Board of Road Commissioners.
Ernest W. McCollom - Member
Roy Jenner - Chairman
Wm. E. Malow - Member

CERTIFICATE OF MUNICIPAL APPROVAL
 This plat was approved by the Township Board of the Township of Clinton at a meeting held January 27th, 1955.
Elmore E. Lester - Clerk

DESCRIPTION OF LAND PLATTED
 The land embraced in the annexed plat of "Gruner Subdivision", a Replat of Lots 1046, 1047, and 1048 of "Liverpool Sub." and Part of P.C.'s 542 & 173, T. 2 N., R. 13 E., Clinton Twp., Macomb Co., Michigan, is described as follows: Commencing at the intersection of Crocker Boulevard and Westerly line of P.C. 173 and thence extending S. 54°-30'-30"E. 566.0 feet along the centerline of Crocker Boulevard, and thence S. 16°-25'-30"E. 1169.77 feet to the point of beginning of this description, and thence extending S. 73°-38'W. 283.30 feet, thence along a curve (R = 884.17 feet) concave to the North whose long chord bears S. 80°-19'-10"W. and is 205.91 feet in length; thence along a curve (R = 646.24 feet) concave to the East whose long chord bears S. 8°-54'E. and is 169.25 feet in length, thence S. 16°-25'-30"E. 133.54 feet, thence N. 73°-03'-45"E. 510.00 feet, thence N. 16°-25'-30"W. 272.30 feet to the point of beginning. This plat includes Lots 1 through 9, inclusive.

THIS IS TO CERTIFY THAT ACCORDING TO THE COUNTY TREASURER'S RECORDS THERE ARE NO TAX LIENS OR OTHER LIENS AND THAT TAXES ARE PAID FOR FIVE YEARS PREVIOUS TO DATE OF THIS INSTRUMENT
 AS WITNESSED BY ME, Notary Public, on this 27th day of January, 1955.
 THIS INSTRUMENT DOES NOT APPLY TO TAXES, IF ANY, NOW OR HEREIN DUE OR TO BE COLLECTED BY TOWNSHIP, CITY, VILLAGE OR LOCAL OFFICERS.
 Lynn Whalen, Macomb County Treasurer
 Wm. E. Malow, Macomb County Clerk
 Roy Jenner, Macomb County Chairman
 Charles R. Walters, President
 Allan J. Frasher, Assistant Cashier
 Paul M. Gruner, Margaret Gruner
 Edw. L. Carl, Notary Public
 State of Michigan, County of Macomb

STATE OF MICHIGAN) SS.
 COUNTY OF MACOMB)
 On this first day of October, 1955, before me, a Notary Public in and for said county appeared Charles R. Walters and Allan J. Frasher to me personally known, who being each by me duly sworn did say that they are the president and Assistant Cashier respectively of the First National Bank in Mount Clemens, a Federal Banking Corporation, and that the seal affixed to said instrument is the corporate seal of said corporation and that said instrument was signed and sealed in behalf of said corporation by authority of its Board of Directors and the said Charles R. Walters and Allan J. Frasher acknowledged said instrument to be the free act and deed of said corporation.
 My Commission expires: April 19, 1959
Linn Ann Peleski
 Notary Public, Macomb County, Michigan

FEB 2 1956

"ASBURY PARK SUBDN NO. 2"
OF PART OF P.C. 542 & PART OF P.C. 173 T. 2 N. R. 13 E.
CLINTON TWP MACOMB CO. MICH.

SHEET 1 OF 2 37502

NOTE: ALL DIMENSIONS ARE IN FEET AND DECIMALS THEREOF.

HARRY J. FULLER
REG. LAND SURVEYOR
MT. CLEMENS MICH.

DEDICATION

KNOW ALL MEN BY THESE PRESENTS, that we Otto Sherbeck and Emily Sherbeck his wife, and Marion Haley, Individually and as Executrix of the Estate of Grace M. Spranger, deceased, and the Capital Land Company, a Michigan Corporation by Raymond J. Dierickx, President and Frederick L. Smith, Secretary-Treasurer as proprietors have caused the land embraced in the annexed plat to be surveyed, laid out and platted, to be known as "ASBURY PARK SUBDN NO. 2", part of P.C. 542 and P.C. 173 T. 2 N.R. 13 E. Clinton Township, Macomb County, Michigan and that the streets as shown on said plat are hereby dedicated to the use of the public and that the easements as shown on said plat are hereby reserved for the use of public utilities and no permanent structures are to be erected within the lines of said easements. Regulation of the use thereof is vested in the local governmental authority.

Signed and Sealed in the presence of:
Leona B. Landis
Maurice A. Gernay
Maurice A. Gernay

Otto Sherbeck
Otto Sherbeck
Emily Sherbeck
Emily Sherbeck
Marion Haley
Marion Haley, individually and as Executrix of the Estate of Grace M. Spranger deceased

CAPITAL LAND CO.
Raymond J. Dierickx
Raymond J. Dierickx, Pres.
Frederick L. Smith
Frederick L. Smith, Sec.-Treas.

ACKNOWLEDGEMENT

STATE OF MICHIGAN) ss.
County of Macomb)
On this 9th day of December A.D. 1955 before me as a Notary Public in and for said County appeared Otto Sherbeck and Emily Sherbeck his wife, and Marion Haley, individually and as Executrix of the Estate of Grace M. Spranger deceased, known to me to be the persons who executed the above dedication and acknowledged the same to be their free act and deed.
Maurice A. Gernay
Maurice A. Gernay
Notary Public, Macomb Co., Michigan
My Commission expires 7-16-56.

STATE OF MICHIGAN) ss.
County of Macomb)
On this 16th day of December A.D. 1955 before me as a Notary Public in and for said County appeared Raymond J. Dierickx and Frederick L. Smith, to be personally known, who being each by me duly sworn, did say that they are the President and Secretary-Treasurer respectively of the Capital Land Co., a Michigan Corporation, and that the seal affixed to said instrument is the corporate seal of said corporation, and that said instrument was signed and sealed in behalf of said corporation by authority of its Board of Directors and the said Raymond J. Dierickx and Frederick L. Smith acknowledged said instrument to be the free act and deed of said corporation.
Maurice A. Gernay
Maurice A. Gernay
Notary Public, Macomb Co., Michigan
My commission expires 7-16-56.

DESCRIPTION OF LAND PLATED

The land embraced in the annexed plat of "ASBURY PARK SUBDN NO. 2" of part of P.C. 542 and part of P.C. 173 T. 2 N.R. 13 E. Clinton Township, Macomb Co., Mich., is described as follows:

Commencing at the intersection of the centerline of Crocker Blvd., and the East line of P.C. 542, thence S 19° 22' E 252.8 feet, along the East line of P.C. 542, thence S 73° 04' 30" W 212.2 feet, thence S 16° 25' 30" E 323.78 feet, thence S 16° 08' E 76.45 feet, to the point of beginning, thence N 73° 04' 30" E 882.10 feet, thence S 24° 22' E 1017.42 feet, thence N 70° 17' E 15 feet, thence S 24° 24' E 614.45 feet, S 16° 28' E 298.85 feet, thence S 71° 09' W 161.06 feet, thence N 23° 12' E 139.45 feet, thence N 66° 51' W 1151.10 feet, thence N 15° 15' W 23.35 feet, thence S 72° 50' W 89.9 feet, thence N 17° 02' W 280.97 feet, thence N 0° 15' W 274.24 feet, thence N 33° 27' W 252.42 feet, thence N 26° 35' W 309.85 feet, to the point of beginning.

SURVEYOR'S CERTIFICATE

I hereby certify that the plat heron delineated is a correct one, and that permanent monuments consisting of iron rods at least one half inch in diameter and 36 inches in length, encased in concrete cylinders four inches in diameter and 36 inches in length, have been set at points marked thus (o) as thereon shown at all angles in the boundaries of the land platted, at all intersections of streets and at intersections of streets with the boundaries of the plat.

Harry J. Fuller
HARRY J. FULLER, Registered Land Surveyor

MUNICIPAL APPROVAL

This plat was approved by the Township Board of the Township of Clinton at a meeting held August 31, 1955.
Edward Paulsen
Edward Paulsen (Clerk)

APPROVAL BY COUNTY PLAT BOARD

This plat was approved on the 23rd day of Feb., 1956 by the Macomb County Plat Board.
Aaron Burr (County Register of Deeds)
Albert A. Wagner (County Clerk)
Frank Lohr (County Drain Commissioner)

CERTIFICATE OF APPROVAL BY BOARD OF COUNTY ROAD COMMISSIONERS

Plat has been examined and approved on this 21st day of February 1956 by the Board of County Road Commissioners of Macomb County.
Ernest W. McClellan Chairman
Ray Corneer Vice-Chairman
Lawrence DeWolfe Member

THIS IS TO CERTIFY THAT ACCORDING TO THE COUNTY TREASURER'S RECORDS THERE ARE NO LIENS ON THIS PROPERTY AND THAT TAXES ARE PAID FOR FIVE YEARS PREVIOUS TO DATE OF THIS INSTRUMENT.
CLERKED AS TO TAXES Richard NO. 2731 DATE 2-27-56
THIS CERTIFICATE DOES NOT APPLY TO TAXES, IF ANY, NOW IN PROCESS OF COLLECTION BY TOWNSHIP, CITY OR VILLAGE COLLECTING OFFICERS.
LYNN WHITMAN, MACOMB COUNTY TREASURER. WIT: Richard

COPY
Recorder's Office
Macomb County
Plat of Asbury Park Subdn
of Clinton Township
was recorded this 28th day of February A.D. 1956 at 2:30 o'clock
A.M. in Liber. 25 of Plats
on Page 24 of 25
Aaron Burr
Register of Deeds

I hereby certify this copy is a true copy of map or plat recorded in the Register of Deeds Office.
Date February 27, 1956
Filed in Auditor General's Dept.
Date March 13, 1956
Examined and approved
Date February 27, 1956
V. J. Jorgensen
Auditor General
Richard
Plat Register

37502


"ASBURY PARK SUBD'N. NO.2"
OF PART OF P.C. 542 & PART OF P.C. 173 T. 2N. R. 13 E.
CLINTON TWP. MACOMB CO. MICH.

SHEET 2 OF 2

SCALE: 1" = 100'

NOTE: ALL DIMENSIONS ARE IN FEET AND DECIMALS THEREOF.

HARRY J. FULLER
REG. LAND SURVEYOR
MT. CLEMENS MICH.

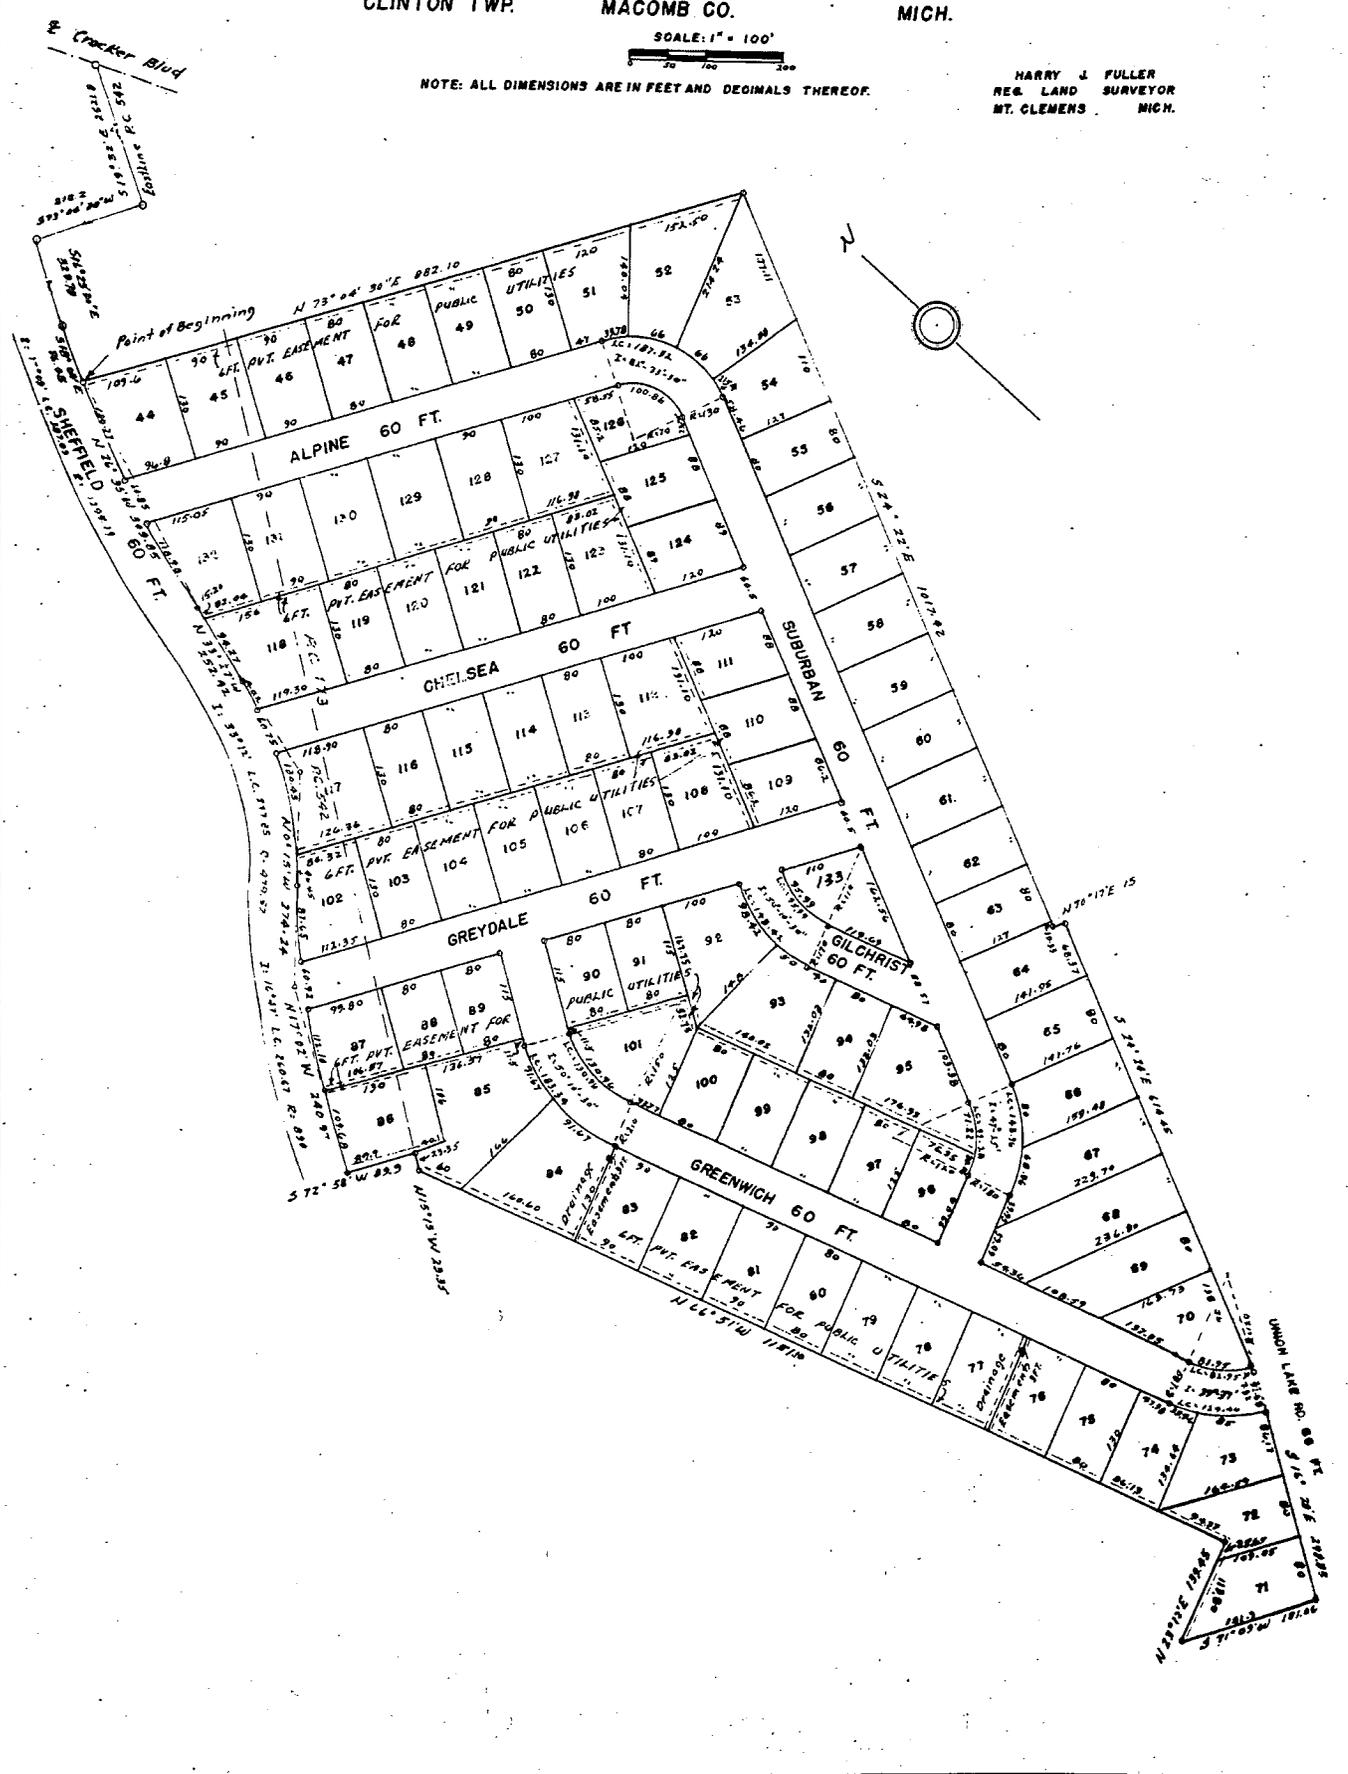

ORIGINAL

TAUBITZ MANOR SUB'N.

OF PART OF FRACTIONAL SECTION 25 & PRIVATE CLAIMS 164 & 173, T. 2 N., E. 13 E., CLINTON TOWNSHIP, MACOMB COUNTY, MICHIGAN

EXAMINED AND APPROVED

Date October 6, 1959

Frank S. Soyarski
SURVEYOR GENERAL



Note: All dimensions shown are given in feet and decimals thereof. Curvilinear dimensions are given along the arc.


REGISTER'S OFFICE
COUNTY OF MACOMB

Received for Record
October 7, 1959

at 8:55 o'clock P.M., and recorded
in Vol. 45 of Plats, on
Page 39
Aaron Burr
Register of Deeds

444155

SUPERVISORS PLAT NO 7
L. 18 - P. 49
6.89° 59' 05" E 1073.65'

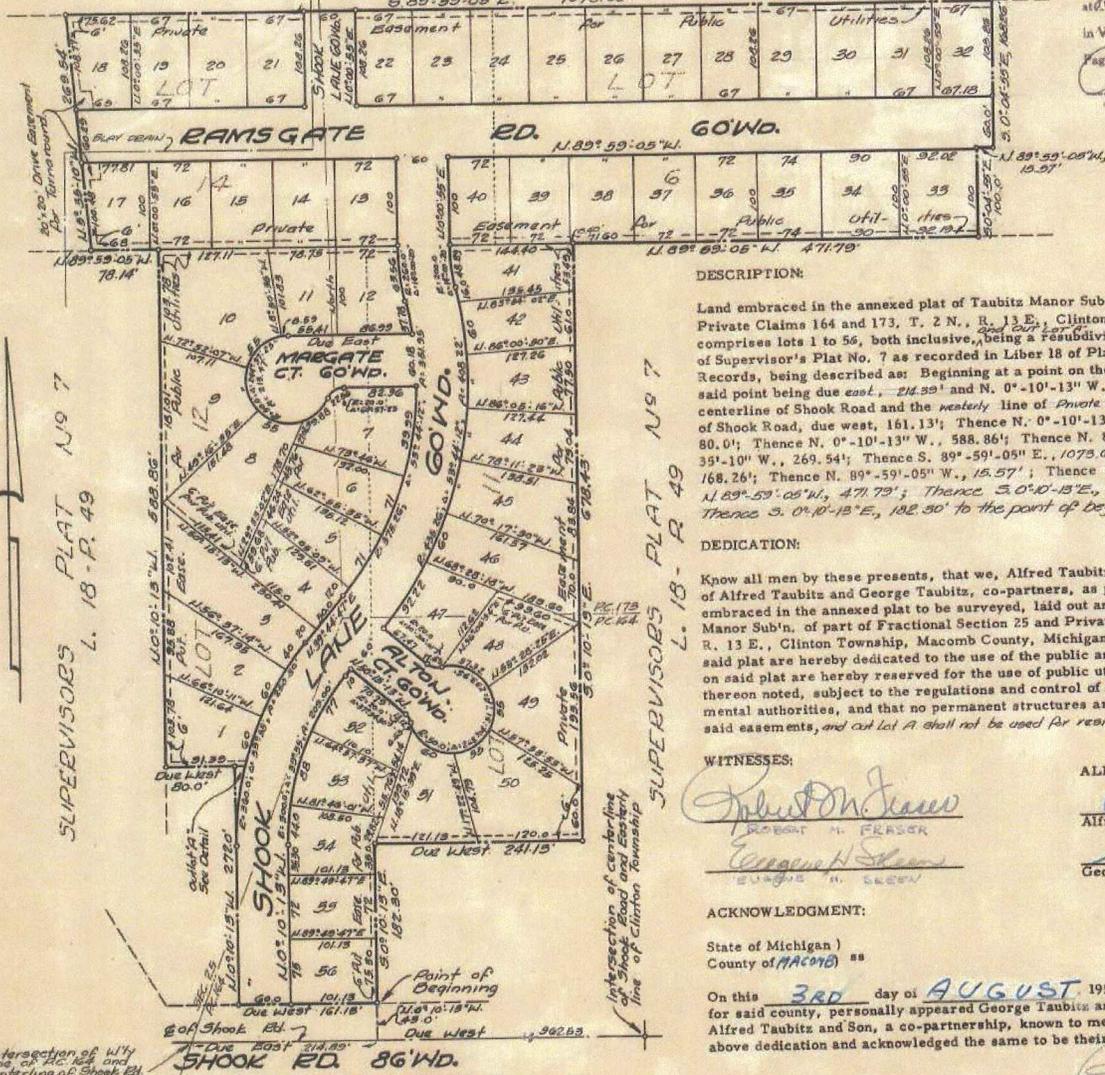

DESCRIPTION:
Land embraced in the annexed plat of Taubitz Manor Sub'n. of part of Fractional Section 25 and Private Claims 164 and 173, T. 2 N., R. 13 E., Clinton Township, Macomb County, Michigan, comprises lots 1 to 56, both inclusive, being a subdivision of parts of lots 6, 11, 12 and 14 of Supervisor's Plat No. 7 as recorded in Liber 18 of Plats, on Page 49, Macomb County Records, being described as: Beginning at a point on the north line of Shook Road (86 feet wide), said point being due east, 214.39' and N. 0°-10'-13" W., 43.0' from the intersection of the centerline of Shook Road and the westerly line of Private Claim 164; Thence along the north line of Shook Road, due west, 161.13'; Thence N. 0°-10'-13" W., 272.0'; Thence due west, 80.0'; Thence N. 0°-10'-13" W., 588.86'; Thence N. 89°-59'-05" W., 78.14'; Thence N. 5°-35'-10" W., 269.54'; Thence S. 89°-59'-05" E., 1073.05'; Thence S. 0°-04'-55" E., 168.26'; Thence N. 89°-59'-05" W., 15.57'; Thence S. 0°-05'-55" E., 100.0'; Thence N. 89°-59'-05" W., 471.79'; Thence S. 0°-10'-13" E., 678.45'; Thence due west, 241.13'; Thence S. 0°-10'-13" E., 192.30' to the point of beginning.

DEDICATION:
Know all men by these presents, that we, Alfred Taubitz and Son, a co-partnership consisting of Alfred Taubitz and George Taubitz, co-partners, as proprietors, have caused the land embraced in the annexed plat to be surveyed, laid out and platted, to be known as "Taubitz Manor Sub'n. of part of Fractional Section 25 and Private Claims 164 and 173, T. 2 N., R. 13 E., Clinton Township, Macomb County, Michigan" and that the streets as shown on said plat are hereby dedicated to the use of the public and that the private easements indicated on said plat are hereby reserved for the use of the public and for the specific use as thereon noted, subject to the regulations and control of the use thereof by the local governmental authorities, and that no permanent structures are to be erected within the lines of said easements, and that Lot A shall not be used for residential purposes.

WITNESSES:
Robert M. Parker
ROBERT M. PARKER
Notary Public
Eugene H. Siewer
EUGENE H. SIEWER

ALFRED TAUBITZ AND SON
Alfred Taubitz
Alfred Taubitz, Co-Partner
George Taubitz
George Taubitz, Co-Partner

ACKNOWLEDGMENT:
State of Michigan)
County of MACOMB) ss
On this 3RD day of AUGUST, 1959, before me, a Notary Public in and for said county, personally appeared George Taubitz and Alfred Taubitz, co-partners of Alfred Taubitz and Son, a co-partnership, known to me to be the persons who executed the above dedication and acknowledged the same to be their free act and deed.

Robert M. Parker
ROBERT M. PARKER
Notary Public
My commission expires: 8-18-59

APPROVAL BY COUNTY PLAT BOARD:
This plat was approved on the 2nd day of Oct., 1959, by the Macomb County Plat Board.
Aaron Burr
Aaron Burr, Register of Deeds
Albert A. Wagner
Albert A. Wagner, County Clerk
Lynn Whalen
Lynn Whalen, County Treasurer
Frank E. Lohr
Frank E. Lohr, Drain Commissioner

SURVEYOR'S CERTIFICATE:
I hereby certify that the plat hereon delineated is a correct one, and that permanent monuments consisting of iron rods at least one-half inch in diameter and not less than 36 inches in length, encased in concrete cylinders four inches in diameter and not less than 36 inches in length have been set at points marked (o) as thereon shown at all angles in the boundaries of the land platted, at all intersections of the lines of streets and at intersections of the lines of streets with the boundaries of the plat.

Richard C. Postiff
Richard C. Postiff
Registered Land Surveyor

APPROVAL BY BOARD OF COUNTY ROAD COMMISSIONERS:
This plat has been examined and was approved on this 30th day of September, 1959, by the Macomb County Board of Road Commissioners.

Lawrence Debnick
Lawrence Debnick, Chairman
Keith Bovenchen
Keith Bovenchen, Vice-Chairman
Ernest W. McCollom
Ernest W. McCollom, Member

MUNICIPAL APPROVAL:
This plat was approved by the Township Board of the Township of Clinton at a meeting held Sept. 9, 1959.
Edward J. Faulmann
Edward J. Faulmann, Clerk

THIS IS TO CERTIFY THAT ACCORDING TO THE COUNTY TREASURER'S RECORDS THERE ARE NO TAX LIENS ON THIS PROPERTY AND THAT TAXES ARE PAID FOR THE YEARS PREVIOUS TO DATE OF THIS INSTRUMENT EXCEPT 19...
Lynn Whalen
Lynn Whalen, MACOMB COUNTY TREASURER
PER: Richard C. Postiff
REGISTERED LAND SURVEYOR
NOT INCLUDE CURRENT TAXES NOW BEING COLLECTED

Vertical text on the left margin: SUPERVISORS PLAT NO 7 L. 18 - P. 49, SHOOK RD. 86' W.D., LANE, SHOOK LANE, DETAIL OF OUTLOT A Scale 1" = 20', SHOOK RD. 86' W.D., INTERSECTION OF W/4 LINE OF AC 24' AND CENTERLINE OF SHOOK RD.

L45 P39

JEFFERSON VILLA SUB. NO. 2


PART OF FRACTIONAL SEC. 25, T. 2 N., R. 13 E. HARRISON TWP., MACOMB CO., MICH.

SCALE: 1" = 100' ALL DIMENSIONS ARE IN FEET AND DECIMALS THEREOF. ALL DIMENSIONS ON CURVES ARE MEASURED ON THE ARC.

ALL EASEMENTS ARE PRIVATE EASEMENTS FOR PUBLIC UTILITIES AND MAINTENANCE OF SURFACE DRAINAGE.

SPALDING, BEBECKER & ASSOCIATES, INC. ENGINEERS 1405 S. WOODWARD AVE. BIRMINGHAM, MICHIGAN

M.S.H.D. R.R.W. INTERSTATE 94 LIMITED ACCESS HIGHWAY NO DIRECT INGRESS OR EGRESS WILL BE PERMITTED

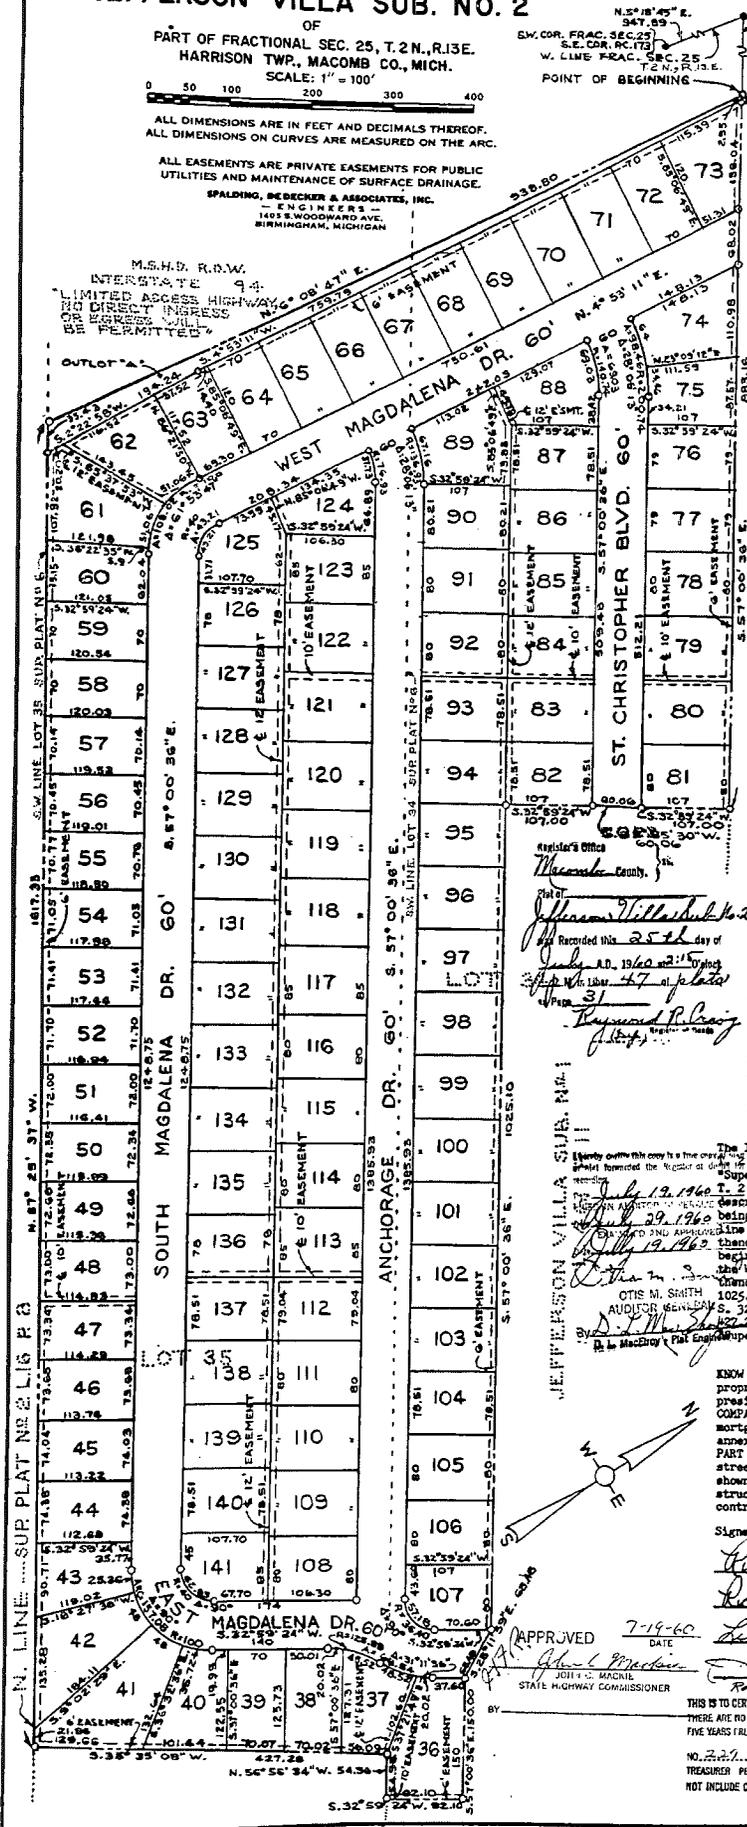

I hereby certify that the plat hereon delineated is a correct one and that permanent metal monuments consisting of bars not less than one-half inch in diameter and 36 inches in length enclosed in concrete cylinders at least 4 inches in diameter and 36 inches in depth have been placed at points marked (a) as thereon shown at all angles in the boundaries of the land platted, at all the intersections of lines of streets and at the intersections of lines of streets with the boundaries of the plat as shown on said plat.

V. B. Spalding, Registered Land Surveyor. CERTIFICATE OF MUNICIPAL APPROVAL. This plat was approved by the Township Board of the Township of Harrison at a meeting held May 23, 1962, and the width of lots is in compliance with the requirements of Section 30, Act 172 of 1929 as amended.

STATE OF MICHIGAN } COUNTY OF WAYNE } SS. On this 23 day of MAY, 1960 A. D., before me, a Notary Public in and for said County, appeared Sidney Forbes and William Semple to me personally known, who being each by me duly sworn did say that they are the President and Secretary respectively of the FORBES REALTY IMPROVEMENT CORPORATION, a Michigan corporation, and that said instrument was signed in behalf of said corporation by authority of its Board of Directors and the said Sidney Forbes and William Semple acknowledged said instrument to be the free act and deed of said corporation.

STATE OF MICHIGAN } COUNTY OF WAYNE } SS. On this 23 day of MAY, 1960 A. D., before me, a Notary Public in and for said County, appeared Sidney Forbes and Alvin Gale to me personally known, who being each by me duly sworn did say that they are the President and Secretary respectively of MAGNA LAND DEVELOPMENT COMPANY, INC., a Michigan corporation, and that said instrument was signed in behalf of said corporation by authority of its Board of Directors and the said Sidney Forbes and Alvin Gale acknowledged said instrument to be the free act and deed of said corporation.

STATE OF MICHIGAN } COUNTY OF MACOMB } SS. On this 26 day of MAY, 1960 A. D., before me, a Notary Public in and for said County, personally came the above named W. J. C. KAUFMANN and MABEL G. KAUFMANN and BEATRICE M. GOLDEN, known to me to be the persons who executed the above dedication and acknowledged the same to be their free act and deed.

CERTIFICATE OF APPROVAL BY BOARD OF COUNTY ROAD COMMISSIONERS. This plat has been examined and approved on the 12th day of July, 1962 by the Board of County Road Commissioners of Macomb County.

CERTIFICATE AS TO STATE TRUNK LINE OR FEDERAL AID ROADS. We hereby certify that said plat appears to include land located on a state trunk line or federal aid road.


COUNTY PLAT BOARD APPROVAL. This plat was approved on the 14th day of July, 1962 by the Macomb County Plat Board.

DESCRIPTION. The land embraced in the annexed plat of 'JEFFERSON VILLA SUB. NO. 2 OF PART OF FRACTIONAL SEC. 25, T. 2 N., R. 13 E., HARRISON TWP., MACOMB CO., MICH.' being a replat of part of Lot 34 and 35 of 'Supervisor's Plat No. 6' (L. 16, P. 35) of parts of fractional sections 25 and 30 and P.C. 172, 173, 174, 999, 1000.

KNOW ALL MEN BY THESE PRESENTS, that we, W. J. C. KAUFMANN and MABEL G. KAUFMANN his wife, as proprietors and FORBES REALTY IMPROVEMENT CORPORATION, a Michigan corporation, by Sidney Forbes president, and William Semple secretary, as proprietor - vendee and MAGNA LAND DEVELOPMENT COMPANY, INC., a Michigan corporation, by Sidney Forbes president, and Alvin Gale secretary, as mortgagee - vendee and BEATRICE M. GOLDEN as mortgagee have caused the land embraced in the annexed plat to be surveyed, laid out and platted to be known as 'JEFFERSON VILLA SUB. NO. 2 OF PART OF FRACTIONAL SEC. 25, T. 2 N., R. 13 E., HARRISON TWP., MACOMB CO., MICH.' and that the streets as shown on said plat are hereby dedicated to the use of the public and the easements as shown on said plat are hereby reserved for the purposes indicated thereon and that no permanent structures are to be erected within the boundaries of said easements. The regulation and control of said easements shall be vested in the local government's authorities.

Signed in the presence of: Richard A. Ward, Richard A. Ward, Richard A. Ward. W. J. C. KAUFMANN, MABEL G. KAUFMANN, BEATRICE M. GOLDEN. FORBES REALTY IMPROVEMENT CORPORATION, Sidney Forbes, President. MAGNA LAND DEVELOPMENT COMPANY, INC., Alvin Gale, Secretary.

APPROVED 7-19-60 DATE. JOHN C. MACON, STATE HIGHWAY COMMISSIONER. THIS IS TO CERTIFY THAT ACCORDING TO THE COUNTY TREASURER'S RECORDS THERE ARE NO TAX LIENS ON THIS PROPERTY AND THAT TAXES ARE PAID FOR FIVE YEARS PREVIOUS TO DATE OF THIS INSTRUMENT EXCEPT 19.....

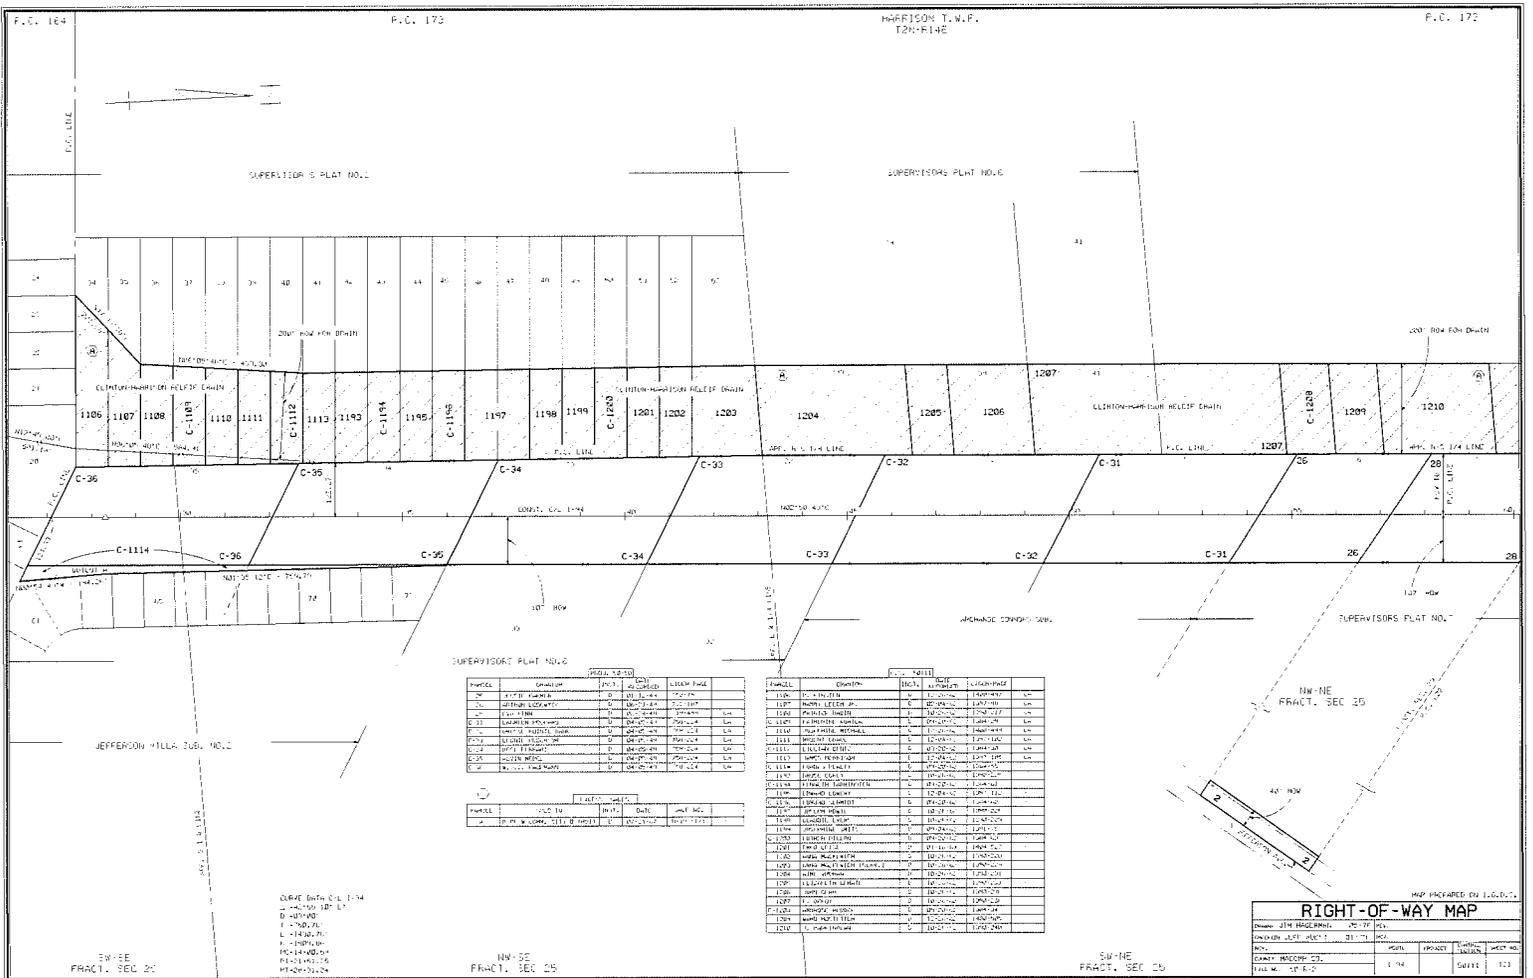

Parcel	Owner	Area	Acres	Block
1106	SUPERVISOR'S PLAT NO. 2	0.0000	0.0000	1106
1107	SUPERVISOR'S PLAT NO. 2	0.0000	0.0000	1107
1108	SUPERVISOR'S PLAT NO. 2	0.0000	0.0000	1108
1109	SUPERVISOR'S PLAT NO. 2	0.0000	0.0000	1109
1110	SUPERVISOR'S PLAT NO. 2	0.0000	0.0000	1110
1111	SUPERVISOR'S PLAT NO. 2	0.0000	0.0000	1111
1112	SUPERVISOR'S PLAT NO. 2	0.0000	0.0000	1112
1113	SUPERVISOR'S PLAT NO. 2	0.0000	0.0000	1113
1114	SUPERVISOR'S PLAT NO. 2	0.0000	0.0000	1114
1196	SUPERVISOR'S PLAT NO. 3	0.0000	0.0000	1196
1197	SUPERVISOR'S PLAT NO. 3	0.0000	0.0000	1197
1198	SUPERVISOR'S PLAT NO. 3	0.0000	0.0000	1198
1199	SUPERVISOR'S PLAT NO. 3	0.0000	0.0000	1199
1200	SUPERVISOR'S PLAT NO. 3	0.0000	0.0000	1200
1201	SUPERVISOR'S PLAT NO. 3	0.0000	0.0000	1201
1202	SUPERVISOR'S PLAT NO. 3	0.0000	0.0000	1202
1203	SUPERVISOR'S PLAT NO. 3	0.0000	0.0000	1203
1204	SUPERVISOR'S PLAT NO. 3	0.0000	0.0000	1204
1205	SUPERVISOR'S PLAT NO. 3	0.0000	0.0000	1205
1206	SUPERVISOR'S PLAT NO. 3	0.0000	0.0000	1206
1207	SUPERVISOR'S PLAT NO. 3	0.0000	0.0000	1207
1208	SUPERVISOR'S PLAT NO. 3	0.0000	0.0000	1208
1209	SUPERVISOR'S PLAT NO. 3	0.0000	0.0000	1209
1210	SUPERVISOR'S PLAT NO. 3	0.0000	0.0000	1210



Parcel	Owner	Area	Acres	Block
1106	SUPERVISOR'S PLAT NO. 2	0.0000	0.0000	1106
1107	SUPERVISOR'S PLAT NO. 2	0.0000	0.0000	1107
1108	SUPERVISOR'S PLAT NO. 2	0.0000	0.0000	1108
1207	SUPERVISOR'S PLAT NO. 3	0.0000	0.0000	1207
1208	SUPERVISOR'S PLAT NO. 3	0.0000	0.0000	1208
1209	SUPERVISOR'S PLAT NO. 3	0.0000	0.0000	1209
1210	SUPERVISOR'S PLAT NO. 3	0.0000	0.0000	1210

RIGHT-OF-WAY MAP					
Drawn	Checked	Project	Scale	Date	Sheet
J. G. B. S.	J. G. B. S.	1194	AS SHOWN	11/94	101

UNION LAKE MEADOWS

A PART OF PRIVATE CLAIM NO. 173, T-2-N, R-14-E
HARRISON TOWNSHIP, MACOMB COUNTY, MICHIGAN

LIBER PAGE
SHEET 2 OF 4 SHEETS

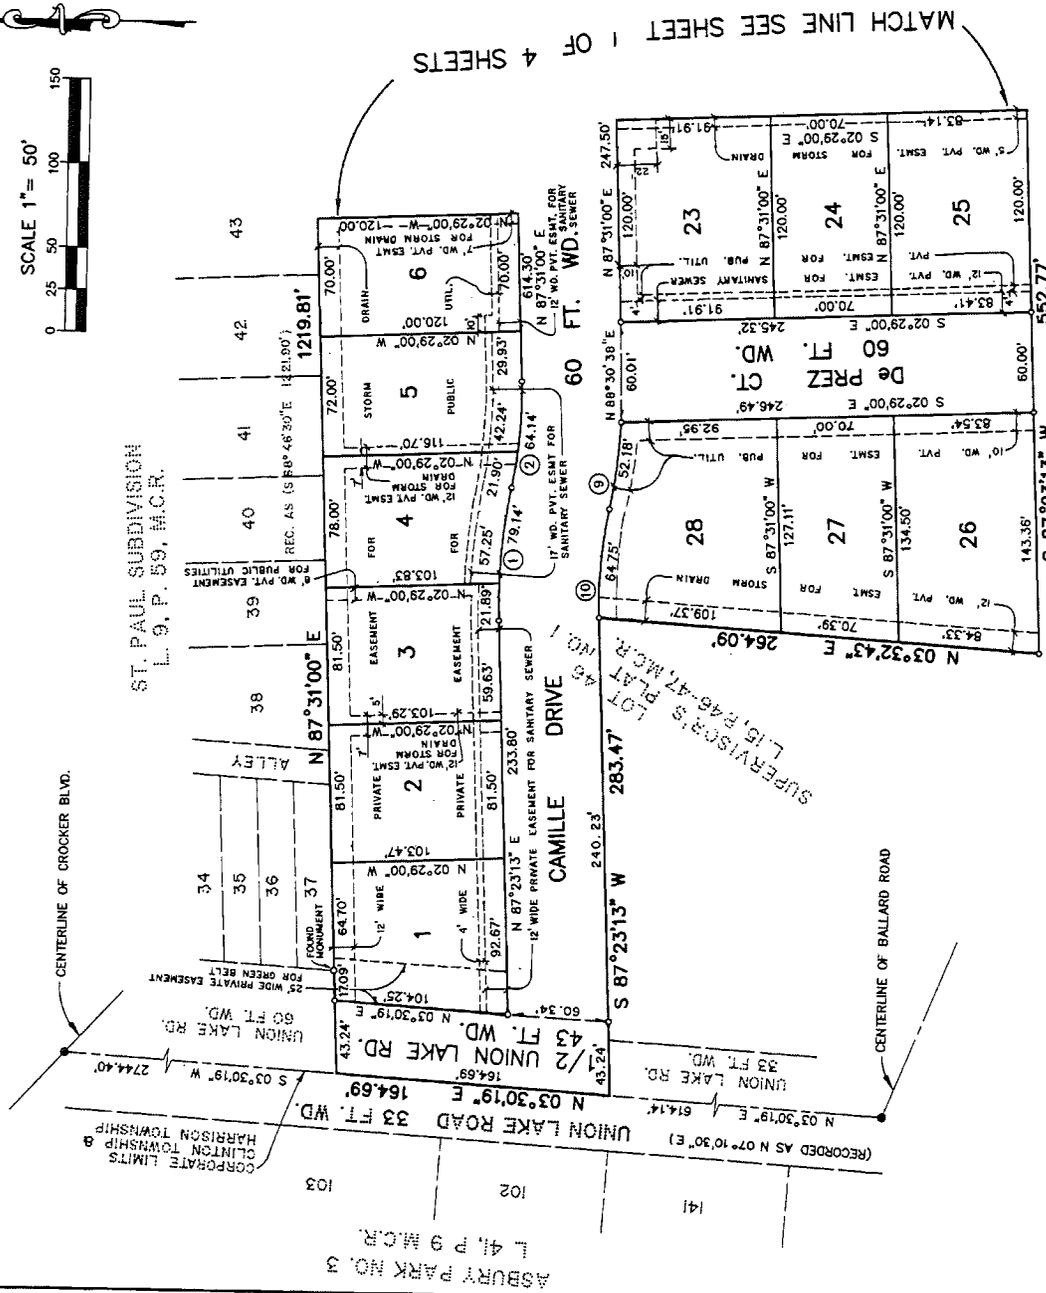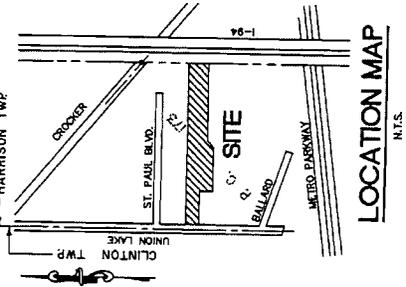


CURVE DATA

CURVE	ARC	RADIUS	CENTRAL ANGLE	CHORD	CHORD BEARINGS
1	79.14'	330.00'	13°44'27"	78.85'	S 85°44'34" E
2	64.14'	270.00'	15°35'40"	63.99'	S 85°40'40" E
3	52.18'	330.00'	09°03'35"	52.13'	S 87°24'07" E
4	64.75'	270.00'	13°44'27"	64.60'	N 85°44'34" W

LEGEND

1. ALL DIMENSIONS ARE GIVEN IN FEET. DISTANCES.
2. CURVILINEAR MEASUREMENTS ARE ARC DISTANCES.
3. CONCRETE MONUMENTS HAVE BEEN PLACED AT ALL POINTS MARKED "O". CONCRETE MONUMENTS ARE STEEL DIAMETER HALF (1/2) INCH IN LENGTH, EIGHT (8) INCHES IN DIAMETER AND THIRTY SIX (36) INCHES IN LENGTH.
4. STEEL BARS ONE-HALF (1/2) INCH IN DIAMETER AND EIGHTEEN (18) INCHES IN LENGTH.
5. LOT CORNERS HAVE BEEN MARKED WITH STEEL BARS ONE-HALF (1/2) INCH IN DIAMETER AND EIGHTEEN (18) INCHES IN LENGTH.
6. (N) INDICATES A RADIAL LINE.
7. (A) INDICATES AN ANGLE.
8. BEARINGS ARE BASED ON THE SOUTHERLY LINE OF ST. PAUL SUBDIVISION AS RECORDED IN L. 9 P. 59 OF PLATS MACOMB COUNTY RECORDS.

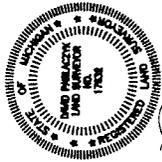

D. Wehler

Giffels-Webster Engineers, Inc.
ENGINEERS - SURVEYORS - PLANNERS
2871 BROAD STREET, ROCHESTER HILLS, MICHIGAN
(313) 682-5100

062286

UNION LAKE MEADOWS

A PART OF PRIVATE CLAIM NO. 173, T-2-N, R-14-E
HARRISON TOWNSHIP, MACOMB COUNTY, MICHIGAN

SURVEYOR'S CERTIFICATE:

I, DAVID PAWLACZYK, SURVEYOR, CERTIFY THAT I HAVE SURVEYED AND MARKED THE CORNERS OF THIS PLAT, DESCRIBED AS FOLLOWS: "UNION LAKE MEADOWS", A PART OF PRIVATE CLAIM NO. 173, T-2-N, R-14-E, HARRISON TOWNSHIP, MACOMB COUNTY, MICHIGAN, BEING A SUBDIVISION OF LOT 46 OF SUPERVISOR'S PLAT NO. 1 OF HARRISON TOWNSHIP AS RECORDED IN LIBER 15 OF PLATS, PAGES 46 AND 47, MACOMB COUNTY RECORDS, BEING MORE PARTICULARLY DESCRIBED AS: COMMENCING AT THE INTERSECTION OF THE CENTERLINE OF CROCKER BOULEVARD AND THE EAST LINE OF PRIVATE CLAIM NO. 173, SAID POINT BEING ALSO THE WESTERLY LINE OF INTEREST IN THE S. 87°23'13"W, 204.76 FEET; THENCE S. 42°01'43"W, 13.13 FEET TO THE POINT OF BEGINNING; THENCE S. 42°01'43"W, 264.09 FEET; THENCE S. 87°23'13"W, 204.76 FEET; THENCE N. 03°30'19"E, 164.69 FEET; THENCE S. 87°23'13"W, 283.47 FEET TO THE CENTERLINE OF UNION LAKE ROAD, SAID POINT BEING 33 FEET EAST OF THE EAST LINE OF PLAT 47, MACOMB COUNTY RECORDS; THENCE N. 03°30'19"E, 164.69 FEET ALONG SAID UNION LAKE ROAD TO THE CENTERLINE OF UNION LAKE ROAD TO THE SOUTHWEST CORNER OF PLAT 47, MACOMB COUNTY RECORDS; THENCE ALONG THE SOUTH LINE OF SAID SUBDIVISION N. 87°31'00"E, 1219.81 FEET TO THE POINT OF BEGINNING. THIS PLAT CONTAINS 9.30 ACRES AND IS COMPRISED OF 28 LOTS NUMBERED 1 THROUGH 28, INCLUSIVE.

THAT I HAVE MADE SUCH SURVEY, LAND DIVISION AND PLAT BY THE DIRECTION OF THE OWNERS OF SUCH LAND.
THAT SUCH PLAT IS A CORRECT REPRESENTATION OF ALL THE EXTERIOR BOUNDARIES OF THE LAND SURVEYED AND THE SUBDIVISION OF IT.
THAT THE REQUIRED MONUMENTS AND LOT MARKERS HAVE BEEN LOCATED IN THE GROUND OR THAT SURETY HAS BEEN DEPOSITED WITH THE MUNICIPALITY, AS REQUIRED BY SECTION 123 OF THE ACT.
THAT THE ACCURACY OF BE SURVEY IS WITHIN THE LIMITS REQUIRED BY SECTION 126 OF THE ACT.
THAT THE BEARINGS SHOWN ON THE PLAT ARE EXPRESSED AS REQUIRED BY SECTION 126(3) OF THE ACT AND EXPLAINED IN THE LEGEND.

GIFFELS-WEBSTER ENGINEERS, INC.
2871 BOND STREET
ROCHESTER HILLS, MI 48069-3315
DATE: July 13, 1994
D.D.P.
DAVID PAWLACZYK, R.L.S. #17632
VICE PRESIDENT



PROPRIETOR'S CERTIFICATE:

DEPREZ-PASCOR INVESTMENTS, INC. A CORPORATION DULY ORGANIZED AND EXISTING UNDER THE LAWS OF THE STATE OF MICHIGAN, BY RANDY DEPREZ, PRESIDENT, AS PROPRIETOR HAS CAUSED THE LAND TO BE SURVEYED, DIVIDED, MAPPED AND DEDICATED AS REPRESENTED ON THIS PLAT AND THAT THE PUBLIC UTILITY STREETS ARE FOR THE USE OF THE PUBLIC; THAT THE PUBLIC UTILITY EASEMENTS ARE PRIVATE EASEMENT AND THAT ALL OTHER EASEMENTS ARE FOR THE USES SHOWN ON THE PLAT; AND THAT LOTS 15 AND 16 SHALL NOT HAVE DIRECT VEHICULAR ACCESS TO INTERSTATE 94.

BY: *Randy Deprez*
RANDY DEPREZ, PRESIDENT
4687 SPRUCE DRIVE
SHELBY, MICHIGAN 48151

WITNESSES:
Michelle G. Giffels
John Giffels
Giffels-Webster Engineers, Inc.
2871 Bond Street
Rochester Hills, Michigan 48069-3315

ACKNOWLEDGEMENT:
STATE OF MICHIGAN)
COUNTY OF MACOMB) S.S.
PERSONALLY CAME BEFORE ME THIS 13 DAY OF July, 1994
RANDY DEPREZ, PRESIDENT OF THE ABOVE NAMED CORPORATION TO ME KNOWN TO ME AND TO ME KNOWN TO THE FOREGOING INSTRUMENT AND TO ME KNOWN TO THE FOREGOING INSTRUMENT, AS SUCH PRESIDENT THAT HE EXECUTED THE FOREGOING INSTRUMENT, AS REQUIRED BY SECTION 123 OF THE ACT AND DEED OF SAID CORPORATION.
NOTARY PUBLIC *Giffels-Webster Engineers, Inc.* MACOMB COUNTY, MICHIGAN
MY COMMISSION EXPIRES: December 31, 1994

PROPRIETOR'S CERTIFICATE:

HUNTINGTON BANKS OF MICHIGAN, DULY ORGANIZED AND EXISTING UNDER THE LAWS OF THE STATE OF MICHIGAN, BY LOUIS J. PETERS, SENIOR VICE PRESIDENT AND ROBERT P. JOHNSON, VICE PRESIDENT, HAS CAUSED THE LAND TO BE SURVEYED, DIVIDED, MAPPED AND DEDICATED AS REPRESENTED ON THIS PLAT AND THAT THE STREETS ARE FOR THE USE OF THE PUBLIC; THAT THE PUBLIC UTILITY EASEMENTS ARE PRIVATE EASEMENTS AND THAT ALL OTHER EASEMENTS ARE FOR THE USES SHOWN ON THE PLAT; AND THAT LOTS 15 AND 16 SHALL NOT HAVE DIRECT VEHICULAR ACCESS TO INTERSTATE 94.

BY: HUNTINGTON BANKS OF MICHIGAN
801 WEST BIG BEAVER ROAD
POST OFFICE BOX 3823
TROY, MICHIGAN 48067-5823

WITNESSES:
Michelle G. Giffels
John Giffels
Giffels-Webster Engineers, Inc.
2871 Bond Street
Rochester Hills, Michigan 48069-3315

ACKNOWLEDGEMENTS:
STATE OF MICHIGAN)
COUNTY OF MACOMB) S.S.
PERSONALLY CAME BEFORE ME THIS 13 DAY OF July, 1994
LOUIS J. PETERS, SENIOR VICE PRESIDENT AND ROBERT P. JOHNSON, VICE PRESIDENT OF THE ABOVE NAMED BANK, TO ME KNOWN TO BE THE PERSON WHO EXECUTED THE FOREGOING INSTRUMENT AND TO ME KNOWN TO BE SUCH SENIOR VICE PRESIDENT OF SAID BANK, AND ACKNOWLEDGED THAT HE EXECUTED THE FOREGOING INSTRUMENT, AS SUCH OFFICER AS THIS TRUE ACT AND DEED OF SAID BANK BY ITS AUTHORITY.
NOTARY PUBLIC *Giffels-Webster Engineers, Inc.* MACOMB COUNTY, MICHIGAN
MY COMMISSION EXPIRES: December 31, 1994

STATE OF MICHIGAN)
COUNTY OF MACOMB) S.S.
PERSONALLY CAME BEFORE ME THIS 13 DAY OF July, 1994
ROBERT P. JOHNSON, VICE PRESIDENT OF THE ABOVE NAMED BANK, TO ME KNOWN TO BE THE PERSON WHO EXECUTED THE FOREGOING INSTRUMENT AND TO ME KNOWN TO BE SUCH VICE PRESIDENT OF SAID BANK, AND ACKNOWLEDGED THAT HE EXECUTED THE FOREGOING INSTRUMENT AS SUCH OFFICER AS THIS TRUE ACT AND DEED OF SAID BANK BY ITS AUTHORITY.
NOTARY PUBLIC *Giffels-Webster Engineers, Inc.* MACOMB COUNTY, MICHIGAN
MY COMMISSION EXPIRES: December 31, 1994

Giffels-Webster Engineers, Inc.
ENGINEERS - SURVEYORS - PLANNERS
2871 BOND STREET ROCHESTER HILLS, MICHIGAN
(313) 852-3100

UNION LAKE MEADOWS

A PART OF PRIVATE CLAIM NO. 173, T-2-N, R-14-E
HARRISON TOWNSHIP, MACOMB COUNTY, MICHIGAN

COUNTY TREASURER'S CERTIFICATE:

THE RECORDS IN MY OFFICE SHOW NO UNPAID TAXES OR SPECIAL ASSESSMENTS FOR THE FIVE YEARS PRECEDING JULY 18, 1994 INVOLVING THE LANDS INCLUDED IN THIS PLAT.

Rose Barnett
MACOMB COUNTY TREASURER
ROSE BARNETT, DEPUTY

COUNTY ROAD COMMISSIONER CERTIFICATE:

APPROVED ON Aug. 2nd 1994 AS COMPLYING WITH SECTION 193 OF ACT 288, P.A. 1967, AND THE APPLICABLE PUBLISHED RULES AND REGULATIONS OF THE BOARD OF ROAD COMMISSIONERS OF MACOMB COUNTY.

John Peterson
JOHN PETERSON, CHAIRPERSON
Mark Peterson
MARK PETERSON, MEMBER
Thomas S. Welsh
THOMAS S. WELSH, COMMISSIONER

COUNTY PLAT BOARD CERTIFICATE:

THIS PLAT HAS BEEN REVIEWED AND IS APPROVED BY THE MACOMB COUNTY PLAT BOARD ON August 19, 1994 AS BEING IN COMPLIANCE WITH ALL OF THE PROVISIONS OF ACT 288, P.A. 1967, AND THE PLAT BOARD'S APPLICABLE RULES AND REGULATIONS.

Mark A. Stepien
MARK A. STEPIEN, CHAIRPERSON
BOARD OF COUNTY COMMISSIONERS
Carmella Sabauagh
CARMELLA SABAUGH, COUNTY CLERK
Candice S. Miller
CANDICE S. MILLER, COUNTY TREASURER

COUNTY DRAIN COMMISSIONER'S CERTIFICATE:

APPROVED ON July 22, 1994 AS COMPLYING WITH SECTION 192 OF ACT 288, P.A. 1967, AND THE APPLICABLE RULES AND REGULATIONS PUBLISHED BY MY OFFICE IN THE COUNTY OF MACOMB.

Anthony V. Marrocco
ANTHONY V. MARROCCO
MACOMB COUNTY DRAIN COMMISSIONER

CERTIFICATE OF MUNICIPAL APPROVAL:

I CERTIFY THAT THIS PLAT WAS APPROVED BY THE TOWNSHIP BOARD OF THE TOWNSHIP OF HARRISON AT A MEETING HELD August 8, 1994 AND WAS REVIEWED AND FOUND TO BE IN COMPLIANCE WITH ACT 288, P.A. 1967. SURETY HAS BEEN POSTED FOR THE PLACING OF MONUMENTS AND LOT MARKERS WITHIN ONE YEAR OF THE ABOVE DATE. MINIMUM LOT WIDTH AND AREA REQUIRED BY SECTION 184(7) ACT 288 OF P.A. 1967, HAS BEEN WAIVED AND CONFORMS WITH THE LEGALLY ADOPTED ZONING AND SUBDIVISION CONTROL ORDINANCES OF THE TOWNSHIP OF HARRISON. PUBLIC SEWER AND WATER SERVICES HAVE BEEN INSTALLED AND ARE READY FOR CONNECTION WITHIN THE PLAT.

Kathleen M. Lyon
KATHLEEN M. LYON
TOWNSHIP CLERK

MICHIGAN DEPARTMENT OF TRANSPORTATION CERTIFICATE:

APPROVED ON September 23, 1994 AS COMPLYING WITH ACT 288, P.A. 1967 AND THE APPLICABLE PUBLISHED RULES AND REGULATIONS OF THE DEPARTMENT OF TRANSPORTATION.

G. Robert Adams
G. ROBERT ADAMS, CHIEF DEPUTY DIRECTOR
MICHIGAN DEPARTMENT OF TRANSPORTATION

RECORDING CERTIFICATE:

STATE OF MICHIGAN)
MACOMB COUNTY)


THIS PLAT WAS RECEIVED FOR RECORD ON THE 16 DAY OF NOVEMBER 1994 AT 11:17 A.M. AND RECORDED IN LIBER 185 OF PLATS ON PAGES 37-72



Carmella Sabauagh
CARMELLA SABAUGH, COUNTY CLERK
REGISTER OF DEEDS

D. D. Peterson

Giffels-Webster Engineers, Inc.
ENGINEERS - SURVEYORS - PLANNERS
2071 BOND STREET ROCHESTER HILLS MICHIGAN
(313) 862-3100

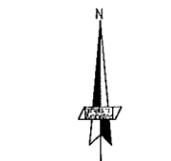

DATE	EDITS


Designed For
MACOMB COUNTY REGISTER OF DEEDS
CLEMENS CENTER
32 MARKET STREET
MOUNT CLEMENS, MI 48043
588-469-8752
588-469-5130

2014 REMON WORKSHEET

CLINTON TWP
MACOMB COUNTY
MICHIGAN

Date: 10-06-14
Scale: 1"=400'
Sheet: 1
Project: 13784.62

POINT	NORTH	EAST	DESC
7	339753.314	1352375.221	CALC
8	339550.392	13518704.650	CALC
9	335494.312	13518747.733	CALC
17	339291.878	13512746.786	LP MON PT
18	339184.900	13512750.677	CALC
19	339333.718	13512645.014	CALC
475	339211.551	13514311.510	CALC
487	339379.276	13514341.241	CALC 4.240M SOUTH
491	42022.241	13518173.590	CALC
506	339244.641	13515099.816	CHIFFENAW SUB
508	339106.030	13516417.259	CHIFFENAW SUB
1001	339689.764	13518749.967	FI
1002	339593.828	13518748.466	FI
1003	339442.379	13518704.791	SQUARE MON
1005	339425.375	13516458.714	FI
1006	339433.142	13518718.195	FI 3/4"
1077	339500.097	13513111.394	INLET SIDE 1
1076	130217.628	13518486.544	INLET SIDE 1
1078	339374.254	13514245.000	CALC PC-026
1091	339374.427	13514223.911	CALC
1355	339374.419	13513115.476	5-20 FD REMON CAP
1357	339384.544	13513115.908	5-20 FD REMON CAP
1360	339950.379	13513118.331	243 FI
1361	187721.218	13513118.331	243 FI
1363	339241.812	13513118.278	243 FI
1369	339490.150	13513118.497	243 FI
1372	339550.320	13513118.379	243 FI
1373	339490.870	13513118.433	164 PM BROWN
1374	339334.148	13513118.611	163 FI BENT
1375	339324.265	13513118.316	164 PM BROWN
1376	339354.983	13513118.817	163 FI
1380	339431.439	13515679.951	243 FI
1381	339431.572	13515679.481	243 FI
1382	339246.396	13515679.455	243 PM
1383	339246.313	13515679.297	243 PM
1386	339246.630	13515679.785	243 17219
1388	339333.074	13514424.132	243 PM
1390	339444.843	13513118.911	243 14929
1391	339494.364	13513118.210	243 PM
1392	339494.364	13513118.210	243 PM
1393	339494.364	13513118.210	243 PM
1394	339494.364	13513118.210	243 PM
1395	339494.364	13513118.210	243 PM
1396	339494.364	13513118.210	243 PM
1397	339494.364	13513118.210	243 PM
1398	339494.364	13513118.210	243 PM
1399	339494.364	13513118.210	243 PM
1401	339207.934	13513118.430	243 PM HD

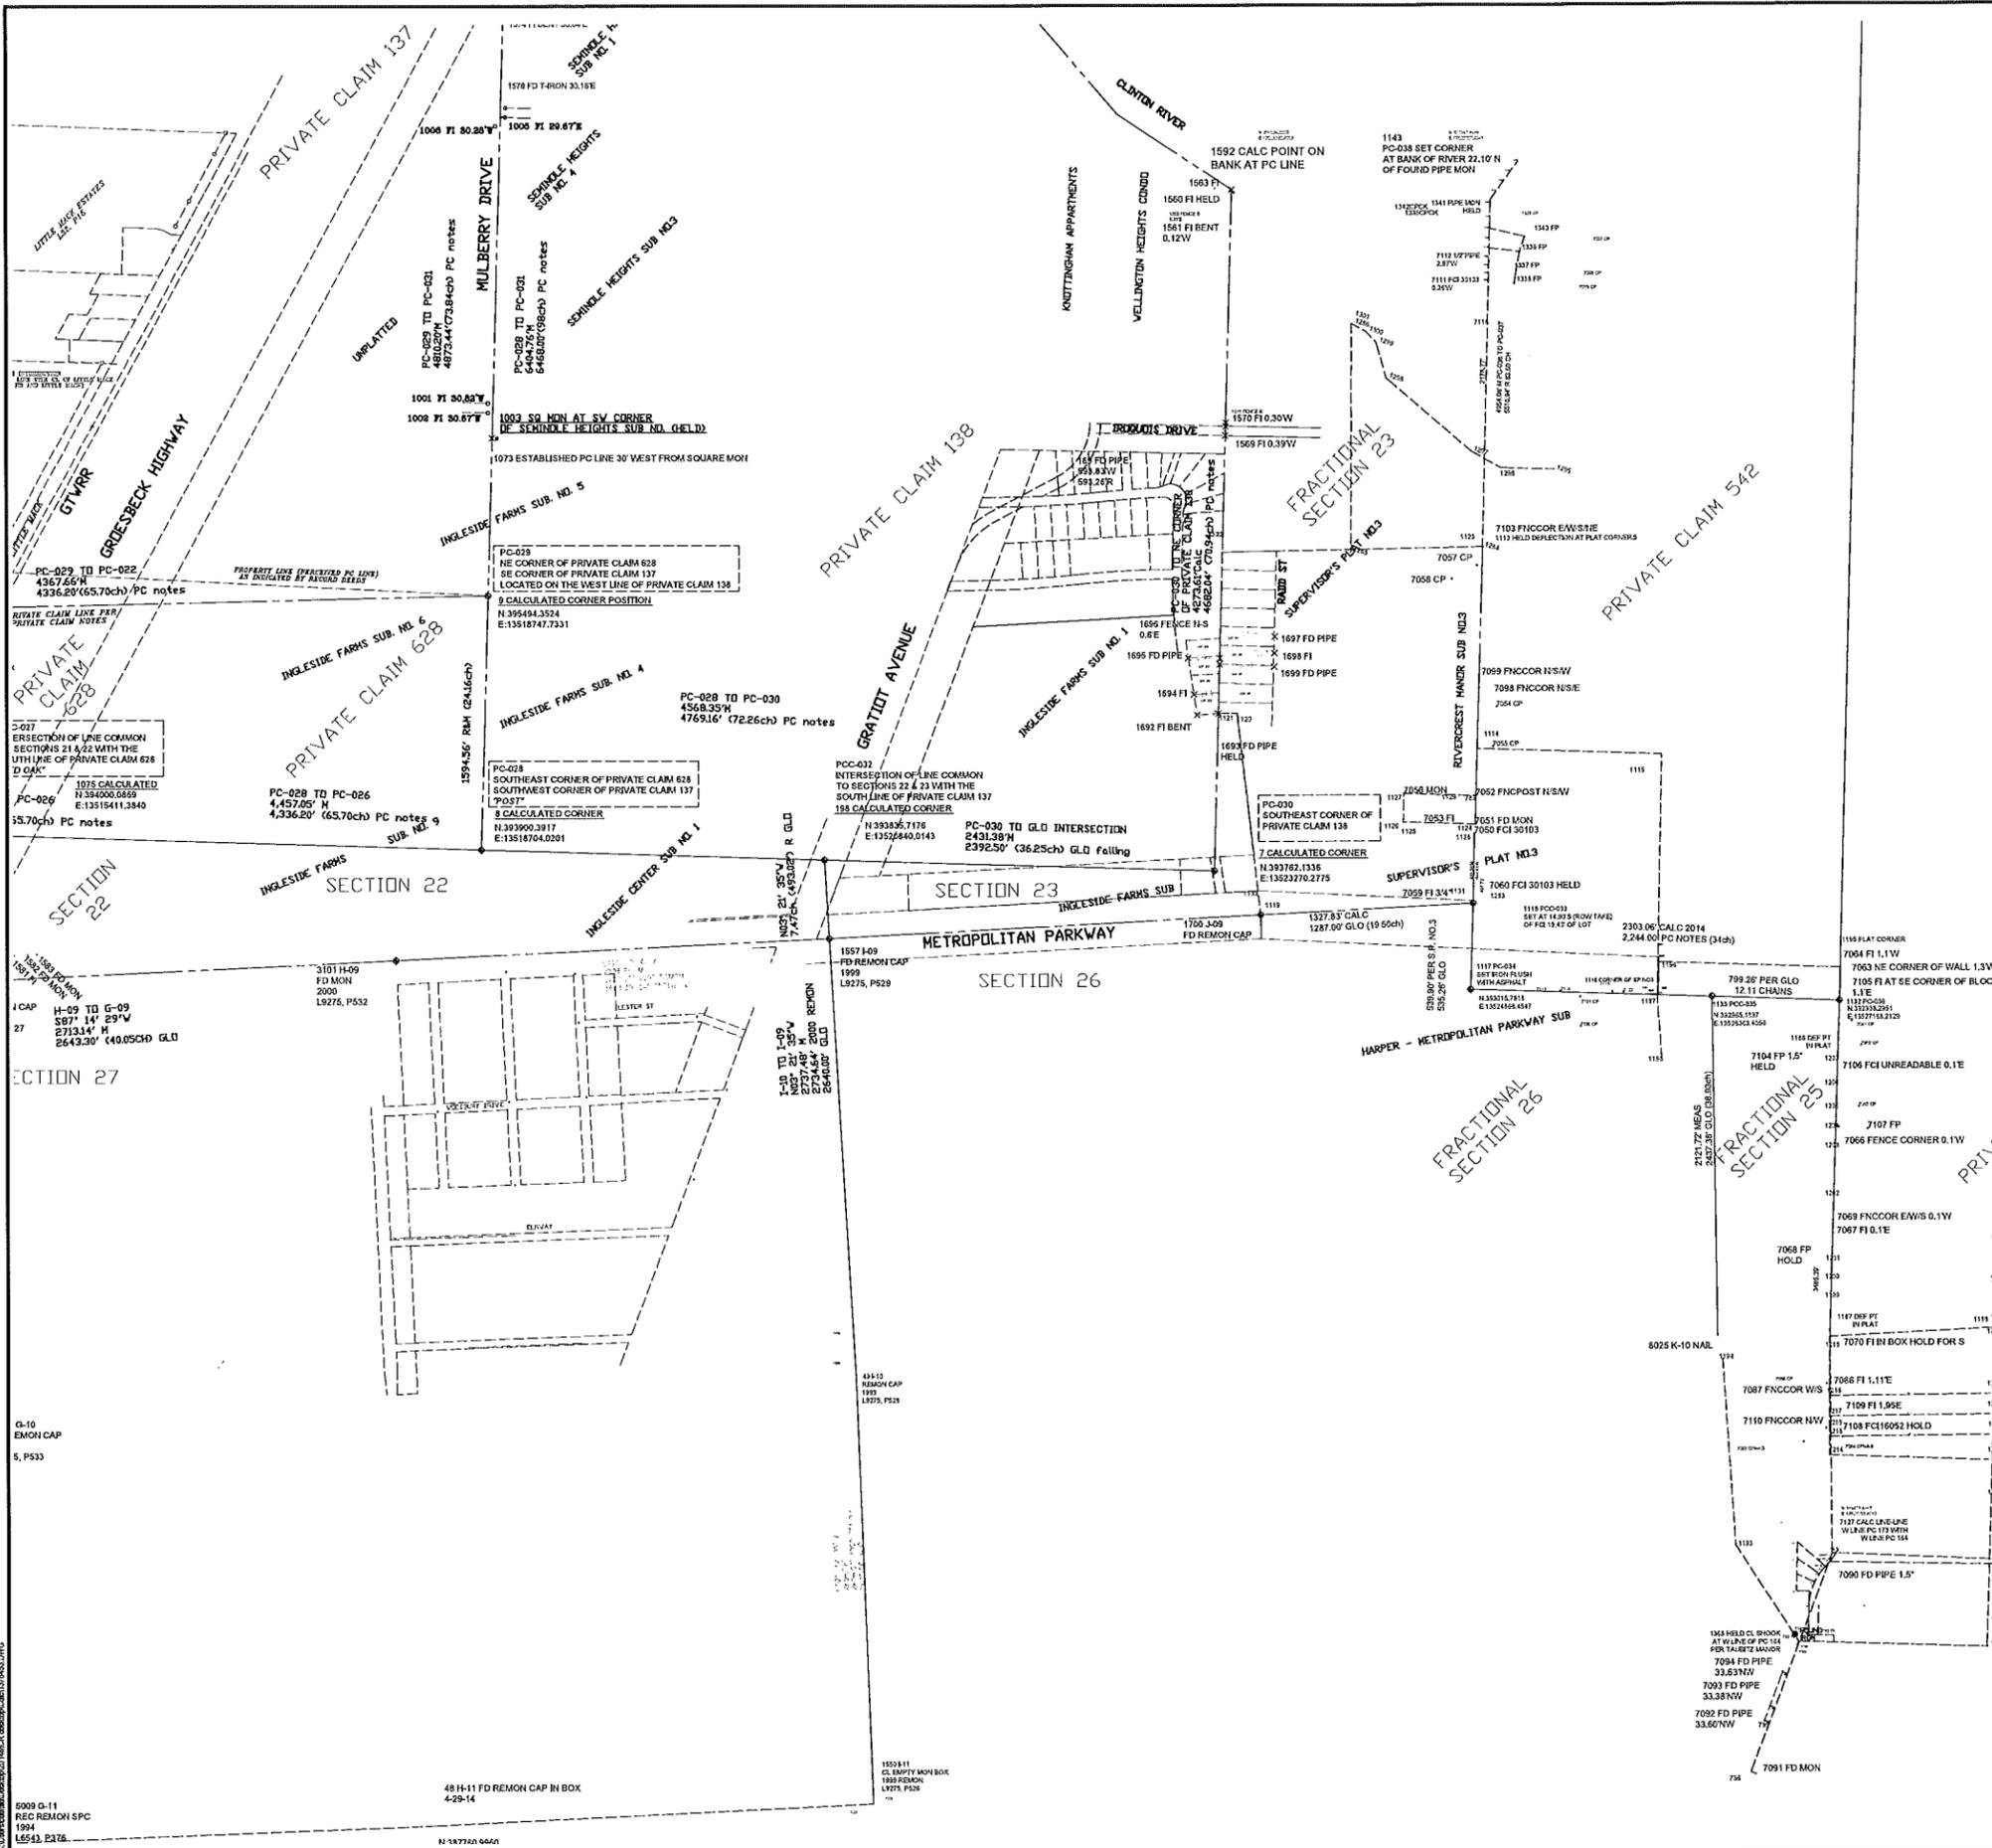

5009 G-11
REC REMON 5PC
1994
L6541, E3476

48 H-11 FD REMON CAP IN BOX
4-28-14

1550 B-11
CL EMPTY MON BOX
1887 FENON
L9275, P526

N 147726 6441