

---

**MACOMB COUNTY 2016 REMONUMENTATION GRANT  
PROGRAM FOR CLINTON TOWNSHIP  
B-02**

**Section One**

Index

Pictures in the four cardinal directions; found monumentation and after setting the required monumentation.

**Section Two**

Surveyor's Report

Land Corner Recordation Certificate

**Section Three**

1-2. Field Notes

3. Map of Clinton Township – 1875

4. Map of Clinton Township – 1895

5. Map of Clinton Township – 1916

6. Map of Clinton Township – 2006

7. Macomb County Composite Map 11-06B

8. Macomb County Composite Map 11-06C

9. Macomb County Composite Map 11-06F

10. Macomb County Composite Map 11-06G

**Section Four**

1. Land Corner Recordation Certificate, L. 3310, pg. 115, Page one of one

2. Land Corner Recordation Certificate, L. 06325, pg. 317, Page one of one














**Land Corner Recordation Certificate**  
**2016 Annual Grant Agreement**  
 Authority: MICH. 1970 PA 74, MCL 54.205

Surveyor's Name: Huston K. Kennedy, PS  
 For Corner(s) in: Macomb County

Field Survey Date: June 4, 2016  
 Municipality: Clinton Township

Corner Type	Section Private Claim	Survey Township				Corner Code
Original Public Land Survey Corner	S/PC _____	T _____	N _____	R _____	E _____	_____
Property Controlling Corner	S/PC _____	T _____	N _____	R _____	E _____	_____
Property Corner	S/PC _____	T _____	N _____	R _____	E _____	_____
Protracted Public Land Survey Corner	S/PC <u>6</u>	T <u>02</u>	N _____	R <u>13</u>	E _____	<u>B-02</u>

Other Corner Code Description:

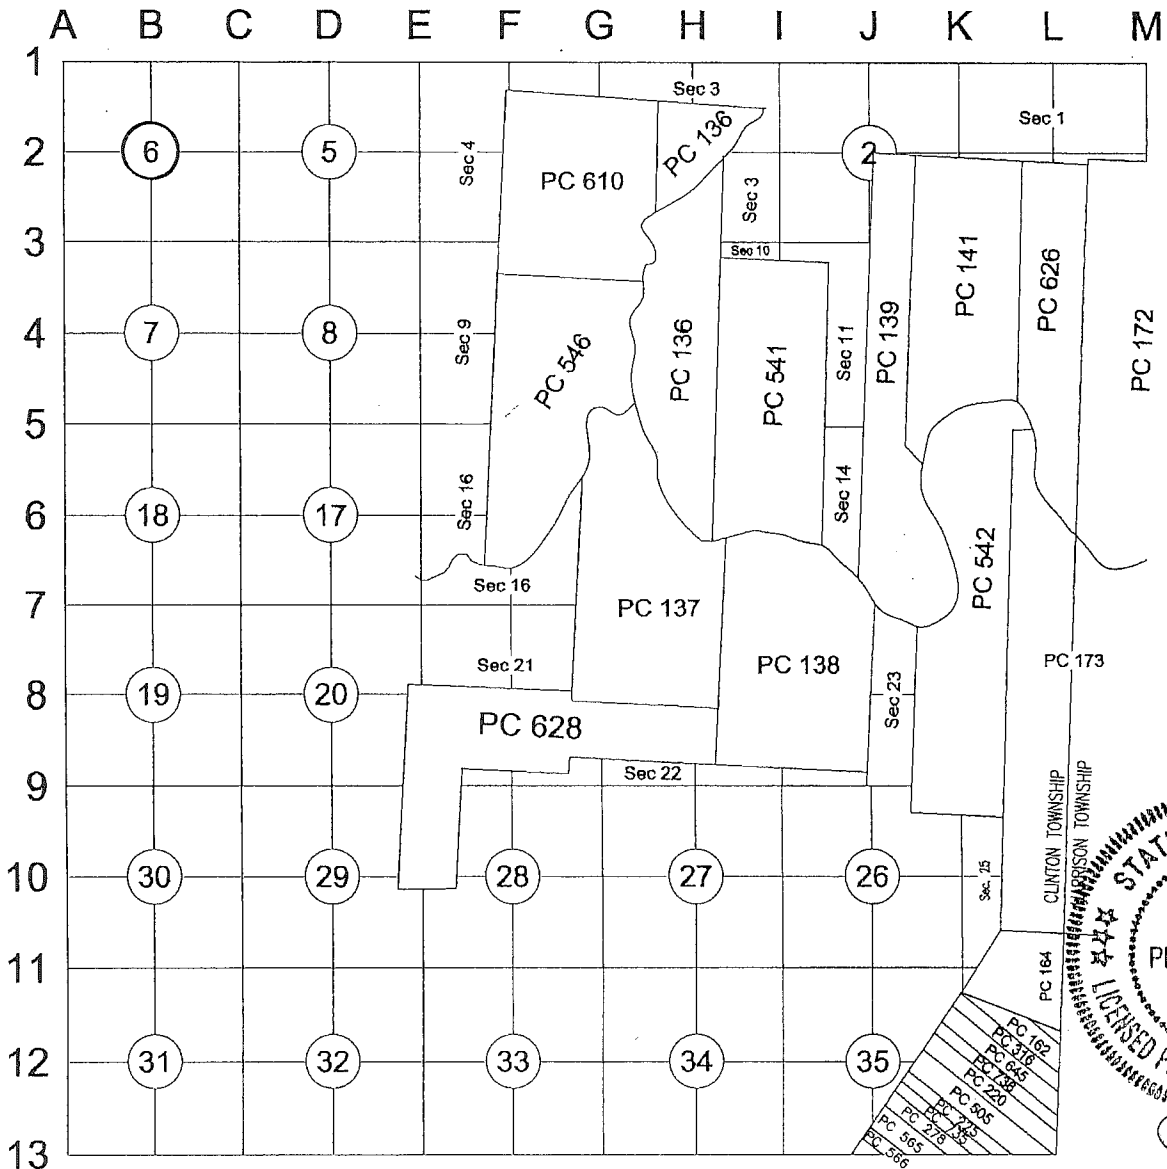

4 MB

C



**Part A: Corner History:**

- 1.) 1818-Preston, D.S., Center of Section 6 was not monumented during the original government survey
- 2.) 1981-Avey, RLS #15396; LCRC L. 3310, pg. 115 – Replaced the corner by setting a 1/2" bar with cap #15396 using the witnesses below which were found in good condition
- 3.) 1994-Money, PS #30092; LCRC L. 06325, pg. 317 – Fnd a 3/4" pipe

**Part B: Surveyor's Report on Perpetuation, Restoration, Reestablishment or Monumentation of Corner:**

The Center of Section 6 was not monumented in the original government survey. The corner has been perpetuated with a 3/4" x 24" iron pipe that falls 19' west of the back of the concrete curb and gutter for Dalcoma Drive extending to the north and south, which has a bituminous surface. There are no lines of occupational features extending to the east or west.

The witnesses from items # 2 & 3 as listed in Part "A", the comparison of the recorded distance to the measured distance between the following adjacent public land corner to the South (B-03) were used to validate the found 3/4" iron pipe as the best evidence for the Center of Section 6 (B-02) to be perpetuated.

**RECORDED, UNRECORDED AND FIELD MEASUREMENTS BETWEEN ADJACENT CORNERS**

**B-02 to B-01**

No GLO  
N02°23'36" W 2693.66 Ft. (mea. 2016)

**B-02 to B-03**

No GLO  
LCRC recorded in Liber 3310, page 115 = 2659.88 Ft.  
N02°47'57" W 2660.23 Ft. (mea. 2016)

**B-02 to A-02**

No GLO  
S87°20'49" W 2666.68 Ft. (mea. 2016)

**B-02 to C-02**

No GLO  
N87°03'50" E 2658.86 Ft. (mea. 2016)


**Part C: Field Evidence of Perpetuation or Monumentation of Corner:**

B-02 I replaced the found 3/4" iron pipe with a 4" diameter concrete monument with a 1/2" iron rod 36" long with a 2" diameter brass cap stamped "Macomb County Monument, MI Act #345, PS #17623" (B-02)

**Accessories:**

- N08°W 48.92' Cut "x" south edge casting for GV&W manhole
- S20°E 61.62' Cut "x" NE corner casting for storm sewer structure
- S45°E 81.70' Cut "x" NW corner of casting for storm sewer structure
- N89°E 10.61' Cut "x" East side of casting for sanitary sewer manhole
- N72°E 99.44' Set Mag Nail w/Remon washer stamped "Macomb County Witness Tag" top a guardrail post

I, Huston K. Kennedy, P.S., in a field survey on June 4, 2016, certify under the requirements of the State Survey and Remonumentation Act, 1990 PA 345, MCL 54.261 to 54.279, and the Corner Recordation Act, 1970 PA 74, MCL 54.201 to 54.210d, that the corner identified and described hereon has been perpetuated or monumented as described in Parts A, B, and C above, pursuant to the laws and rules of the State of Michigan.

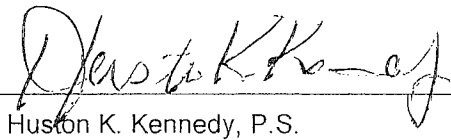
  
Huston K. Kennedy, P.S.

September 12, 2016

Date

Professional Surveyor's License No.: 17623

Prepared by:  
Huston K. Kennedy, PS  
105 North Washington Street  
Oxford, Michigan 48371

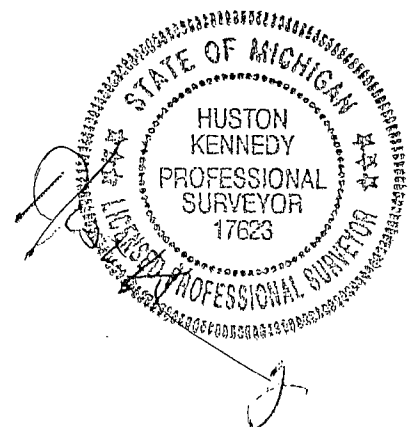



Geodetic Coordinate Data for corner:

Corner Code and Narrative Description: B-02, T02N, R13E  
0

Date of Observation	Latitude	Longitude	Datum and Adjustment Year	Epoch Date
14 June 2016	N42°37'12.021136"	W-82°57'47.064630"	NAD83 (2011)	2010.0000

Method for Latitude-Longitude determination: : Dual Frequency Static Observations constraining to the CORS stations of Auburn Hills (AJ5557), Livonia (DK7841) and Brighton (AJ5553), with 3 dimensional least square adjustment.

Disclaimer on accuracy of values reported relative to their use: 1' ±.

State Plane Coordinates in international feet: N-411308.92, E-13501109.78  
Standard Deviation: 0.04 N-0.05 E  
Zone South  
Combined Factor: 0.99989  
NGSPID: = Washington Station (DH 9019)  
Survey Method: GPS C2-II  
Orthometric Height: 600.38  
Elev. Datum: NAVD 88

I, Joseph C. Kapelczak, state under the requirements of the State Survey and Remonumentation Act, 1990 PA 345, MCL 54.261 to 54.279, that the Latitude and Longitude reported hereon were observed by me for the corner identified hereon and that the data reported meets the requirements prescribed for the State Survey and Remonumentation Program.

*Joseph C. Kapelczak*  
\_\_\_\_\_  
Joseph C. Kapelczak, PS

*SEPT. 12, 2016*  
\_\_\_\_\_  
Date

Professional Surveyor's License No.: 24598

JCK Group, Inc.  
8615 Richardson Road  
Suite 100  
Commerce Township, MI 48390



I, Martin C. Dunn, state that the corner(s) identified and described hereon and perpetuated or monumented as described in Parts A, B, and C above was presented to and reviewed by the Peer Review Group on July 12, 2016 and is accepted for filing in the Macomb County Remonumentation Program.



*Martin C. Dunn*  
\_\_\_\_\_  
Martin C. Dunn, P.S.

*9-30-2016*  
\_\_\_\_\_  
Date

Macomb County Surveyor Representative  
License No. 30081



# SKETCH OF CORNER LOCATION

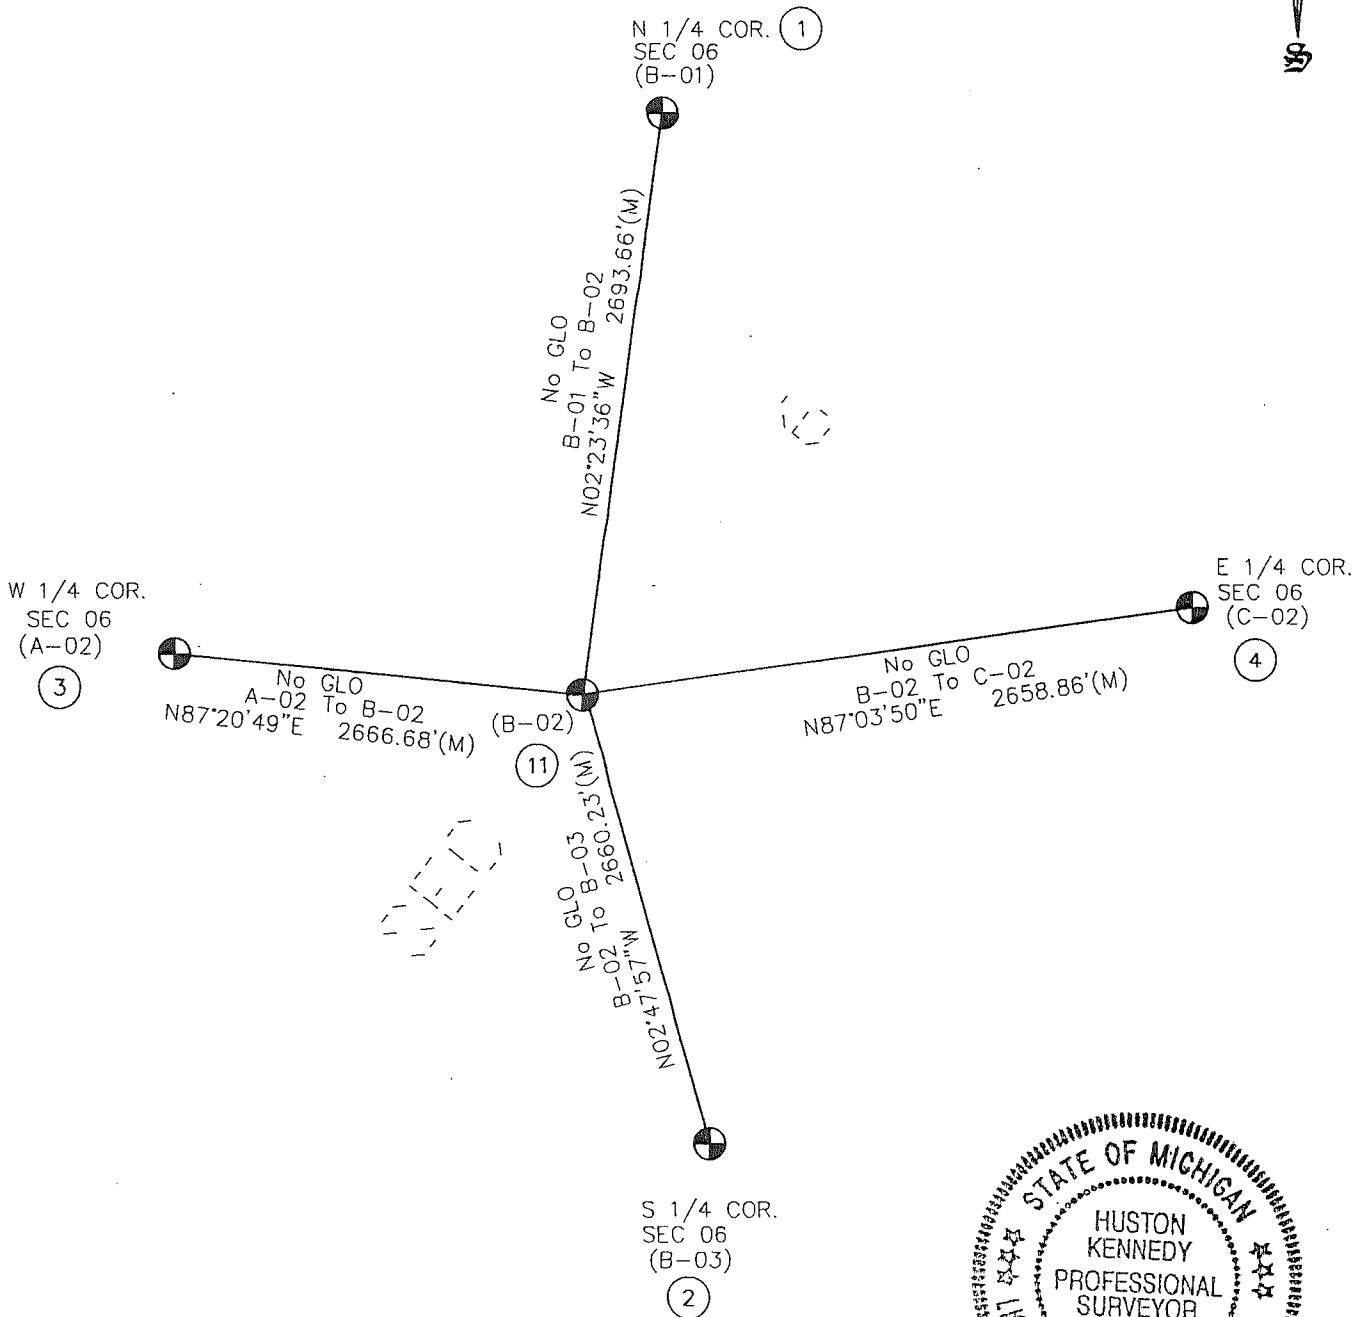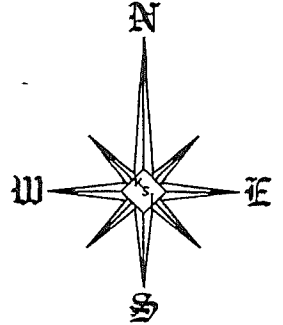

SECTION 06, T02N, R13E  
CLINTON TOWNSHIP  
(16-7610)

Center of Section that is being accepted and used. ⑪

Not To Scale

Land Corner Recordation Certificate  
T 02 N R 13 E Code B-02

**2016  
MACOMB COUNTY REMONUMENTATION  
GRANT PROGRAM FOR  
CLINTON TOWNSHIP  
Research Dossier  
B-02**

Prepared by:  
Kennedy Surveying, Inc.  
105 North Washington Street  
Oxford, Michigan 48371

---

**Sources of Information Researched  
For Macomb County 2016 Remonumentation Grant Program  
for Clinton Township**

- 1) GLO Notes
- 2) Act 74 Recorded LCRC
- 3) Act 132 Recorded Surveys
- 4) Personal History and Records
- 5) LCRC's and Surveys
- 6) Letters to the Following, Requesting Unrecorded information
  - a) Anderson, Eckstein & Westrick
  - b) BMJ Engineers & Surveyors
  - c) Community Engineering & Surveying
  - d) David Little Land Surveyor
  - e) David P. Smith & Associates, Inc.
  - f) Fenn & Associates Surveying, Inc.
  - g) George Jerome & Company
  - h) Grant Ward Surveyors
  - i) Great Lakes Geomatics
  - j) JCK Group, Inc.
  - k) James Land Surveying
  - l) Kem-Tec & Associates
  - m) Kieft Engineering, Inc.
  - n) Lehner Associates, Inc.
  - o) Metco Land Sea Corp.,
  - p) Milletics & Associates
  - q) R. A. Duthler Land Surveyor, LLC
  - r) Reichert Surveying
  - s) R. J. Donnelly & Associates
  - t) Road Commission for Macomb County
  - u) Rowe Professional Services
  - v) Spalding, DeDecker & Associates
  - w) Urban Land Consultants, LLC
  - x) William J. Angus & Associates



## **B-02 TOWN 02 NORTH, RANGE 13 EAST, CLINTON TOWNSHIP**

Recorded and unrecorded surveys, LCRC's, plats and condominium plans that were used to recover and verify the location of B-02.

### **EXISTING FILED CONDITIONS**

Found a ¾" x 24" iron pipe 19' west of back of concrete curb and gutter for Dalcoma Drive extending to the north and south, which has a bituminous surface with concrete curb and gutter. There are no lines of occupational features extending to the east or west.

### **GLO HISTORY**

1818 – W. Preston, D.S., the township was divided into sections with closing corners set on the north and west lines of the township, the Center of Section 6 was not monumented during the original government survey.

### **RECORDED AND UNRECORDED INFORMATION USED TO RECOVER AND VERIFY THE LOCATION OF THIS CORNER**

February 17, 1981 – Herbert J. Avey, RLS #15396 recorded a LCRC in Liber 3310, page 115. He replaced the corner by setting a ½" bar with cap #15396 using the witnesses below which were found in good condition.

### **WITNESSES:**

73.24' north PK nail in west face 4" Wild cherry (gone)  
66.95' west to form nail in washer north face triple 6" Maple (gone)  
120.47' SE to vertical PK nail in westerly root 30" Maple (gone)  
\*2659.88' south to ½" bar in monument box centerline 19 Mile Road – south ¼ corner (mea. 2660.16')

May 11, 1994 – Shelby W. Money, PS #30092 recorded a LCRC in Liber 06325, page 317. He found a ¾" pipe.

### **WITNESSES:**

\*Az 00° 15.80' Fnd the centerline of gas line marker (mea. 15.80')  
Az 00° 73.24' Set PK nail w/tag #30092 above scar found in the west face of 6" Cherry (gone)  
Az 55° 78.14' Set PK nail w/tag #30092 in the NW face of 8" Elm on the west bank of drain (gone)  
Az 275° 66.95' Fnd Form nail in the north face of a triple 8" Maple (gone)  
\*Az 310° 81.75' Fnd the centerline of a hydrant

### **RECORDED, UNRECORDED AND FIELD MEASUREMENTS BETWEEN ADJACENT CORNERS**

#### **B-02 to B-01**

No GLO  
N02°23'36" W 2693.66 Ft. (mea. 2016)

#### **B-02 to B-03**

No GLO  
LCRC recorded in Liber 3310, page 115 = 2659.88 Ft.  
N02°47'57" W 2660.23 Ft. (mea. 2016)

(Revised 07/13/16)

**B-02 to A-02**

No GLO

S87°20'49" W 2666.68 Ft. (mea. 2016)

**B-02 to C-02**

No GLO

N87°03'50" E 2658.86 Ft. (mea. 2016)

**B-02 (as monumented) to B-02 (intersection of ¼ lines)**

N52°31'45" E 11.56 Ft. (cal.)

**SURVEYOR'S RECOMMENDATION**

The witnesses from the above mentioned recorded LCRC's, the comparison of the recorded distance to the measured distance between the following adjacent public land corner to the South (B-03) were used to validate the location of the found ¾" iron pipe as of June 14, 2016. I therefore, recommend to the Macomb County Survey Peer Group to accept the location of the found ¾" iron pipe as the best evidence of the Center of Section 6 (B-02) to be perpetuated.



Huston K. Kennedy, PS  
Kennedy Surveying, Inc.


HKK/ch

\*Used to verify the location of the found corner (B-02)

**2016  
MACPMB COUNTY REMONUMENTATION  
GRANT PROGRAM FOR  
CLINTON TOWNSHIP B-02**



16-7610

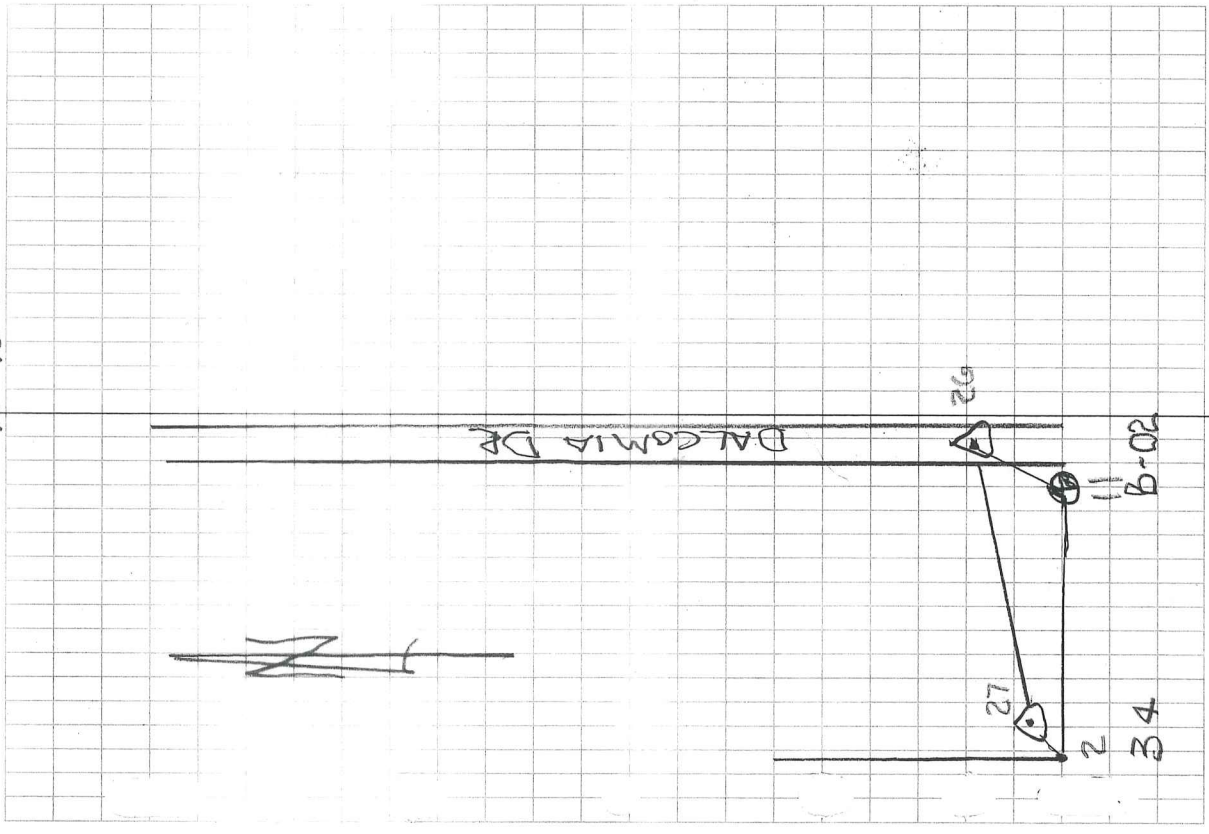

1348-22 (GR)					
1348-39 (L&W)	♂	26-27			Control
		1348.41			
PR 27 TO P7 11 (HL)	♂	26-11			B-02
1 34-01-10		76.38			
2 68-02-20					
3 34-01-10					
4 PR 27 TO P7 28 (HL)		26-28			with 28 NW Hwy
28 04-11-40	♂	126.72			
29 09-45-35	♂	68.97			Center G-V&W
30 06-10-55 (HL)	♂	110.93			NE cor. CB
31 05-19-10	♂	103.40			NW cor. CB
32 151-22-20	♂	37.52			GUARD RAIL Post
33 238-42-10 (HL)	♂	69.03			Center Spout Mid
4 PR 26 TO P7 34 (HL)	♂	27-34			Fo 1/2 Fe 1/2
1 140-26-35	♂	62.25			
2 280-53-00					47955
3 140-26-30					






# MAP OF CLINTON

Township 2 North Range 13 East

Scale 2 Inches to one Mile

of the Meridian of Michigan

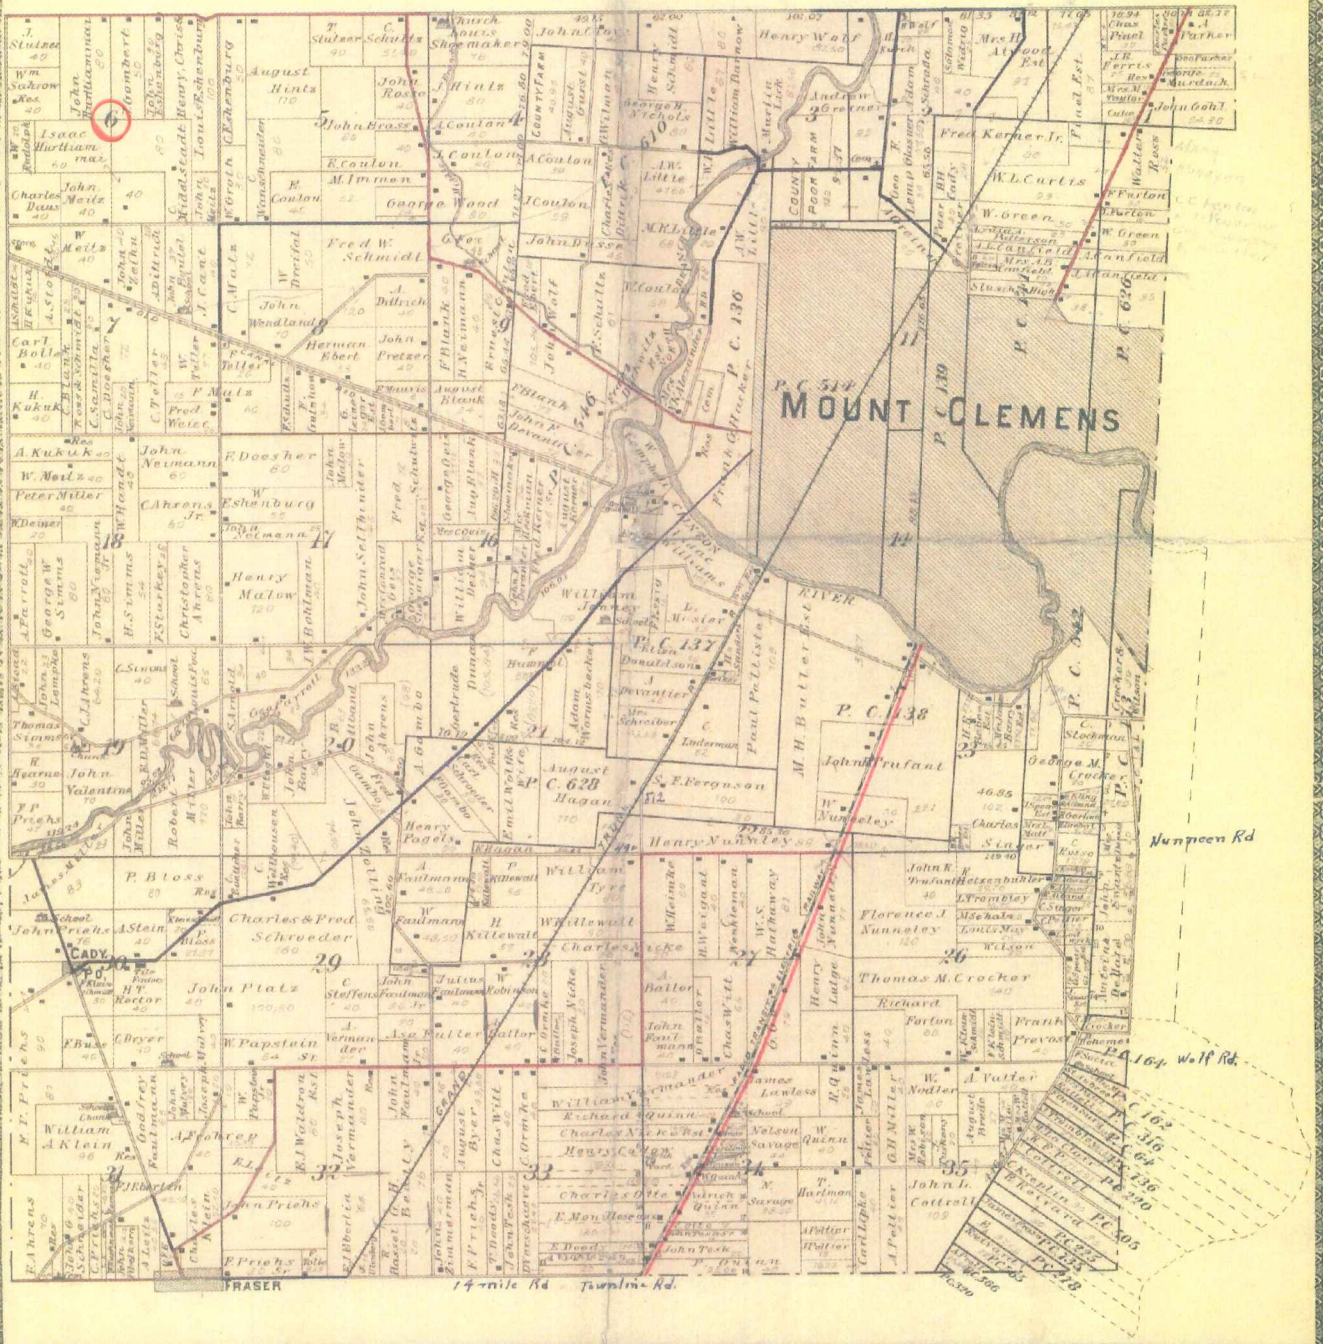


1895 (4)



MAP OF  
**CLINTON**  
 TOWNSHIP

Scale 2 inches to 1 mile

Fractional Township 2 North, Range 13 East of the Michigan Meridian

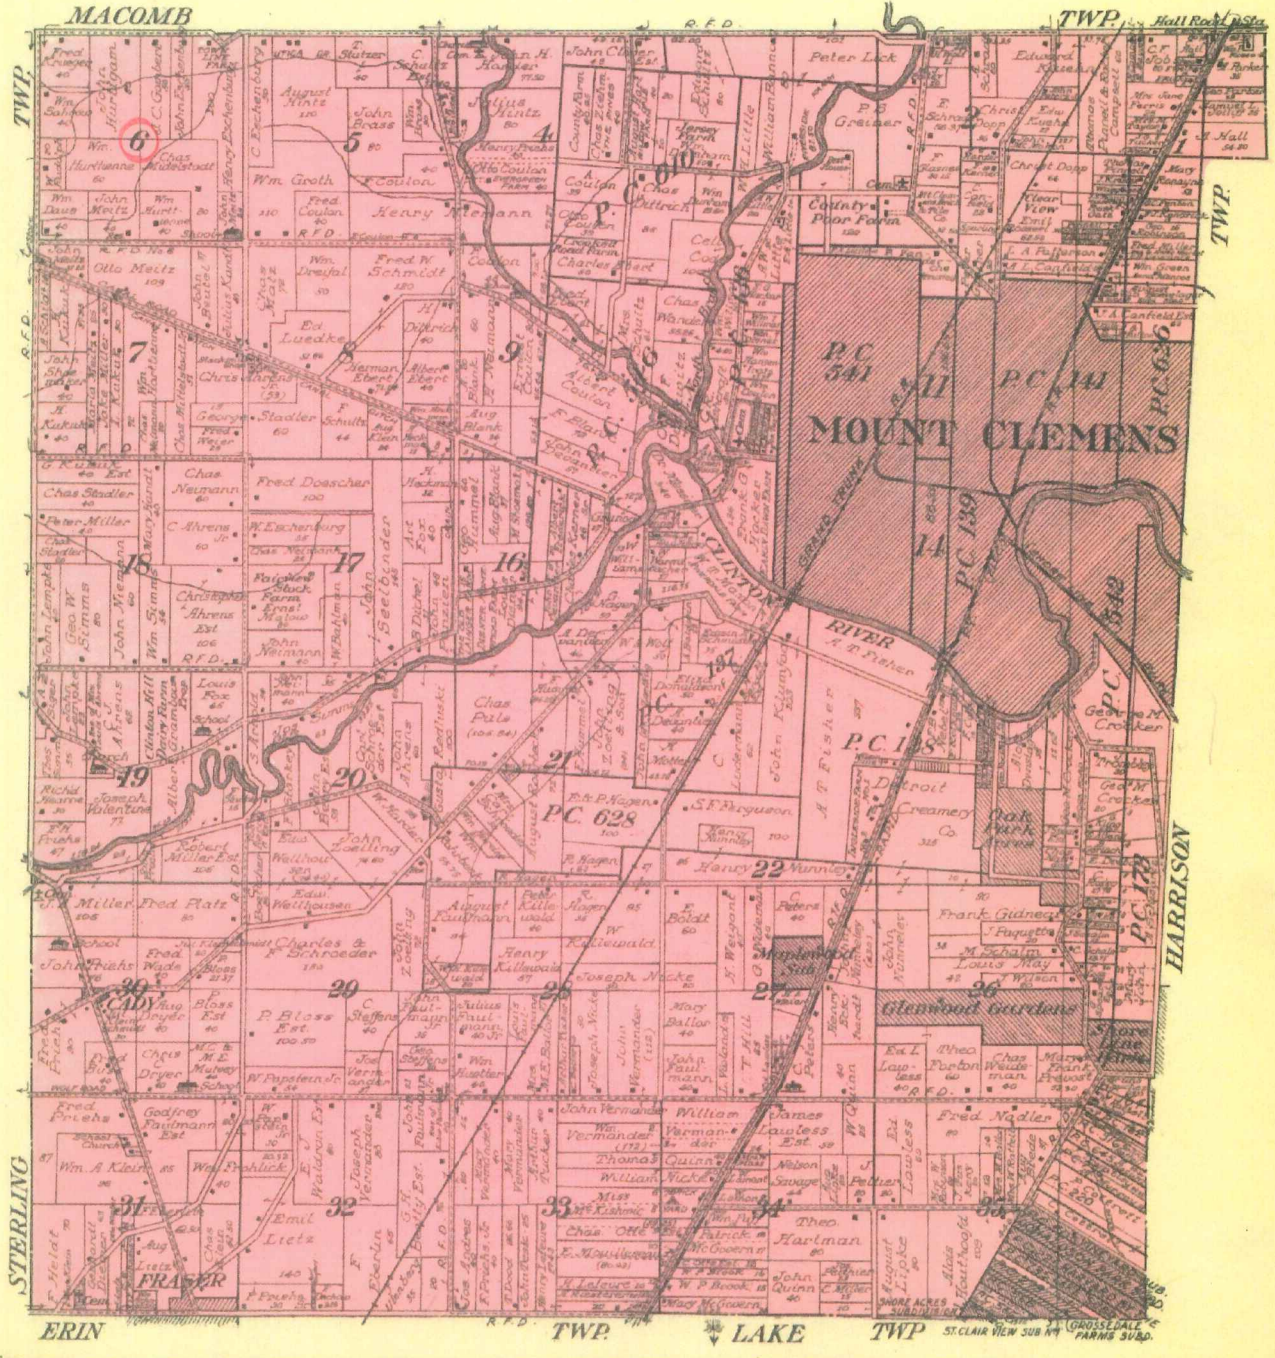

1916

5












Date of Photography: Spring 2012  
 100 50 0 100 200 Feet

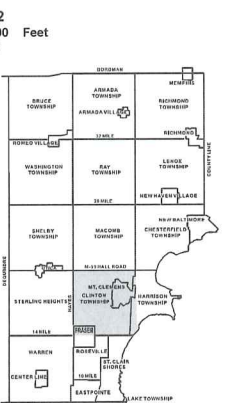

CLINTON TWP SHEET INDEX

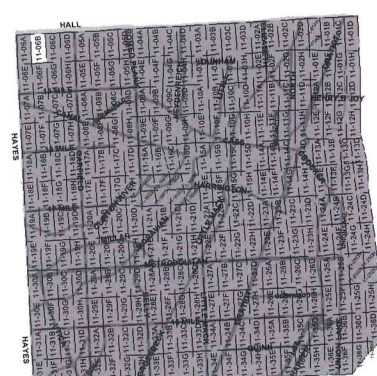

DESCRIPTION OF PERMANENT REAL ESTATE INDEX NUMBER  
**13-19-302-018**

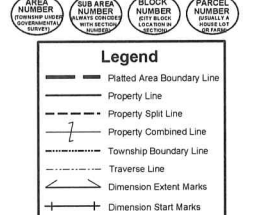

**11-06B**

CLINTON TWP.  
 E. 1/2 N.W. 1/4 SEC. 6 T. 2N. R. 13E.

Source: Macomb County Department of Planning and Economic Development  
 - 2008 Digital Orthophotography Project  
 - Parcel Conversion Project

Note: Digital Orthophotography horizontal positioning accuracy is 3 feet. Parcel boundary lines should be considered a graphical representation and not in any way a legal survey or engineering document. In general, the horizontal positioning and length accuracy is within 15 feet.

This map is intended for general planning purposes. Site specific evaluation should be verified by field inspection. This is a work in progress and may contain errors and omissions. Please report any potential revisions to (586)469-5285.



GIS **MACOMB COUNTY**  
 Planning and Economic  
 Development Department

Published: Jun 06 2013







Date of Photography: Spring 2012  
 100 50 0 100 200 Feet  
 1:1,200

CLINTON TWP SHEET INDEX

DESCRIPTION OF PERMANENT REAL ESTATE INDEX NUMBER  
**13-19-302-018**

**11-06C**

CLINTON TWP.  
 W.1/2 N.E. 1/4 SEC. 6 T.2N. R.13E.

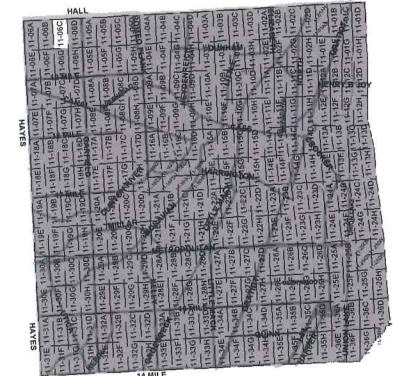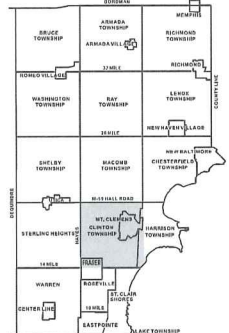

**Legend**

- Platted Area Boundary Line
- Property Line
- Property Split Line
- Property Combined Line
- Township Boundary Line
- Traverse Line
- Dimension Extent Marks
- Dimension Start Marks


Source: Macomb County Department of Planning and Economic Development  
 - 2008 Digital Orthophotography Project  
 - Parcel Conversion Project

Note:  
 Digital Orthophotography horizontal positioning accuracy is 3 feet. Parcel boundary lines should be considered a graphical representation and not in any way a legal survey or engineering document. In general, the horizontal positioning and length accuracy is within 15 feet.

This map is intended for general planning purposes. Site specific evaluation should be verified by field inspection. This is a work in progress and may contain errors and omissions. Please report any potential revisions to (586)469-5265.





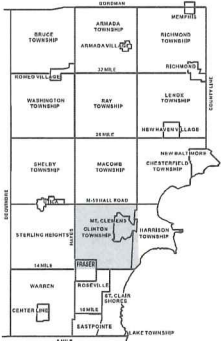

HALL	SEAVY
11-06-001 11-06-002 11-06-003 11-06-300

DESCRIPTION OF PERMANENT REAL ESTATE INDEX NUMBER  
**13-19-302-018**



**11-06F**

CLINTON TWP.  
 E.1/2 S.W.1/4 SEC.6 T.2N. R.13E.

Source: Macomb County Department of Planning and Economic Development  
 - 2008 Digital Orthophotography Project  
 - Parcel Conversion Project

Note: Digital Orthophotography horizontal positioning accuracy is 3 feet. Parcel boundary lines should be considered a graphical representation and not in any way a legal survey or engineering document. In general, the horizontal positioning and length accuracy is within 15 feet.  
 This map is intended for general planning purposes. Site specific evaluation should be verified by field inspection. This is a work in progress and may contain errors and omissions. Please report any potential revisions to (566)469-5285.





BRADFORD DR

327 COMMONS CONDOMINIUM

378

377

PROFESSIONAL OFFICE BUILDING

400

451

HEALTHIER WAY

DALCOGA DR


COMMONS DR

19 MILE RD


CLINTON TWP

Date of Photography: Spring 2012  
100 50 0 100 200 Feet

1:1,200

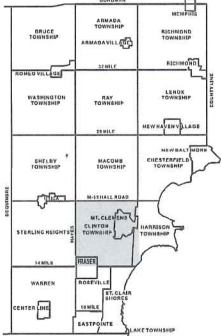

CLINTON TWP SHEET INDEX

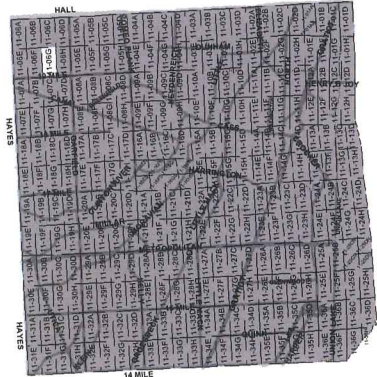

DESCRIPTION OF PERMANENT REAL ESTATE INDEX NUMBER  
**13-19-302-018**

**Legend**

- Platted Area Boundary Line
- Property Line
- Property Split Line
- Property Combined Line
- Township Boundary Line
- Traverse Line
- Dimension Extent Marks
- Dimension Start Marks

**11-06G**

CLINTON TWP.

W.1/2 S.E.1/4 SEC.6 T.2N. R.13E.

Source: Macomb County Department of Planning and Economic Development  
- 2008 Digital Orthophotography Project  
- Parcel Conversion Project

Note: Digital Orthophotography horizontal positioning accuracy is 3 feet. Parcel boundary lines should be considered a graphical representation and not in any way a legal survey or engineering document. In general, the horizontal positioning and length accuracy is within 15 feet.

This map is intended for general planning purposes. Site specific evaluation should be verified by field inspection. This is a work in progress and may contain errors and omissions. Please report any potential revisions to (566)469-5285.



GIS MACOMB COUNTY Planning and Economic Development

Published: Jun 06 2013



**LAND CORNER RECORDATION CERTIFICATE**  
 FILING REQUIREMENT OF ACT 74, MICH. P.A.1970

FOR CORNERS OF-- Section 6 LOCATED IN-- Clinton Twp. CORNER CODE NUMBER

1. PUBLIC LAND SURVEY T. 2 N. R. 13 E. B-2

2. PROPERTY CONTROLLING IN SECTION T. N. S. R. E. W.

3. MISCELLANEOUS PROPERTY IN SECTION T. N. S. R. E. W.

4. LOT NO. \_\_\_\_\_, RECORDED PLAT \_\_\_\_\_

5. PRIVATE CLAIMS \_\_\_\_\_

LIBER 3310 PAGE 115  
 A691956  
 RECORDED IN MACOMB COUNTY  
 RECORDS AT: 10:08 A.M.  
 FEB 17 1981

*Edna Hill*  
 CLERK-REGISTER OF DEEDS  
 MACOMB COUNTY, MICHIGAN  
 REGISTER OF DEEDS STAMP AND  
 FILING NUMBER

I, Herbert G. Avey, do hereby certify that under requirements of P.A. 74, Michigan P.A. of 1970, the corner points mentioned in lines 1 and 2 above were, in a field survey on November 26, 1980, established, re-established, monumented, re-monumented, recovered or restored as expressed below and in conformance with regulations and rules therefore as required in the current manual of survey instructions of the United States Department of the Interior, Bureau of Land Management or by a decree of a court of law. Furthermore, that the corner points mentioned in lines 3, 4 and 5 above were, in a field survey on \_\_\_\_\_, 19\_\_\_\_, found, recovered, restored, established or re-established as expressed below and in conformance with the rules of the Michigan State Board of Registration for Land Surveyors or, by a Decree of a Court of law:

A. Description of original monument and accessories and/or subsequent restoration:

330.00' west to  $\frac{1}{2}$ " bar on E-W  $\frac{1}{4}$  line.  
 2659.88' south to south  $\frac{1}{4}$  corner of Section 6.

B. Description of corner evidence found and/or method applied in restoring or re-establishing corner:

Found corner destroyed by construction. Replaced corner by use of above witnesses which were found in good condition.

C. Description of monument for corner and accessories established to perpetuate locating the position of the corner:

Set  $\frac{1}{2}$ " bar with cap #15396  
 73.24' north to P.K. nail in west face 4" wild cherry.  
 66.95' west to form nail in washer, north face triple 6" maple.  
 120.47' S.E. to vertical P.K. nail in westerly root 30" maple  
 2659.88' south to  $\frac{1}{2}$ " bar in monument box centerline 19 Mile Road - south  $\frac{1}{4}$  CORNER  
 330.00' west to  $\frac{1}{2}$ " bar cap #17635.



SIGNED BY Herbert G. Avey DATE December 4, 1980

SURVEYOR'S MICHIGAN REGISTRATION NO. #15396 (SEAL)

FOR STATE AND UNITED STATES AGENCIES:

SIGNED BY \_\_\_\_\_ DATE \_\_\_\_\_

APPROVED AND SIGNED BY \_\_\_\_\_ DATE \_\_\_\_\_ (SEAL)

SURVEYOR'S MICHIGAN REGISTRATION NO. \_\_\_\_\_

3'

1

2



188:06325PC317

0065826

LAND CORNER RECORDATION CERTIFICATE 94 MAY 11 AM 10:58  
Filing Requirement of Act 74, Mich. P.A. 1970

For corners in  
HACOMB  
(County)

Located in: CLINTON TOWNSHIP Corner Code: B-2

CAP. ... LAUGH  
REG. ... DEEDS  
MAY ... CITY, MI

- 1. Public Land Survey T 2N R 13E B-2
- 2. Property Controlling in Section S T R
- 3. Miscellaneous Property in Sec. S T R
- 4. Lot No. Recorded Plat
- 5. Private Claims

Register of Deeds Stamp & File Number

	A	B	C	D	E	F	G	H	I	J	K	L	M
2													
3													
4													
5													
6													
7													
8													
9													
10													
11													
12													
13													

I, Shelby W. Money, in a field survey on March 24, 1994, do hereby certify that under requirements of P.A. 74, Michigan P.A. of 1970, the corner points mentioned in lines 1 and 2 above were in conformance with regulations and rules therefore as required in the current manual of survey instructions of the United States Department of the Interior, Bureau of Land Management or by a decree of a Court of Law and/or that the corner points mentioned in lines 3, 4 and 5 above were in conformance with the rules of the Michigan Board of Land Surveyors or by a Decree of a Court of Law, established, re-established, monumented, re-monumented, recovered, found as expressed below:

NOTE: Not more than 4 corners, all in the same town and range, may be recorded on this certificate.

A. Description of original monument and accessories and/or subsequent restoration:

B-2 G.L.O. (1818) PRESTON NO WITNESSES FOUND  
LCRC (1981) LIBER 3310 PAGE 115. HERBERT G. AVEY, P.S. #15396 SET 1/2" BAR W/CAP #15396

B. Description of corner evidence found and/or method applied in restoring or reestablishing corner:

B-2 FOUND 3/4" PIPE  
LIBER 3310 PAGE 115  
NORTH 73.24' FOUND, PK'NAIL IN THE WEST FACE OF A 6" WILD CHERRY  
WEST 66.95' FOUND, FORM NAIL IN THE NORTH FACE OF A TRIPLE 6" MAPLE

C. Description of monument for corner and accessories established to perpetuate locating the position of the corner:

B-2 FOUND 3/4" PIPE  
THE CENTER POST, SECTION 6, T.2N., R.13E.  
AZ 00° 15.80' FOUND, THE CENTERLINE OF GAS LINE MARKER  
AZ 00° 73.24' SET, PK'NAIL W/TAG #30092 ABOVE SCAR FOUND IN THE WEST FACE OF A 6" CHERRY  
AZ 55° 78.14' SET, PK'NAIL W/TAG #30092 IN THE NORTHWEST FACE OF AN 8" ELM ON THE WEST BANK OF DRAIN  
AZ 275° 66.95' FOUND, FORM NAIL IN THE NORTH FACE OF A TRIPLE 8" MAPLE  
AZ 310° 81.75' FOUND, THE CENTERLINE OF A HYDRANT

Signed by Shelby W. Money  
Surveyor's Michigan License No. 30092

Date 5/11/94



FORM APPROVED BY MICHIGAN BOARD OF LAND SURVEYORS, MAY 14, 1975  
REVISED JAN., 1983

2