

C152233

LAND CORNER RECORDATION CERTIFICATE
Filing Requirement of Act 74, Mich. P.A. 1970

94 DEC 14 AM 10: 52

CARD REGISTRY AUGH DEEDS MACOMB COUNTY, MI

For corners in MACOMB (County)

Located In: Clinton Township Corner Code #

- 1. Public Land Survey T 2N R 13E J-1
2. Property Controlling in Section S T R
3. Miscellaneous Property in Sec. S T R

LIBER 6527 PAGE 810

Register of Deeds Stamp & File Number

- 4. Lot No. Recorded Plat
5. Private Claims

Grid table with columns A-M and rows 2-13. A dot is marked at the intersection of column J and row 2.

I, Randy Kolehouse, in a field survey on Sept. 28, 1994, do hereby certify that under requirements of P.A. 74, Michigan P.A. of 1970, the corner points mentioned in lines 1 and 2 above were in conformance with regulations and rules therefore as required in the current manual of survey instructions of the United States Department of the Interior, Bureau of Land Management or by a decree of a Court of Law and/or that the corner points mentioned in lines 3, 4 and 5 above were in conformance with the rules of the Michigan Board of Land Surveyors or by a Decree of a Court of Law; established, re-established, monumented, re-monumented, recovered, found as expressed below.

NOTE: Not more than 4 corners, all in the same town and range, may be recorded on this certificate.

A. Description of original monument and accessories and/or subsequent restoration:

Table with columns: J-1, 1817, G.L.O., Notes, Preston, NA, Post. Rows include MDOT Road Plans, L.C.R.C. L. 4382 P. 77, and L.C.R.C. L. 4685 P. 289.

ACCEPTED BY THE MACOMB COUNTY SURVEY PEER GROUP AS THE OFFICIAL CORNER UNDER MICHIGAN PUBLIC ACT 345 OF 1990 AT A MEETING HELD ON 10-4-94

Signature of William E. Scoderberg, P.S., CHAIRMAN

B. Description of corner evidence found and/or method applied in restoring or reestablishing:

J-1 Found 1/2" rebar in Monument Box 10.9 feet north of the center line of Hall Road (M-59) per the witnesses of above L.C.R.C.'s, 598.63' East of J-13 T3N R13E as monumented in 1993 (G.L.O. 574.2) said iron in monument box is 2082.9' West of K-13 (MDOT = 2082.4)


L.C.R.C. L. 4382 P. 77: N 30° E 46.2 PK in D.E. Pole, S 30° W 58.5 C/L Fire Hyd., S 50° W 80.3' PK in D.E. Pole, N 50° W 91.5 C/L Hyd.
L.C.R.C. L. 4685 P. 289: N 30° E 46.2 PK in D.E. Pole, S 30° W 58.5 C/L Fire Hyd., S 50° W 80.3' PK in D.E. Pole, N 50° W 91.5 C/L Hyd.

Measure W 2697.80 to I-1 (G.L.O. 2640)
Measure E 2656.96 to K-1 (G.L.O. 2640)

C. Description of monument for corner and accessories established to perpetuate locating the position of the corner:

J-1 I replaced the found 1/2" rebar with a 3/4" x 24" Iron Rod w/2" diameter aluminum cap stamped "Macomb County Monument MI Act 345 #25854" in an existing Monument Box.

- PK in NW Face Util. Pole N 20° E 46.03'
C/L Top Nut of Hyd. N 60° W 91.43'
C/L Top Nut of Hyd. S 28° W 58.52'
PK in SE Face Util. Pole S 35° W 80.22'
PK & Macomb Co. Remon. Tag in NE Face Util. Pole S 53° E 114.08'
C/L Hall Road (M-59) Pavement S 10.9'

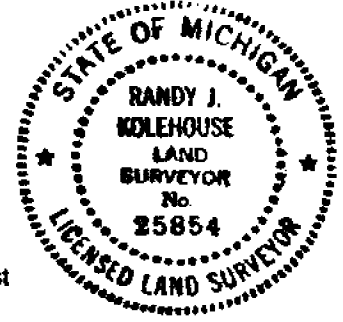

The selected location is accepted by me and is generally accepted by professional surveyors as the best available evidence of the position of the original corner.

Signed by Randy J. Kolehouse, Date 10/14/94, Surveyor's Michigan License No. 25854



**LAND CORNER RECORDATION CERTIFICATE**  
**Filing Requirement of Act 74, Mich. P.A. 1970**

or corners in

<u>MACOMB</u> (County)	Located In:	Corner Code #
Public Land Survey	T <u>3N</u> R <u>13E</u>	<u>J-13</u>
	T _____ R _____	_____
	T _____ R _____	_____
	T _____ R _____	_____
Property Controlling	S _____ T _____ R _____	_____
in Section	S _____ T _____ R _____	_____
Miscellaneous	S _____ T _____ R _____	_____
Property in Sec.	S _____ T _____ R _____	_____

Register of Deeds Stamp & File Number

1. Lot No. \_\_\_\_\_, Recorded Plat \_\_\_\_\_  
 5. Private Claims \_\_\_\_\_

	A	B	C	D	E	F	G	H	I	J	K	L	M
2	6		5		4		3		2		1		
3													
4	7		8		9		10		11		12		
5													
6	18		17		16		15		14		13		
7													
8	19		20		21		22		23		24		
9													
10	30		29		28		27		26		25		
11													
12	31		32		33		34		35		36		
13													

BRUCE ANTCLIFF, in a field survey on NOVEMBER, 1993

do hereby certify that under requirements of P.A. 74, Michigan P.A. of 1970, the corner points mentioned in lines 1 and 2 above were in conformance with regulations and rules therefore as required in the current manual of survey instructions of the United States Department of the Interior, Bureau of Land Management or by a decree of a Court of Law and/or that the corner points mentioned in lines 3, 4 and 5 above were in conformance with the rules of the Michigan Board of Land Surveyors or by a Decree of a Court of Law; established, re-established, monumented, re-monumented, recovered, found as expressed below:

**NOTE: Not more than 4 corners, all in the same town and range, may be recorded on this certificate.**

A. Description of original monument and accessories and/or subsequent restoration:

- |                            |   |
|----------------------------|---|
| GLO-Post, NO WITS. REMAIN  | MDOT (1989)-PK IN 3/4" PIPE<br>N&T IN PP, N50W, 8.43'                     |
| MDOT (1961)-3/4" PIPE      | TOP CENTER HYDRANT, N30E, 7.00'   |
| 32" ELM, N03W, 16.39'      | N&T IN 10" PINE, N85E, 53.01'   |
| 13" ELM, N70W, 43.81'      | PK IN NORTH EDGE PAVT, S05W, 35.54'                                       |
| 18" ELM, N82E, 82.40'      |   |
| N EDGE PAVT, SOUTH, 40.40' | LCRC (1989) L4685,P284-PK IN 3/4" PIPE<br>TOP CENTER HYDRANT, N30E, 7.00' |
|                            | NAIL IN 10" PINE, N85E, 53.01'  |
|                            | PK IN NORTH OF BIT., S05W, 35.54'   |
|                            | N&T IN PP, N50W, 8.43'  |

B. Description of corner evidence found and/or method applied in restoring or reestablishing corner:  
 FOUND 3/4" PIPE

FOUND AND VERIFIED THREE OF THE ABOVE WITNESSES

C. Description of monument for corner and accessories established to perpetuate locating the position of the corner:







LAND CORNER RECORDATION CERTIFICATE  
Filing Requirement of Act 74, Mich. P.A. 1970

or corners in

Macomb <small>County</small>	Located In.	Corner Code #/
Public Land Survey	T 2 N. R 13 E.	J-1, K-1
	T _____ R _____	_____
	T _____ R _____	_____
	T _____ R _____	_____
Property Controlling in Section 2	S _____ T _____ R _____	Clinton
Miscellaneous	S _____ T _____ R _____	Twp. _____
Property in Sec	S _____ T _____ R _____	_____

Register of Deeds Stamp & File Number

Lot No \_\_\_\_\_, Recorded Plat \_\_\_\_\_  
Private Claims \_\_\_\_\_

	A	B	C	D	E	F	G	H	I	J	K	L	M
2	6	5	4	3	2	1							
3													
4	7	8	9	10	11	12							
5													
6	16	17	18	19	20	21	22	23	24	25	26	27	28
7													
8	19	20	21	22	23	24	25	26	27	28	29	30	31
9													
10	20	21	22	23	24	25	26	27	28	29	30	31	32
11													
12	31	32	33	34	35	36							
13													

G.J. Landwehr in a field survey on January 22, 1988, hereby certify that under requirements of P.A. 74, Michigan P.A. of 1970, the corner points mentioned in lines 1 and 2 above were in conformance with regulations and rules therefore as required in the present manual of survey instructions of the United States Department of the Interior Bureau of Land Management or by a decree of a Court of Law and, or that the corner points mentioned in lines 3, 4 and 5 above were in conformance with the rules of the Michigan Board of Land Surveyors or by a Decree of a Court of Law, established, re-established, monumented, re-monumented, recovered, found as expressed below:

OTE: Not more than 4 corners, all in the same town and range, may be recorded on this certificate.

Description of original monument and accessories and/or subsequent restoration:

RECORDED IN MACOMB COUNTY  
RECORDS AT: 2:15 P. M.

MAR 10 1988

*Edna M. ...*

Description of corner evidence found and/or method applied in restoring or reestablishing corner: CLERK - REGISTER OF DEEDS  
MACOMB COUNTY, MICHIGAN

J-1 P.K. Nail found 2082.4 feet recorded and measured West of monument box

K-1 1/2" iron in mon box found 574.2 feet recorded and measured East of monument box

Description of monument for corner and accessories established to perpetuate locating the position of the corner.

J-1 N. 30° E. 46.2' P.K. Nail N.W. side of D.E. pole  
S. 30° W. 58.5' Center of fire hydrant  
S. 50° W. 80.3' P.K. Nail S.E. side of D.E. pole  
N. 50° W. 91.5' Center of fire hydrant  
South 10.9' Center line of pavement

K-1 S. 30° E. 56.3' P.K. Nail & washer N.E. side of D.E. pole  
S. 50° W. 61.0' Center of catch basin  
S. 60° W. 78.6' Center 3" metal sign post  
N. 50° W. 53.0' Center of catch basin

igned by *G.J. Landwehr* Date February 11, 1988  
urveyor's Michigan License No. 10065

LIBER 0468510289

B376060

LAND CORNER RECORDATION CERTIFICATE  
Filing Requirement of Act 74, Mich. P.A. 1970

For corners in

Macomb County	Located In	Corner Code
1. Public Land Survey	T 2 N. R 13 E.	J-1
	T R	
	T R	
	T R	
2. Property Controlling in Section	S T R	
3. Miscellaneous Property in Sec.	S T R	
4. Lot No.	Recorded Plat	
5. Private Claims		

RECORDED IN MACOMB COUNTY,  
RECORDS AT: 1:50p. M.  
JUL 18 1989

*Edna M. Hill*  
CLERK - REGISTER OF DEEDS  
MACOMB COUNTY, MICHIGAN  
Register of Deeds Stamp & File Number

I, P. H. Wetoskey in a field survey on June 28, 19 89, do hereby certify that under requirements of P.A. 74, Michigan P.A. of 1970, the corner points mentioned in lines 1 and 2 above were in conformance with regulations and rules therefore as required in the current manual of survey instructions of the United States Department of the Interior, Bureau of Land Management or by a decree of a Court of Law and/or that the corner points mentioned in lines 3, 4 and 5 above were in conformance with the rules of the Michigan Board of Land Surveyors or by a Decree of a Court of Law, established, re-established, monumented, re-monumented, recovered, found as expressed below.

NOTE: Not more than 4 corners, all in the same town and range, may be recorded on this certificate.

	A	B	C	D	E	F	G	H	I	J	K	L	M
2													
3													
4													
5													
6													
7													
8													
9													
10													
11													
12													
13													

A. Description of original monument and accessories and/or subsequent restoration:


J-1 From L.C.R.C. Liber 4382, Page 77, by G. J. Landwehr, No. 10065, on 2-11-88  
PK Nail found, 2,082.4 feet recorded and measured west of monument box.  
N 30° E 46.2' PK Nail NW side D.E. pole  
S 30° W 58.5' Center of F. Hyd.  
S 50° W 80.3' PK Nail SE side D.E. pole  
N 50° W 91.5' Center line of F. Hyd.  
South 10.9' C/L of pvt.

B. Description of corner evidence found and/or method applied in restoring or reestablishing corner:

J-1 Found PK Nail, 2,082.5571' Grid Distance west of monument box.  
N 30° E 46.2' N. side D.E. pole  
S 30° W 58.5' Center of F. Hyd.  
S 50° W 80.3' PK Nail SE side D.E. pole  
N 50° W 91.5' Top center of F. Hyd.  
South 10.9' Center of pvt.

C. Description of monument for corner and accessories established to perpetual locating the position of the corner:

J-1 Monument: Iron in Monu. Box  
N 30° E 46.2' N side D. E. pole  
S 30° W 58.5' Center of F. Hyd.  
S 50° W 80.3' PK Nail SE side D.E. pole  
N 50° W 91.5' Top center of F. Hyd.  
South 10.9' Center of pvt.

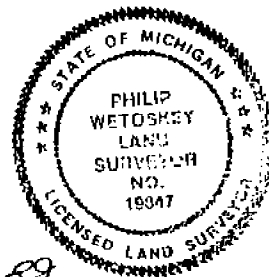

Signed by Phil Wetoskey Date 7-3-89  
Surveyor's Michigan License No. 19847  
Michigan Department of Transportation

FORM APPROVED BY MICHIGAN STATE BOARD OF LAND SURVEYORS, JAN. 28, 1971  
REVISED MAY 14, 1975  
REVISED JAN., 1983

01507