

REC'D NOV 15 2007 4:00 PM

LAND CORNER RECORDATION CERTIFICATE  
Filing Requirement of Act 74, Mich. P.A. 1970

For corners in

MACOMB  
(County)

Located in:  
HARRISON TWP.

Corner Code #

7158665  
LIBER 19067 PAGE 921  
11/29/2007 09:06:50 A.M.  
MACOMB COUNTY, MI SEAL  
CARNELLA SABAUGH, REGISTER OF DEEDS

1. Public Land Survey T 2N R 14E PC-011  
T R  
2. Property Controlling S T R  
in Section S T R  
3. Miscellaneous S T R  
Number S T R  
Property in Sec. S T R



4. Lot No. \_\_\_\_\_, Recorded Plat \_\_\_\_\_  
5. Private Claims PC-011, Southwest Corner of Private Claim 601 Common with a Corner Of Fractional Section 25


I, Steven E. Dunn, in a field survey on February 28 and August 6, 2007, do hereby certify that under requirements of P.A. 74, Michigan P.A. of 1970, the corner points mentioned in lines 1 and 2 above were in conformance with regulations and rules therefore as required in the current manual of survey instructions of the United States Department of the Interior, Bureau of Land Management or by a decree of a Court of Law and/or that the corner points mentioned in lines 3, 4 and 5 above were in conformance with the rules of the Michigan Board of Land Surveyors or by a Decree of a Court of Law, established, re-established, monumented, re-monumented, recovered, found as expressed below:

NOTE: Not more than 2 corners, all in the same town and range, may be recorded on this certificate.

A. Description of original monument and accessories and/or subsequent restoration:  
No evidence of Original Corner found.

Original survey performed by Aaron Greeley, July 18, 1810

(see Back)

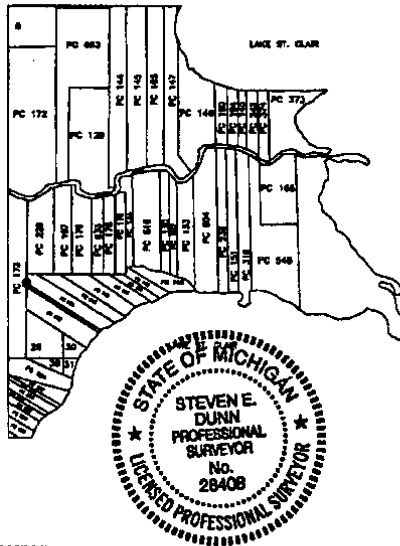

B. Description of corner evidence found and/or method applied in restoring or reestablishing corner:  
PC 011 Southwest Corner of Private Claim 601 also being a corner of Fractional Section 25. No evidence of original corner found. "John Campau Subdivision No. 1", as recorded in Liber 5 of Plats, Page 48, shows the line common with Private Claim 601 and Fractional Section 25 as being the rear of Lots 49 thru 79, yet makes no reference the corner. "Campau Lane Subdivision", as recorded in Liber 77 of Plats, Page 45 & 46, begins at the easterly corner of Lot No. 49 of said "John Campau Subdivision No. 1" and has a tie from the southwest corner of Private Claim No. 229 with a call along the line common with Private Claim No. 601 and Private Claim No. 173. I entered the calls for said "Campau Lane Subdivision" from the southwest corner of Private Claim No. 229 then rotated it around the southwest corner of Private Claim No. 229 to match the Private Claim line common with Private Claim No. 601 and Private Claim No. 173. I then set a point at the westerly corner of said Lot No. 49 on the line common with said Lot No. 49 and Lot No. 1 of said "Campau Lane Subdivision" the record distance of said Lot No. 49, being the line common with Private Claim 601 and Fractional Section 25. I then did a line-line intersection from this point and the southwest corner of Private Claim 229 to re-establish the location of the corner and set a 1/2" steel rod. Corner falls in the grassy area between the westbound I-94 exit ramp for Metropolitan Parkway, the entrance ramp from Metropolitan Parkway to westbound I-94 and the westbound lanes of I-94.

**FIELD MEASUREMENTS AND RECORD MEASUREMENTS (see back):**

C. Description of monument for corner and accessories established to perpetuate locating the position of the corner:  
PC 011 Southwest Corner of Private Claim 601 also being a corner of Fractional Section 25. Set a 1/2" steel rod.  
I replaced the 1/2" steel rod with a 4" X 36" concrete monument with aluminum disc stamped "Macomb County Monument MI. Act # 345, PC 011, 28408".

**WITNESSES:**

S.29°W. 88.21' Set Mag nail w/Macomb County Witness tag in northwest face of 15" Poplar.  
N.80°W. 16.87' Set Mag nail w/Macomb County Witness tag in north face of 8" Poplar (northern most tree of group of 8).  
S.65°E. 47.73' Set 1/2" steel rod w/Control Cap at base of slope from westbound I-94 and west of "Adopt-a-Highway" sign.  
N.10°E. 133.93' Set 1/2" steel rod w/Control Cap at base of slope from exit ramp "Metro Parkway" opposite "Bridge May be icy" sign.

THE SELECTED LOCATION IS ACCEPTED BY ME AND IS GENERALLY ACCEPTED BY PROFESSIONAL SURVEYORS AS THE BEST AVAILABLE EVIDENCE OF THE POSITION OF THE ORIGINAL CORNER.

ACCEPTED BY THE MACOMB COUNTY SURVEY PEER GROUP AS THE OFFICIAL CORNER UNDER MICHIGAN PUBLIC ACT 345 OF 1990 AT A MEETING HELD ON 9-18-07  
Martin C. Dunn  
MARTIN C. DUNN, P.S. CHAIRMAN

Signed by Steven E. Dunn Date October 23, 2007  
Surveyor's Michigan License No. 28408

2

For corners in

MACOMB Located in: Corner Code #  
(County) HARRISON TWP.

1. Public Land Survey T 2N R 14E PC-011  
T   R

5. Private Claims PC-011, Southwest Corner of Private Claim 601 Common with a Corner of Fractional Section 25

A. Description of original monument and accessories and/or subsequent restoration:

- |                          |  |               |
|--------------------------|--|---------------|
| 1. Elm Tree              | GLO Survey -- Aaron Greeley                        | July 18, 1810 |
| 2. 1/2" X 18" iron stake | Plat, "John Campau Subdivision No. 1", L. 5, P. 48 | July 20, 1921 |
| 3. N/A                   | Plat, Supervisors Plat No. 1, L. 15, P. 46 & 47    | May 21, 1931  |
| 4. N/A                   | Plat, Campau Lane Subdivision, L. 77, P. 45 & 46   | May 1, 1991   |

B. Description of corner evidence found and/or method applied in restoring or reestablishing corner:  
PC 011 Southwest Corner of Private Claim 601 also being a corner of Fractional Section 25. Set a 1/2" steel rod.

**FIELD MEASUREMENTS AND RECORD MEASUREMENTS:**

**PC 011 to Southwest Corner of Private Claim 229:**

649.44' - Record, GLO (9 chains, 84 links).  
599.05' - Field.

**Angle Southwest Corner Private Claim 229/PC 011/Westerly Corner of Lot No. 49, "John Campau Subdivision No. 1":**

125°00'00" - Record, GLO.  
124°48'36" - Field.

**MACOMB COUNTY**  
**INDEX OF SUPPORTING DOCUMENTATION FOR**

**Town 2 North, Range 14 East**

**Harrison Township**

**Corner Code: PC 011 Northwest Corner of Private Claim 601 common with a corner for Fractional Section 25.**

**Section One:**

- A. Index
- B. Pictures
  - 1. Before Pictures - August 6, 2007
  - 2. After Picture

**Section Two:**

- A. Preliminary LCRC – July 28, 2007
- B. Surveyor's Report – July 27, 2007

**Section Three:**

- A. Field Notes
  - 1. February 28, 2007 (2)
  - 2. August 6, 2007
- B. Legal Description – N/A
- C. Tax Description – N/A
- D. Sketches - July 27, 2007
- E. Maps
  - 1. GLO Map (2) – Town 2 North, Range 14 East, Harrison Township.
  - 2. Standard Atlas of Macomb County (1875) – Map of Harrison Township
  - 3. Standard Atlas of Macomb County (1895) – Map of Harrison Township
  - 4. Standard Atlas of Macomb County (1916) – Map of Harrison Township
- F. Full size Composite Maps (4) – 11-24G and H, 11-25CN and DN (2005)

**Section Four:**

- A. Copies of original government notes  
Aaron Greeley – July 18, 1810 - Elm tree
- B. Recorded LCRC's – N/A
- C. Recorded and unrecorded surveys – N/A
- D. Copies of all items listed in "Part A" of LCRC.  
Plats
  - 1. Campau Lane Subdivision – L. 77, Page 45 & 46      May 1, 1991
  - 2. Supervisors Plat No. 1 – L. 15, P. 46 & 47      May 21, 1931
  - 3. "John Campau Subdivision No. 1" – L. 5, P. 48      July 20, 1921

**Survey Report**  
**PC 011**  
**Southwest Corner PC 601**  
**Common with a Corner of Fractional Section 25**  
**T.2N., R.14E., Harrison**

**Letters asking for unrecorded information were sent to:**

AEW, Inc. – Shelby Twp.  
Fenn & Associates, Inc. - Shelby Twp.  
GWE – Rochester Hills  
Kennedy Surveying, Inc. - Oxford  
Lehner Associates, Inc. – Clinton Twp.  
GLA Surveyor – Plymouth  
Professional Engineering Assoc. Inc. – Troy  
R. J. Donnelly & Associates Inc. – Troy  
George Jerome & Company – Roseville  
King Surveying, Inc. – Armada  
Michigan Surveying Inc. – Livonia  
David C. Adams & Son – Redford  
Urban Land Consultants – Shelby Township

**GENERAL:** Traverse points were set and points located then tied in with a Leica System 500 GPS unit. Corners from previous years were shot also and used to apply a scale factor to match the coordinates of the existing corners. Points not able to locate by GPS were side-shot off previously located points with a Leica TCA1103 Electronic Theodolite.

**CORNER:** PC 011 Southwest Corner of Private Claim 601 also being a corner of Fractional Section 25. No evidence of original corner found. "John Campau Subdivision No. 1", as recorded in Liber 5 of Plats, Page 48, shows the line common with Private Claim 601 and Fractional Section 25 as being the rear of Lots 49 thru 79, yet makes no reference the corner. "Campau Lane Subdivision", as recorded in Liber 77 of Plats, Page 45 & 46, begins at the easterly corner of Lot No. 49 of said "John Campau Subdivision No. 1" and has a tie from the southwest corner of Private Claim No. 229 with a call along the line common with Private Claim No. 601 and Private Claim No. 173. I entered the calls for said "Campau Lane Subdivision" from the southwest corner of Private Claim No. 229 then rotated it around the southwest corner of Private Claim No. 229 to match my coordinate base for the line common with Private Claim No. 601 and Private Claim No. 173. I then set a point at the westerly corner of said Lot No. 49 on the line common with said Lot No. 49 and Lot No. 1 of said "Campau Lane Subdivision" the record distance of said Lot No. 49, being the line common with Private Claim 601 and Fractional Section 25. I then did a line-line intersection from this point and the southwest corner of Private Claim 229 to re-establish the location of the corner and set a ½" steel rod. Corner falls in the grassy area between the westbound I-94 exit ramp for Metropolitan Parkway, the entrance ramp from Metropolitan Parkway to westbound I-94 and the westbound lanes of I-94.

**OBSERVATIONS:** Field measurement from PC 011 to the southwest corner of Private Claim 229 is 599.05'. GLO measurement is 649.44' (9 chains, 84 links).

Angle southwest corner Private Claim 229/PC 011/Westerly corner of said Lot No. 49 field measures 124°48'36". 125°00'00" record, GLO.

**RECOMMENDATION:** My recommendation to the Peer Review Board is to accept the ½" steel rod as the proper location for the corner.

*Respectfully submitted,*

---

Steven E Dunn, PS #28408

---

MACOMB Co. REMON 8-5-07

SUNNY 80°

534-29

AD  
TR  
G

STA	HORIZ	DIST.	DESC.
K-501		509.926 (4)	TP
B5-500	0-00-00		TP
FS-314	56° 51' 40"	151.629	PCD11
Witness 1	20-49-32	141.249	my W
2	54-28-46	134.809	my W
3	61-15-31	127.470	my W
4	14-52-57	208.069	LE. TCA 2

WITNESS 1: SET PK NAIL W/ WASHER IN N.W. FACE OF 15" TREE, POPLAR (STANDS ALONE)

WITNESS 2: SET PK NAIL W/ WASHER IN NORTH FACE OF 8" TREE, POPLAR (TREE GROUP OF 6)

WITNESS 3: SET IRON ROD W/ CAP AT BASE OF HILL FROM WEST BOUND I-94 AND DIRECTLY DOWN FROM 'ADOPT-A-HIGHWAY' SIGN.

WITNESS 4: SET IRON W/ CAP AT BASE OF HILL FROM EXIT RAMP, METRO PARKWAY AND DIRECTLY DOWN FROM 'BRIDGE MAY BE ITY' SIGN ON WEST BOUND I-94.

FEB 28, 2007 FB-520

TG  
RD  
DD

GPS  
FILE

MAIL

ARMY E-94 2 10-11-16  
ON

HARRISON TWP  
MARCUMB

07-100

1061 SET MAG IN CONC DRIVE  
12' SOUTH OF CROCKER E/RD  
O HSE # 24888

1062 SET MAG 10' & WALK ON NORTH  
SIDE OF CROCKER NEAR HYD  
HSE #  
24838

1065 SET MAG IN ASPH @ END OF  
CUL-DE-SAC ON SAINT PAUL BLVD  
8' OFF EAST OF ASPH EDGE  
8' SOUTH OF N. END OF GUARD

1066 SET MAG NAIL IN ASPH 6' NORTH  
OF SOUTH EDGE OF ROAD  
24766 SAINT PAUL BLVD

1072 SET  
MAG NAIL IN ASPH PARKING  
300' WEST OF CROCKER

1073 SET 1/2" IR WITH IR BAG CLAP

ALONG PC 10' EAST OF ON  
PUNTING EDGE  
1074 SET 1/2" IR WITH IR BAG CLAP  
NEAR SIGN 15' EAST OF  
PUNTING EDGE

TC  
RD  
DD

FEB 28, 2007

FB-520

(11)

DATA COLLECTION FILE: 022807TC

W.P.O.B. OF CONWANTIC  
OF WAY MARKET ALONG I-94 N SIDE  
OF CLACKEN

FD CONC MON.

CONC R/W MARKET (FD)

SP 1/2 I.R. # 1652

HARRISON TWP.  
MACOMB

\* RIGHT DIST

16	17	18	19	52	53
K001061	0-00-00	353.913	SET MAG	78-41-39	289.922
05 1062	0-00-00	353.913	SET MAG	FD CONC MON	
52	155-32-22	289.922	CONC RIGHT		
53	104-59-16	284.604	FD 1/2 I.R.		

18	19	54	55	56	57	58
* Right DIST	K001065	0-00-00	325.323	268-28-09	194.000	267-43-32
	05 1066	0-00-00	325.323	CONC R/W MARKET		
	54	104-59-16	284.604			
	55	259-26-28	104.121			
	56	268-28-09	194.000			
	57	267-43-32	194.116			
	58	267-55-45	194.174			


05 ✓  
19  
25 / 10/6 0-0-01 325.324



07-100 HARRISON

PC 011

7-27-2057

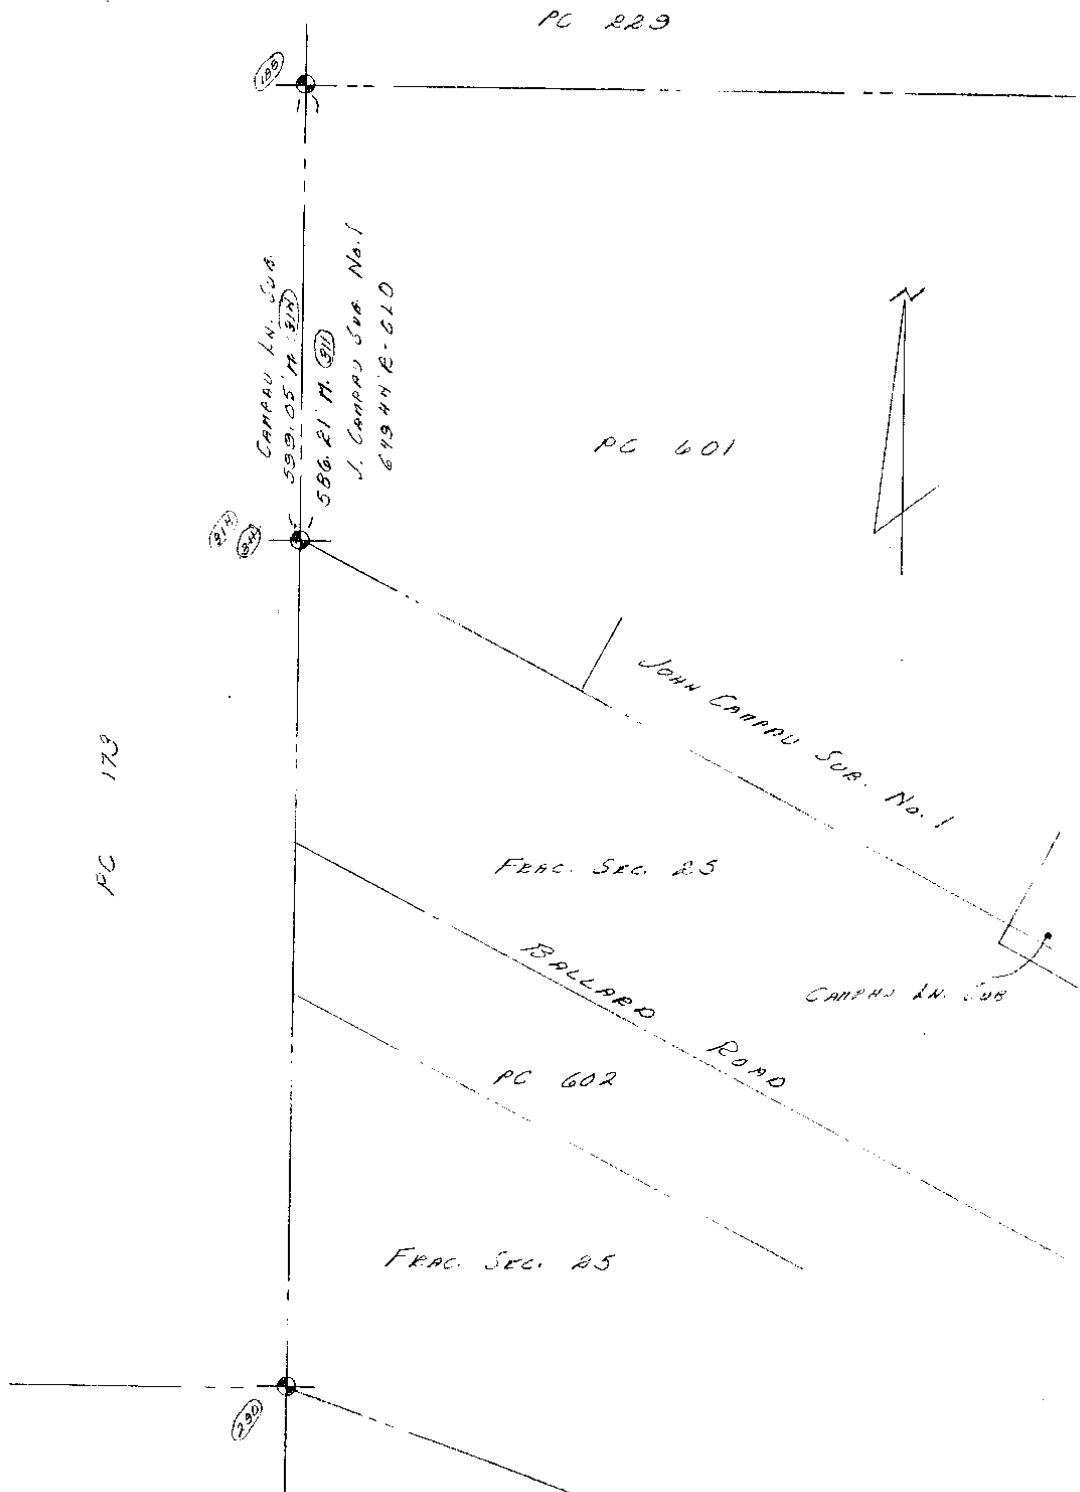



## Survey Details

[? Quick Help](#) [✓ Bookmark](#)

[Home](#) > [Survey Search](#) > [Results List](#) > [Survey Details](#)

[Help](#)
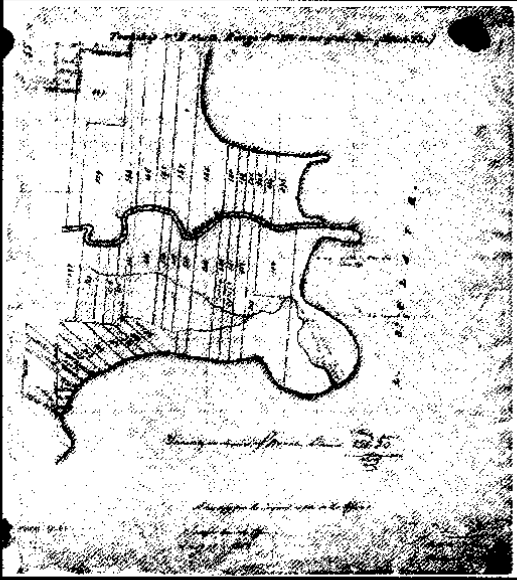
<b>Original Survey</b> • Twp 2N-14E, MI, Michigan - Toledo Strip (Subdiv. Lines)	
<a href="#">Survey Details</a>	<a href="#">Plat Details</a>
<a href="#">Plat Image</a>	<a href="#">Field Note Images</a>
Page 1	Description: —
	
	
<b>zoom view</b>	
<a href="#">Basic Viewer</a> <a href="#">JavaScript Viewer</a> <a href="#">Plug-In Viewer</a> <a href="#">Download Image File</a>	

- **Problems?** Please check our [Browser Compatibility Guide for Image Viewers](#).
- **A Note about printing:** You will not get satisfactory print results from any of our image viewers. For information about printing, check this [Help page](#).



# Survey Details

**Original Survey** • Twp 2N-14E, MI, Michigan - Toledo Strip (Subdiv. Lines)


[Survey Details](#)
[Plat Details](#)
[Plat Image](#)
[Field Note Images](#)

Page 1 Description: ---

**zoom view**

[Basic Viewer](#)
[JavaScript Viewer](#)
[Plug-In Viewer](#)
[Download Image File](#)


- **Problems?** Please check our [Browser Compatibility Guide for Image Viewers](#).
- **A Note about printing:** You will not get satisfactory print results from any of our image viewers. For information about printing, check this [Help page](#)

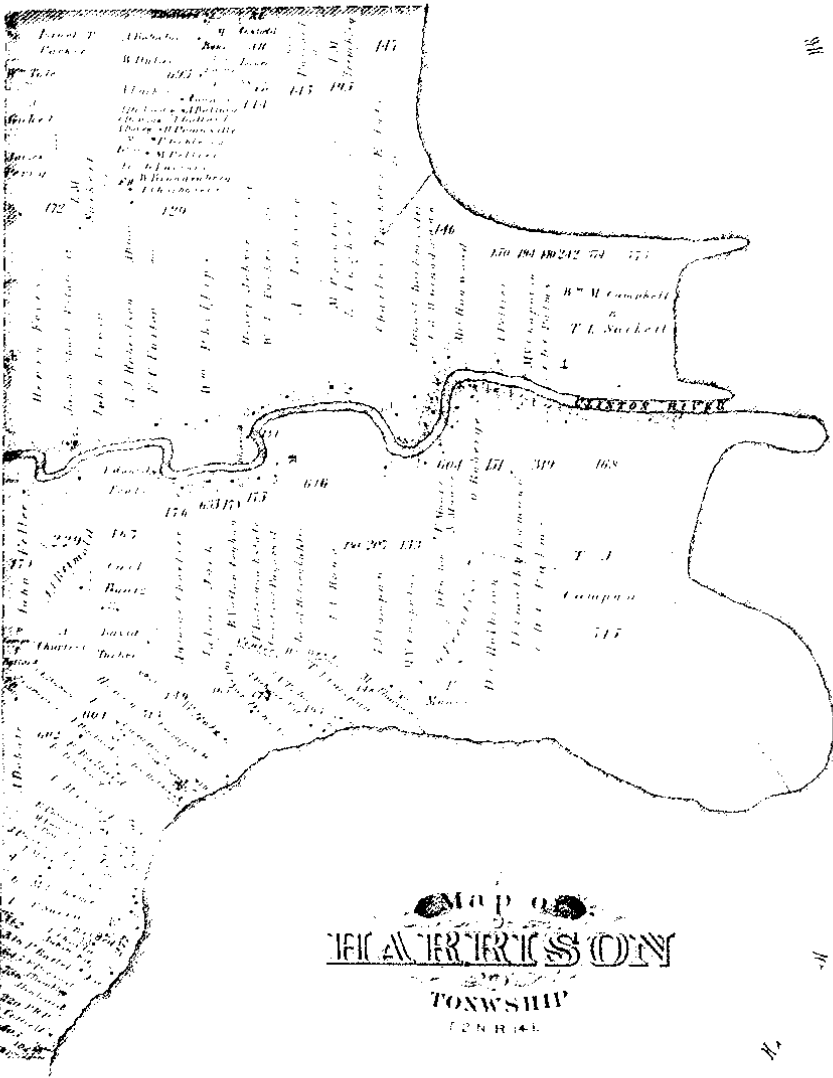


Map of  
**THE AMERICAN TOWNSHIP**  
 TOWNSHIP  
 CONR 141

# MAP OF HARRISON

Township 2 North Range 14 East

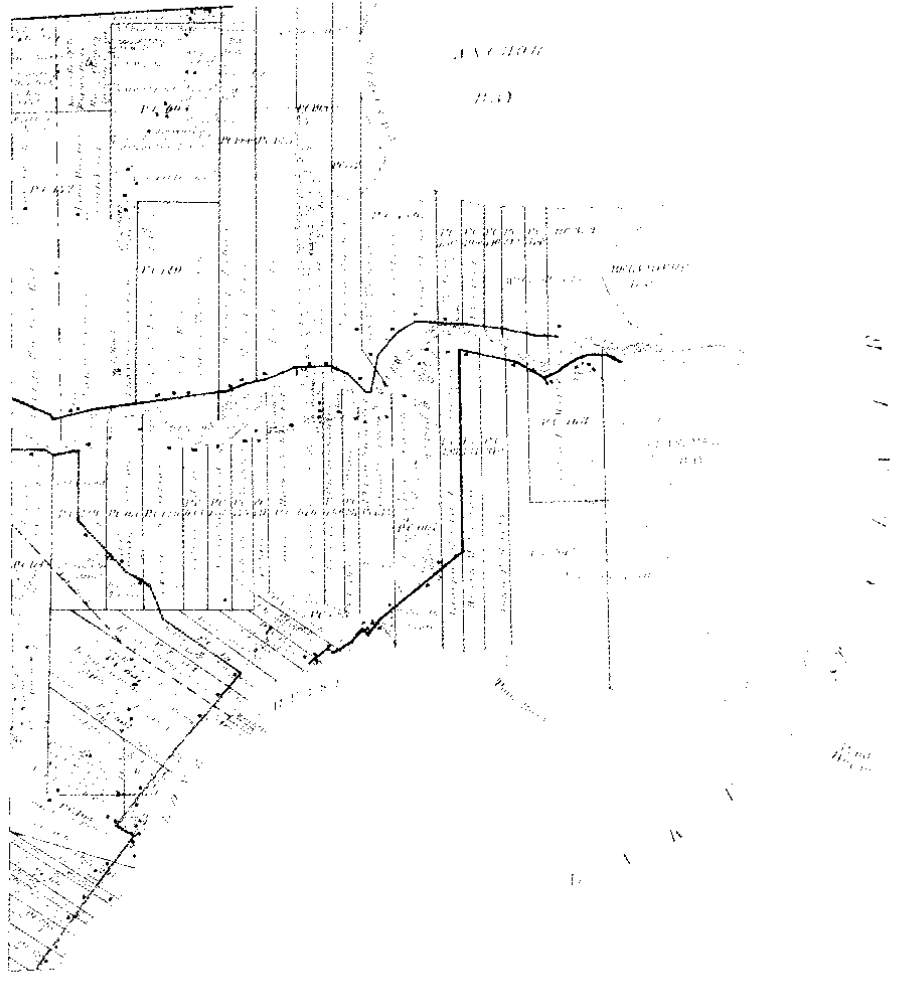

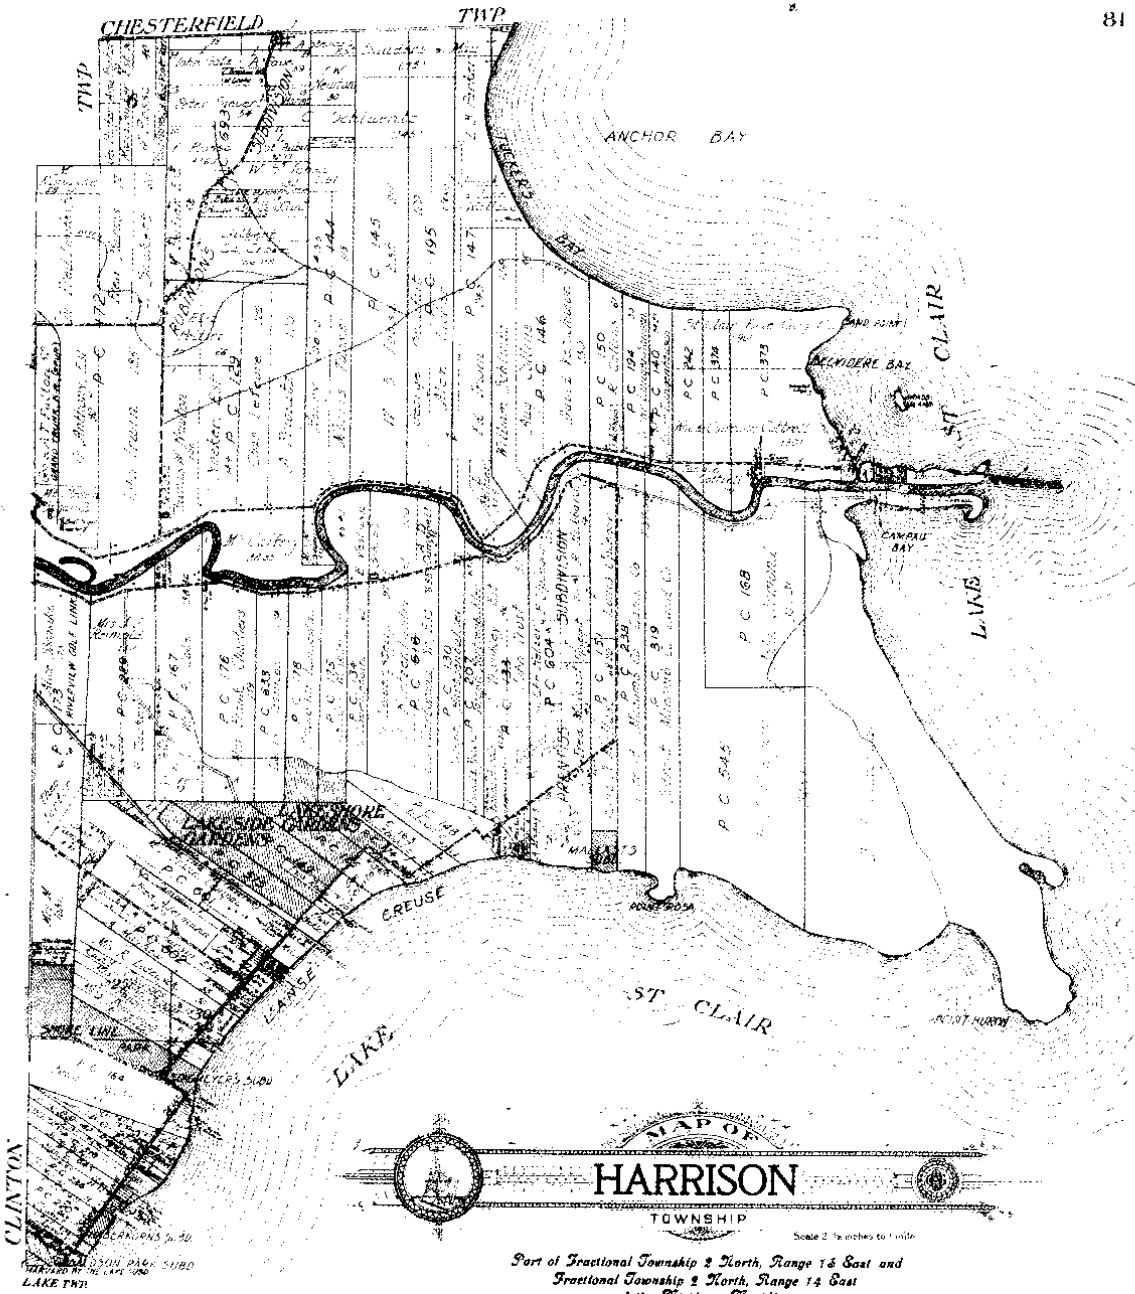

CLINTON

CLINTON PAGE 5100  
DRAWN BY THE LANSING  
LAKE TRUST

# HARRISON

TOWNSHIP

Scale 2 1/2 inches to 1 mile

Part of Fractional Township 2 North, Range 16 East and  
Fractional Township 2 North, Range 14 East  
of the Michigan Meridian

Lake St. Clair

Date	6-25-07	Pages	22
From	Nick Clever		
Co./Dept	OLSR		
Phone #	386-469-1916	Phone #	517 241 6320
Fax #	(586) 469-5130	Fax #	517 241 6301

Post-It® Fax Note 7671

Thirty one chains twelve links, to the place of beginning containing two hundred and seventy seven acres & eighty seven hundredths of an acre  
 Detroit July 18. 1810

Asron Greeley Surveyor  
 of private Claims.

N. 454,, Lake St. Clair  
 Description N. 602 Confirms to Alexis Dubuy commencing at a post standing on the border of Lake St. Clair between this tract and an unceded land, thence north fifty five degrees west seventy two chains twenty seven links, to a post standing on the East line of a tract confirmed to James Abbott on the south side of River - thence north fourteen chains ten links, to a post thence south fifty five degrees East eighty chains thirty six links, to a post standing on the border of Lake St. Clair between this tract & a tract of unceded land, thence along the border of said Lake south thirty five degrees west eleven chains fifty five links, to the place of beginning containing eighty eight acres & seventy two hundredths of an acre.  
 Detroit July 18. 1810

Asron Greeley Surveyor  
 of private Claims.

N. 455,, Lake St. Clair  
 Description N. 601, Confirmed to Jean Baptist Dubuy, commencing

at  
 La  
 a  
 so.  
 ch  
 the  
 lin  
 sin  
 inn  
 -for  
 Ord.  
 -to a  
 ut.  
 son  
 zle  
 pl.  
 her  
 son  
 St  
  
 N  
  
 Lon  
 sta  
 betu  
 -fer  
 von  
 cha  
 this  
 lin  
 we.  
 Ba,  
 deg  
 two

H 07

Lake St. Clair

317

at a post standing on the border of  
 Lake St. Clair between this tract and  
 a tract of unconceded land, thence  
 north fifty five degrees west eighty eight  
 chains sixty two links, to an Elm tree  
 thence north nine chains eighty four  
 links, to a post thence east nine chains  
 ninety six links, to a post the north west  
 corner of a tract confirmed to Louis Sa-  
 forge, thence south fifty five degrees --  
 east eighty nine chains seventy nine links  
 to a post standing on the border of Lake  
 St. Clair thence along the border of  
 said lake south fifty degrees west four-  
 teen chains twenty six links to the  
 place of beginning containing one  
 hundred and twenty seven acres,  
 seventy five hundredths of an acre.

Detroit July 18. 1810

Aaron Greeley Surveyor  
of private claims.


N. 457. Lake St. Clair

Description. N. 513. Confirmed to  
 Louis Saforge, commencing at a post  
 standing on the border of Lake St. Clair  
 between this tract and a tract con-  
 firmed to Jean Baptist Dubuy, thence  
 north fifty five degrees west eighty nine  
 chains seventy nine links, to a post  
 thence east nine chains seventy three  
 links, to a Black Ash tree the north  
 west corner of a tract confirmed to Jean  
 Baptist Paire, thence south fifty five  
 degrees east seventy four chains sixty  
 two links, to a post standing on the



# CAMPAU LANE SUBDIVISION


OF PART OF PRIVATE CLAIM 601 AND FRACTIONAL SECTION 30, T.2N., R.14E., HARRISON TOWNSHIP, MACOMB COUNTY, MICHIGAN.

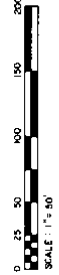

SCALE 1" = 50'

**PLAT LEGEND:**  
ALL DIMENSIONS ARE SHOWN IN FEET.  
ALL LOT MARKERS ARE 1/2" BY 18" IRON BARS.  
THE SYMBOL "X" INDICATES A CONCRETE MONUMENT.  
BEARINGS WERE DETERMINED FROM THE "N.W." LOT LINE OF LOT 35 OF SUPERVISOR'S PLAT NO. 1, LIBER 151, PAGES 48 & 49.

THIS PLAT IS SUBJECT TO RESTRICTIONS AS REQUIRED BY ACT 280 OF 1967, AS AMENDED ON CERTAIN LOTS WITH RESPECT TO THE REQUIREMENTS OF THE MICHIGAN DEPARTMENT OF PUBLIC HEALTH AND THE MICHIGAN DEPARTMENT OF PUBLIC HEALTH, WHICH ARE RECORDED IN LIBER 343.43, PAGE 27.45, OF RECORDS OF THIS COUNTY.

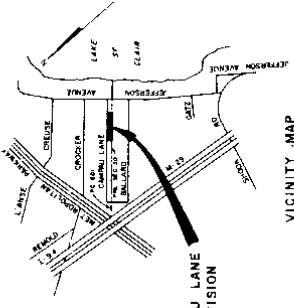

VICINITY MAP  
NOT TO SCALE

1988-01-05  
1988-01-05  
1988-01-05




DATE: JANUARY 21, 1988  
EDWARD PATRICK O'ROURKE  
REGISTERED LAND SURVEYOR NO. 10470  
505 WEST THURSDEN VILLE ROAD  
PULLEY HEIGHTS, MICHIGAN 48871

SURVEYOR'S CERTIFICATE  
I, EDWARD PATRICK O'ROURKE, SURVEYOR, CERTIFY:  
THAT I HAVE SURVEYED, QUANTIFIED AND MARKED THE LAND SHOWN ON THIS PLAT DESCRIBED AS FOLLOWS: CAMPAU LANE SUBDIVISION, OF PART OF PRIVATE CLAIM 601 AND FRACTIONAL SECTION 30, T.2N., R.14E., HARRISON TOWNSHIP, MACOMB COUNTY, MICHIGAN, ACCORDING TO THE SURVEY AND PLAT THEREON, AND THAT THE SAME IS ACCORDING TO THE ACT, AND THAT THE BEARINGS, DISTANCES AND POINTS ARE EXPRESSED AS REQUIRED BY SECTION 126.53 OF THE ACT AND AS EXPLAINED IN THE LEGEND.

THAT THE ACCURACY OF SAID SURVEY, LAND DIVISION, AND PLAT BY THE DIRECTION OF THE DIMENSIONS OF SAID LOTS, THAT SAID PLAT IS A CORRECT REPRESENTATION OF ALL THE EXTERIOR BOUNDARIES OF THE LAND DESCRIBED AND THE SUBDIVISION OF IT, THAT THE BEARINGS, DISTANCES AND POINTS ARE EXPRESSED AS REQUIRED BY SECTION 126.53 OF THE ACT, AND THAT THE BEARINGS, DISTANCES AND POINTS ARE EXPRESSED AS REQUIRED BY SECTION 126.53 OF THE ACT AND AS EXPLAINED IN THE LEGEND.

SECTION	CAMPAU	SUBS	NO. 1	L. S.	P. 43	151	30	37	38	39	40	41	42	43	44	45	46	47	48	49	50
148	149	150	151	152	153	154	155	156	157	158	159	160	161	162	163	164	165	166	167	168	169

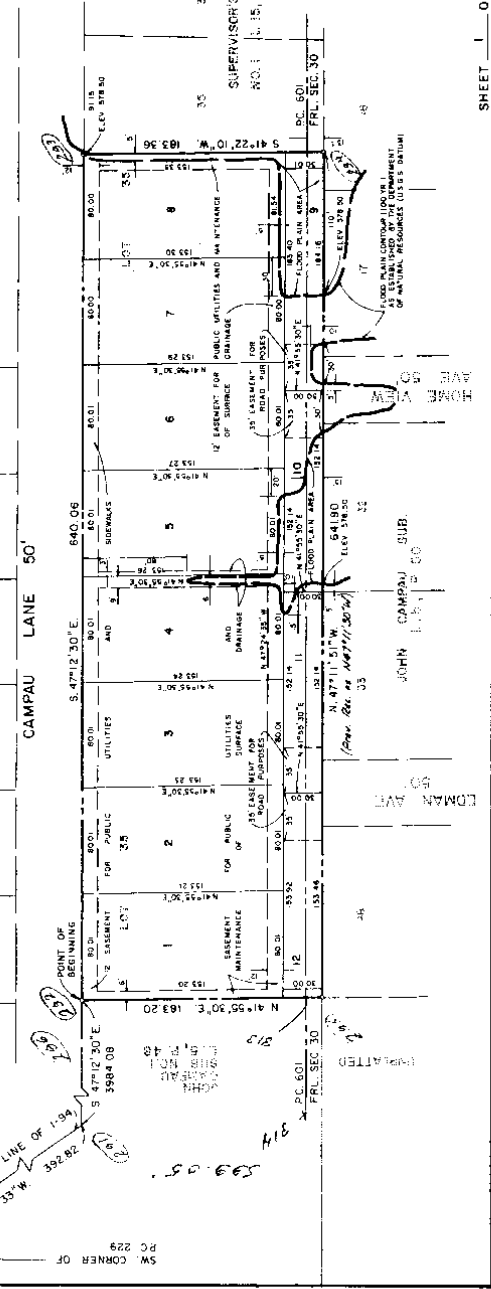

57894

CAMPAU LANE SUBDIVISION  
OF PART OF PRIVATE CLAIM 601 AND FRACTIONAL SECTION 30, T2N, R14E, HARRISON TOWNSHIP MACOMB COUNTY, MICHIGAN

COUNTY TREASURER'S CERTIFICATE

THE PERSONS IN THE OFFICE SHOW NO UNPAID TAXES OR OTHER ASSESSMENTS FOR THE FIVE YEARS PRECEDING THE DATE OF THIS CERTIFICATE.

IN WITNESS WHEREOF, I have hereunto set my hand and the seal of said County at Macomb, Michigan, this 21st day of June, 1984.

AS COMPLYING WITH SECTION 197.5 OF ACT 283, P.A. OF 1981 AND THE APPLICABLE PUBLISHED RULES AND REGULATIONS OF THE BOARD OF ROAD COMMISSIONERS OF MACOMB COUNTY.

APPROVED ON 2-17-84 AS COMPLYING WITH SECTION 193 OF ACT 283, P.A. OF 1981 AND THE APPLICABLE PUBLISHED RULES AND REGULATIONS OF THE BOARD OF ROAD COMMISSIONERS OF MACOMB COUNTY.

JOHN S. HELSH, CHAIRMAN

JOSEPH P. FERRY, COMMISSIONER

CERTIFICATE OF MUNICIPAL APPROVAL

I CERTIFY THAT THIS PLAN WAS APPROVED BY THE BOARD OF THE TOWNSHIP OF HARRISON, MICHIGAN, ON THIS 17th DAY OF JUNE, 1984, IN ACCORDANCE WITH THE PROVISIONS OF ACT 283, P.A. OF 1981 AND THE APPLICABLE PUBLISHED RULES AND REGULATIONS OF THE BOARD OF ROAD COMMISSIONERS OF MACOMB COUNTY.

THE MINIMUM LOT WIDTH AND AREA REQUIRED BY SECTION 193 OF ACT 283, P.A. OF 1981, HAVE BEEN MAINTAINED AND CONFORM WITH THE LEGALLY ADOPTED ZONING AND SUBDIVISION CONTROL ORDINANCES OF THE TOWNSHIP OF HARRISON, MICHIGAN.

APPROVED ON 6-17-84 AS COMPLYING WITH SECTION 193 OF ACT 283, P.A. OF 1981 AND THE APPLICABLE PUBLISHED RULES AND REGULATIONS OF THE BOARD OF ROAD COMMISSIONERS OF MACOMB COUNTY.

JOHN S. HELSH, CHAIRMAN

JOSEPH P. FERRY, COMMISSIONER

PROPRIETORS CERTIFICATE

WE AS PROPRIETORS HEREBY STATE AND PLEDGE THAT WE HAVE CAUSED THE LAND IN THIS PLAN TO BE SURVEYED, DIVIDED, MAPPED, AND DEDICATED AS REPRESENTED ON THIS PLAN AND THAT THE STREETS ARE FOR THE USE OF THE PUBLIC; THAT THE PUBLIC UTILITY EASEMENTS ARE FOR THE USE OF THE PUBLIC; THAT THE PUBLIC UTILITY EASEMENTS ARE NOT TO BE USED FOR RESIDENTIAL CONSTRUCTION UNLESS IN COMBINATION WITH THOSE LOTS AND WILL NOT BE USED FOR RESIDENTIAL CONSTRUCTION UNLESS IN COMBINATION WITH THOSE LOTS.

ATTEST: ANN T. ROBINSON, COUNTY CLERK

ANN T. ROBINSON, COUNTY CLERK

STATE OF MICHIGAN

PERSONALLY AND BEFORE ME THIS 21st day of June, 1984, DONALD C. WILSON, CO-PARTNER AND ASSOCIATE IN INTEREST, DONALD C. WILSON, CO-PARTNER AND ASSOCIATE IN INTEREST, and JOHN S. HELSH, CHAIRMAN OF THE BOARD OF ROAD COMMISSIONERS OF MACOMB COUNTY, TO ME KNOWN TO BE SUCH CO-PARTNERS OF SAID CO-PARTNERSHIP, AND ACKNOWLEDGED THAT THEY EXECUTED CO-PARTNERSHIP, BY ITS AUTHORITY, TO ME KNOWN TO BE SUCH CO-PARTNERSHIP, BY ITS AUTHORITY.

RETAIL PUBLIC OFFICE, MACOMB COUNTY, MICHIGAN

PROPRIETORS CERTIFICATE

WE AS PROPRIETORS HEREBY STATE AND PLEDGE THAT WE HAVE CAUSED THE LAND IN THIS PLAN TO BE SURVEYED, DIVIDED, MAPPED, AND DEDICATED AS REPRESENTED ON THIS PLAN AND THAT THE STREETS ARE FOR THE USE OF THE PUBLIC; THAT THE PUBLIC UTILITY EASEMENTS ARE FOR THE USE OF THE PUBLIC; THAT THE PUBLIC UTILITY EASEMENTS ARE NOT TO BE USED FOR RESIDENTIAL CONSTRUCTION UNLESS IN COMBINATION WITH THOSE LOTS AND WILL NOT BE USED FOR RESIDENTIAL CONSTRUCTION UNLESS IN COMBINATION WITH THOSE LOTS.

ATTEST: ANN T. ROBINSON, COUNTY CLERK

ANN T. ROBINSON, COUNTY CLERK

STATE OF MICHIGAN

PERSONALLY AND BEFORE ME THIS 21st day of June, 1984, ANN T. ROBINSON, COUNTY CLERK, AND JOHN S. HELSH, CHAIRMAN OF THE BOARD OF ROAD COMMISSIONERS OF MACOMB COUNTY, TO ME KNOWN TO BE SUCH CO-PARTNERS OF SAID CO-PARTNERSHIP, BY ITS AUTHORITY, TO ME KNOWN TO BE SUCH CO-PARTNERSHIP, BY ITS AUTHORITY.

RETAIL PUBLIC OFFICE, MACOMB COUNTY, MICHIGAN

RECORDING CERTIFICATE

STATE OF MICHIGAN

THIS DEED WAS RECORDED FOR RECORD ON THE 21st DAY OF JUNE, 1984, AT 8:14 A.M. AND RECORDED IN LIBER 57554 ON PAGES 2 & 3.

RECORDED IN LIBER 57554

RECORDED IN LIBER 57554

CERTIFIED TRUE COPY BY DEPARTMENT OF COMMERCE

BY DEPARTMENT OF COMMERCE

RECORDED IN LIBER 57554

RECORDED IN LIBER 57554



Edward Robert O'Brien



*and level only*

25543  
2nd sheet

SHEET NO. OF 2 SHEETS


# SUPERVISORS PLAT N<sup>o</sup> 1

PART OF FKL SECS 25 & 30 T. 2 N. R. 13 & 14 E. & PART OF P.C.S 149, 513, 601, 173, 229 & 602  
HARRISON TWP.

SCALE 1"=200'

MACOMB CO. MICH.

WALTER J. LENNER, REG. C.E.  
HT. CLEMENS' BLDG.

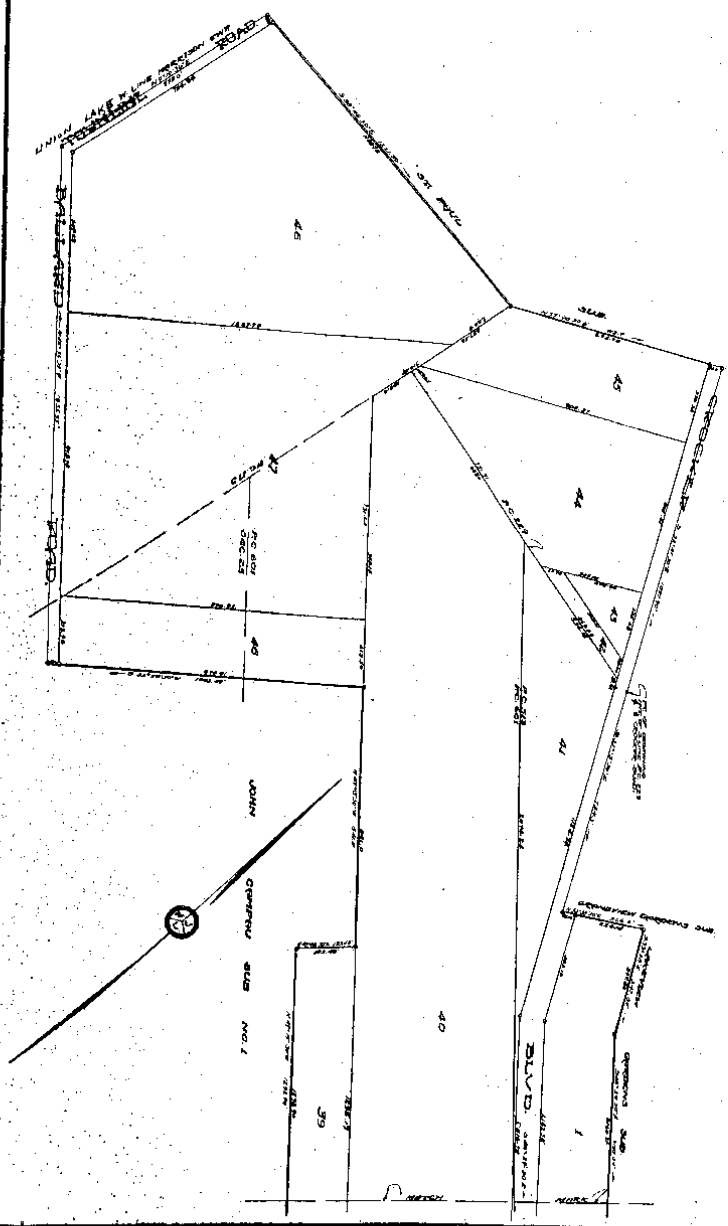


*As struck some  
change see  
V.D.S. 27*

JOHN CAMPAU

July 19 1921  
J. J. S. Hanna

SUBDIVISION No. 1

A PART OF PC 601, T2N R13E & T2N R14E  
HARRISON TOWNSHIP MACOMB CO. MICHIGAN

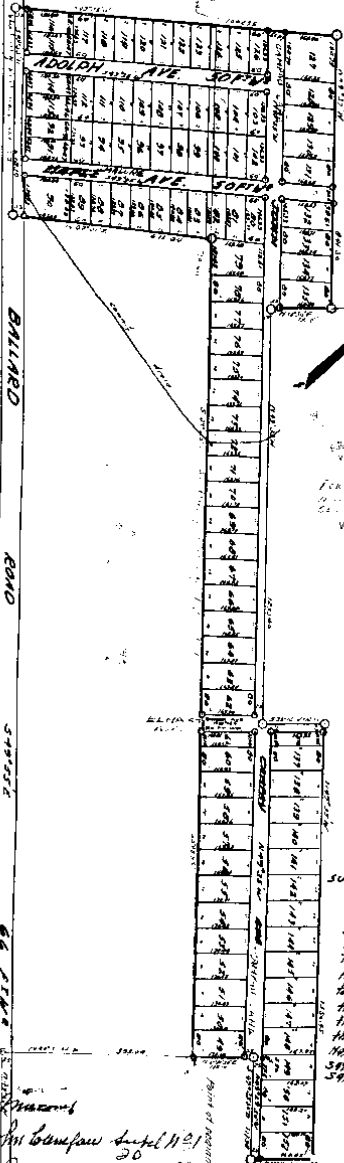

Walker J. Lehar  
Registered Civil Eng.  
H. J. Coleman, Mich.

KNOW ALL MEN BY THESE PRESENTS That we, Mary Campau (widow); George Campau and Edith his wife; Emma Stone; Adolph Campau and Edith his wife; Edmund Campau and Ella his wife; Martha Johnson; Small Campau and Margaret his wife; Bessie Cook; Mary Stone; John Lehar; John Lehar; James Lehar; William Lehar and Mary his wife; John Lehar; Thomas Lehar; William Lehar and Emma his wife; and John Lehar and Emma his wife, the widow and all the heirs at law of John Campau, decedent, do hereby dedicate to the Township of Harrison and State of Michigan...

As proprietors have caused the land embraced in the annexed plat to be surveyed, laid out and plotted, to be known as "JOHN CAMPAU Subdivision No. 1", part of PC 601, T2N R13E and T2N R14E, Harrison Township Macomb Co. Mich and that the streets and alleys as shown on said plat are hereby dedicated to the use of the public in accordance with the provisions of the act in that behalf passed by the Legislature of this State...

STATE OF MICHIGAN  
County of Macomb

On this 21<sup>st</sup> day of April 1921 before me, a Notary Public in and for said county, personally came the above named Mary Campau (widow); George Campau and Edith his wife; Emma Stone; Adolph Campau and Edith his wife; Edmund Campau and Ella his wife; Martha Johnson; Small Campau and Margaret his wife; Bessie Cook; Mary Stone; John Lehar; John Lehar; James Lehar; William Lehar and Mary his wife; John Lehar; Thomas Lehar; William Lehar and Emma his wife; and John Lehar and Emma his wife, the widow and all the heirs at law of John Campau, decedent, all of the County of Harrison and State of Michigan, and known to me to be the persons who executed the above dedication and acknowledged the same to be their free act and deed.

Walter J. Lehar  
Notary Public  
Macomb County, Mich.  
My Commission expires July 19, 1923

Description of Land Plotted  
The Land embraced in the annexed Plat of JOHN CAMPAU, Subdivision No. 1, part of PC 601, T2N R13E and T2N R14E is described as follows: Commencing at the intersection of center line of Jefferson Street and center line of Ballard Road in PC 601, T2N R13E and T2N R14E Harrison Township Macomb County Michigan; thence North 17° 15' 30" W 120.48 ft; thence N 17° 15' 30" W 280.96 ft to the point of beginning; thence N 17° 15' 30" W 175.14 ft; thence S 89° 56' 18" W 120.48 ft; thence S 89° 56' 18" W 280.96 ft; thence S 89° 56' 18" W 175.14 ft; thence S 89° 56' 18" W 120.48 ft; thence S 89° 56' 18" W 280.96 ft; thence S 89° 56' 18" W 175.14 ft to the point of beginning.

This is to certify that the above plat was approved by the Township Board of the Township of Harrison...  
Macomb County, Michigan, at a meeting held on July 19, 1921  
Signed: J. J. S. Hanna, Township CI

I hereby certify that the plat herein delineated is a correct one and that persons claiming to own lots therein to the best of my knowledge and belief are the owners thereof as shown on said plat and as all interests of record are made and shown.

John Campau July 19 1921  
July 20  
21 1921  
John J. Hanna

Walter J. Lehar  
Notary Public  
Macomb County, Mich.  
My Commission expires July 19, 1923

This plat was approved by the Charter Board for Macomb County, Michigan, at a meeting held July 19, 1921  
Signed: J. J. S. Hanna, Township CI