

INDEX
PC-056
SOUTHEAST CORNER P.C. 151
COMMON WITH THE
SOUTHWEST CORNER P.C. 238 ON THE
NORTHERLY SHORELINE OF LAKE ST. CLAIR
HARRISON TOWNSHIP,
T2N, R14E

SECTION 1:

1. Index
2. Before Pictures of Point and in Each Cardinal Direction
3. After Pictures of Point

SECTION 2:

1. LCRC
2. Surveyor's Report
3. Sketch of Private Claims (2 pages) (PC 151, PC 238)
4. Sketch of 2015 Private Claims Overview

SECTION 3:

1. 1818 Original Government Survey map (1 page)
2. 1875 Map of Harrison Township (1 page)
3. 1895 Map of Harrison Township (1 page)
4. 1916 Map of Harrison Township (1 page)
5. 2006 Map of Harrison Township (1 page)
6. 2012 Harrison Township Composite Maps (5 pages; 12-16B, 12-16F, 12-21B, 12-21E, 12-28A)
7. 2015 Field Notes with Corner Witnesses (1 page)
8. Undated Addressograph Department drawing (1 page)

SECTION 4:

- | | | | |
|----------|------------------------------|---|------------------------------|
| 1. 1810 | Original Private Claim Notes | Aaron Greeley | (4 pages, 2 Orig, 2 Transc.) |
| 2. 1905 | "Mallast's Sub." | L.M. Sachett Surveyor | L.2, P.92 |
| 3. 1916 | "Riverside-Bay Gardens" | E.B. Williams | L.3, P.23 |
| 4. 1921 | "Mallast's Sub. No. 1" | Walter J. Lehner #123 | L.5, P.78 |
| 5. 1926 | "Warren Park Sub." | H.F. Cushing Reg. Surveyor | L.10, P.56 |
| 6. 1934 | "S.P. #5" | Walter J. Lehner #123 | L.16, P.26 |
| 7. 1937 | "S.P. #11" | Walter J. Lehner #123 | L.18, P.8 |
| 8. 1937 | "Mallast's Sub. No. 2" | Walter J. Lehner #123 | L.18, P.9 |
| 9. 1953 | Plat of Survey | Walter J. Lehner & Sons | Unrecorded |
| 10. 1957 | "Rhees Sub." | Ernest L. Pettingill
Reg. Land Surveyor,
Prof. Engineer | L.39, P.39 |
| 11. 1977 | Sketch of Survey | Lehner Associates, Inc. | Unrecorded |

Your work never ends

Page 1 of 3

PC - 056

REFERENCE MONUMENT

S.E. Corner of PC 151 common with S.W.
corner of PC 238 on the Northerly shoreline of
Lake St. Clair

T.2N.,R.14E. Harrison Twp.



Your work order confirmation


Page 3 of 3

PC – 056

REFERENCE MONUMENT

**S.E. Corner of PC 151 common with S.W.
corner of PC 238 on the Northerly shoreline of
Lake St. Clair**

T.2N.,R.14E. Harrison Twp.




PC - 056

**S.E. Corner of PC 151 common with S.W.
corner of PC 238 on the Northerly shoreline of
Lake St. Clair**

T.2N.,R.14E. Harrison Twp.

N

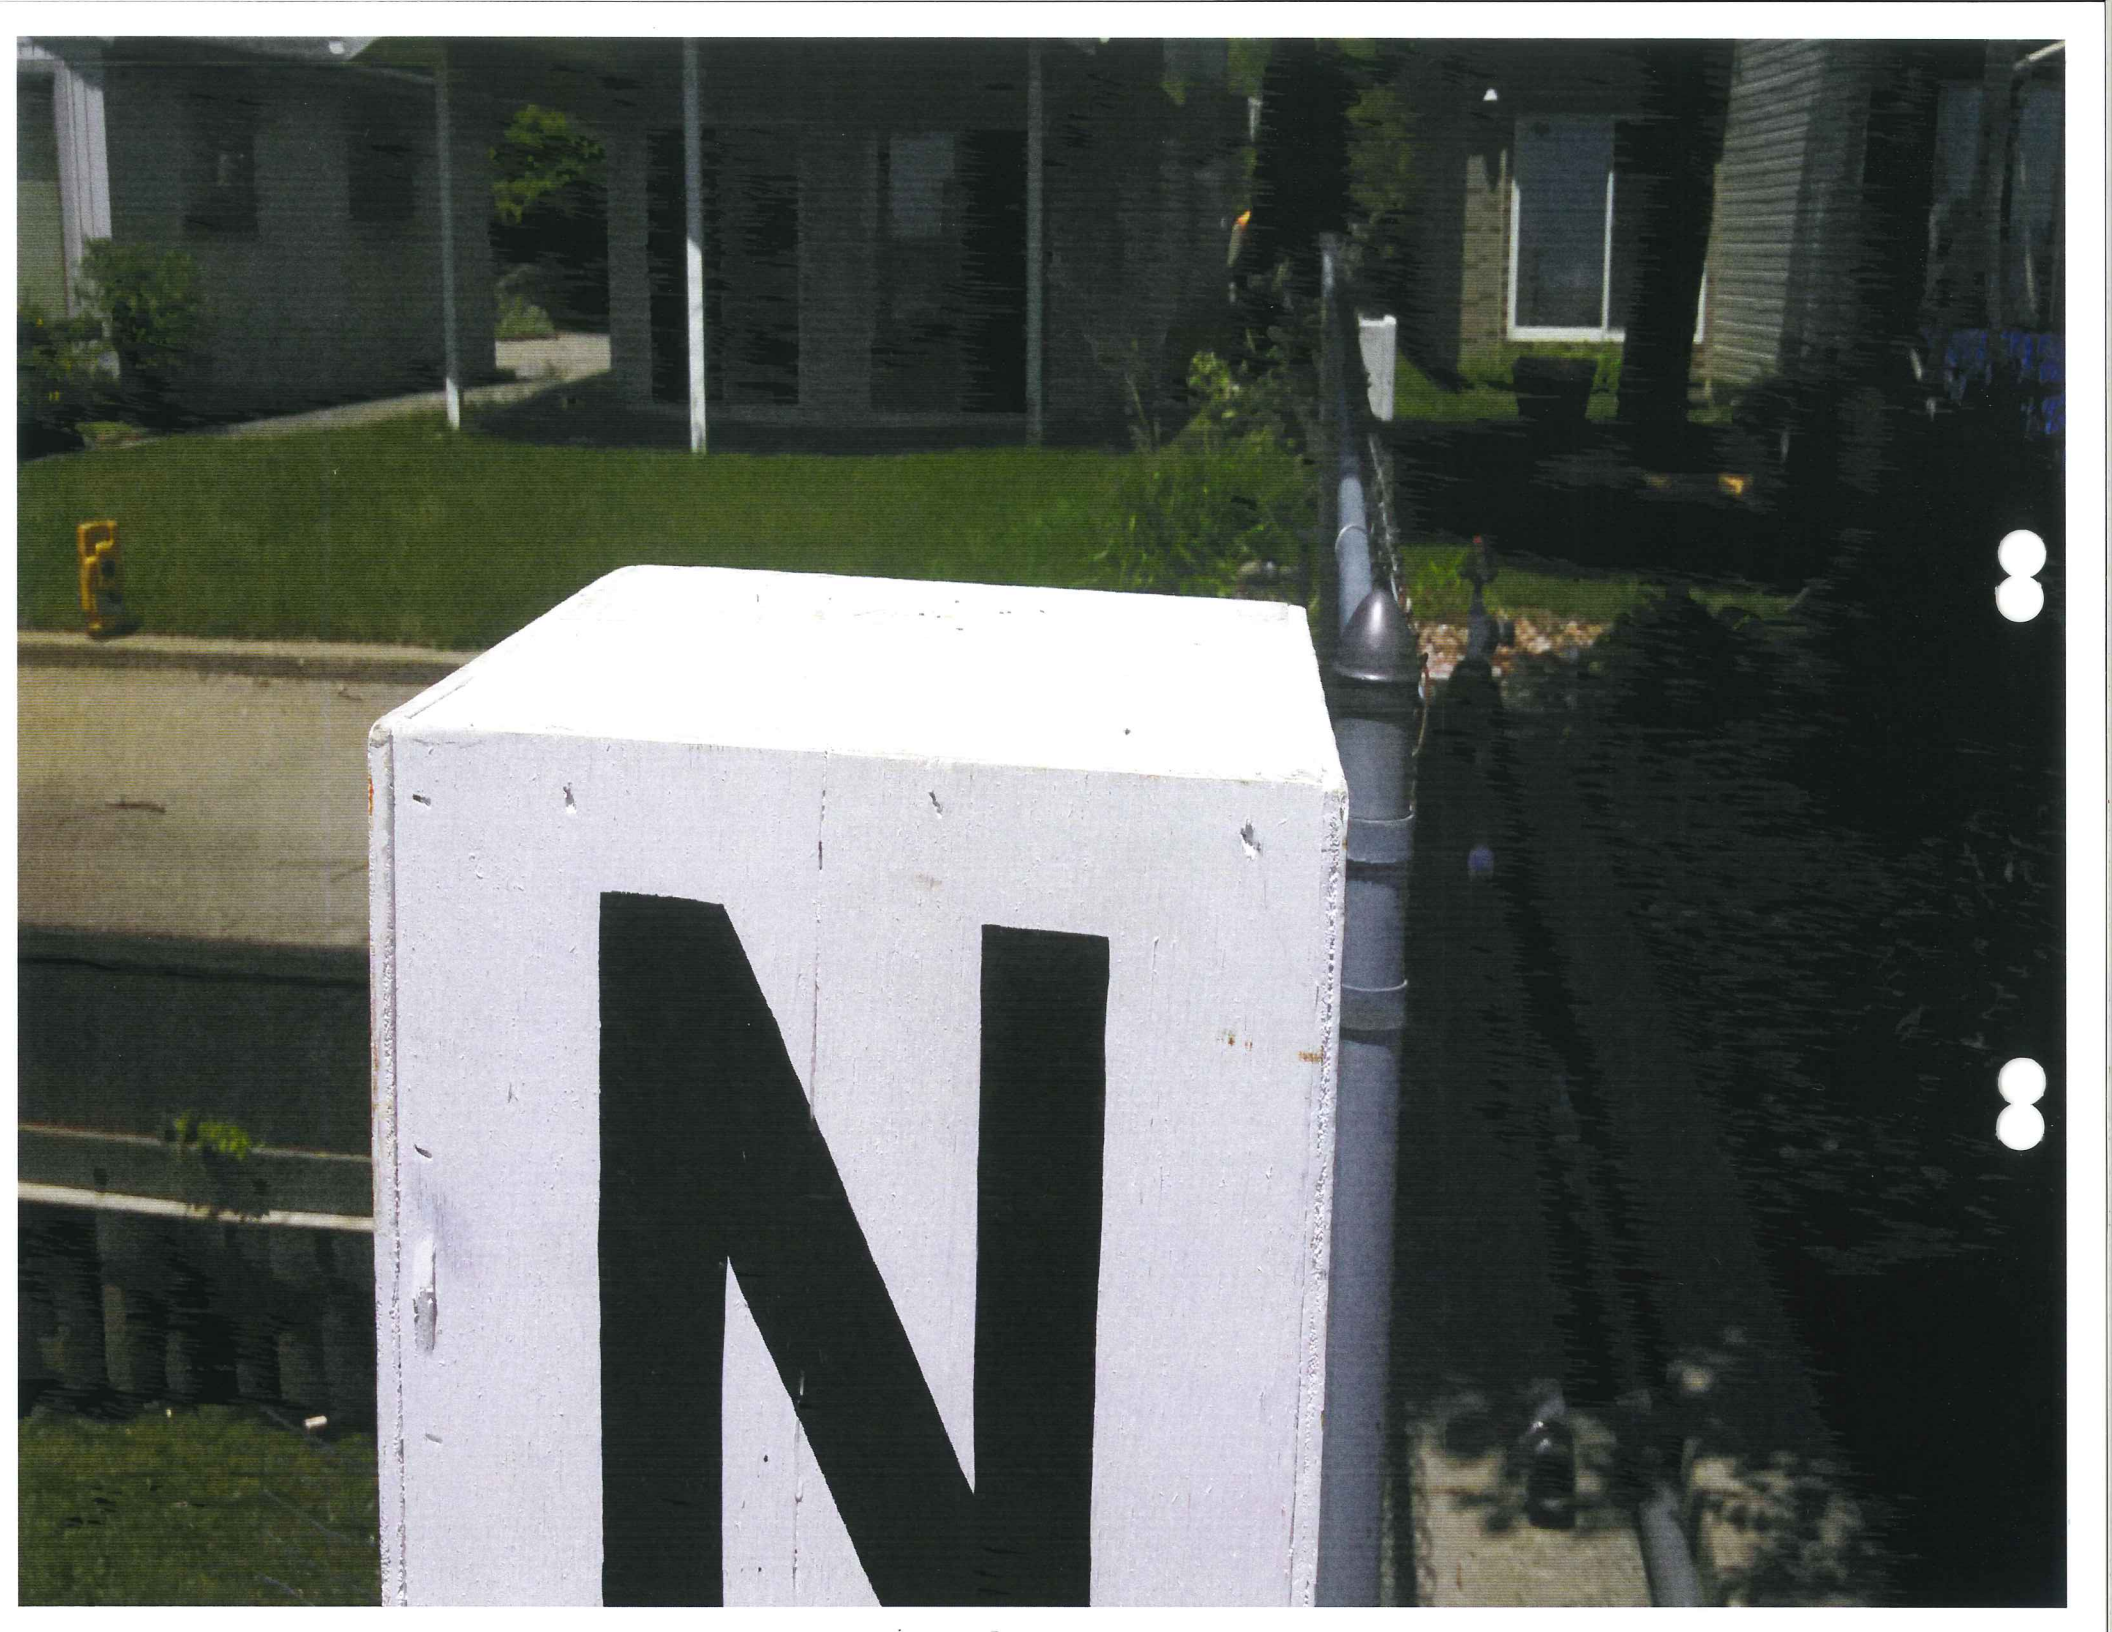







Land Corner Recordation Certificate
Attachment B to 2015 Annual Grant Agreement
 Authority: MCL 54.205 and R54.202

This form is **ONLY** for corners filed under the 2015 State Survey and Remonumentation Grant Agreement

Filing Requirement: MCL 54.268(2)(a), 54.268(2)(d), 54.201 – 54.210d and 2015 State Survey and Remonumentation Grant Agreement


Notes:

- No more than two Original Public Land Survey Corners can be recorded on this certificate
- If a corner reported hereon is common to two or more survey townships, each Town, Range and Corner Code for the corner may be identified on this certificate
- If a corner reported hereon is common to two or more counties, each county may be identified on this certificate and a copy of this certificate filed with the Register of Deeds in each county

For corner in: Macomb County

Harrison Township

Corner Type	Survey Township		Corner Code
Original Public Land Survey Corner	T	R	
• MCL 54.202(g)	T	R	PC-056
• MCL 54.262(g)	T	R	
	T	R	
Property Controlling Corner	S	T	R
• MCL 54.202(i)	S	T	R
• MCL 54.262(h)	S	T	R
	S	T	R
Protracted Public Land Survey Corner	T	R	
• MCL 54.202(k)	T	R	
• MCL 54.262(i)	T	R	
	T	R	

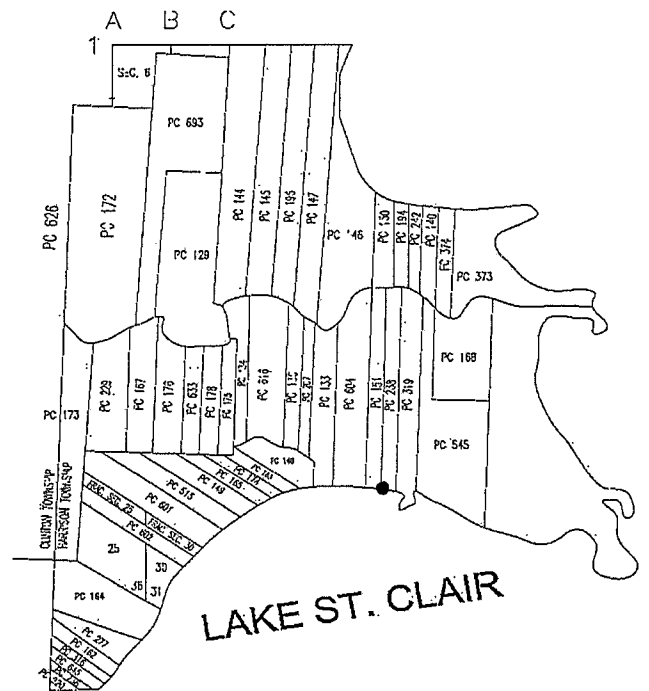

PC-056 Southeast Corner Private Claim 151, common with the Southwest Corner Private Claim 238 on the Northerly shoreline of Lake St. Clair.

Part A: Corner(s) History

1.	1810	Original Private Claim Notes	Aaron Greeley	(2 pages)
2.	1905	"Mallast's Sub."	L.M. Sachett Surveyor	L.2, P.92
3.	1916	"Riverside-Bay Gardens"	E.B. Williams Surveyor	L.3, P.23
4.	1921	"Mallast's Sub. No. 1"	Walter J. Lehner #123	L.5, P.78
5.	1926	"Warren Park Sub."	H.F. Cushing Reg.Surveyor	L.10, P.56
6.	1934	"S.P. #5"	Walter J. Lehner #123	L.16, P.26
7.	1937	"S.P. #11"	Walter J. Lehner #123	L.18, P.8
8.	1937	"Mallast's Sub. No. 2"	Walter J. Lehner #123	L.18, P.9
9.	1953	Plat of Survey	Walter J. Lehner & Sons	Unrecorded
10.	1957	"Rhees Sub."	Ernest L. Pettingill Reg. Land Surveyor, Prof. Engineer	L.39, P.39
11.	1977	Sketch of Survey	Lehner Associates, Inc.	Unrecorded

Land Corner Recordation Certificate
 Attachment B to 2015 Annual Grant Agreement
 T2N R14E Code PC-056

Page 2 of 3

Part B: Surveyor's Report on Perpetuation or Monumentation of Corner(s)

No evidence of the original post was found. I consider it an obliterated corner.

I established the private claim line between Private Claim 151 and Private Claim 238 from found evidence in items 3, 4, 5, 6 and 8.

I extended the established private claim line south to the north shore of Lake St. Clair and cut an "X" on the concrete Lake Shore. Private Claim Line 151/238 is the centerline of Cherry Lane from Metropolitan Parkway south to the north shore of Lake St. Clair as established from items 4 and 8. The north terminus of Private Claim Line 151/238 from Metropolitan Parkway north to the south bank of the Clinton River was established from found evidence in items 3 and 5. No occupation lines east, west or south. There is a 4 foot chain link fence north to Bakeman Street right of way.

Distances:

PC-056 Ref. Mon. to PC-051
 10,233.96' (155 Chains, 6 links Private Claim Notes)
 9,505.59' (Measured 2015)

Private Claim 238 (perpendicular west to east)
 569.58' (8 Chains, 63 Links Private Claim Notes)
 577.28' "Riverside-Bay Gardens Sub."
 577.28' Measured 2015

Private Claim 151 (perpendicular east to west)
 595.32' (9 Chains, 2 links Private Claim Notes)
 596.0' "Mallast's Subdivision No.1"
 596.0' "Supervisor's Plat no. 11"
 595.84' Measured 2015

Part C: Field Evidence of Perpetuation or Monumentation of Corner(s)

I set a 1-1/4" brass cap stamped:
 Macomb County Monument, MI Act 345, 30103, Ref. PC-056.

Witnesses:


EAST 136.82' to the outside corner of a steel seawall
 S30°W 56.84' to the outside corner of a steel seawall
 N35°W 70.30' to S.E. corner of house no. 37786
 N5°W 60.06' to S.E. corner of house no. 37790

Date of Observation	Latitude	Longitude	Datum and Adjustment Year	Epoch Date
Ref. Mon. 8/20/2015	42°34'15.00"	-82°48'38.81"	August 2011	2010
True Cor. 8/20/2015	42°34'07.82"	-82°48'39.26"		

Method for coordinate determination: GPS Survey

Disclaimer on accuracy of values reported relative to their use: +/- 1 foot.


I, Roger J. Stecker, in a field survey on 06/04/2015, certify under the requirements of the State Survey and Remonumentation Act, 1990 PA 345, MCL 54.261 to 54.279, and the Corner Recordation Act, 1970 PA 74, MCL 54.201 to 54.210d, that the corner identified and described hereon has been perpetuated or monumented as described in Parts A, B, and C above, pursuant to the laws and rules of the State of Michigan.

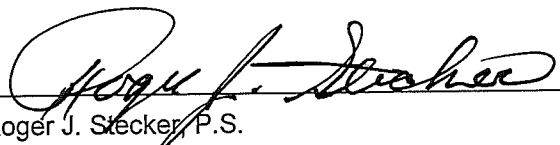
 Roger J. Stecker, P.S.

12-4-2015
 Date

Professional Surveyor's License No.: 30103

Lehner Associates, Inc.
 17001 19 Mile Rd., Suite 3
 Clinton Township, MI 48038

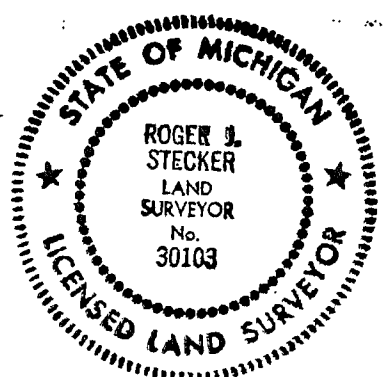

Land Corner Recordation Certificate
Attachment B to 2015 Annual Grant Agreement
T2N R14E Code PC-056

Page 3 of 3

I, Martin C. Dunn, P.S., Macomb County Surveyor Representative, confirm that the corner identified and described hereon and perpetuated or monumented as described in Parts A, B, and C above was presented to and reviewed by the Peer Review Group on November 10, 2015 and is accepted for filing in the Macomb County Remonumentation Program.

Martin C. Dunn

Martin C. Dunn, P.S.

12-8-2015

Date

Professional Surveyor's License No.: 30081

SURVEYOR'S REPORT
PC-056
SOUTHEAST CORNER P.C. 151
COMMON WITH THE
SOUTHWEST CORNER P.C. 238 ON THE
NORTHERLY SHORELINE OF LAKE ST. CLAIR
HARRISON TOWNSHIP,
T2N, R14E

GLO HISTORY:

Description of P.C. 151

Confirmed to Francois St. Obin commencing at a post standing on the border of River Huron, between this tract and a tract confirmed to Louis Chapoton Junior thence south one hundred and fifty five chains six links to a post standing on the border of Lake St. Clair thence along the border of said Lake west nine chains two links to a post the south east corner of a tract confirmed to Joseph Campeau thence north one hundred and fifty seven chains sixty three links to a post standing on the border of River Huron thence along the border of said River down stream south seventy degrees east seven chains twenty eight links, thence south eighty eight degrees east two chains eighteen links, to the place of beginning, containing one hundred and thirty nine acres seventy eight hundredths of an acre.

Detroit July 18, 1810

Aaron Greeley Surveyor
of private claims

Description of P.C. 238

Confirmed to Louis Chapoton Junior commencing at a post standing on the border of River Huron between this tract and a tract confirmed to Joseph Campeau thence south one hundred and fifty four chains sixty links to a post standing on the border of Lake St. Clair thence along the border of said lake west eight chains sixty three links, to a post the south east corner of a tract confirmed to Francois St. Obin thence north one hundred and fifty five chains six links to a post standing on the border of River Huron thence along the border of said river down stream south eighty eight degrees east six chains thirty five links thence south eighty three degrees east two chains thirty links to the place of beginning, containing one hundred and thirty four acres forty nine hundredths of an acre.

Detroit July 18, 1810

Aaron Greeley Surveyor
of private claims

EXISTING CONDITIONS:

No evidence of the original post was found. I consider it an obliterated corner.
I established the private claim line between Private Claim 151 and Private Claim 238 from found evidence in items 2, 3, 4, 5, 6 and 8.
I extended the established private claim line south to the north shore of Lake St. Clair. and cut an "X" on the concrete Lake Shore. Private Claim Line 151/238 is the centerline of Cherry Lane from Metropolitan Parkway south to the north shore of Lake St. Clair as established from items 4 and 8. The north terminus of Private Claim Line 151/238 from Metropolitan Parkway north to the south bank of the Clinton River was established from found evidence in items 3 and 5. No occupation lines east, west or south. There is a 4 foot chain link fence north to Bakeman Street right of way.
I recommend to the Peer Group to accept the cut "x" the best position for a reference monument.

RECORDED & UNRECORDED SURVEYS, & FIELD NOTES:

1.	1810	Original Private Claim Notes Post	Aaron Greeley	(4 pages, 2 Orig., 2 Transc.)
2.	1905	"Mallast's Sub." Shows line only	L.M. Sachett Surveyor	L.2, P.92
3.	1916	"Riverside-Bay Gardens" Shows line only	E.B. Williams Surveyor	L.3, P.23
4.	1921	"Mallast's Sub. No. 1" Shows line only	Walter J. Lehner #123	L.5, P.78
5.	1926	"Warren Park Sub." Shows line only	H.F. Cushing Reg.Surveyor	L.10, P.56
6.	1934	"S.P. #5" Shows point at river, object not stated	Walter J. Lehner #123	L.16, P.26
7.	1937	"S.P. #11" Shows line only	Walter J. Lehner #123	L.18, P.8
8.	1937	"Mallast's Sub. No. 2" Shows line only	Walter J. Lehner #123	L.18, P.9
9.	1953	Plat of Survey Shows line only	Walter J. Lehner & Sons	Unrecorded
	1957	"Rhees Sub." Shows line only	Ernest L. Pettingill Reg. Land Surveyor, Prof. Engineer	L.39, P.39
10.	1977	Sketch of Survey Shows line only	Lehner Associates, Inc.	Unrecorded.

DISTANCES:

PC-056 Ref. Mon to PC-051
10,233.96' (155 Chains, 6 links Private Claim Notes)
9,505.59' (Measured 2015)

Private Claim 238 (perpendicular west to east)
569.58' (8 Chains, 63 Links Private Claim Notes)
577.28' "Riverside-Bay Gardens Sub."
577.28' Measured 2015

Private Claim 151 (perpendicular east to west)
595.32' (9 Chains, 2 links Private Claim Notes)
596.0' "Mallast's Subdivision No.1
596.0' "Supervisor's Plat no. 11"
595.84' Measured 2015



RECOMMENDATIONS:

I set a 1-1/4" brass cap stamped:
Macomb County Monument, MI Act 345, 30103, Ref. PC-056.

WITNESSES: PC-056 CORNER

EAST 136.82' to the outside corner of a steel seawall
S30°W 56.84' to the outside corner of a steel seawall
N35°W 70.30' to S.E. corner of house no. 37786
N5°W 60.06' to S.E. corner of house no. 37790

SKETCH OF PRIVATE CLAIM 151

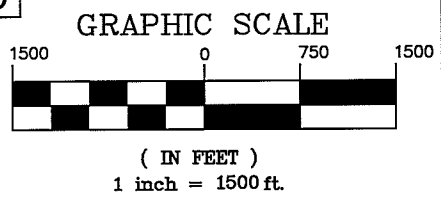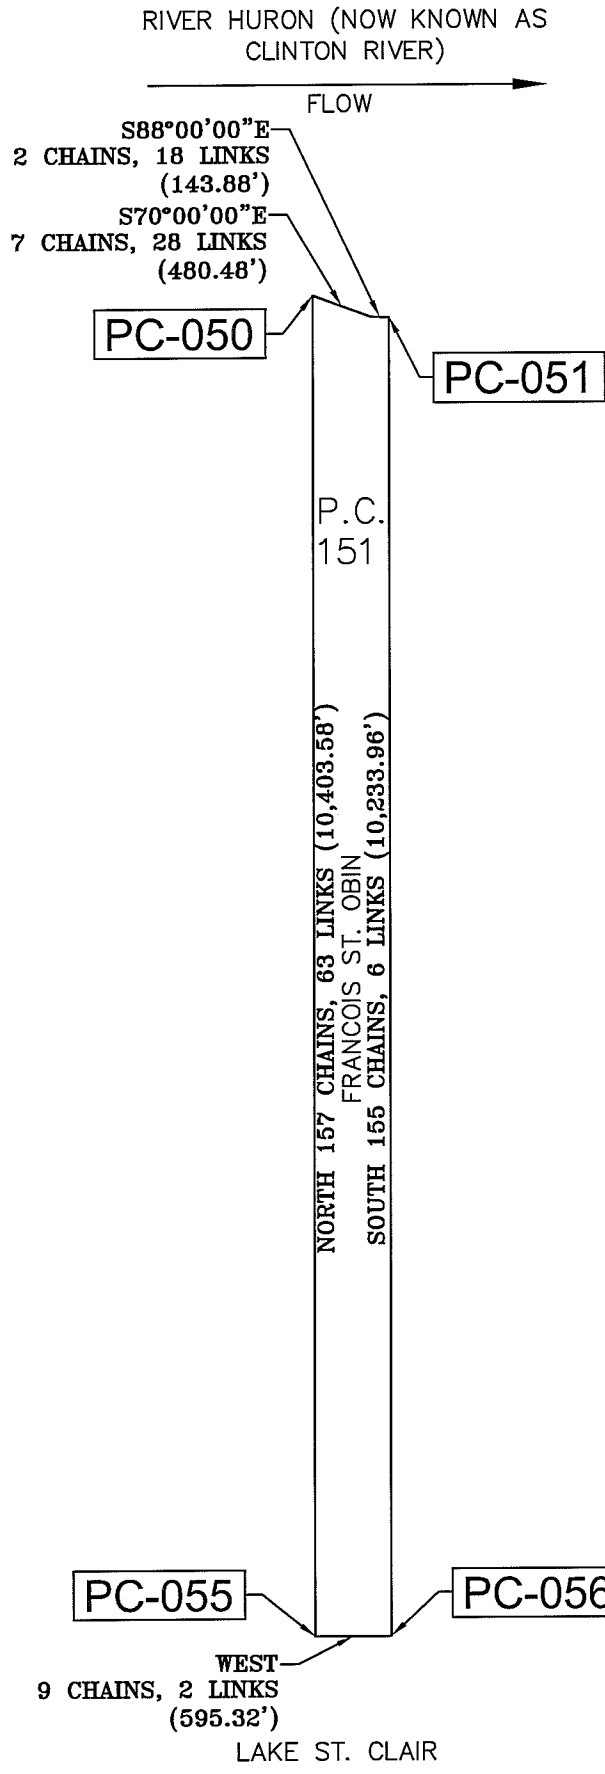

P.C. 151

CONFIRMED TO FRANCOIS ST. OBIN

COMMENCING AT A POST STANDING ON THE BORDER OF RIVER HURON, BETWEEN THIS TRACT AND A TRACT CONFIRMED TO LOUIS CHAPOTON JUNIOR THENCE SOUTH ONE HUNDRED AND FIFTY FIVE CHAINS SIX LINKS TO A POST STANDING ON THE BORDER OF LAKE ST. CLAIR THENCE ALONG THE BORDER OF SAID LAKE WEST NINE CHAINS TWO LINKS TO A POST THE SOUTH EAST CORNER OF A TRACT CONFIRMED TO JOSEPH CAMPEAU THENCE NORTH ONE HUNDRED AND FIFTY SEVEN CHAINS SIXTY THREE LINKS TO A POST STANDING ON THE BORDER OF RIVER HURON THENCE ALONG THE BORDER OF SAID RIVER DOWN STREAM SOUTH SEVENTY DEGREES EAST SEVEN CHAINS TWENTY EIGHT LINKS, THENCE SOUTH EIGHTY EIGHT DEGREES EAST TWO CHAINS EIGHTEEN LINKS, TO THE PLACE OF BEGINNING, CONTAINING ONE HUNDRED AND THIRTY NINE ACRES SEVENTY EIGHT HUNDREDTHS OF AN ACRE.

DETROIT JULY 18, 1810

AARON GREELEY SURVEYOR
OF PRIVATE CLAIMS

SKETCH OF PRIVATE CLAIM 238



RIVER HURON (NOW KNOWN AS CLINTON RIVER)

FLOW

S83°00'00"E
2 CHAINS, 30 LINKS
(151.80')

S88°00'00"E
6 CHAINS, 35 LINKS
(419.10')

PC-051

PC-052

P.C.
238

NORTH 155 CHAINS, 6 LINKS (10,233.96')
LOUIS CHAPOTON, JUNIOR
SOUTH 154 CHAINS, 60 LINKS (10,203.60')

PC-056

PC-057

WEST
8 CHAINS, 63 LINKS
(569.58')

LAKE ST. CLAIR

GRAPHIC SCALE



(IN FEET)
1 inch = 1500 ft.

P.C. 238


CONFIRMED TO LOUIS CHAPOTON, JUNIOR

COMMENCING AT A POST STANDING ON THE BORDER OF RIVER HURON, BETWEEN THIS TRACT AND A TRACT CONFIRMED TO JOSEPH CAMPEAU THENCE SOUTH ONE HUNDRED AND FIFTY FOUR CHAINS SIXTY LINKS TO A POST STANDING ON THE BORDER OF LAKE ST. CLAIR THENCE ALONG THE BORDER OF SAID LAKE WEST EIGHT CHAINS SIXTY THREE LINKS, TO A POST THE SOUTH EAST CORNER OF A TRACT CONFIRMED TO FRANCOIS ST. OBIN THENCE NORTH ONE HUNDRED AND FIFTY FIVE CHAINS SIX LINKS TO A POST STANDING ON THE BORDER OF RIVER HURON THENCE ALONG THE BORDER OF SAID RIVER DOWN STREAM SOUTH EIGHTY EIGHT DEGREES EAST SIX CHAINS THIRTY FIVE LINKS THENCE SOUTH EIGHTY THREE DEGREES EAST TWO CHAINS THIRTY LINKS TO THE PLACE OF BEGINNING, CONTAINING ONE HUNDRED AND THIRTY FOUR ACRES FORTY NINE HUNDREDTHS OF AN ACRE.

DETROIT JULY 18, 1810

AARON GREELEY SURVEYOR
OF PRIVATE CLAIMS

Township N: II North, Range N: XIV East of the Mer. (Mich. Ter.)

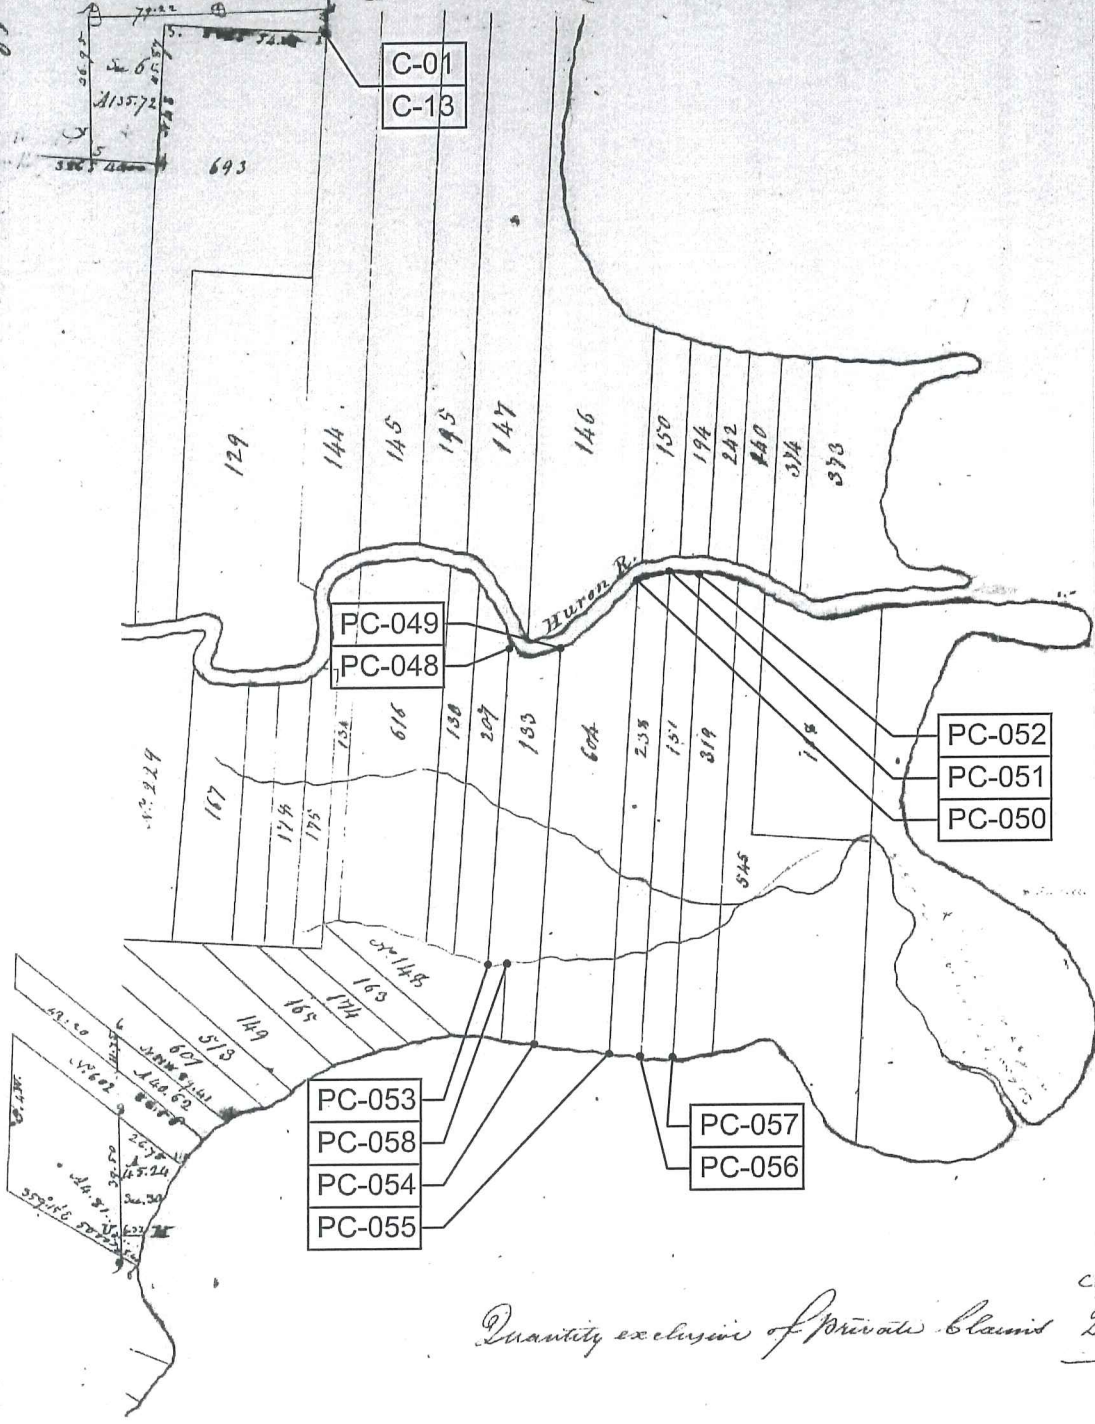

L. S. C. L. A. I. R.


Quantity exclusive of Private Claims 236-39
C. A. H. see
[Signature]

A true Copy from the Original on file in this Office

Surveyor General's Office
July 20 1878

2N, 14E HARRISON

[Signature]
Surveyor

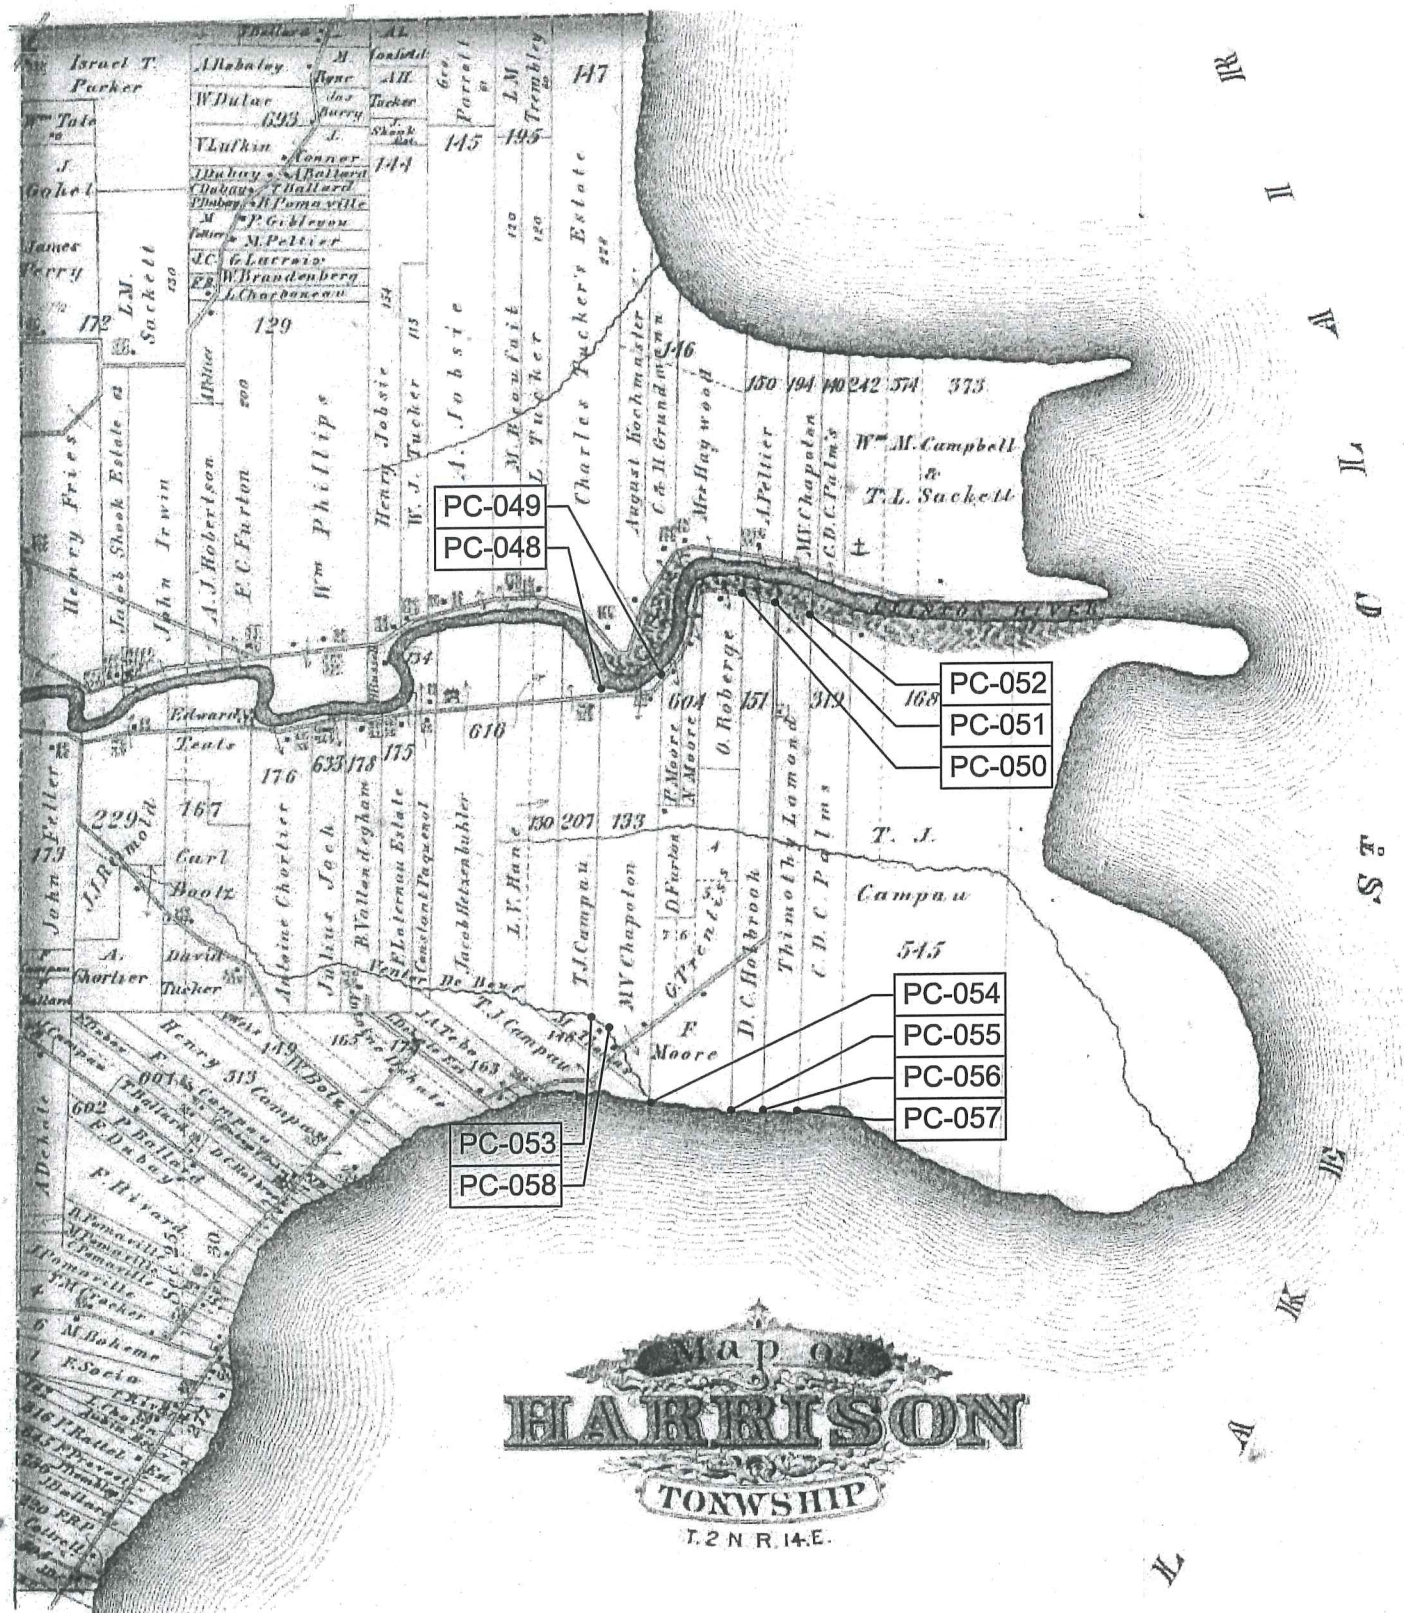

PC-049
PC-048

PC-052
PC-051
PC-050

PC-054
PC-055
PC-056
PC-057

PC-053
PC-058

Map of
HARRISON
TOWNSHIP
T. 2 N. R. 14. E.


1875

HARRISON

Township 2 North Range 14 East

Scale 2 Inches to one Mile

of the Meridian of Montgomery

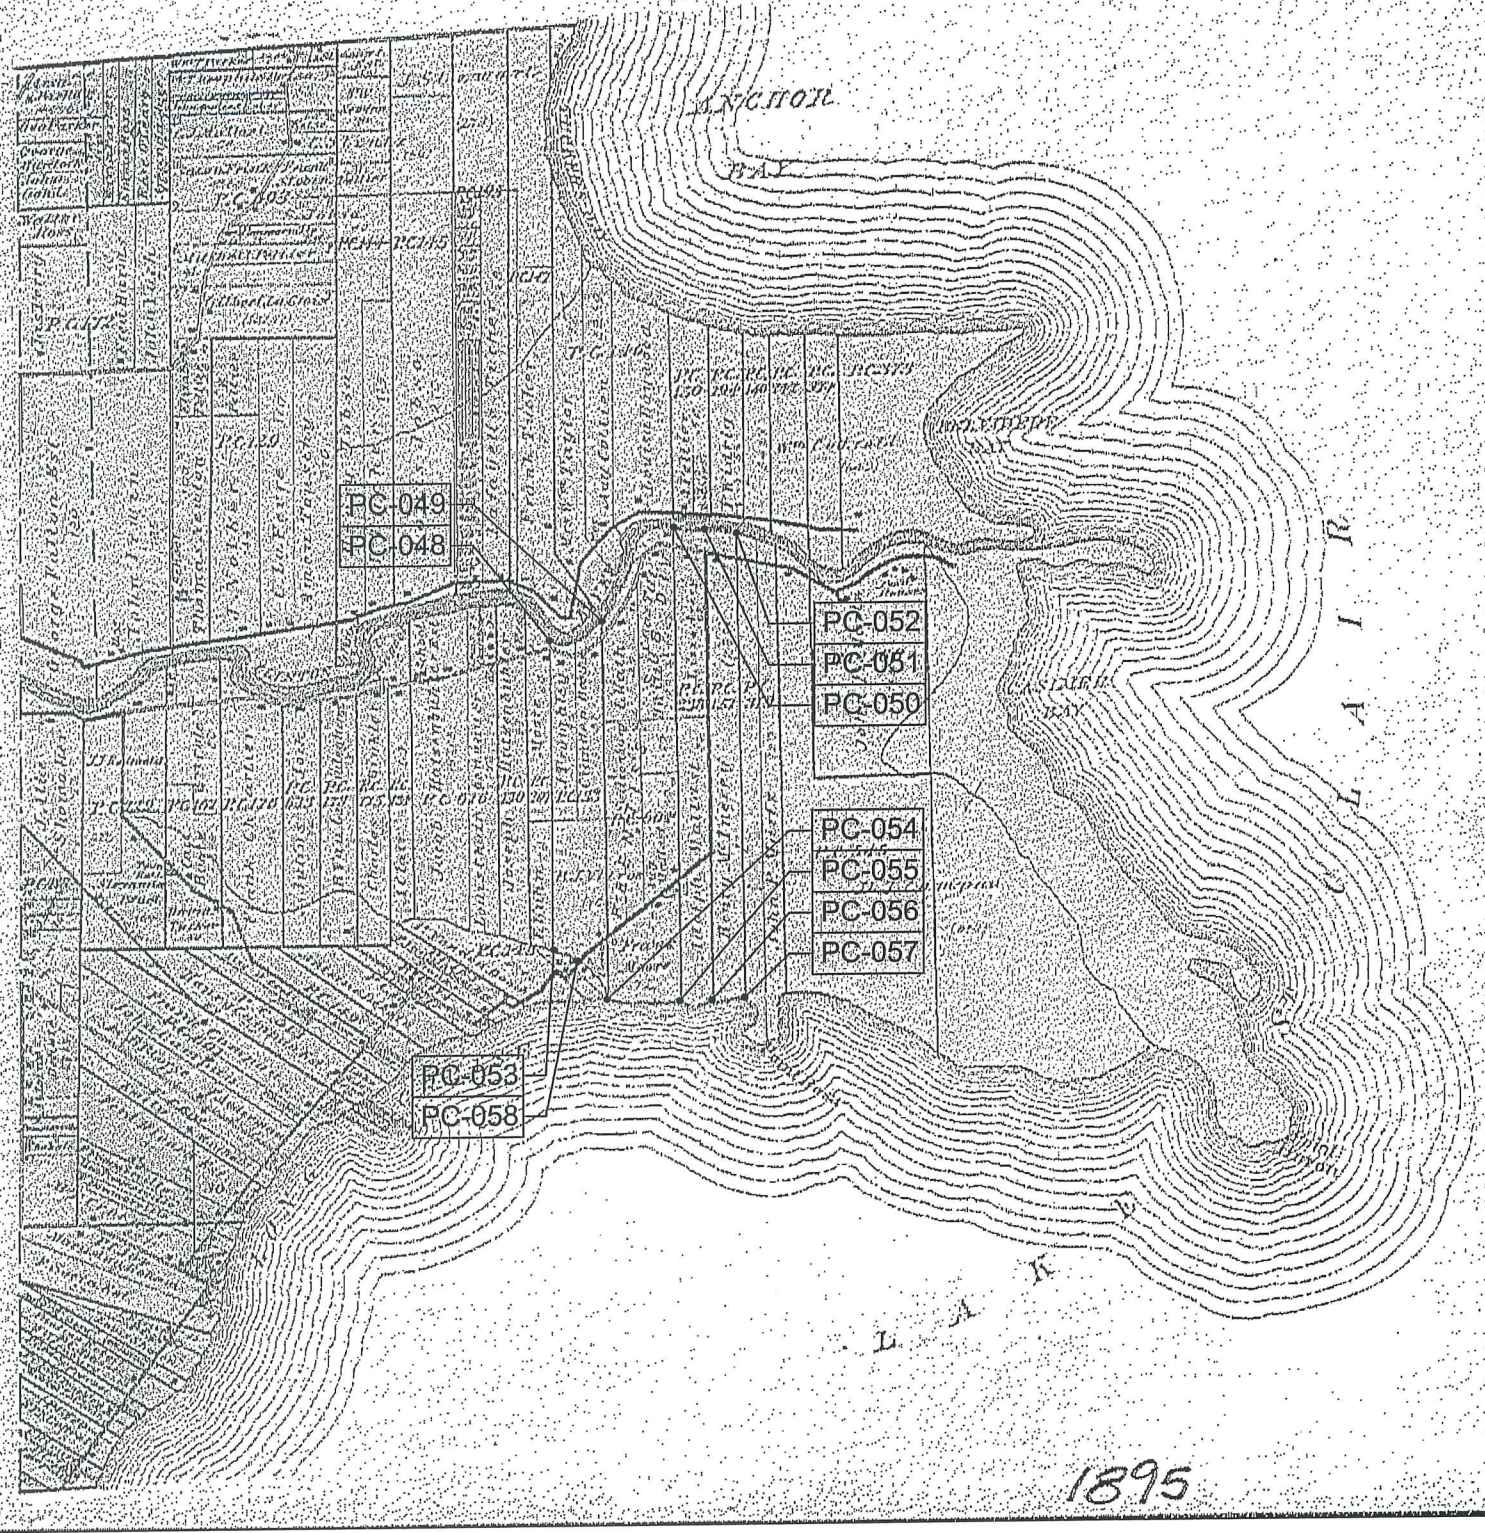

TWP

CHESTERFIELD

TWP

ANCHOR BAY

ST. CLAIR

LAKE

ST. CLAIR

POINT HURON

- PC-052
- PC-051
- PC-050
- PC-053
- PC-058
- PC-054
- PC-055
- PC-056
- PC-057

- PC-048
- PC-049



Part of Fractional Township 2 North, Range 13 East and
 Fractional Township 2 North, Range 14 East
 of the Michigan Meridian

1916

Scanned By METCO

CLINTON

BERKMAN'S SUBD.
 HARRISON PARK SUBD.
 CHARVANS AT THE LAKE SUBD.
 LAKE TWR


HARRISON

T. 2N. - R. 14E.



C-01

C-13 See CHESTERFIELD Page 31

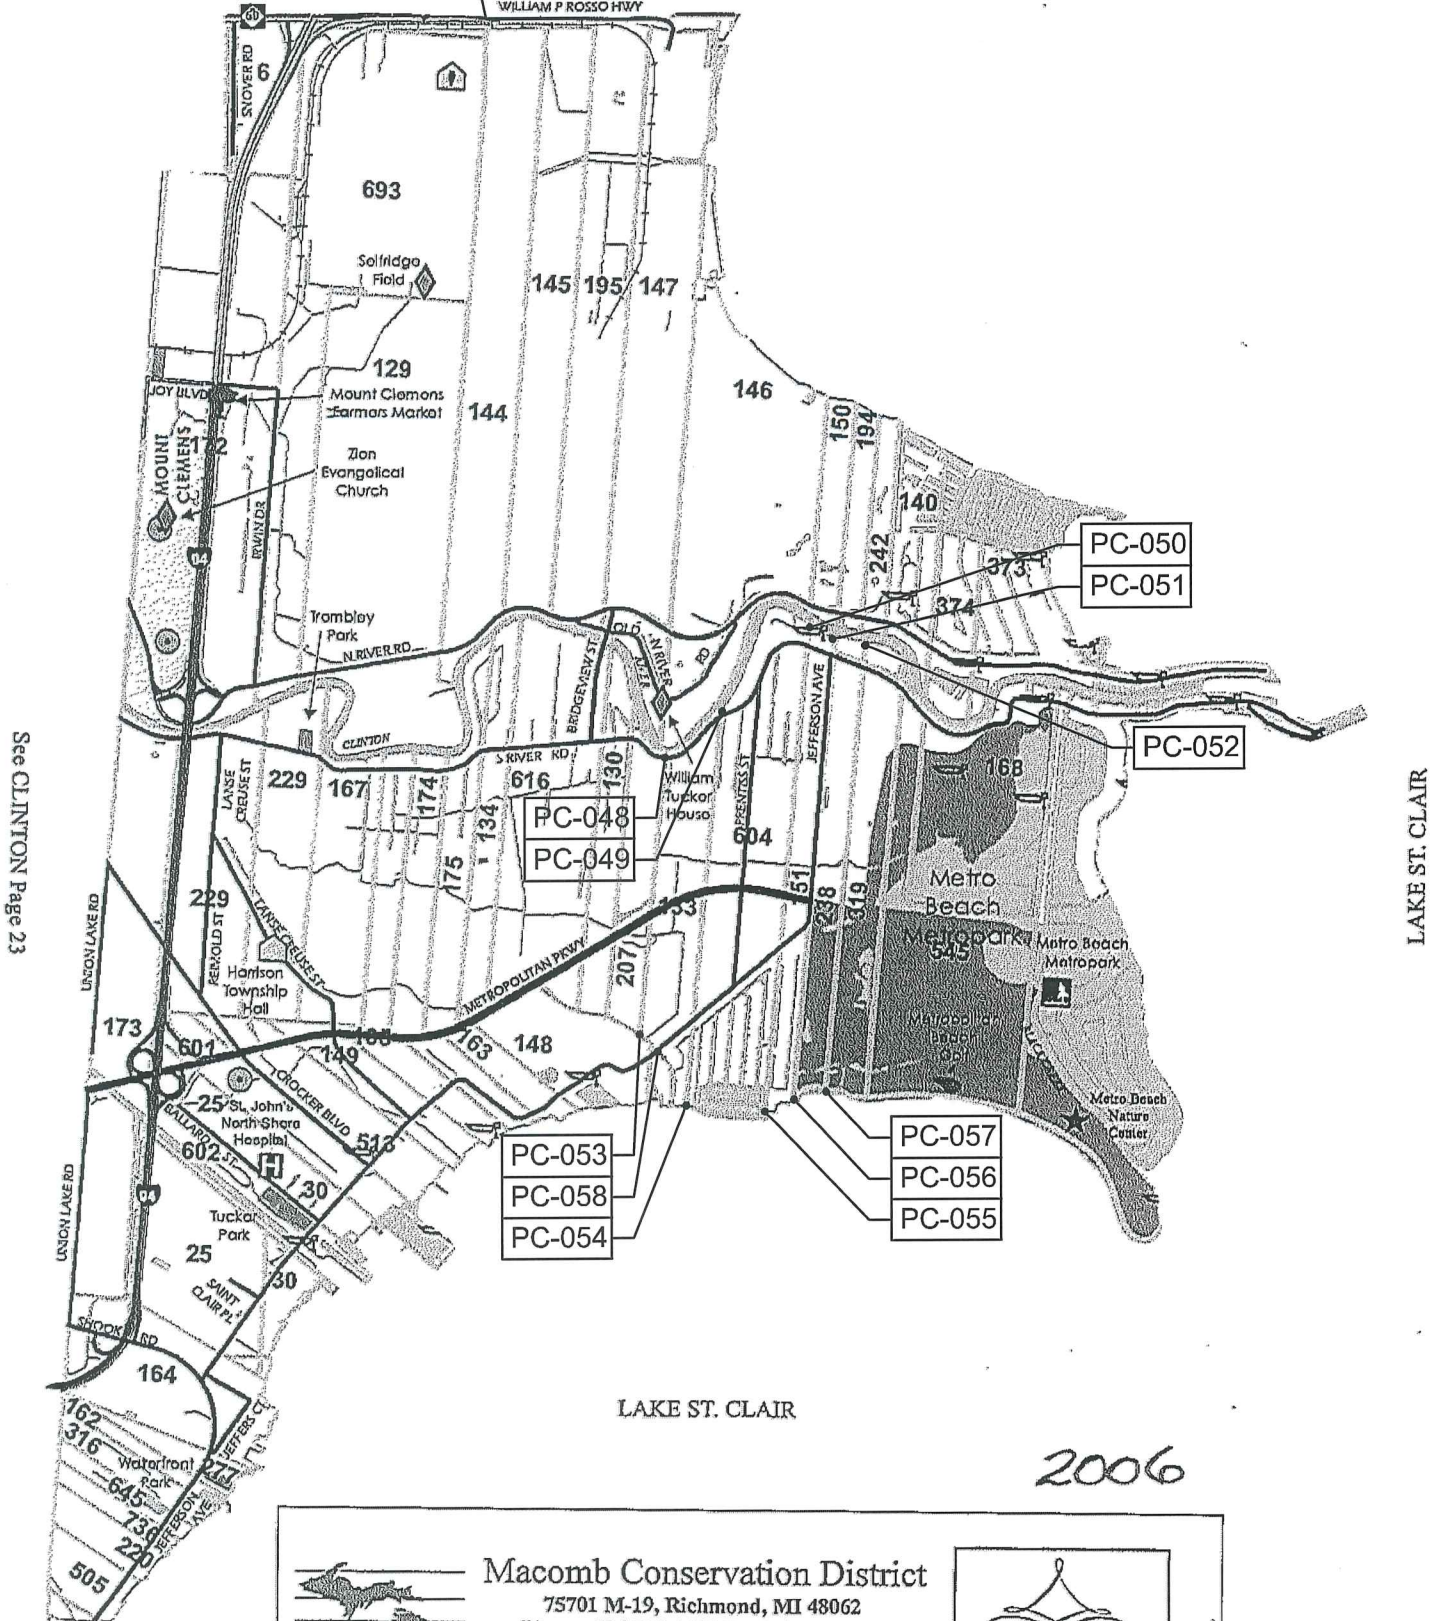


Macomb Conservation District

75701 M-19, Richmond, MI 48062
 Phone: 586-727-2666 Fax: 586-727-2621
 E-mail: macombcd@klondyke.net
 Website: www.macombcd.com

Assistance available for :
 Tree Sales Forestry Native Plants
 Conservation Education



*Celebrating
 55 Years of
 Managing
 Macomb County's
 Natural Resources*

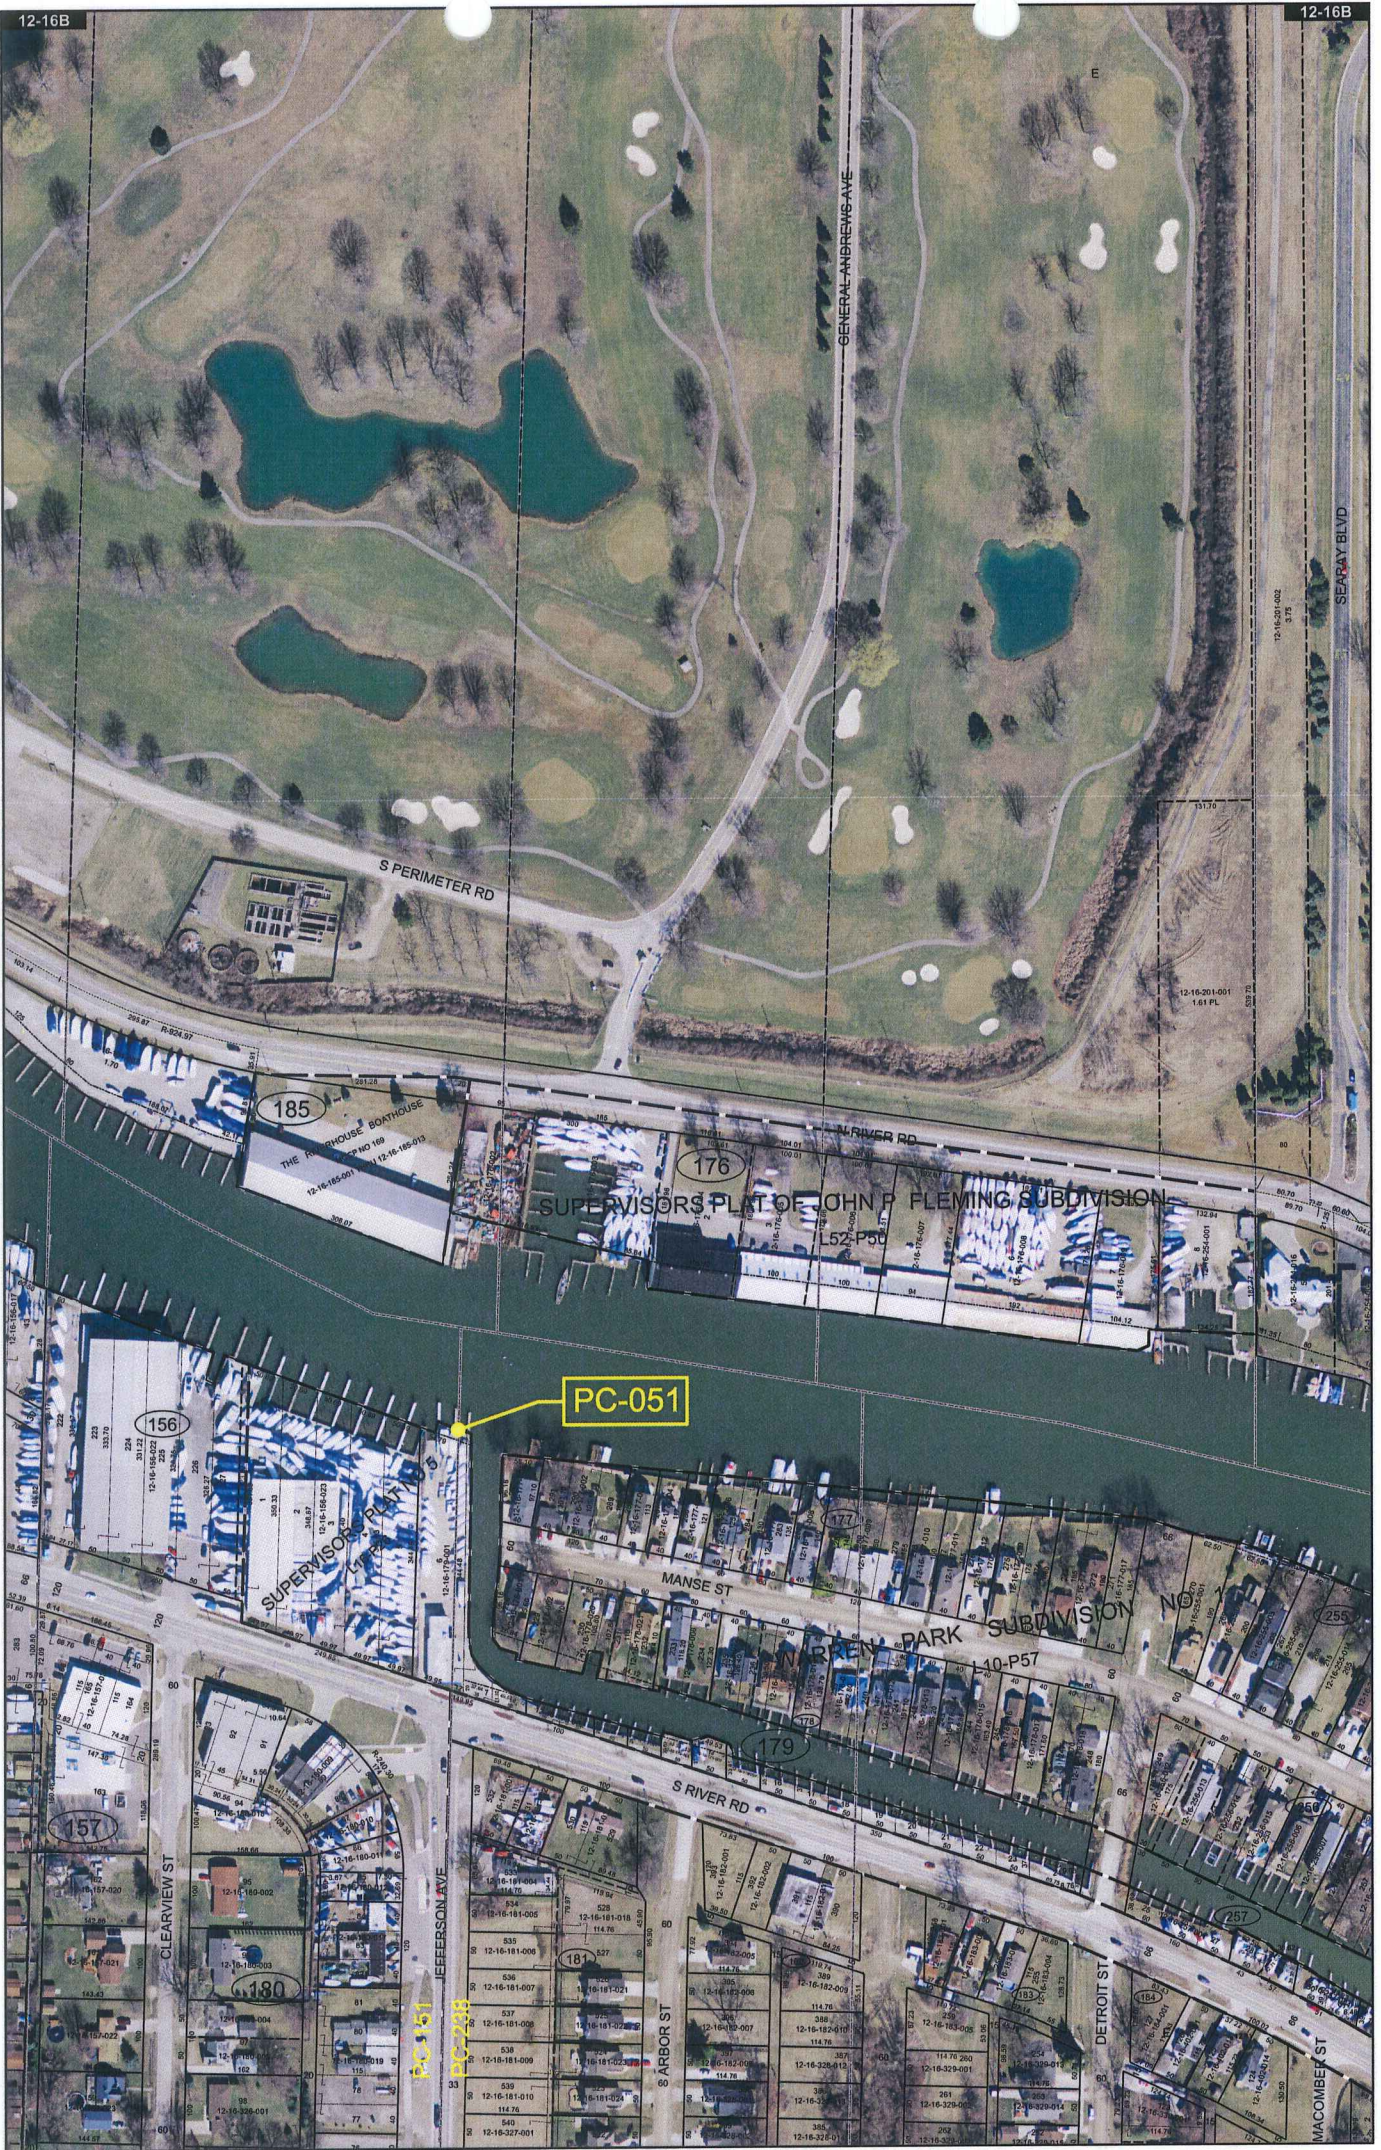

Date of Photography: Spring 2012
 100 50 0 100 200 Feet

HARRISON TWP SHEET INDEX

DESCRIPTION OF PERMANENT REAL ESTATE INDEX NUMBER
13-19-302-018

12-16B

HARRISON TWP.
 E. 1/2 N.W. 1/4 SEC. 16 T.2N. R.14E.



Source: Macomb County Department of Planning and Economic Development
 - 2008 Digital Orthophotography Project
 - Parcel Conversion Project

Note:
 Digital Orthophotography horizontal positioning accuracy is 3 feet. Parcel boundary lines should be considered a graphical representation and not in any way a legal survey or engineering document. In general, the horizontal positioning and length accuracy is within 10 feet.

This map is intended for general planning purposes. Site specific evaluation should be verified by field inspection. This is a work in progress and may contain errors and omissions. Please report any potential revisions to (586)469-5265.

Legend

- Plotted Area Boundary Line
- Property Line
- Property Split Line
- Property Combined Line
- Township Boundary Line
- Traverse Line
- Dimension Extent Marks
- Dimension Start Marks

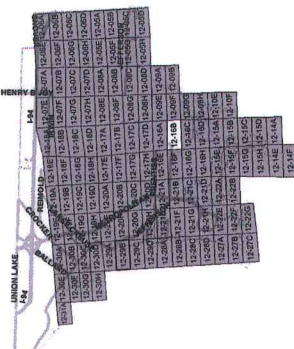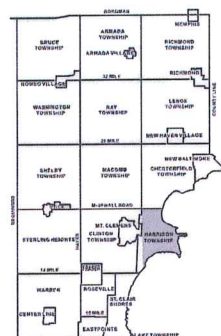





Date of Photography: Spring 2012
 100 50 0 100 200 Feet

HARRISON TWP SHEET INDEX

DESCRIPTION OF PERMANENT REAL ESTATE INDEX NUMBER
13-19-302-018

12-16F

HARRISON TWP.
 E. 1/2 S.W. 1/4 SEC. 16 T.2N. R. 14E.

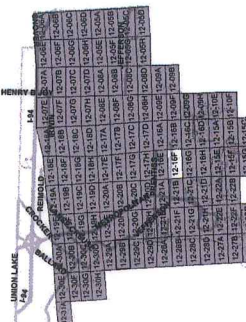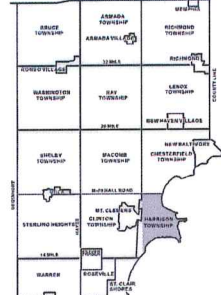

Legend

- Platted Area Boundary Line
- Property Line
- Property Split Line
- Property Combined Line
- Township Boundary Line
- Traverse Line
- Dimension Extent Marks
- Dimension Start Marks

Source: Macomb County Department of Planning and Economic Development
 - 2008 Digital Orthophotography Project
 - Parcel Conversion Project

Note:
 Digital Orthophotography horizontal positioning accuracy is 3 feet. Parcel boundary lines should be considered a graphical representation and not in any way a legal survey or engineering document. In general, the horizontal positioning and length accuracy is within 15 feet.

This map is intended for general planning purposes. Site specific evaluation should be verified by field inspection. This is a work in progress and may contain errors and omissions. Please report any potential revisions to (586)469-5265.





Date of Photography: Spring 2012
 100 50 0 100 200 Feet

HARRISON TWP SHEET INDEX

DESCRIPTION OF PERMANENT REAL ESTATE INDEX NUMBER
13-19-302-018



12-21B

HARRISON TWP.
 E. 1/2 N.W. 1/4 SEC. 21 T. 2N. R. 14E.

Source: Macomb County Department of Planning and Economic Development
 - 2008 Digital Orthophotography Project
 - Parcel Conversion Project

Note:
 Digital Orthophotography horizontal positioning accuracy is 3 feet. Parcel boundary lines should be considered a graphical representation and not in any way a legal survey or engineering document. In general, the horizontal positioning and length accuracy is within 15 feet.

This map is intended for general planning purposes. Site specific evaluation should be verified by field inspection. This is a work in progress and may contain errors and omissions. Please report any potential revisions to (586)469-2285.

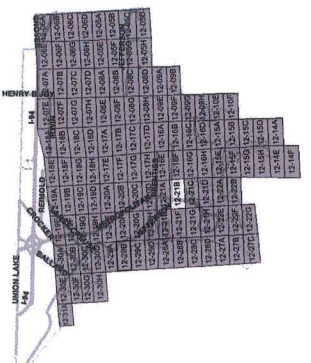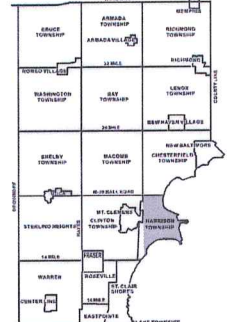

AREA NUMBER (POSTOFFICE DISTRICT OR UNINCORPORATED SURVEY)	GRID AREA NUMBER (TOWNSHIP AND RANGE)	BLOCK NUMBER (CITY BLOCK OR SECTION)	PARCEL NUMBER (RURALITY CODE AND LOT OR PART)
13-19-302-018	19-302	018	018

- Legend**
- Platted Area Boundary Line
 - Property Line
 - Property Split Line
 - Property Combined Line
 - Township Boundary Line
 - Traverse Line
 - Dimension Extent Marks
 - Dimension Start Marks





Date of Photography: Spring 2012
 100 50 0 100 200 Feet

HARRISON TWP SHEET INDEX

DESCRIPTION OF PERMANENT REAL ESTATE INDEX NUMBER
13-19-302-018



12-21E

HARRISON TWP.
 W.1/2 S.W.1/4 SEC.21 T.2N. R.14E.

Source: Macomb County Department of Planning and Economic Development
 - 2008 Digital Orthophotography Project
 - Parcel Conversion Project

Note:
 Digital Orthophotography horizontal positioning accuracy is 3 feet. Parcel boundary lines should be considered a graphical representation and not in any way a legal survey or engineering document. In general, the horizontal positioning and length accuracy is within 15 feet.

This map is intended for general planning purposes. Site specific evaluation should be verified by field inspection. This is a work in progress and may contain errors and omissions. Please report any potential revisions to (586)468-5285.

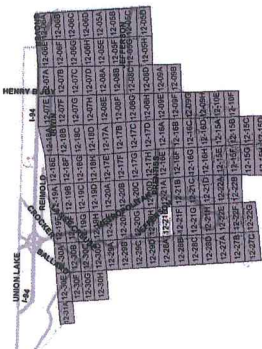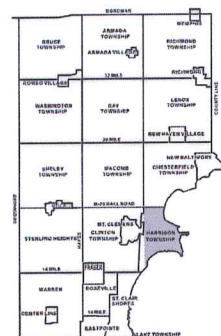

AREA NUMBER (FOR USE WITH PROPERTY INDEX)	SUB AREA NUMBER (FOR USE WITH PROPERTY INDEX)	BLOCK NUMBER (FOR USE WITH PROPERTY INDEX)	PARCEL NUMBER (FOR USE WITH PROPERTY INDEX)
13-19-302-018			

Legend	
	Platted Area Boundary Line
	Property Line
	Property Split Line
	Property Combined Line
	Township Boundary Line
	Traverse Line
	Dimension Extent Marks
	Dimension Start Marks







Date of Photography: Spring 2012
 100 50 0 100 200 Feet

HARRISON TWP SHEET INDEX

DESCRIPTION OF PERMANENT REAL ESTATE INDEX NUMBER
13-19-302-018

12-28A

HARRISON TWP.
 W. 1/2 N.W. 1/4 SEC. 28 T. 2N. R. 14E.

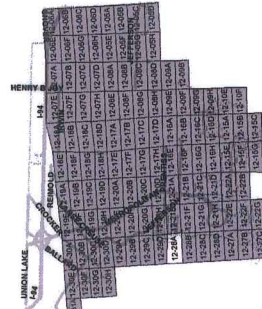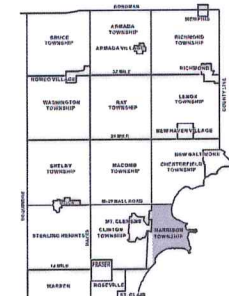

AREA NUMBER (TOWNSHIP)	SUB AREA NUMBER (SECTION)	BLOCK NUMBER (LOT BLOCK SECTION)	PARCEL NUMBER (OWNER LOT SECTION)
13-19-302-018			

Legend	
	Platted Area Boundary Line
	Property Line
	Property Split Line
	Property Combined Line
	Township Boundary Line
	Traverse Line
	Dimension Extent Marks
	Dimension Start Marks

COPYRIGHT 2009
 MACOMB COUNTY, MI
 All Rights Reserved



GIS MACOMB COUNTY
 Planning and Economic
 Development Department
 Published: Jun 06 2013

Source: Macomb County Department of Planning and Economic Development
 - 2008 Digital Orthophotography Project
 - Parcel Conversion Project


Note:
 Digital Orthophotography horizontal positioning accuracy is 3 feet. Parcel boundary lines should be considered a graphical representation and not in any way a legal survey or engineering document. In general, the horizontal positioning and length accuracy is within 15 feet.

This map is intended for general planning purposes. Site specific evaluation should be verified by field inspection. This is a work in progress and may contain errors and omissions. Please report any potential revisions to (586)469-5285.

6-16-2015 PC-056

RS BS

S.E. COR. of PC 151 COMMON
with the S.W. COR. of PC 238
T. 2N., R. 14E. HARRISON
TWP.

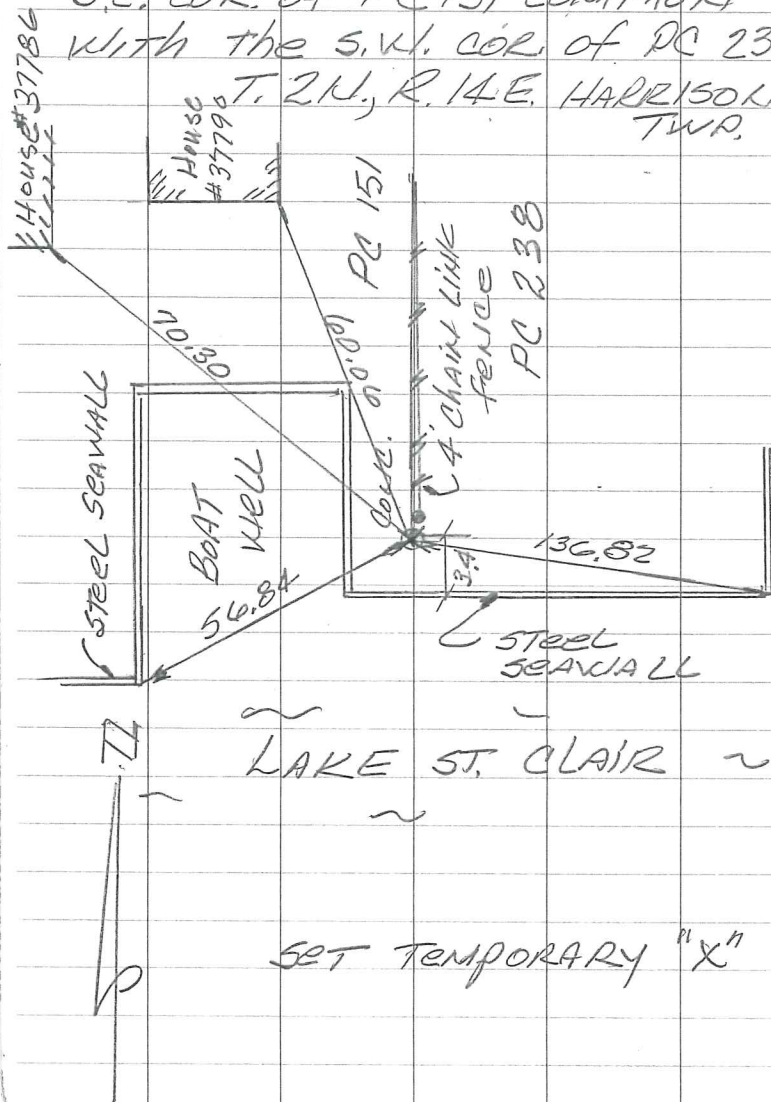

Set 1 1/4" DIA BRASS CAP
STAMPED Mi. ACT #345
PC-056


WITNESSES

EAST 136.82 FT. OUTSIDE
CORNER OF STEEL SEAWALL

S. 30° W. 56.84 FT. OUTSIDE
CORNER OF STEEL SEAWALL

N. 35° W. 70.30 FT. TO S.E.
CORNER OF HOUSE #37786

N. 5° W. 60.06 FT. TO S.E.
CORNER OF HOUSE #37790

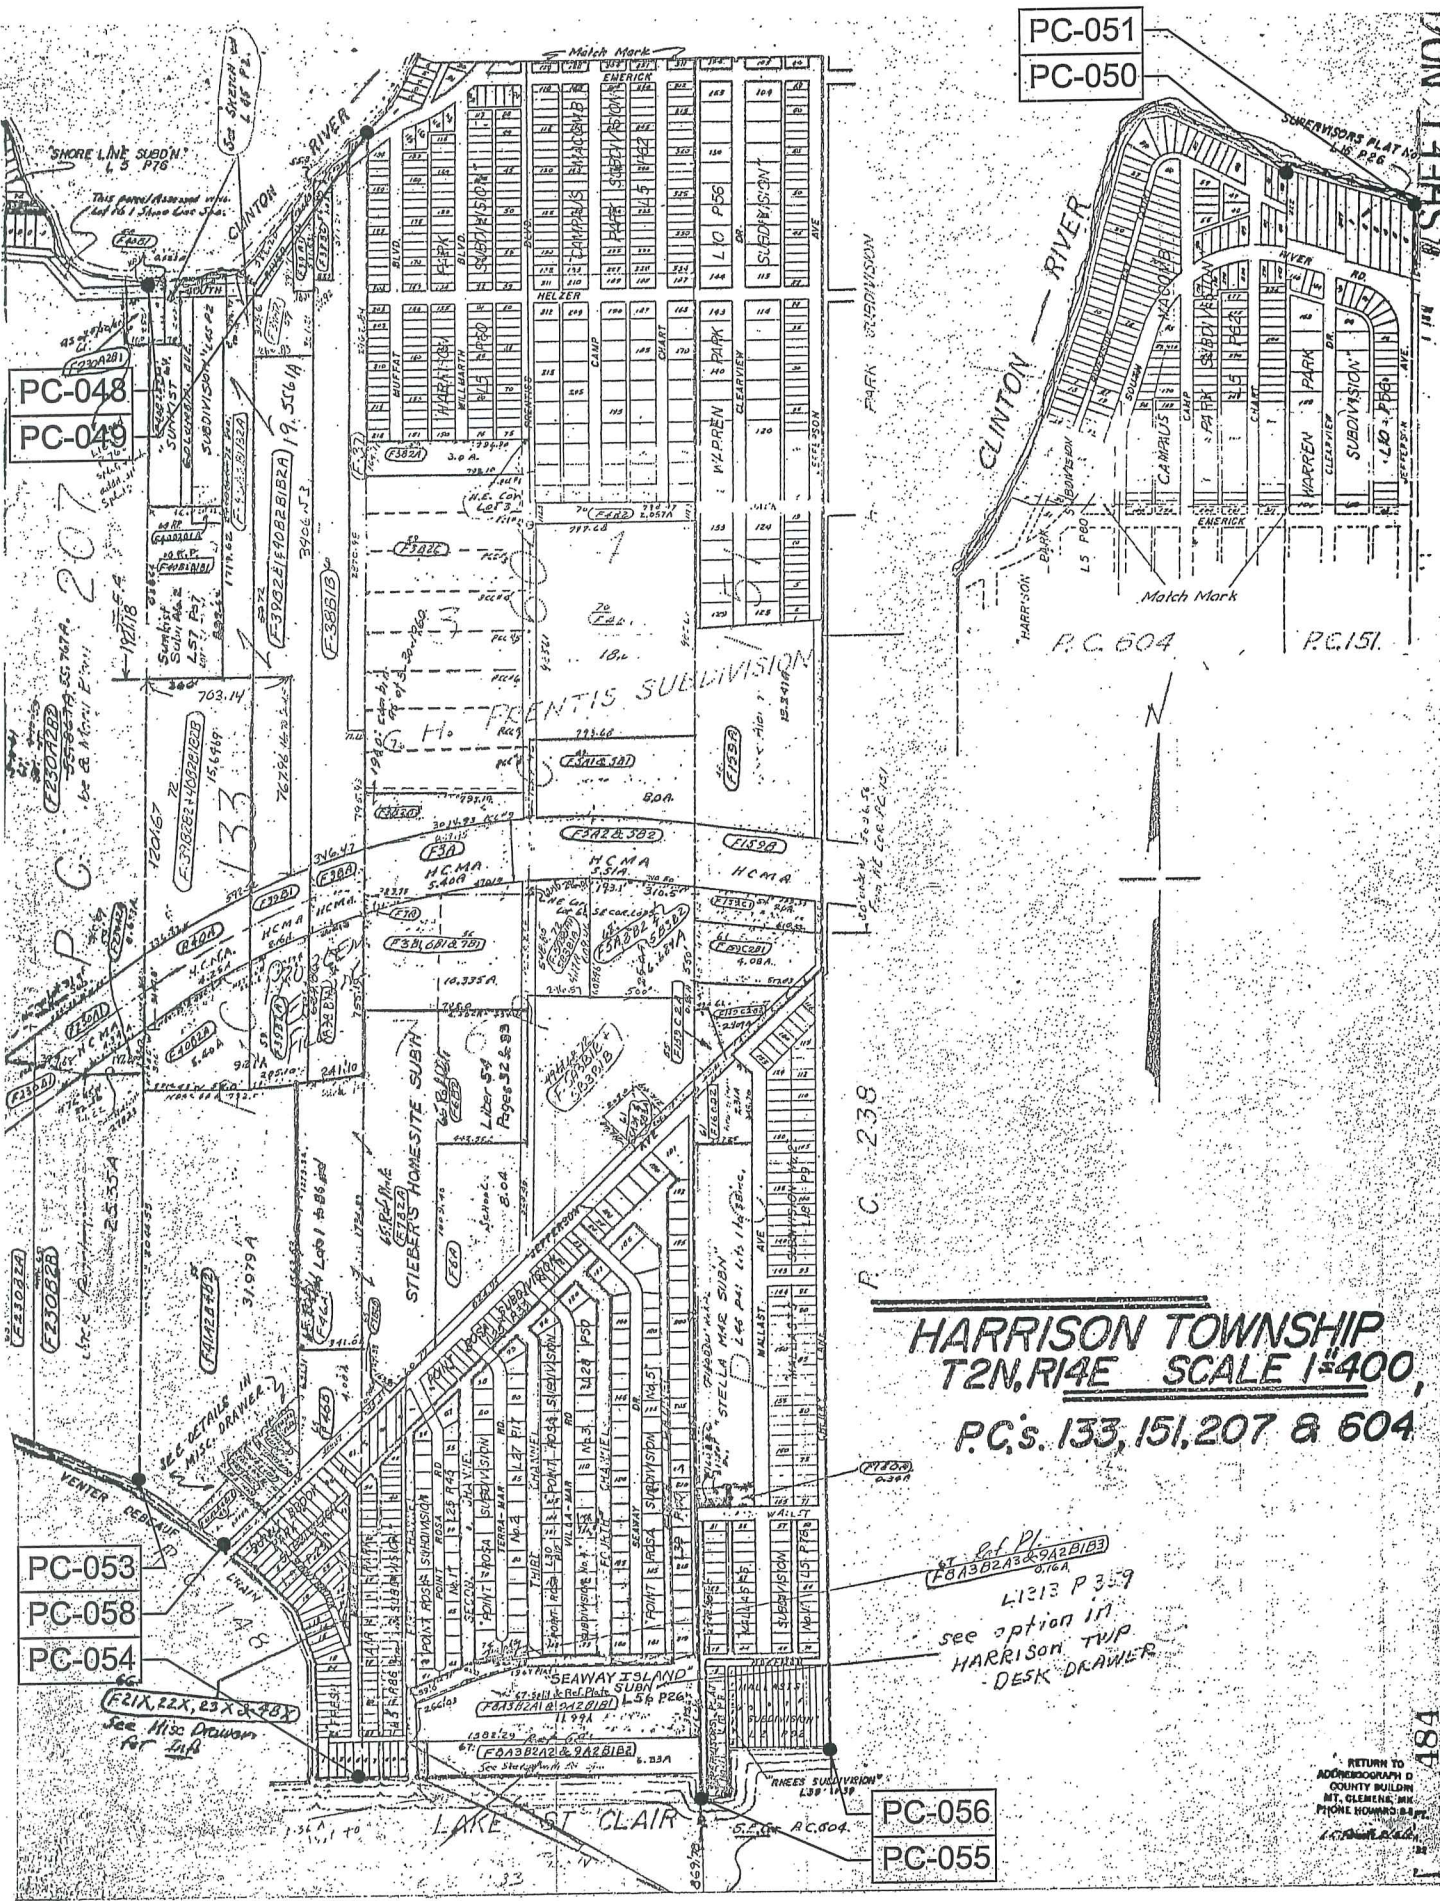

PC-051
PC-050

PC-048
PC-049

207

PC-053
PC-058
PC-054

PC-056
PC-055

HARRISON TOWNSHIP
T2N, R14E SCALE 1"=400'
P.C.'s 133, 151, 207 & 604

see option in
HARRISON TWP
DESK DRAWER

RETURN TO
AGGREGATOR
COUNTY BUILDING
ST. CLAIR COUNTY
MICHIGAN

SHEET NO. 118

184

N^o 466,, South Side of River Huron
Description N^o 151, Confirmed to
Francois St. Obin Commencing at a
post standing on the border of River
Huron between this tract and a
Tract Confirmed to Lo Chapoton from
thence south one hundred and fifty
five chains six links, to a post standing
on the border of Lake St. Clair thence
along the border of said Lake west nine
chains two links, to a post the southeast
corner of a tract Confirmed to Joseph
Gaspereau, thence north one hundred
and fifty seven chains sixty three links,
to a post standing on the border of
River Huron thence along the border
of said River down stream South
seventy degrees East seven chains twenty
eight links, thence South Eighty eight
degrees east two chains eighteen links,
to the place of beginning containing
one hundred and thirty nine acres.
Seventy eight hundredths of an acre.
Detroit July 18. 1810

Arnon Greeley Surveyor
of private Claims.

No. 466

No. 151 Confirmed to
Francois St. Obin

SOUTH SIDE OF RIVER HURON

Description No. 151 Confirmed to Francois St. Obin commencing at a post standing on the border of River Huron between this tract and a tract confirmed to Louis Chapoton Junior thence south one hundred and fifty five chains six links to a post standing on the border of Lake St. Clair thence along the border of said Lake west nine chains two links to a post the south east corner of a tract confirmed to Joseph Campeau thence north one hundred and fifty seven chains sixty three links to a post standing on the border of River Huron thence along the border of said River down stream south seventy degrees east seven chains twenty eight links, thence south eighty eight degrees east two chains eighteen links, to the place of beginning, containing one hundred and thirty nine acres seventy eight hundredths of an acre, _____

Detroit July 18, 1810

Aaron Greeley Surveyor
of private claims

N^o. 455.

South Side River Run

Description N^o. 233. Confirmed to Louis Chapiroton Junior Commencing at a post standing on the border of River Huron between this tract and a tract Confirmed to Joseph Campeau; thence South one hundred and fifty four chains sixty links, to a post standing on the border of Lake St. Clair thence along the border of said Lake west eight chains sixty three links, to a post the southeast corner of a tract Confirmed to Francis St. Obin, thence north one hundred and fifty five chains six links to a post standing on the border of River Huron thence along the border of said River down stream south eighty eight degrees east six chains thirty five links, thence south Eighty three degrees East two chains thirty links, to the place of Beginning containing one hundred and thirty four acres forty nine hundredths of an acre.

Detroit July 18. 1810

Arson Greeley Surveyor
of private Claims.

No. 405

No. 238 Confirmed to
Louis Chapeton, Junior

SOUTH SIDE OF RIVER HURON

Description No. 238 Confirmed to Louis Chapeton Junior
commencing at a post standing on the border of River Huron
between this tract and a tract confirmed to Joseph Campeau
thence south one hundred and fifty four chains sixty links to
a post standing on the border of Lake St. Clair thence along
the border of said lake west eight chains sixty three links, to
a post the south east corner of a tract confirmed to Francois
St. Obin thence north one hundred and fifty five chains six
links to a post standing on the border of River Huron thence
along the border of said river down stream south eighty eight
degrees east six chains thirty five links thence south eighty
three degrees east two chains thirty links to the place of
beginning, containing one hundred and thirty four acres forty
nine hundredths of an acre ____.

Detroit July 18, 1810 ____

Aaron Greeley Surveyor
of private claims

MALLAST'S SUBDIVISION OF THE SOUTH PART OF PRIVATE CLAIM No. 151, MACOMB COUNTY, MICHIGAN

KNOW ALL MEN BY THESE PRESENTS, That I, Emmet Mallast, proprietor, have caused the land embraced in the annexed plat to be surveyed, laid out and platted, to be known as Mallast's Subdivision of the South Part of Private Claim No. 151, Macomb County, Michigan and that the streets and alleys as shown on said plat are hereby dedicated to the use of the public.

DESCRIPTION
The land embraced in the annexed plat of MALLAST'S SUBDIVISION OF THE SOUTH PART OF PRIVATE CLAIM No. 151, MACOMB COUNTY, MICHIGAN is described as follows: Commencing at an iron gas pipe, two feet long by one inch in diameter, planted at the southeast corner of Private Claim No. 151 and said gas pipe is 179 feet South of an iron spike driven into the corner of a goch on lot No. 1 on the East line of said P. C. No. 151 from which spike a willow, 3 inches in diameter, bears N. 6 1/4° W., 24 feet, also Bahemans House, bearing N. 25° E. 52 feet, Thence N. 3° 30' E., 775 feet, Thence N. 86° 30' W., 595 feet, Thence S. 5° 30' W., 775 feet, Thence S. 86° 36' E., 395 feet to the place of beginning.

State of Michigan, County of Macomb, I, Edmund S. Sweeney, Register of said county and L. M. Stubbins, Surveyor, hereby certify that we have and carefully compared the original plat of MALLAST'S SUBDIVISION OF THE SOUTH PART OF PRIVATE CLAIM No. 151, Macomb County, Michigan and that it is an exact copy, true and correct copy of the original plat as shown to us by Emmet Mallast, Proprietor of said claim.

State of Michigan, County of Macomb, I, Edmund S. Sweeney, Register of said county and L. M. Stubbins, Surveyor, hereby certify that we have and carefully compared the annexed plat of MALLAST'S SUBDIVISION OF THE SOUTH PART OF PRIVATE CLAIM No. 151, Macomb County, Michigan and that it is an exact copy, true and correct copy of the original plat as shown to us by Emmet Mallast, Proprietor of said claim.



Order of Vacation
The 17.53 in. of this plat is and the same is hereby vacated, effective from the date of this order, to wit: 24th November 24th 1921
Vacated 1321-1921

REGISTERS OFFICE
County of Macomb
Received for Record the 16th day of July 1921
A. D. 1921
11 o'clock P.M. and is recorded in Book of Plat on Page 2 of Book of Plat
Edmund S. Sweeney, Register.

Emmet A. Mallast, Esq.
Bachelor

Deanna L. Burns
With a Knight

Scale 80' 40' 80' 40' 160' 240'
LAKE ST. CLAIR
Place of Beginning

17901

MALLAST'S SUBDIVISION NO. 1

A PART OF SOUTH PART OF P.L. 151 T.2 N. R. 14 E. HARRISON TOWNSHIP,
MACOMB COUNTY
MICHIGAN

Nov 22-1921
Chas. L. House



17895

Macomb County
Mallast's Subdivision
#1
November 23
Plat 2
78
Plat
Christ Church

Nov. 28-1921
Chas. L. House

WALTER J. LEHNER, REG. C. E.
MT. CLEMENS, MICH.

Nov 22-1921
Chas. L. House

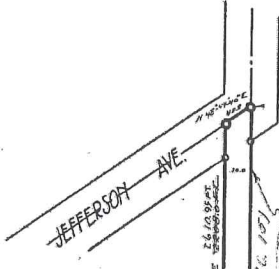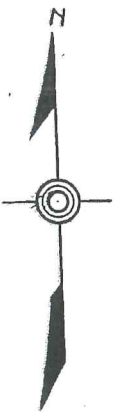

Point of beginning


Know all men by these presents, that
Emil A. Mallast, a single man,
proprietor, has caused the land embraced in the annexed
plat to be surveyed, laid out and platted, to be known as "MALLAST'S SUBDIVISION No. 1"
A part of South part of P.L. 151 T.2 N. R. 14 E. Harrison Township, Macomb County Michigan,
and that the streets and dredge cuts shown on said plat are
sincerely dedicated to the use of the lot owners.
Witness my hand and the seal of my office
this 22nd day of November 1921
Walter J. Lehner, Registered Civil Engineer

State of Michigan
County of Macomb
On this 20th day of October 1921
before me, a Notary Public in and for said County, personally
came the above named
Emil A. Mallast, a single man,
known to me to be the person who executed the above defini-
tion, and acknowledged the same to be his free act and deed.
Notary Public, Macomb Co., Mich.
J. H. ...

Description of Land Platted
The Land embraced in the annexed Plat of MALLAST'S SUBDIVISION No. 1
A part of South part of P.L. 151 T.2 N. R. 14 E. Harrison Township,
Macomb County, Michigan
is described as follows: Beginning at the point of intersection of the
center line of Jefferson Ave., and the easterly line of P.L. 151; thence
S3°30'W 340.72'; thence N86°25'20"W 120.00'; thence S3°30'W 325.00';
thence N86°25'20"W 116.00'; thence N3°30'E 116.50'; thence S86°45'20"E
566.00'; thence N3°30'E 220.00'; thence N 28°44'45"E 422.25'; to
the point of beginning.

This is to certify that the above plat was approved by the
Township Board of the Township of Harrison
Macomb County, Michigan, at a meeting held this 22nd
day of June 1920
Chas. L. House, Township Clerk

I hereby certify that the plat herein delineated is a correct one
and that permanent monuments consisting of 1/4 x 1/2 inch fine
stakes have been placed at points marked "O" as shown
shown at all angles in the boundaries of the land platted and
at all intersections of streets or avenues and alleys.
Walter J. Lehner, Registered Civil Engineer

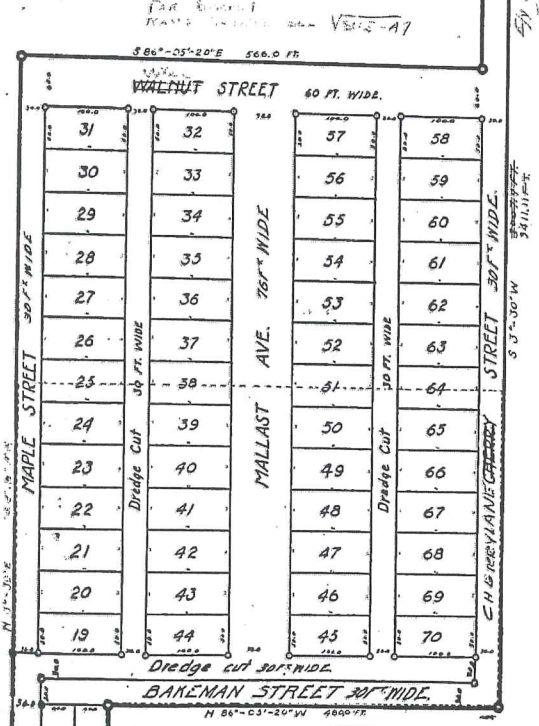

Corrected on favor of Plat, Jan. 16, 1927
Walter J. Lehner, Civil Engineer

COUNTY TREASURER'S CERTIFICATE.
This is to Certify, That there are no Tax Liens or Tax
by the State or any individual person, and that the
described in the annexed instrument have been paid
prior to the date thereof, according to the records of said
County Treasurer, Macomb County, Mich.
Oct. 21, 1921 James B. Gillett, County Treasurer, Macomb County, Mich.

This plat was approved by the County Board for Macomb
County, Michigan, at a meeting held October 21, 1921
Judge of Probate,
County Clerk,
County Treasurer,

22213

Register's Office
Wayne County, Michigan
Plat of
Warren Park Sub
Mar 26 1926
High & Whiting

Examined and approved
Mar 19 1926
Deputy Auditor General



WARREN PARK SUBDIVISION

OF PART OF
PRIVATE CLAIMS 604 & 151
HARRISON TWP MACOMB CO. MICHIGAN.

All dimensions are given in feet or decimals thereof
SCALE 1" = 200' FEET

Mar 19 1926
C. R. Harris
Mar 22 1926
J. L. Harris

This plat was approved by the County Board for Macomb County, Michigan, at a public hearing held at Macomb, Michigan, on March 15, 1926.

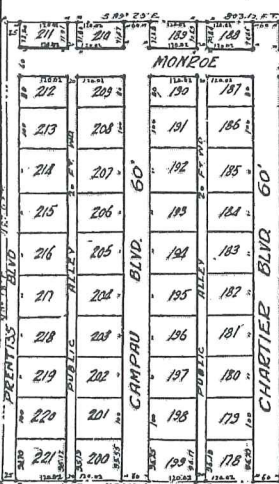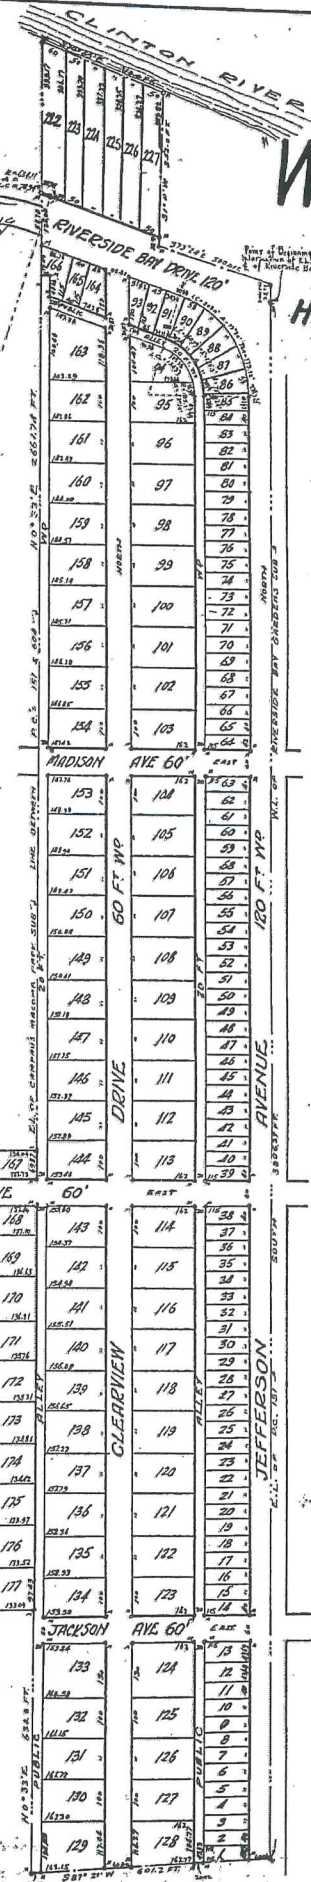

SURVEYOR'S CERTIFICATE

I hereby certify that the plat hereon delineated is a correct one, and that permanent monuments consisting of 1" x 15" pipes, set in concrete bases 4" in diameter and 48" in depth, have been placed in the ground at all points marked thus (o) as shown thereon at all angles in the boundaries of the land platted, and at all intersections of streets, of alleys, or of streets and alleys, or of streets or alleys with the boundaries of the plat.

H. F. Coaling
Registered Surveyor.

DEDICATION

KNOW ALL MEN BY THESE PRESENTS: that we, Warren J. Hopwood, a single man, Henry Meyering Jr. and Helen J. Meyering, his wife as proprietors and The Detroit-Macomb Land Co. a Michigan corporation by R. M. Richards, Vice-President and C. M. Burton, Secretary, as mortgagee, have caused the land embraced in the annexed plat to be surveyed, laid out and platted, to be known as "WARREN PARK SUBDIVISION" of part of PRIVATE CLAIM 604 & 151, Harrison Twp, Macomb Co. Michigan and that the streets and alleys shown on said plat are hereby dedicated to the use of the public.

SIGNED AND SEALED IN PRESENCE OF WITNESSES:
Warren J. Hopwood
Henry Meyering Jr.
Helen J. Meyering
R. M. Richards
C. M. Burton

Warren J. Hopwood (L.S.)
Henry Meyering Jr. (L.S.)
Helen J. Meyering (L.S.)
DETROIT-MACOMB LAND CO.
R. M. Richards (L.S.) Vice-Pres.
C. M. Burton (L.S.) Sec.

STATE OF MICHIGAN) SS:
COUNTY OF WAYNE)

On this... day of... 1926 before me, a Notary Public, personally came the above named Warren J. Hopwood, a single man, Henry Meyering Jr. and Helen J. Meyering, his wife, known to me to be the persons who executed the above dedication and acknowledged the same to be their free act and deed.

Hubert D. ...
Notary Public, in and for Wayne County, Michigan.

My commission expires
Aug 5, 1929

STATE OF MICHIGAN) SS:
COUNTY OF WAYNE)

On this... day of... 1926 before me, a Notary Public in and for said County, personally came the above named R. M. Richards and C. M. Burton, to me personally known, who being each by me duly sworn, did say that they are the Vice President and Secretary respectively, of The Detroit-Macomb Land Co. a Michigan corporation, and that the seal affixed to said instrument is the corporate seal of said corporation, and the said instrument was signed and sealed in behalf of said corporation by authority of its Board of Directors, and the said R. M. Richards and C. M. Burton, acknowledged said instrument to be the free act and deed of said corporation.

Edward N. Munro
Notary Public, in and for Wayne County, Michigan.

My commission expires
Feb 16, 1927

CERTIFICATE OF TOWNSHIP BOARD

I hereby certify that this plat has been approved by the Township Board of the Township of Harrison at a session held... 1926.

Carl P. ...
Clerk.

DESCRIPTION

The land embraced on the annexed plat of "Warren Park Subdivision" of part of Private Claims 604 & 151 Harrison Twp, Macomb Co., Michigan, is more particularly described as follows: Beginning at an iron in the intersection of Riverside Bay Drive and Jefferson Ave., which is also the East line of P.C. 151, thence South 2806.27 ft. to a point, thence S 87°21' W 601.2 ft. to a point, thence N 0°33' E 638.8 ft. to a point, thence N 89°28' W 798.17 ft. to a point, thence N 0° 18' E 1107.0 ft. to a point, thence S 89°23' E 803.18 ft. to a point, thence northerly along the line between P.C.'s 151 & 604 N 0°33' E 2861.74 ft. to the South bank of the Clinton River, thence S 70° 55' E 310.0 ft. to a point, thence S 1°11' W 355.0 ft. to a point, thence S 73°24' E 300.00 ft. to a point, thence South 95.73' to the place of beginning.

COUNTY TREASURER'S CERTIFICATE

The fee of \$...
Mar 15 26
Arthur A. ...
County Treasurer

SUPERVISOR'S PLAT No. 5

OF PARTS OF P.C.S. 151, 238, 319,
& 545, HARRISON TOWNSHIP,
MACOMB COUNTY, MICH.

SCALE 1"=100'

WALTER J. LEHNER
MT. CLEMENS MICH.



DEDICATION.

KNOW ALL MEN BY THESE PRESENTS, that I, Floyd W. Rosso, Supervisor of the Township of Harrison Macomb County, Michigan, by virtue of authority in me vested by Section 51 Act 172 of P.A. 1929, having caused the land embraced in the annexed plat to be surveyed, laid out and platted, to be known as SUPERVISOR'S PLAT NO. 5, of parts of P.C.S. 151, 238, 319, & 545 Harrison Township, Macomb County, Michigan, and that the streets as shown on said plat have been dedicated to the use of the public.

Witnesses:
Floyd W. Rosso
 Supervisor for Harrison Twp.
W. J. Lechner
Mon. J. Peters

STATE OF MICHIGAN. } SS.
 COUNTY OF MACOMB. }

On this first day of May A.D. 1933 before me a Notary Public in and for said County personally came the above named Floyd W. Rosso, Supervisor of Harrison Twp., known to me to be the person who executed the above dedication and acknowledged the same to be his free act and deed as such Supervisor.

Carl H. John
 Notary Public in and for
 Macomb County.
 My Commission expires March 14, 1937

TOWNSHIP APPROVAL.

This plat was approved by the Township Board of the Township of Harrison at a meeting held May first, 1933.

Carl H. John
 Township Clerk.

CERTIFICATE OF APPROVAL BY COUNTY BOARD

This plat was approved on the 16th day of November 1933

Frederic C. Wiley
 Judge of Probate
James B. Larline
 County Clerk
J. H. Kancher
 County Treasurer

Examined and Approved

Respectfully Submitted
Floyd W. Rosso
 Supervisor

Resolution S 3746 P-232

DESCRIPTION.

THE LAND EMBRACED IN THE ANNEXED PLAT OF SUPERVISOR'S PLAT NO. 5, of parts of P.C.S. 151, 238, 319, & 545 Harrison Township, Macomb County, Mich., is described as follows:

Beginning at the intersection of the northerly side line of Riverside Bay Drive, so called, and the easterly line of P.C. 151, and thence extending N. 73°-24' W. 299.8 ft; thence N. 1°-11' E. 351.80 ft; thence S. 71°-47' -30" E. 308.24 ft. along the southerly bank of Clinton River; thence S. 0°-12' W. 324.48 ft; thence S. 75°-18' -30" E. 483.40 ft; thence S. 75°-23' E. 432.43 ft; thence S. 66°-37' E. 291.05 ft; thence S. 64°-25' E. 124.23 ft; thence S. 62°-30' E. 148.59 ft; thence S. 54°-40' -30" E. 75.83 ft; thence N. 0°-04' -30" E. 461.46 ft; thence S. 13°-16' -30" E. 453.00 ft; thence N. 60°-00' -30" W. 120.68 ft; thence S. 0°-04' -50" W. 80.96 ft; thence S. 63°-27' -15" E. 95.14 ft; thence S. 58°-19' E. 100.00 ft; thence S. 49°-33' -15" E. 111.78 ft; thence S. 0°-04' -30" W. 25.0 ft; thence N. 58°-19' W. 393.17 ft; thence N. 62°-30' W. 146.71 ft; thence N. 64°-25' W. 122.94 ft; thence N. 6°-37' W. 288.29 ft; thence N. 73°-23' W. 919.75 ft. to the place of beginning.

SURVEYOR'S CERTIFICATE.

I hereby certify that the plat hereon delineated is a correct one and that permanent metal monuments of not less than one inch in diameter and fifteen inches in length set in concrete base at least four inches in diameter and forty eight inches in depth have been placed at points marked thus (O) as shown at all angles in the boundaries of the land platted, and at all intersections of streets with the boundaries of the plat as shown on said plat.

Walter J. Lechner
 REGISTERED CIVIL ENGINEER,

JEFFERSON AVE

RIVERSIDE BAY DRIVE

CANAL


PC-051

PC 238
PC 319

DETROIT

BLVD.

CLINTON RIVER

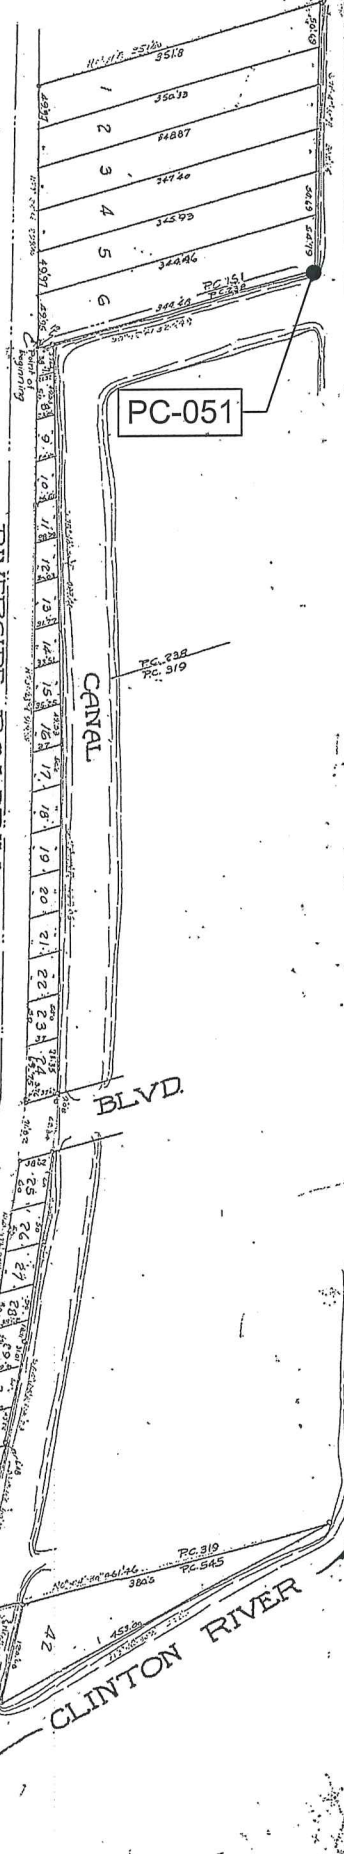

Lehner's

151

1540


SUPERVISOR'S PLAT NO-11

PART OF P.C. 151 & REPLAT OF LOTS 17 & 18 OF MALLAST'S SUBDIVISION NO. 1-A PART OF SOUTH PART OF P.C. 151 T. 2 N. R. 14 E. HARRISON TWP, MACOMB COUNTY, MICH.

Scale 1"=50'

WALTER J LEHNER
MTCLEMENS, MICH.

0 25 50 100
All dimensions in feet and decimals thereof

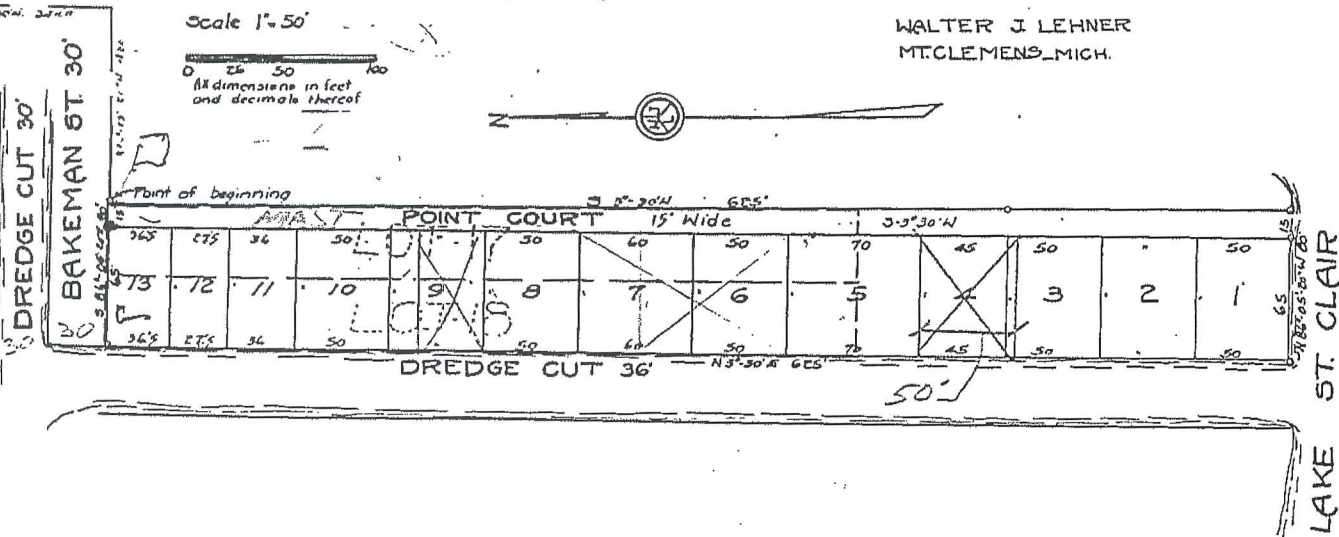

WITNESSETH, that I, Floyd W. Rouse, Supervisor of Harrison Township, Macomb County, State of Michigan, by virtue of authority in me vested by Section 51, Act 172 of P.A. 1924, having been duly authorized by the Township Board have caused the land embraced in the annexed plat to be surveyed, laid out as platted, to be known as "Supervisor's Plat No. 11, of part of P.C. 151 & Replat of Lots 17 & 18 of Mallast's Subdivision No. 1-A part of South part of P.C. 151 T. 2 N. R. 14 E., Harrison Township, Macomb County, Mich., and that the street as shown on said plat has been dedicated to the use of the public.

Floyd W. Rouse
Supervisor, Harrison Twp.

Witnesses
Carl H. Johnson
M. C. Brown

STATE OF MICHIGAN)
COUNTY OF MACOMB)

On this 4th day of Nov A.D. 1935, before me a Notary Public in and for said County, personally appeared the above named Floyd W. Rouse, Supervisor of Harrison Twp., known to me to be the person who executed the above dedication and acknowledged the same to be his free act and deed as such Supervisor.

Carl H. Johnson
Notary Public in and for
Macomb County, Michigan.
My Commission expires March 6th, 1937.

TOWNSHIP APPROVAL
This plat was approved by the Township Board of the Township of Harrison at a meeting held on
Monday Nov 4th A.D. 1935.
Carl H. Johnson
Harrison Township Clerk.

DESCRIPTION.

THE LAND EMBRACED IN THE ANNEXED PLAT OF SUPERVISOR'S PLAT NO. 11 part of P.C. 151 & Replat of Lots 17 & 18 of Mallast's Subdivision No. 1-A part of the south part of P.C. 151 T. 2 N. R. 14 E., Harrison Twp., Macomb County, Mich., is described as follows: Commencing at the North East Corner of said lot No. 15, and thence extending S. 2°-20' W. 625 ft; thence N. 86°-05'-20" W. 80 ft; thence the border of Lake St. Clair; thence N. 3°-30' E. 625 ft; thence S. 86°-05'-20" E. 80 ft. to the place of beginning. The said point of beginning being 3411.11 ft. S. 1°-30' W. and 480 ft. N. 86°-05'-20" W. of the intersection of the East line of P.C. 151 and the center line of Jefferson Ave., so called.

SURVEYOR'S CERTIFICATE.

I hereby certify that the plat hereon delineated is a correction and that permanent metal monument, of not less than fifteen inches in length and one inch diameter set in a concrete base at least four inches in diameter and forty eight inches in depth have been placed at points marked thus (S), as shown at all angles in the boundaries of the land platted, at all intersections of streets with the boundaries of the plat as shown on said plat.

Walter J. Lehner
Registered Civil Engineer.

COUNTY BOARD APPROVAL.

This plat was approved by the County Board for Macomb County at a meeting held January 10th 1936
Arthur J. Miller Judge of Probate.
Emmie L. Rouse Deputy County Clerk.
Carl B. Grandenburg County Treasurer.

REGISTER'S OFFICE
County of Macomb
RECORDED
FEB 2 1936
3:16
Walter J. Lehner
Register

Examined and Approved
2/1/37
James J. Jamison
Deputy Auditor General


"MALLAST'S SUBDIVISION NO 2"

A PART OF P.C. 151, T. 2 N.R. 13 & 14 E.
HARRISON TOWNSHIP, MACOMB COUNTY, MICHIGAN.

Scale 1" = 150'

Moller J. Lehner
M. Clemens, Mich

All dimensions in feet
& decimals thereof

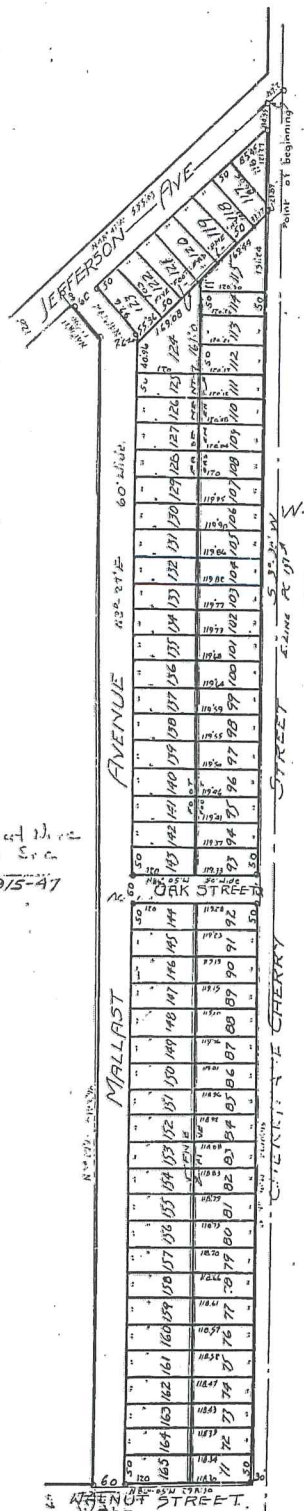

DEDICATION.

KNOW ALL MEN BY THESE PRESENTS, THAT WE, CATHERINE WATT, single person, DONOVAN H. WATT & BERNADINE WATT, his wife, GEORGE W. ANTHONY & THERESA A. ANTHONY, his wife, ARTHUR WOLTMANN & CLARA WOLTMANN, his wife, and FRED MALLAST, a single man, and ADOLPH MALLAST, administrator of the estate of Emil A. Mallast, deceased, as proprietors, have caused the land embraced in the annexed plat to be surveyed, laid out and platted, to be known as "MALLAST'S SUBDIVISION NO. 2," a part of P.C. 151, Harrison Township, Macomb County, Mich., and that the streets as shown on said plat are hereby dedicated to the use of the public.

Joseph A. Finesth
Donovan H. Watt
Bernadine Watt
Arthur Woltmann
Clara Woltmann
Fred Mallast
Adolph Mallast

STATE OF MICHIGAN.

COUNTY OF MACOMB } SS,
On this 17th day of September A.D. 1936, before me, A Notary Public in and for said County, personally came the above named Catherine Watt, Donovan H. Watt and Bernadine Watt, his wife, George W. Anthony and Theresa A. Anthony, his wife, Arthur Woltmann and Clara Woltmann, his wife, Fred Mallast, a single man, and Adolph Mallast, administrator of the Estate of Emil A. Mallast, deceased, known to me to be the persons who executed the above dedication and acknowledged the same to be their free act and deed.

My commission expires August 4th 1940.

DESCRIPTION OF LAND PLATTED.
THE LAND EMBRACED IN THE ANNEXED PLAT OF "MALLAST'S SUBDIVISION NO. 2," a part of P.C. 151 Harrison Township, Macomb County, Mich., is described as follows:
Commencing at a point in the center of Jefferson Ave., so called, 42.2 ft. S. 48°-42' W. of the intersection of the center line of said Jefferson Ave., and the easterly side line of P.C. 151, and thence extending S. 3°-30' W. 2610.95 ft; thence N. 86°-05' W. 298.30 ft; thence N. 3°-27' E. 2123.70 ft; thence N. 41°-18' W. 132.90 ft; thence N. 48°-42' E. 555.03 ft. to the place of beginning.

SURVEYOR'S CERTIFICATE.
I hereby certify that the plat hereon delineated is a correct one and that permanent metal monuments of not less than one inch in diameter and fifteen inches in length set in a concrete base at least four inches in diameter and forty eight inches in depth have been placed at points marked thus (o), as thereon shown at all angles in the boundaries of the land platted, at all intersections of streets, and at the intersections of streets with the boundaries of the plat as shown on said plat.

TOWNSHIP APPROVAL.
This plat was approved by the Township Board of the Township of Harrison Macomb County, Michigan, at a meeting held Aug 15 1936 A.D. 1936



COUNTY TREASURER'S CERTIFICATE.
OFFICE OF COUNTY TREASURER, MACOMB COUNTY.
I, hereby certify, that there are no tax liens or titles held by the State on the lands described above, and that there are no tax liens or titles held by individuals on said lands for the five years preceding the 17th day of September A.D. 1936 and that the taxes for said period of five years are paid, as shown by the records of this office.

Carl D. Juncosbury
County Treasurer.

CERTIFICATE OF APPROVAL BY COUNTY BOARD.
This plat was approved on the 17th day of September A.D. 1936.


Arthur Woltmann
Judge of Probate.
Carl D. Juncosbury
County Treasurer.

James J. Jamison
2/1/37

Examined and approved
James J. Jamison
2/1/37

James J. Jamison
2/1/37

COPY
Register's Office
Macomb County
Paul G. Mallett Subdivision
770-2
Book of
37, 3150
18 pages
Paul G. Mallett
Register of Deeds
ORIGINAL ON FILE

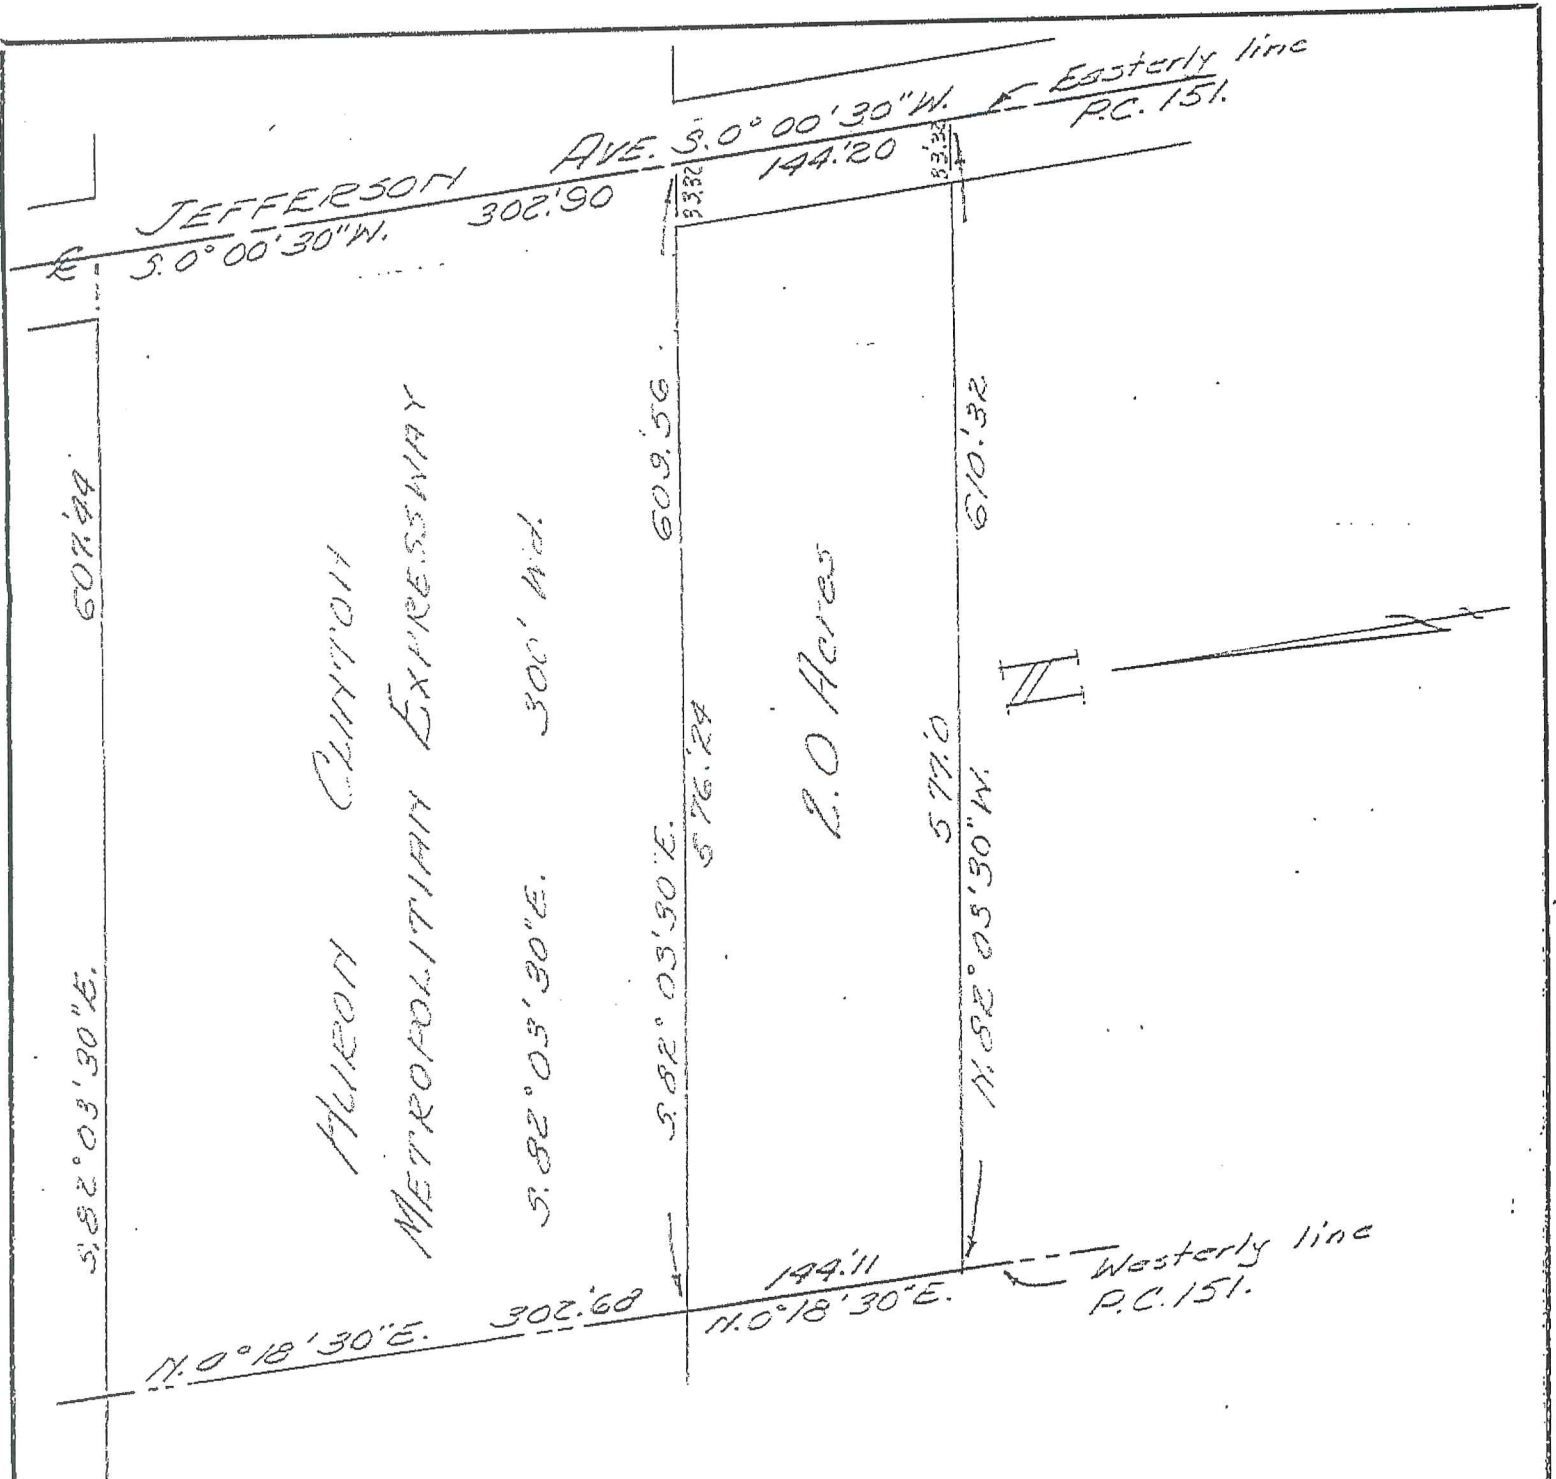


Plat of Survey of Part of P. C. 151,
 T. 2 N., R. 14 E., Harrison Twp.
 Macomb County, Michigan.

SCALE: 1" = 100'
 DATE: 5 Oct 53

WALTER J. LEHNER & SONS
 REGISTERED LAND SURVEYORS
 LAWYERS BLDG.
 MT. CLEMENS MICHIGAN

53-784

Sketch of Survey
 East line of Lot 1
 "Mallast Subdivision"
 of the South part of P.C. 541
 T. 2 N., R. 14 E.,
 Harrison Township, Macomb County,
 Michigan

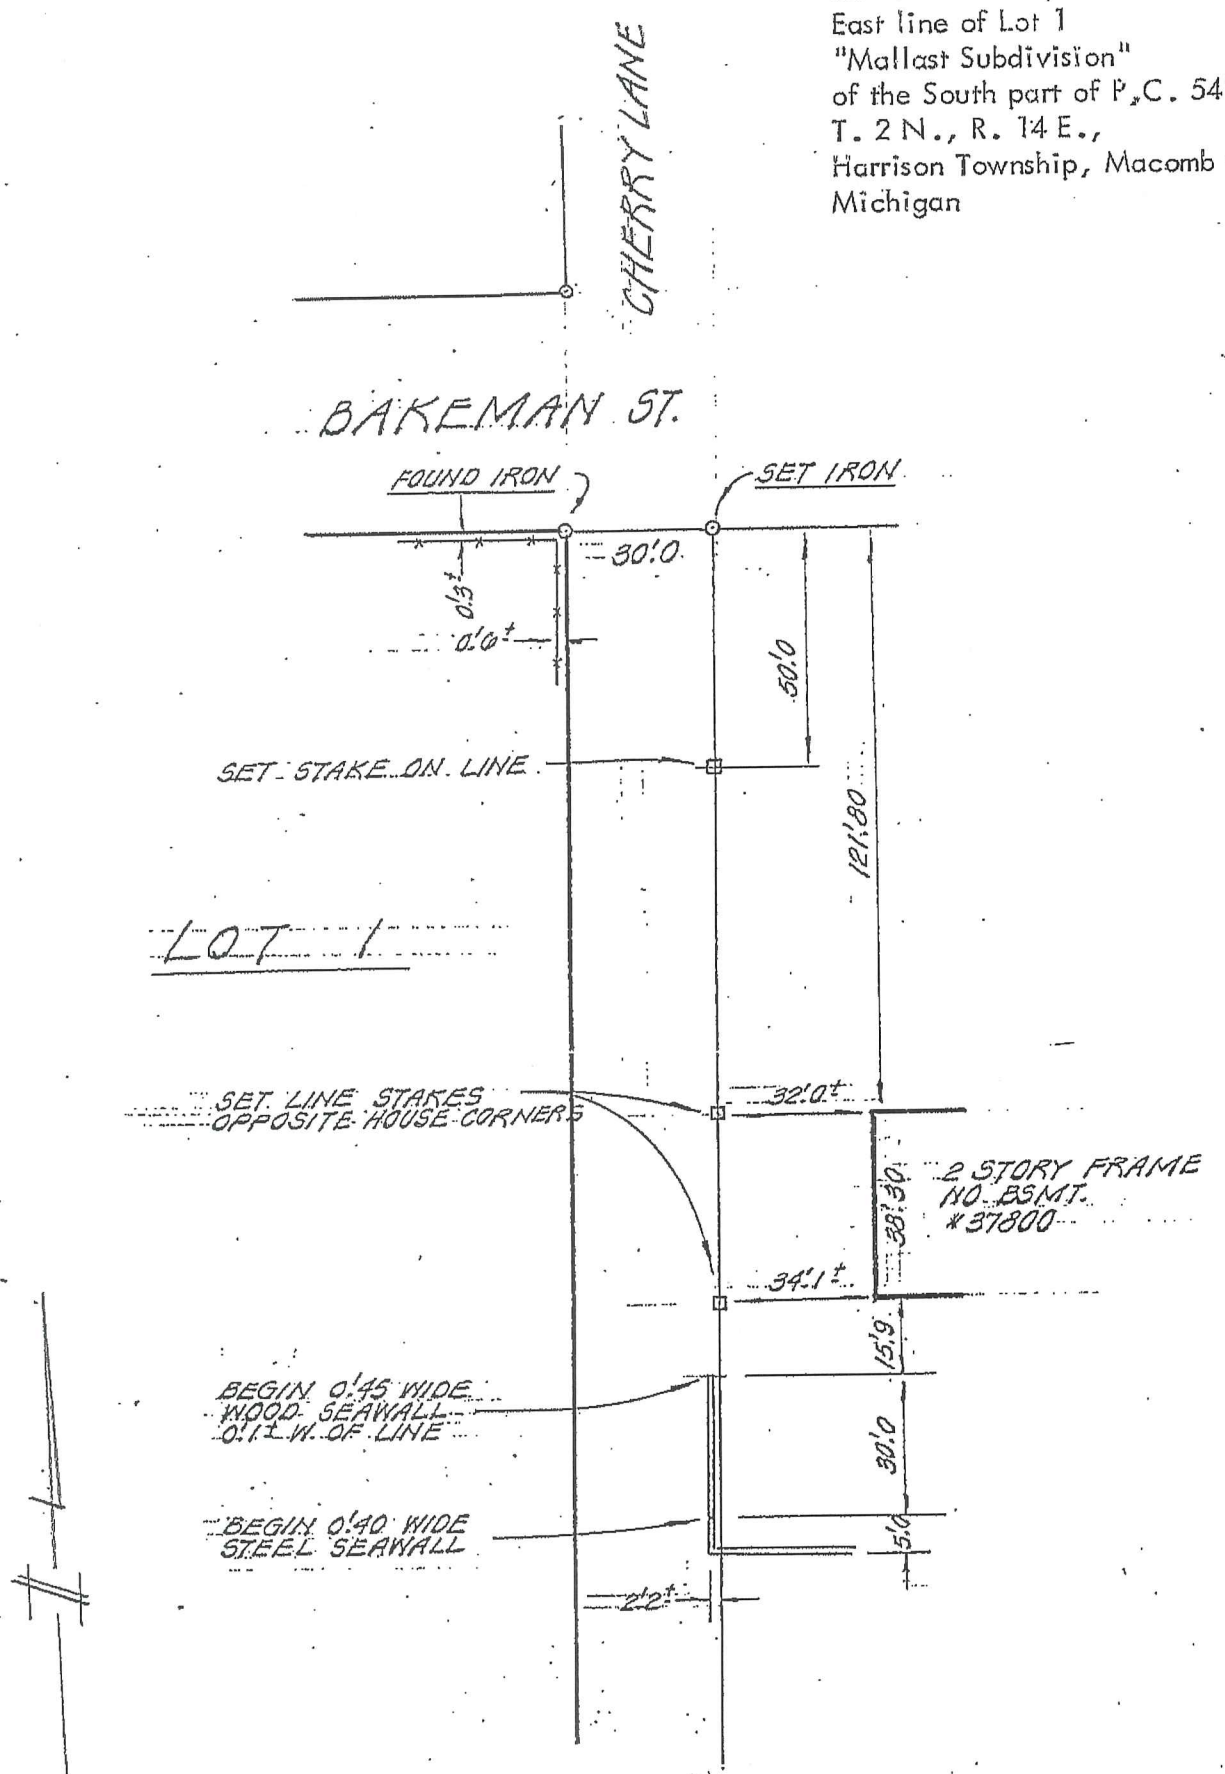

SCALE: 1" = 40'
 DATE: 10-27-77

LEHNER ASSOCIATES, INCORPORATED
 ENGINEERS & SURVEYORS
 22900 WELLINGTON CRESENT
 MT. CLEMENS MICHIGAN

PJP

77-740 EDWARD RIPPLING