
|   | LAND CORNER RE   |   |  |  |                 |
|---|--|---|--|--|-----------------|
| For corners in  |  |   | MICHOLE<br>NO HEI  |  |                 |
| MACOMB  | CHESTERFIELD TOWN Located In: Come   | SHIP<br>er Code #   | WAS AND COMMISSION OF THE PARTY | 1246432  | - 7E/           |
| (County)  | Located III. Com   |   | \$65 47 \$   | IBER 11091 PAG<br>12/13/2001 10:50:00 A.M.   | E 354           |
| 1. Public Land Survey   | T3N R14E L-<br>T R<br>T R  | 1   | OMB COUNTY<br>L CORNER UN<br>1990 AT A M   | MACOMB COUNTY, MI<br>CARMELLA SABAUGH, REGISTI   | ER OF DEEDS     |
| in Section S  3. Miscellaneous S Property in Sec. S   | TR   |   | ACCEPTED BY THE MACOMB COUNTY GROUP AS THE OFFICIAL CORNER UN PUBLIC ACT 345 OF 1990 AT A M ON 10 4 6 10 10 10 10 10 10 10 10 10 10 10 10 10   | Register of Deeds Stamp  | o & File Number |
| 4. Lot No, Recorded Plat_   |  |   | <u>825</u> 2 8 1   |  |                 |
| 5. Private Claims   |  |   |  | BCDEFGHI   | J K J M         |
| I, ROBERT H. BIRKETT, in a field s<br>requirements of P.A. 74, Michigan P.A.<br>2 above were in conformance with<br>current manual of survey instruction:<br>Bureau of Land Management or by a c<br>mentioned in lines 3, 4 and 5 above<br>Board of Land Surveyors or by a De<br>monumented, re-monumented, recover | of 1970, the corner points<br>regulations and rules the<br>s of the United States D<br>decree of a Court of Law an<br>were in conformance with<br>scree of a Court of Law; e | s mentioned in<br>refore as rece<br>epartment of<br>id /or that the<br>the rules of<br>stablished, re | n lines 1 and puired in the the Interior, comer points 7 the Michigan 8  | -7 - 8 - 9 - 10 - 15 19 - 20 - 21 - 22 - 1 - 30 - 29 - 20 - 27 - 27 - 27 - 27 - 27 - 27 27 - 27 27 - 27 | -1413           |
| NOTE: Not more than 2 comers, all in on this certificate.   | the same town and range, I   | may be record   | ied 11<br>12<br>13   | 31 32 33 34  | 35—36           |
| A. Description of original monumen<br>L-1, 1817, G. L. O., PRESTON D.S.<br>(a) 1973 R. PATTERSON # 1763   | , SET POST   |   |  |  |                 |
| B. Description of corner evidence of L-1, FOUND ½" IRON, IN HAND HO IRON 0.66' SOUTH OF THE LIINO PREVIOUSLY RECORDED   | OLE, AT THE INTERSECT<br>NE BETWEEN K-13 AND   | TION OF BU<br>L-13, T. 4 N.   | RDON ROAD (S   | OUTH) AND 26 MILE ROA  | MASPINALT.      |
| FIELD MEASUREMENTS  |  |   |  | BIRI<br>PROFE  | KETT *          |
| K-1 TO L-1  |  | L-1 TO M-1  | 1  | SURV.  | EYOR E          |
| 1817, G. L. O 40 CHAINS - 2640'<br>2000, REMONUMENTATION - 2647   | '.79'  | MACOMB  | . O 40 CHAIN<br>COUNTY TAX N<br>IONUMENTATION  | IAP - 5061.69'   | SIONAL STREET   |
| C. Description of monument for co<br>L-1, REPLACED1/2" IRON WITH A<br>MONUMENT, MI ACT 345,L-1" IN A<br>R. 14 E., LENOX TOWNSHIP.   | 3/4" x 24" RE-BAR CAPP   | ED WITH A   | V ALUMINUM C   | AP STAMPED "MACOMB (   | YTNUOX          |
| AZ. 165° 126.25' SET REMON<br>AZ. 185° 51.21' SET REMON<br>AZ. 320° 45.82' SET REMON<br>AZ. 270° 353.04' K-13, T. 4 N.  | N TAG ABOVE FOUND PIN TAG IN THE WEST FAC<br>N TAG IN THE WEST ENIN<br>N TAG IN THE SOUTHWE<br>I., R. 14 E., LENOX TOWN<br>FFT IN PLACE)                                     | CE OF A GR<br>D OF AN 18"<br>EST FACE O   | OUP OF 4" ELM<br>CORRUGATED  | METAL PIPE.  | ITY POLE.       |
| THE SELECTED LOCATION IS AC<br>THE BEST AVAILABLE EVIDENCE  | CEPTED BY ME AND IS<br>OF THE POSITION OF  | GENERALLY<br>THE ORIGIN   | Y ACCEPTED B<br>AL CORNER.   | / PROFESSIONAL SURVE   | YORS AS         |
| 7.110   |  |   | ,, ,   | - 1  |                 |
| Signed by A b. H.   | <del>- 1612</del>  | Date  | 11-30  | -01  |                 |
| Surveyor's Michigan License No  | 41094  |   |  |  |                 |



## LAND CORNER RECORDATION CERTIFICATE

FILING REQUIREMENT OF ACT 74, MICH. F.A.1970

|        | Chesterfield  | Township   | LIBER 23   | 80 page $49$   | б   | A176340  |
|--------|---|--|--|--|---|--|
| 1      | FOR CORNERS OF -:   | LOCATED IN -:  | : '  | CORNER CODE  | NUMBER  | •  |
|        | 1. PUBLIC LAND SURVEY   | T3\$\frac{N}{2}, R   | 14 K   | Kl, Ll,  | K2, L2  |  |
|        | A DOOD DEV CONTROL  | N  | L L  |  |   | RECORDED IN MACOMB COUNT   |
|        | 2. PROPERTY CONTROLL-<br>ING IN SECTION—  | ,T S., R   | W.   | ———  | <del></del>   | MAR 2.7 1973   |
|        | 3. MISCEL LANEOUS<br>PROPERTY IN SECTION —  | ,Т <sup>N.</sup> R   | E E:   |  |   | MAR 4 ( 1973   |
|        | 4, LOT NO, RE   | CORNED DLAT  | •  |  |   | Ed m Blok  |
|        | 4, LO1 NO , KE  | COROLD PROT  |  |  |   | CLERK - Rock on the on on the  |
| •      | 5. PRIVATE CLAIMS   | - 40   |  |  |   | REGISTER OF DEIDS STAMP AND  |
|        | the corner points mentioned field survey on Februarestored as expressed below of survey instructions of the court of law. Furthermo   | in lines 1 and 2<br>ary 5 1973,<br>and in conformance<br>United States Depart, that the corne  | above (ident<br>established,<br>e with regul-<br>partment of the<br>points me<br>t, restored, es | ified with dire<br>re-established<br>actions and rule<br>he In erion Bur<br>nctioned in line<br>stablished or re | les on index  I, monumente  s therefore as  cau of Land i  es 3, 4 and 5 stablished | A, 74, Michigan P.A. of 1970. ode diagram—over) were, in a correquired in the current manual anagement or by a decree of a pove were, in a field survey on a expressed below and in con- |
|        | formance with the rules of law:   | the Michigan State   | Board of Re  | gistrition for I   | and Surveyor  | or, by a Decree of a Court of  |
|        |   |  | //   |  |   |  |
|        | A. Description of original m  | nonument and acces   | socies and/  | or subsequant i  | ( :toration;  | •  |
|        |   |  |  |  |   |  |
|        |   |  |  |  |   |  |
|        | B. Description of corner ev   | idence found and/o   | r method app   | olied in restoris  | n or re-estab   | ishing corner:   |
|        |   |  |  |  |   |  |
|        |   | •  |  |  |   |  |
|        |   |  |  |  |   |  |
|        |   |  |  |  |   |  |
|        |   |  |  |  |   |  |
|        |   |  |  | ·  |   |  |
|        | 1/2" Rod in Hand<br>P.K. nail in Util<br>S.E'lv - 74.71 ft  | Hole - Witn<br>Lity Pole N.:   | ess - P.<br>E'ly - 9   | K. nail i<br>7.44 ft.  | P.K. na   | .1 in Utality Pole   |
|        | 1/2" Rod in Hand<br>P.K. nail in Util<br>S.E'ly - 74.71 ft<br>P.K. nail - Witne<br>nail in Utility E  | Hole - With<br>Lity Pole N.<br>L.<br>ess - P.K. n  | ess - P.<br>E'ly - 9<br>ail in U   | K. mail 1<br>7.44 ft.<br>Tility Po   | P.K. na   | $xe^{-x}M^{*}M^{*}N^{*}N = \sqrt{2^{*}}O2^{-x}$  |
| -      | 1/2" Rod in Hand<br>P.K. nail in Util<br>S.E'ly - 74.71 ft<br>P.K. nail - Witne<br>nail in Utility M<br>93.89 ft.<br>Tron - Witness -   | Hole - Withdlity Pole N.: ess - P.K. n. Pole N.E'ly P.K. nail i  | ess - P.<br>E'ly - 9<br>ail in U<br>- 78.80<br>n 12" Tr  | K. nail 1<br>7.44 ft.<br>Iti ity Po<br>ft P.K.   | P.K. na ie N.W'l ail in   | 7 - 53.81 ft. P.K. 77 Tree, S.E'ly - 5t. P.K. nail in 12"  |
| -<br>- | 1/2" Rod in Hand P.K. nail in Util S.E'ly - 74.71 ft P.K. nail - Witne nail in Utility P 93.89 ft. Iron - Witness - Tree, S.E'ly - 23   | Hole - Withelity Pole N.: ess - P.K. n. Pole N.E'ly P.K. nail i 1.22 ft. P.K   | ess - P.<br>E'ly - 9<br>ail in U<br>- 78.80<br>n 12" Tr  | K. nail 17.44 ft.  tility Poft P.K.  ee N.E'l n 12" Fre  | P.K. na ie N.W'l ail in 23.72 , S.W'l   | 7 - 53.81 ft. P.K. 17 Tree, S.E'ly - 1t. P.K. nail in 12" 7 - 28.41 ft.  |
| -<br>- | 1/2" Rod in Hand P.K. nail in Util S.E'ly - 74.71 ft P.K. nail - Witne nail in Utility P 93.89 ft. Iron - Witness - Tree, S.E'ly - 2: Tron - Witness -  | Hole - Withelity Pole N.: ess - P.K. n. Pole N.E'ly P.K. nail i 1.22 ft. P.K. P.K. nail i  | ess - P.<br>E'ly - 9<br>ail in U<br>- 78.80<br>n 12" Tr<br>. nail i<br>n 12" Tr                  | K. nail 17.44 ft.<br>ft lity Poft P.K.<br>ee N.E'l<br>n 12" Fre  | P.K. na  e N.W'l ail in  23.72 , s.W'l 34.23  | 1 in Utility Pole  7 - 53.81 ft. P.K.  17" Tree, S.E'ly -  1t. P.K. nail in 12"  7 - 28.41 ft.  1t. P.K. nail in uti   |
| -<br>- | 1/2" Rod in Hand P.K. nail in Util S.E'ly - 74.71 ft P.K. nail - Witne nail in Utility B 93.89 ft. Iron - Witness - Tree, S.E'ly - 2: Iron - Witness - ity Pole N.E'ly  | Hole - Withdlity Pole N.: ess - P.K. n. Pole N.E'ly  P.K. nail i 1.22 ft. P.K P.K. nail i 34.34 ft. P.                               | ess - P.<br>E'ly - 9<br>ail in U<br>- 78.80<br>n 12" Tr<br>n 12" Tr<br>K. nail                   | K. hail 17.44 ft.  Itility Poft P.K.  Ree N.E'l n 12" Free N.N'l in Utilit                                       | P.K. na  ie N.W'l ail in 23.72 , s.W'l 34.23 Pole S                                 | 7 - 53.81 ft. P.K. 7 Tree, S.E'ly -  1t. P.K. nail in 12" 7 - 28.41 ft. 1t. P.K. nail in uti W'ly 140.95 ft.   |
| -<br>- | 1/2" Rod in Hand P.K. nail in Util S.E'ly - 74.71 ft P.K. nail - Witne nail in Utility B 93.89 ft. Iron - Witness - Tree, S.E'ly - 2: Iron - Witness - ity Pole N.E'ly SIGNED BY  | Pole - With<br>lity Pole N.<br>ess - P.K. n.<br>Pole N.E'ly<br>P.K. nail i<br>1.22 ft. P.K<br>P.K. nail i<br>34.34 ft. P.            | ess - P.<br>E'ly - 9<br>ail in U<br>- 78.80<br>n 12" Tr<br>. nail i<br>n 12" Tr<br>K. nail       | K. nail 17.44 ft.  Tti ity Poft P.K.  Tee N.E'l  in Utilit   | P.K. na  ie N.W'l ail in 23.72 , s.W'l 34.23 Pole S                                 | 7 - 53.81 ft. P.K. 7 Tree, S.E'ly -  1t. P.K. nail in 12" 7 - 28.41 ft. 1t. P.K. nail in uti W'ly 140.95 ft.   |
| -<br>- | 1/2" Rod in Hand P.K. nail in Util S.E'ly - 74.71 ft P.K. nail - Witne nail in Utility B 93.89 ft. Iron - Witness - Tree, S.E'ly - 2: Iron - Witness - ity Pole N.E'ly  | Pole - With<br>lity Pole N.<br>ess - P.K. n.<br>Pole N.E'ly<br>P.K. nail i<br>1.22 ft. P.K<br>P.K. nail i<br>34.34 ft. P.            | ess - P.<br>E'ly - 9<br>ail in U<br>- 78.80<br>n 12" Tr<br>. nail i<br>n 12" Tr<br>K. nail       | K. nail 17.44 ft.  Tti ity Poft P.K.  Tee N.E'l  in Utilit   | P.K. na  ie N.W'l ail in 23.72 , s.W'l 34.23 Pole S                                 | in Utility Pole  7 - 53.81 ft. P.K.  17 Tree, S.E'ly -  it. P.K. nail in 12"  7 - 28.41 ft.  it. P.K. nail in uti  W'ly 140.95 ft.  PATERSON  PATERSON                                   |
| -<br>- | 1/2" Rod in Hand P.K. nail in Util S.E'ly - 74.71 ft P.K. nail - Witne nail in Utility B 93.89 ft. Iron - Witness - Tree, S.E'ly - 2: Iron - Witness - ity Pole N.E'ly SIGNED BY  | Pole - Withelity Pole N  ess - P.K. n.  Pole N.E'ly  P.K. nail i 1.22 ft. P.K  P.K. nail i 34.34 ft. P.  REGISTRATION N              | ess - P.<br>E'ly - 9<br>ail in U<br>- 78.80<br>n 12" Tr<br>. nail i<br>n 12" Tr<br>K. nail       | K. nail 17.44 ft.  Tti ity Poft P.K.  Tee N.E'l  in Utilit   | P.K. na  ie N.W'l ail in 23.72 , s.W'l 34.23 Pole S                                 | in Utility Pole  7 - 53.81 ft. P.K.  27" Tree, S.E'ly -  it. P.K. nail in 12"  7 - 28.41 ft.  it. P.K. nail in uti  W'ly 140.95 ft.  CAND  PATIERSON  LAND  SURVEYOR  SURVEYOR           |
| -<br>- | 1/2" Rod in Hand P.K. nail in Util S.E'ly - 74.71 ft P.K. nail - Witne nail in Utility H 93.89 ft. Iron - Witness - Tree, S.E'ly - 2: Iron - Witness - ity Pole N.E'ly SIGNED BY SURVEYOR'S MICHIGAN FOR STATE AND UNITED                               | Pole - Withelity Pole N ess - P.K. n. Pole N.E'ly  P.K. nail i 1.22 ft. P.K. P.K. nail i 34.34 ft. P.  REGISTRATION N  STATES AGENCY | ess - P.<br>E'ly - 9<br>ail in U<br>- 78.80<br>n 12" Tr<br>. nail i<br>n 12" Tr<br>K. nail       | K. nail 17.44 ft.  ti ity Poft P.K.  ee N.E'l n !2" Free N.W'l in Utilit   | P.K. na e N.W'l ail in 23.72 , S.W'l 34.23 Pole S                                   | in Utility Pole  7 - 53.81 ft. P.K.  27" Tree, S.E'ly -  it. P.C. nail in 12"  7 - 28.41 ft.  it. P.K. nail in uti  W'ly 140.95 ft.  Cuartes of 1800.  ROBERT J.  PATIERSON LAND         |
| -<br>- | 1/2" Rod in Hand P.K. nail in Util S.E'ly - 74.71 ft P.K. nail - Witne nail in Utility B 93.89 ft. Iron - Witness - Tree, S.E'ly - 2: Iron - Witness - ity Pole N.E'ly SIGNED BY SURVEYOR'S MICHIGAN FOR STATE AND UNITED SIGNED BY                     | Pole - Withdright Pole N. 1.  Pole N.E'ly  P.K. nail i 1.22 ft. P.K  P.K. nail i 34.34 ft. P.  REGISTRATION N  STATES AGENCI         | ess - P.<br>E'ly - 9<br>ail in U<br>- 78.80<br>n 12" Tr<br>. nail i<br>n 12" Tr<br>K. nail       | K. nail 17.44 ft.  ti ity Po ft P.K.  ee N.E'l n '2" Fre ee N.W'l in Utilit                                      | P.K. na e N.W'l ail in 23.72 , S.W'l 34.23 Pole S                                   | in Utility Pole  7 - 53.81 ft. P.K.  17 Tree, S.E'ly -  it. P.K. nail in 12"  7 - 28.41 ft.  it. P.K. nail in uti  W'ly 140.95 ft.  ROBERT J.  PATIERSON  LAND  SURVEYOR  NO.  17631     |
| -<br>- | 1/2" Rod in Hand P.K. nail in Util S.E'ly - 74.71 ft P.K. nail - Witne nail in Utility H 93.89 ft. Iron - Witness - Tree, S.E'ly - 2: Iron - Witness - ity Pole N.E'ly SIGNED BY SURVEYOR'S MICHIGAN FOR STATE AND UNITED SIGNED BY APPROVED AND SIGNED | Pole - Withdlity Pole N  | ess - P.<br>E'ly - 9<br>ail in U<br>- 78.80<br>n 12" Tr<br>. nail i<br>n 12" Tr<br>K. nail       | K. nail 17.44 ft.  ti ity Po ft P.K.  ee N.E'l n '2" Fre ee N.W'l in Utilit                                      | P.K. na e N.W'l ail in 23.72 , S.W'l 34.23 Pole S                                   | in Utility Pole  7 - 53.81 ft. P.K.  17 Tree, S.E'ly -  it. P.K. nail in 12"  7 - 28.41 ft.  it. P.K. nail in uti  W'ly 140.95 ft.  ROBERT J.  PATIERSON  LAND  SURVEYOR  NO.  17631     |
| -<br>- | 1/2" Rod in Hand P.K. nail in Util S.E'ly - 74.71 ft P.K. nail - Witne nail in Utility B 93.89 ft. Iron - Witness - Tree, S.E'ly - 2: Iron - Witness - ity Pole N.E'ly SIGNED BY SURVEYOR'S MICHIGAN FOR STATE AND UNITED SIGNED BY                     | Pole - Withdlity Pole N  | ess - P.<br>E'ly - 9<br>ail in U<br>- 78.80<br>n 12" Tr<br>. nail i<br>n 12" Tr<br>K. nail       | K. nail 17.44 ft.  ti ity Po ft P.K.  ee N.E'l n '2" Fre ee N.W'l in Utilit                                      | P.K. na e N.W'l ail in 23.72 , S.W'l 34.23 Pole S                                   | in Utility Pole  7 - 53.81 ft. P.K.  17 Tree, S.E'ly -  it. P.K. nail in 12"  7 - 28.41 ft.  it. P.K. nail in uti  W'ly 140.95 ft.  PATIERSON  LAND  SURVEYOR  NO.  17631                |

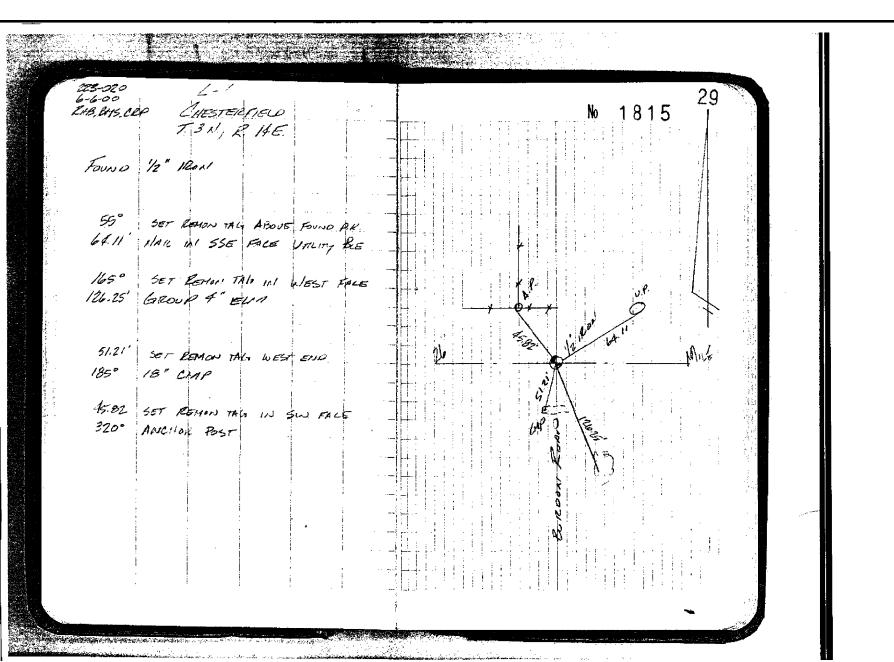

STAIF: 1" - 156

M -MENSONED

N -ARCONDED

C -CALCULATED

FOR DAVE DE GREGORY

JOB MO. 347-86 DAVE 6-25-86

SCALE 1"= 150' SHEET 1 of 2

DRAWN BY H.J.K. CHECKED BY D.H.K.

Part of the North 1/2 of N.E.1/4 of Fractional Section 1, Town 3 North, Range 14 East, Chesterfield Township, Macomb County, Michigan.

Note: Bearings relate to description of record for delineated parent parcel.

26 MILE RD. (66'WD.) delineated parent parcel. NATON'ZOW N 89°54'20"W 393.00 N. LINE SEC. 1. 98.25 2004.78 78.75 CC4.92 PIPE N.E. COR. SEC. 1, T. 3 N., R. 14 L 2 CHESTERFIELD TUP. (T-1804) NU MONT BOX) FORM NAIL & CAP # 5787 IN POWER PALE- HIN- 5469 PORM NAIL & CAP & STAT IN PROMER POLE- N.E. GOLO FORM MAIL & CAP & STAT IN BELL TET. POLE-Note: Set stakes along side lines of parcels. RECORDED IN MACOMB COUNTY RECORDS AT: 12:10P AC.) MARIS 1987 S S b ø 62 Θ Ø ķω 9 CLERK - REGISTER OF DEEDS તાં ∖ં તાં ď I hereby certify that I have surveyed the parcel(a) of land described and delinested hereon; that cell! Survey ۵ was performed with an error of closure no granter than 1 in 5000; and that I have fully compiled with 1 the requirements of Section 3, Act 132, P.A. 1970. CE RCE CE Neder of Bala C. For 61.00 ARC Δ; 00 Herbert J. Kobs 30 00 Registered Land Surveyor ⋖ ⋖ ¥ ت در ٦, Michigan Registration No. 14097 J. KOBS ND SURVEYO No. 25.96

CONSUMERS GAS CO. R.O.W. (166'WD.)

KOBS-KING & ASSOC. INC.

LAND SURVEYING SITE PLANNING