LAND CORNER RECORDATION CERTIFICATE

189010 LIBER 9885 PAGE 1 Filing Requirement of Act 74, Mich. P.A. 1970 12:40:42 P.M. 11/17/2000 MACOMB COUNTY, MI CARMELLA SABAUGH, REG/DEEDS

MACOMB (County)	IRA TOWNSHIP Located In:	Corner Code #
1. Public Land Survey	TR TR TR TR	
Property Controlling in Section Miscellaneous Property in Sec.	S7 T 3N R 15E S T R S T R S T R	

Register of Deeds Stamp & File Number

		PCS.	005
4. Lot No, Records	ed Plat		
5. Private Claims 627			

I, ROBERT H. BIRKETT, in a field survey on JUNE 6, 2000 do hereby certify that under requirements of P.A. 74, Michigan P.A. of 1970, the corner points mentioned in lines 1 and 2 above were in conformance with regulations and rules therefore as required in the current manual of survey instructions of the United States Department of the Interior, Bureau of Land Management or by a decree of a Court of Law and /or that the corner points mentioned in lines 3, 4 and 5 above were in conformance with the rules of the Michigan Board of Land Surveyors or by a Decree of a Court of Law; established, re-established, monumented, re-monumented, recovered, found as expressed below:

NOTE: Not more than 2 comers, all in the same town and range, may be recorded on this certificate.

A 1 \vdash	B (a 5	E F	G H	I J	K L M
2 -	- 6	-5-	4-4-		<u>2</u> -	
3 -	-1-	8-		10-	11-	12
	9	H	\mathbb{H}	+	$\overline{+}$	4-
б 7	-18-	-17-	16	15-	14	13-
8	 _19-— 	20-	21-	22-	23	24
9 10-	_30_	29	28	27-	26	25
11-	+		+	+		
12	-31	32-	33	34	35	36

BIRKET

4109

POFESSIONA

A. Description of original monument and accessories and/or subsequent restoration: INTERSECTION OF MACOMB COUNTY LINE AND THE NORTHWESTERLY LINE OF PRIVATE CLAIM 627. CORNER NOT SET BY G. L. O.

"ASSESSOR'S COUNTY LINE PLAT" RECORDED IN LIBER

B. Description of corner evidence found and/or method applied in restoring or reestablishing corner: INTERSECTION OF MACOMB COUNTY LINE AND THE NORTHERLY LINE OF PRIVATE CLAIM 627. SET MONUMENT AT RECORD DISTANCE FROM THE NORTHEAST CORNER OF PRIVATE CLAIM 627 REFERENCING E OF MICHIGA "ANDREWS BY THE BAY" AS RECORDED IN L. 130 OF PLATS, P. 20, M.C.R.

FIELD MEASUREMENTS

TO NORTHEASTERLY CORNER PRIVATE CLAIM 627.

G. L. O. - NO RECORDED MEASUREMENT. (1998) J. FENN - 1163.59'. (2000) REMON - 1163.59'

TO NORTHEASTERLY CORNER P. C. 614 AND THE NORTHWESTERLY CORNER P. C. 627.. G. L. O. - NO RECORDED MEASUREMENT. (2000) REMON -1275.66'


C. Description of monument for corner and accessories established to perpetuate locating the position of the corner: INTERSECTION OF MACOMB COUNTY LINE AND THE NORTHERLY LINE OF PRIVATE CLAIM 627. SET 1/2" X 36" RE-BAR ENCASED IN CONCRETE CAPPED WITH AN ALUMINUM CAP STAMPED "MACOMB COUNTY MONUMENT, MI ACT 345, P. C. C., 41094", RECORD DISTANCE FROM THE NORTHEASTERLY CORNER PRIVATE CLAIM 627.

		designation of the second seco	
AZ. AZ. AZ.	105° 170° 210°	23.19' SET NAIL WITH REMON TAG IN SOUTH FACE 6" ELM. 18.12' SET NAIL WITH REMON TAG IN SOUTHWEST FACE 6" ELM.	ACCEPTED BY THE MACOMB COUNTY SURVEY PEER GROUP AS THE OFFICIAL CORNER UNDER MICHIGAN PUBLIC ACT 345 OF 1990 AT A MEETING HELD ON

THE SELECTED LOCATION IS ACCEPTED BY ME AND IS GENERALLY ACCEPTED BY PROFESSIONAL SURVEYORS AS THE BEST AVAILABLE EVIDENCE OF THE POSITION OF THE ORIGINAL CORNER.

Ch 2		
Signed by Robert H - Britis	Date	
Surveyor's Michigan License No. 4/094		
	EUDIN V DDBUARU BA WICHIGAN SA	TATE R

BOARD OF LAND SURVEYORS, JAN. 28, 1971 REVISED MAY 14,1975, REVISED JAN., 1983, REVISED OCT., 1996

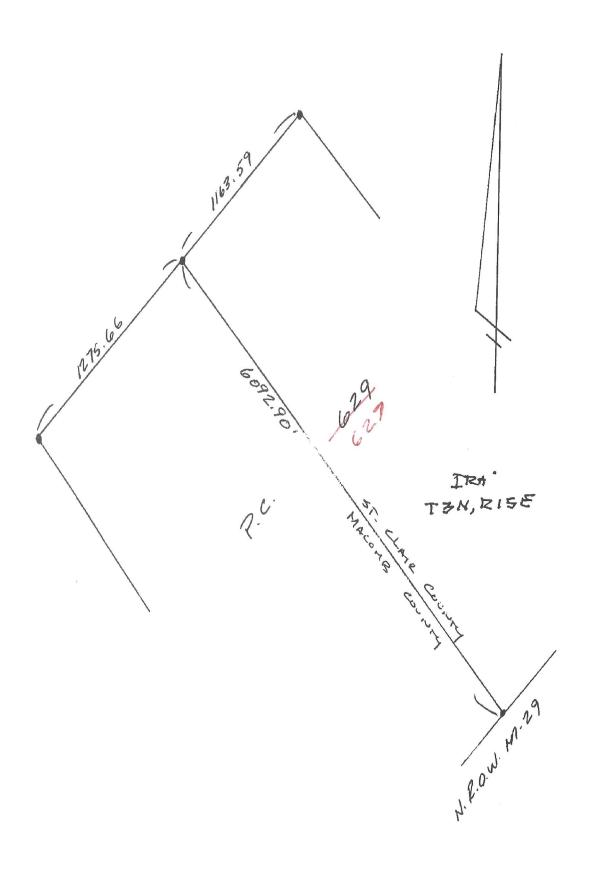

-