

LAND CORNER RECORDATION CERTIFICATE
 Filing Requirement of Act 74, Mich. P.A. 1970

For corners in

MACOMB
 (County)

IRA TOWNSHIP
 Located In: Corner Code #

1. Public Land Survey T 3N R 15E A-6
 T R
 T R
 T R

2. Property Controlling S T R
 in Section S T R

3. Miscellaneous S T R
 Property in Sec. S T R

4. Lot No. _____, Recorded Plat _____

5. Private Claims _____

2271240
 LIBER 12468 PAGE 290
 11/15/2002 12:36:01 P.M.
 MACOMB COUNTY, MI SEAL
 CARMELLA SABAUGH, REGISTER OF DEEDS

2282791
 LIBER 12535 PAGE 523
 11/26/2002 01:40:15 P.M.
 MACOMB COUNTY, MI SEAL
 CARMELLA SABAUGH, REGISTER OF DEEDS

I, ROBERT H. BIRKETT, in a field survey on July, 2002 do hereby certify that under requirements of P.A. 74, Michigan P.A. of 1970, the corner points mentioned in lines 1 and 2 above were in conformance with regulations and rules therefore as required in the current manual of survey instructions of the United States Department of the Interior, Bureau of Land Management or by a decree of a Court of Law and /or that the corner points mentioned in lines 3, 4 and 5 above were in conformance with the rules of the Michigan Board of Land Surveyors or by a Decree of a Court of Law; established, re-established, monumented, re-monumented, recovered, found as expressed below:

NOTE: Not more than 2 corners, all in the same town and range, may be recorded on this certificate.

A. Description of original monument and accessories and/or subsequent restoration:
 A-6 IRA
 1817, PRESTON GLO, SET WOOD POST, GENERAL LAND OFFICE FILE NOTES.

B. Description of corner evidence found and/or method applied in restoring or reestablishing corner:
 A-6 IRA - SET CORNER AT A PRORATED DISTANCE OF 1347.63 FEET FROM THE INTERSECTION OF THE EAST LINE OF CHESTERFIELD TOWNSHIP AND THE SOUTH LINE OF P. C. 614, ALSO THE RIGHT OF WAY IRONS ON THE WEST SIDE OF COUNTY LINE ROAD BETWEEN GREEN STREET AND MAIN STREET.
 CORNER IS COMMON TO A-6, IRA TOWNSHIP, TOWN 3 NORTH, RANGE 15 EAST.
 M-6, CHESTERFIELD TOWNSHIP, TOWN 3 NORTH, RANGE 14E **

FIELD MEASUREMENTS
 A-6 TO THE INTERSECTION OF THE EAST LINE OF CHESTERFIELD TOWNSHIP AND THE SOUTH LINE OF P. C. 614.
 GLO (1817) 19.95 CHAINS (1316.70')
 REMON (2002) 1347.63'


*BEING RERECORDED TO CORRECT R14E TO R15E AND DATE SIGNED.

**Being rerecorded to correct section B reference to common corner.
 C. Description of monument for corner and accessories established to perpetuate locating the position of the corner:
 A-6 IRA SET A 3/4" RE-BAR WITH A 2" DIAMETER ALUMINUM CAP STAMPED "MACOMB COUNTY MONUMENT, MI ACT 345, PCC, IN A NEW MONUMENT BOX.

- 30° - 35.75' - SET NAIL WITH REMON TAG NORTHWEST FACE TELEPHONE POLE.
- 105° - 56.85' - SET NAIL WITH REMON TAG IN SOUTHWEST FACE 10" PINE.
- 210° - 58.73' - SET NAIL WITH REMON TAG NORTHWEST FACE 10" OAK.
- 340° - 56.91' - SET NAIL WITH REMON TAG IN NORTHEAST FACE UTILITY POLE.

THE SELECTED LOCATION IS ACCEPTED BY ME AND IS GENERALLY ACCEPTED BY PROFESSIONAL SURVEYORS AS THE BEST AVAILABLE EVIDENCE OF THE POSITION OF THE ORIGINAL CORNER.

BY THE MACOMB COUNTY SURVEY PEER
 AS THE OFFICIAL CORNER UNDER MICHIGAN
 ACT 345 OF 1990 AT A MEETING HELD
 9/24/02 A.D.
 William E. Soderberg
 WILLIAM E. SODERBERG, P.S., CHAIRMAN

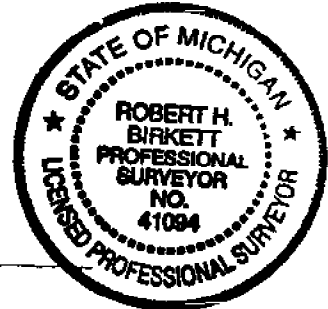

Signed by Robert H. Birkett Date 10/31/02
 Surveyor's Michigan License No. 41094

	A	B	C	D	E	F	G	H	I	J	K	L	M
1													
2	6			5			4		3			2	1
3													
4	7			8			9		10			11	12
5													
6	18			17			16		15			14	13
7													
8	19			20			21		22			23	24
9													
10	30			29			28		27			26	25
11													
12	31			32			33		34			35	36
13													