







RECD MACOMB CO 12SEP14AM0817

Page 1 of 2

RECD MACOMB CO 12OCT25AM0904

REMONUMENTATION
LAND CORNER RECORDATION CERTIFICATE
Filing Requirement of Act 74, Mich. P.A. 1970

For corners in

Macomb County Located In: Bruce Township Corner Code M-03

1. Public Land Survey	T	5N	R	12E	M-03
	T		R		
	T		R		
	T		R		
2. Property Controlling in Section	S	T	R		
	S	T	R		
3. Miscellaneous Property in Sec.	S	T	R		
	S	T	R		

4. Lot No. _____ Recorded Plat _____

5. Private Claims _____

I, Huston K. Kennedy, in a field survey on July 3, 2012 do hereby state that under requirements of P.A. 74, Michigan P.A. of 1970, the corner points mentioned in lines 1 and 2 above were in conformance with regulations and rules therefore as required in the current manual of survey instructions of the United States Department of the Interior, Bureau of Land Management or by a decree of a Court of Law and/or that the corner points mentioned in lines 3, 4 and 5 above were in conformance with the rules of the Michigan Board of Land Surveyors or by a Decree of a Court of Law; established, re-established, monumented, recovered, found as expressed below:

NOTE: Not more than 2 corners, all in the same town and range, may be recorded on this certificate.

2147033 PAGE 1 OF 2
LIBER 21658 PAGE 208
10/25/2012 03:14:53 P.M.
MACOMB COUNTY, MI
CARMELLA SABAUGH, REGISTER OF DEEDS
SEAL

2123102 PAGE 1 OF 2
LIBER 21545 PAGE 925
09/14/2012 08:24:46 A.M.
MACOMB COUNTY, MI
CARMELLA SABAUGH, REGISTER OF DEEDS
SEAL

Register of Deeds Stamp & File Number

A	B	C	D	E	F	G	H	I	J	K	L	M
1												
2	6	5	4		3		2		1			
3												
4	7	8	9		10		11		12			
5												
6	18	17	16		15		14		13			
7												
8	19	20	21		22		23		24			
9												
10	30	29	28		27		26		25			
11												
12	31	32	33		34		35		36			
13												

A. Description of original monument and accessories and/or subsequent restoration:

- 1.) 1817-Wampler, D.S., Set Post 12" Sugar Tree East 5 Links; 14" Maple N49°W 14 Links
- 2.) 1817-Preston, D.S., Intersected the town boundary 30 Links south of corner, no witnesses (Armada Township)
- 3.) 1981-Ruszala, RLS #21581; Certificate of Survey L. 3326, pgs. 68-69
- 4.) 1999-Kennedy, PS #17623; LCRC L. 9054, pg. 814 (Bruce Township)
- 5.) 1999-Kennedy, PS #17623; LCRC L. 9054, pg. 817 (Armada Township)

B. Description of corner evidence found and/or method applied in restoring or reestablishing corner:

1999-Kennedy Surveying, Inc. - Huston K. Kennedy, PS #17623 – Vendor for Macomb County prepared a LCRC for M-03, T5N, R12E, Bruce Township, which was reviewed and approved by the Macomb County Survey Peer Group on July 27, 1999 and recorded in Liber 9054, page 814 of Macomb County Records, which resulted in M-03, T5N, R12E, Bruce Township being a common corner with A-03, T5N, R13E, Armada Township. The GLO falling is 30 links or 19.80 feet to the south of the corner, not common.

Ronald John Ruszala, RLS #21581 prepared a Certificate of Survey recorded in Liber 3326, pages 68-69 of Macomb County Records. Ruszala's Certificate of Survey encompasses part of Sections 1 and 12, T5N, R12E, Bruce Township and part of Sections 6 and 7, T5N, R13E, Armada Township. The Certificate of Survey depicts the line between Bruce and Armada Townships, also the intersection of the line between Sections 1 and 12; T5N, R12E, Bruce Township with the line between Bruce and Armada Townships. This would position M-03, T5N, R12E, Bruce Township north of A-03, T5N, R13E, Armada Township,

(cont. on back side of LCRC)

C. Description of monument for corner and accessories established to perpetuate locating the position of the corner:

I set a 4" diameter concrete monument 36" long with a ½" iron rod w/2" diameter aluminum cap stamped "Macomb County Monument, MI Act #345, PS #17623" 12" below the ground surface

N45°E 25.65' Set a capped ½" iron rod stamped #17623 HKK/#40164 SST

S45°E 24.05' Set a capped ½" iron rod stamped #17623 HKK/#40164 SST


S45°W 37.45' Set a capped ½" iron rod stamped #17623 HKK/#40164 SST

N45°W 32.50' Set a capped ½" iron rod stamped #17623 HKK/#40164 SST

East 10' ± centerline of a drainage ditch

S02°E 201.36' Fnd 4" diameter concrete monument w/2" diameter aluminum cap stamped "Macomb County Monument, MI Act #345, PS #17623". Corner common to Sections 6 & 7, T5N, R13E, Armada Township (A-03)

The selected location is accepted by me and is generally accepted by Professional Surveyors as the best available evidence of the position of the corner as being perpetuated.

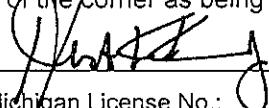Signed by: 


Surveyor's Michigan License No.: 17623

SEPTEMGER 7, 2012
Date August 9, 2012

M.C.O.

FORM APPROVED BY MICHIGAN STATE BOARD OF PROFESSIONAL SURVEYOR'S, JAN. 28, 1971
REVISED MAY 14, 1975
REVISED JAN., 1983
REVISED OCT., 1989

Rerecord to correct
monument set date.

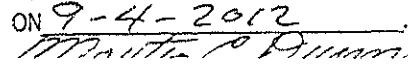ACCEPTED BY THE MACOMB COUNTY SURVEY PEER GROUP AS THE OFFICIAL CORNER UNDER MICHIGAN PUBLIC ACT 345 OF 1990 AT A MEETING HELD ON 9-4-2012


TOWN 5 NORTH, RANGE 12 EAST, BRUCE TOWNSHIP (M-03)

Sec. "B" cont.

Plat book maps for Bruce Township from 1875 to 2006 depicts common ownership in the Southeast $\frac{1}{4}$ of Section 1 and the Northeast $\frac{1}{4}$ of Section 12. This would help explain the lack of occupational features extending east of the $\frac{1}{4}$ corner.


After the completion of the re-measurement of the public land corners in Bruce and Armada Townships, it is my opinion that the approved location of M-03, T5N, R12E, Bruce Township is erroneous and should have been re-established at the intersection of a line from K-03 east thru L-03 with the intersection of a line from M-04 north thru A-03, T5N, R13E, Armada Township. This will result in the following:

- 1.) The falling to A-03, T5N, R13E, Armada Township would be 201.36 feet to the south or 2.986 chains. However, the GLO calls for a falling of 30 links south of the corner. $201.36 \text{ (falling)} = 2.986 \text{ chains}$
 $67.417 \text{ (index chain)}$

It is my opinion that the GLO for the falling for A-03 T5N, R13E of 30 links is erroneous and there could have been an error made when the notes were transcribed, instead of 30 links it should have been 3 chains.

At a meeting of the Macomb County Survey Peer Group on October 11, 2011. It was the consensus of the peer group to re-establish M-03, T5N, R12E, Bruce Township at the intersection of a line from K-03 projected thru L-03 to the intersection of the line from M-04, T5N, R12E, Bruce Township thru A-03, T5N, R13E, Armada Township in the future.

June 2012 – Kennedy Surveying, Inc., Huston K. Kennedy, PS #17623 – Vendor for Macomb County, re-established M-03, T5N, R12E, Bruce Township. He set a 4" diameter concrete monument 36" long with a $\frac{1}{2}$ " iron rod w/2" diameter aluminum cap stamped "Macomb County Monument, MI Act #345, PS #17623" at the intersection of a line from K-03 east thru L-03 to the intersection of the line from M-04 north thru A-03, T5N, R13E, Armada Township. The corner falls 10' \pm west of a drainage ditch extending to the north and south. There are no occupational features extending to the west due to the common ownership across the section line.

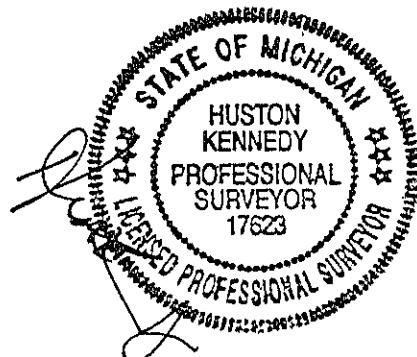

M-03, T5N, R12E, Bruce Township & A-03, T5N, R13E, Armada Township

GLO SURVEY HISTORY MACOMB COUNTY

Researching the government survey records for Macomb County shows that the south and east lines of Bruce Township were surveyed and the township was subdivided into sections with closing corners set on the north and west township lines by Joseph Wampler, D.S. in 1817. The line was ran north 80 chains from corner common to Sections 12 and 13 and set a post common to Sections 1 and 12.

Researching the government survey records for Macomb County shows that the south and east lines of Armada Township were surveyed and the township was subdivided into sections with closing corners set on the north and west township lines by William Preston, D.S. in 1817. The line was ran between Sections 6 and 7 and intersected the township 30 links south of the corner common for Sections 6 and 7.

RECORDED AND UNRECORDED DOCUMENTS

Huston K. Kennedy, PS #17623 prepared a LCRC for M-03, T5N, R12E, Bruce Township that was reviewed and approved by the Macomb County Survey Peer Group on July 27, 1999 and recorded in Liber 9054 on page 814 of Macomb County Records and cites the following: "After a lengthy discussion with the peer group, the corner was recovered on a line between A-03, T5N, R13E, M-04, T5N, R12E, at the distance shown 2515.51 feet as shown on the M.C.P.C. Map for Bruce Township (1-F) which puts this corner 0.18 feet south of A-03 (Armada Twp.). This position was adjusted 0.18 feet to the north and resulting in a common corner with A-03 (Armada Twp.). The corner as recovered is located 10 feet west of a existing ditch extending to the north and south. There are no lines of occupation to the east or west". However, the GLO calls for a falling of 30 links (19.8 ft.) south of the corner, not a common corner.

Huston K. Kennedy, PS #17623 prepared a LCRC for A-03, T5N, R13E, Armada Township that was reviewed and approved by the Macomb County Survey Peer Group on July 27, 1999 and recorded in Liber 9054, page 817 of Macomb County Records. The LCRC cites the following: "The corner was recovered based upon the tax description for Parcel 01-01-400-003 and is located 10 feet west of the center of a ditch extending to the north and south. No line of occupation to the east and west. M-03 (Bruce Township) as recovered, is a common corner with A-03 (Armada Township). I found no other evidence to dispute the recovered position of this corner".

ARMADA TOWNSHIP

The length of the west line as cited on a tax statement for 13-02-06-300-005 is 1829.65 feet, while the length of the west as cited on a tax statement for 13-02-06-100-002 is 1113.92 feet, the combination of the two distances ($1829.65 + 1113.92$) is 2943.57 feet. This distance of 2943.57 feet would validate the position A-02, in a north-south direction from A-01 as approved.

The length of the west line as cited on a tax statement for 13-02-06-300-005 is 1276.08 feet while the length of the west line as cited on a tax statement for 13-02-07-100-009 is 1343.04 feet, the combination of the two distances ($1276.08 + 1343.04$) is 2619.12 feet. This distance of 2619.12 feet would validate the position of A-03 in a north-south direction from A-02 as approved. Also the Point of Beginning for tax statement 13-02-07-100-019 is the northwest corner Section 7 (A-03).

The distance between A-03 to A-04 as cited on Macomb County and Economic Development Map for Armada Township (02-A) is 2652.54 feet and measuring 2652.72 feet. This would validate the position of A-04 in a North-South direction from A-03 as approved.

BRUCE TOWNSHIP

The description for tax statement #14-01-01-400-003 cites the following: "thence North 81°40'35" East 1237.70 feet to east line Section 1; thence Southerly along said east section line to the Northwest Corner Section 7, Armada Township" (A-03).

The GLO distance from M-01 to M-13, T5N, R12E, Bruce Township, Macomb County, Michigan is 12 x 40 chains x 66 feet = 31,680.00 feet. The measured distance between same to two corners as mentioned above is 32,360.25 feet.

$$\text{Calculations for the index GLO chains ("y") } \frac{66}{31,680.00} \times \frac{"y"}{32,360.25 \text{ ft.}} = 67.42$$


The indexed GLO chain = 67.42 feet for the east line of Bruce Township
The indexed GLO $\frac{1}{2}$ mile = 2696.80 feet for the east line of Bruce Township

A line extending east for K-03 thru L-03 and intersecting the east line of Bruce Township will result in a fall between M-03 and A-03 of 201.36 feet. The GLO falling to A-03, T5N, R13E, Armada Township is 30 links or 19.8 feet south of the post.

It is my opinion that the Scribner made an error when the GLO notes were transcribed. Instead of 30 links it should have been 3 chains or 198.00 feet. Using the indexed GLO chain or 67.42 feet, the falling would be 3 chains or $3 \times 67.42 \text{ feet} = 202.26 \text{ feet}$.

At a meeting of the Macomb County Survey Peer Group on October 11, 2011. It was the consensus of the peer group to re-establish M-03, T5N, R12E, Bruce Township at the intersection of a line from K-03 projected thru L-03 to the intersection of the line from M-04, T5N, R12E, Bruce Township thru A-03, T5N, R13E, Armada Township in the future.

The LCRC for M-03, T5N, R12E, Bruce Township was reviewed and approved by the Macomb County Survey Peer Group on August 7, 2012.

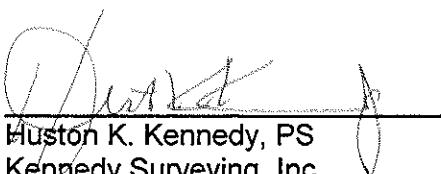

Huston K. Kennedy, PS
Kennedy Surveying, Inc.

HKK/clh

(Revised 08/08/12)

Town of North Range, 12 East

also an Elm 8 in diam. bears S 74 W 20 lbs dist
 38.00 Left 3 sec camp.
 39.73 A. B. Ash 4 in diam.
 40.00 Set. 4 miles from for Corn specium 12+13
 from which an Ash 10 in diam. bears N 20 E 20 lbs distant
 also a B. Ash 16 in diam. bears N 80 W 30 lbs dist
 Land first half mile 1^{1/2} miles east half
Second Timb Buck Alder & Ash Willow + c.

North

27.66 C. Spruce 22 in diam.
 40.00 Set 4 sec. 1st from which
 a Birch 14 in diam. bears N 27 W 7 lbs distant
 also an Elm 5 in diam. bears N 47 E 21 lbs dist
 also Elm 14 in diam.
 40.00 Set 5 miles from for Corn specium 1112 from
 which a Spruce 12 in diam. bears East 5 lbs
 also a Spruce 14 in diam. bears N 19 W 14 lbs distant
 Land first half mile 2^{1/2} miles east land and dry
 last half same

M-03

Timber B. Ash Poplar Birch + c.
 Under growth Birch Hornbeam + c.

North


11.21 A. B. Ash 11 in diam.
 40.00 Set 4 sec. first from which
 a Birch 16 in diam. bears N 48 W 10 lbs distant
 also a Poplar 11 in diam. bears South 65°
 W 27 lbs dist
 Or 12 lbs mile C. S. E.
 an Elm 12 in diam.
 77.00 Or 30 lbs mile S. E.
 80.00 Made out for Township of N.Y. 15 N 5th
Ranges 12+13 East on an Ironwood 11 in
diam. - Land first half mile 2^{1/2} miles
Land and dry last half same

Timber B + W Ash W Oak Sugar Maple + c.

Surveyed 1887 by Joseph M. Miller Esq.

BRUCE

T.5N.-R.12E.

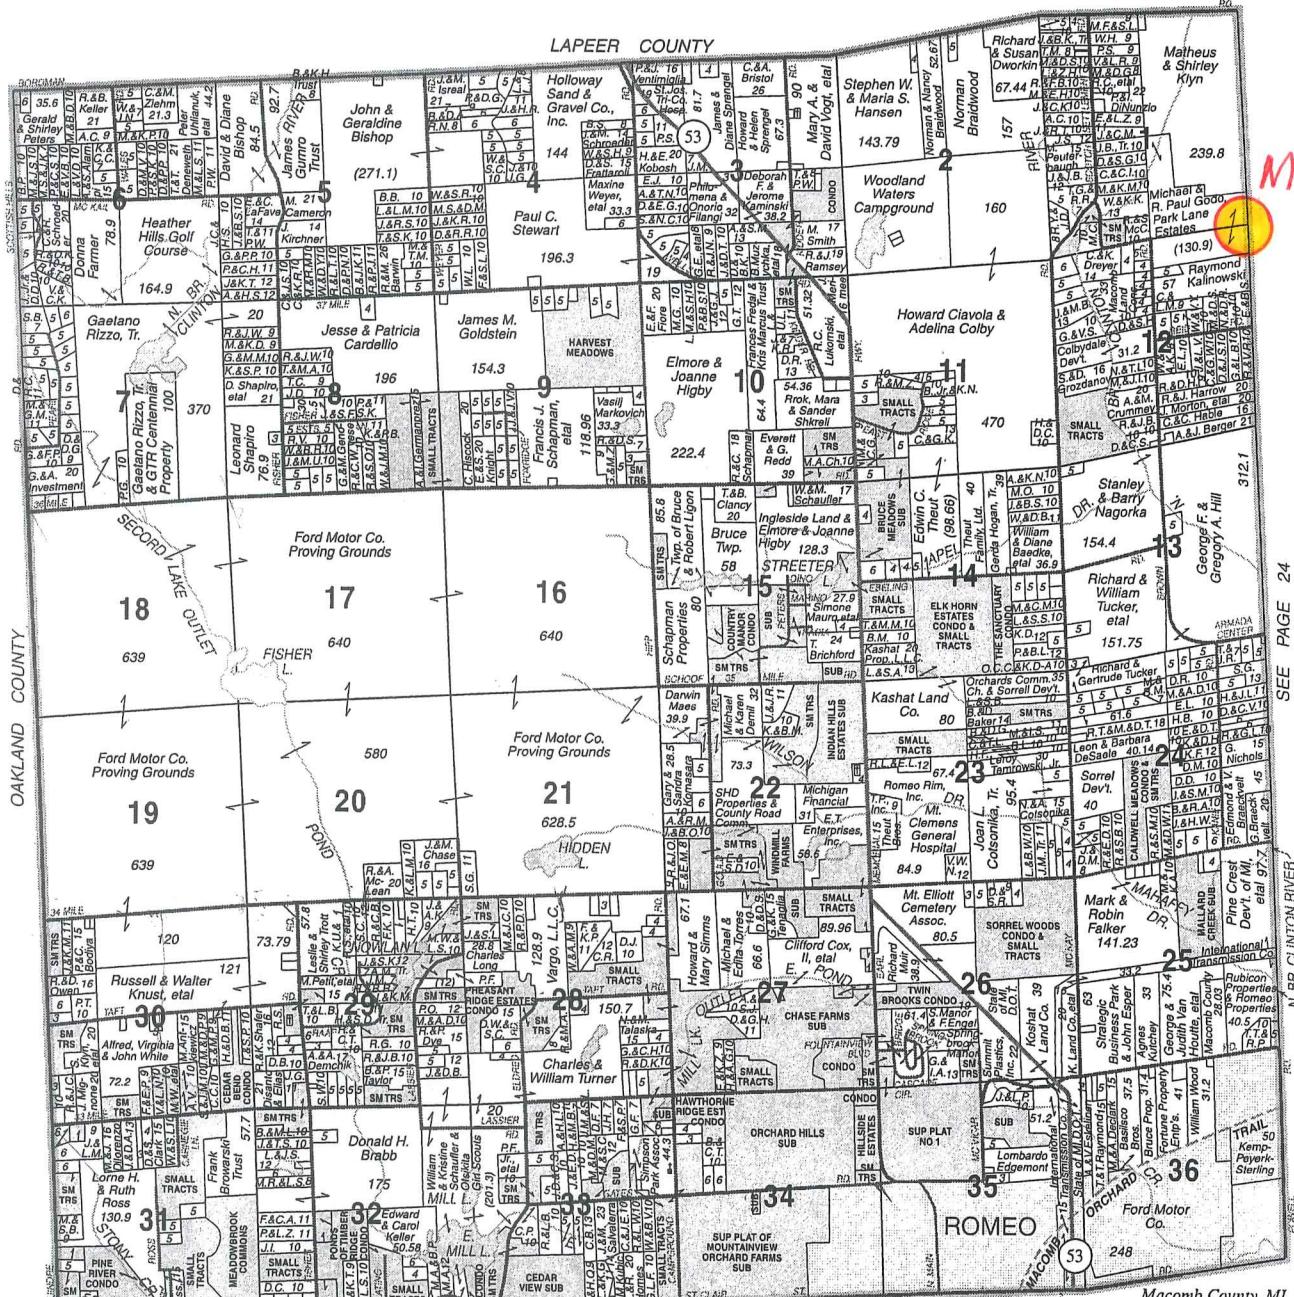

SEE PAGE 24

N. Br. CLINTON RIVER

SEE PAGE 18

© 2006 Rockford Map Publs., Inc.

SERVING MACOMB &
ST. CLAIR COUNTIES

ELMLANDS
REALTY

HOURS: 9-6 MONDAY-SATURDAY
& BY APPOINTMENT




OVER 40 YEARS OF RELIABLE SERVICE

Specializing In:

New & Used Homes - Vacant Property - Farms & Acreage
Industrial Property - Commercial Property Real Estate


586-752-3772

67091 VAN DYKE
ROMEO

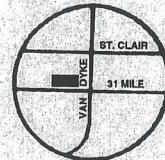

((*MAP OF*) BRUCE *TOWNSHIP*))

TP 5, R.12.

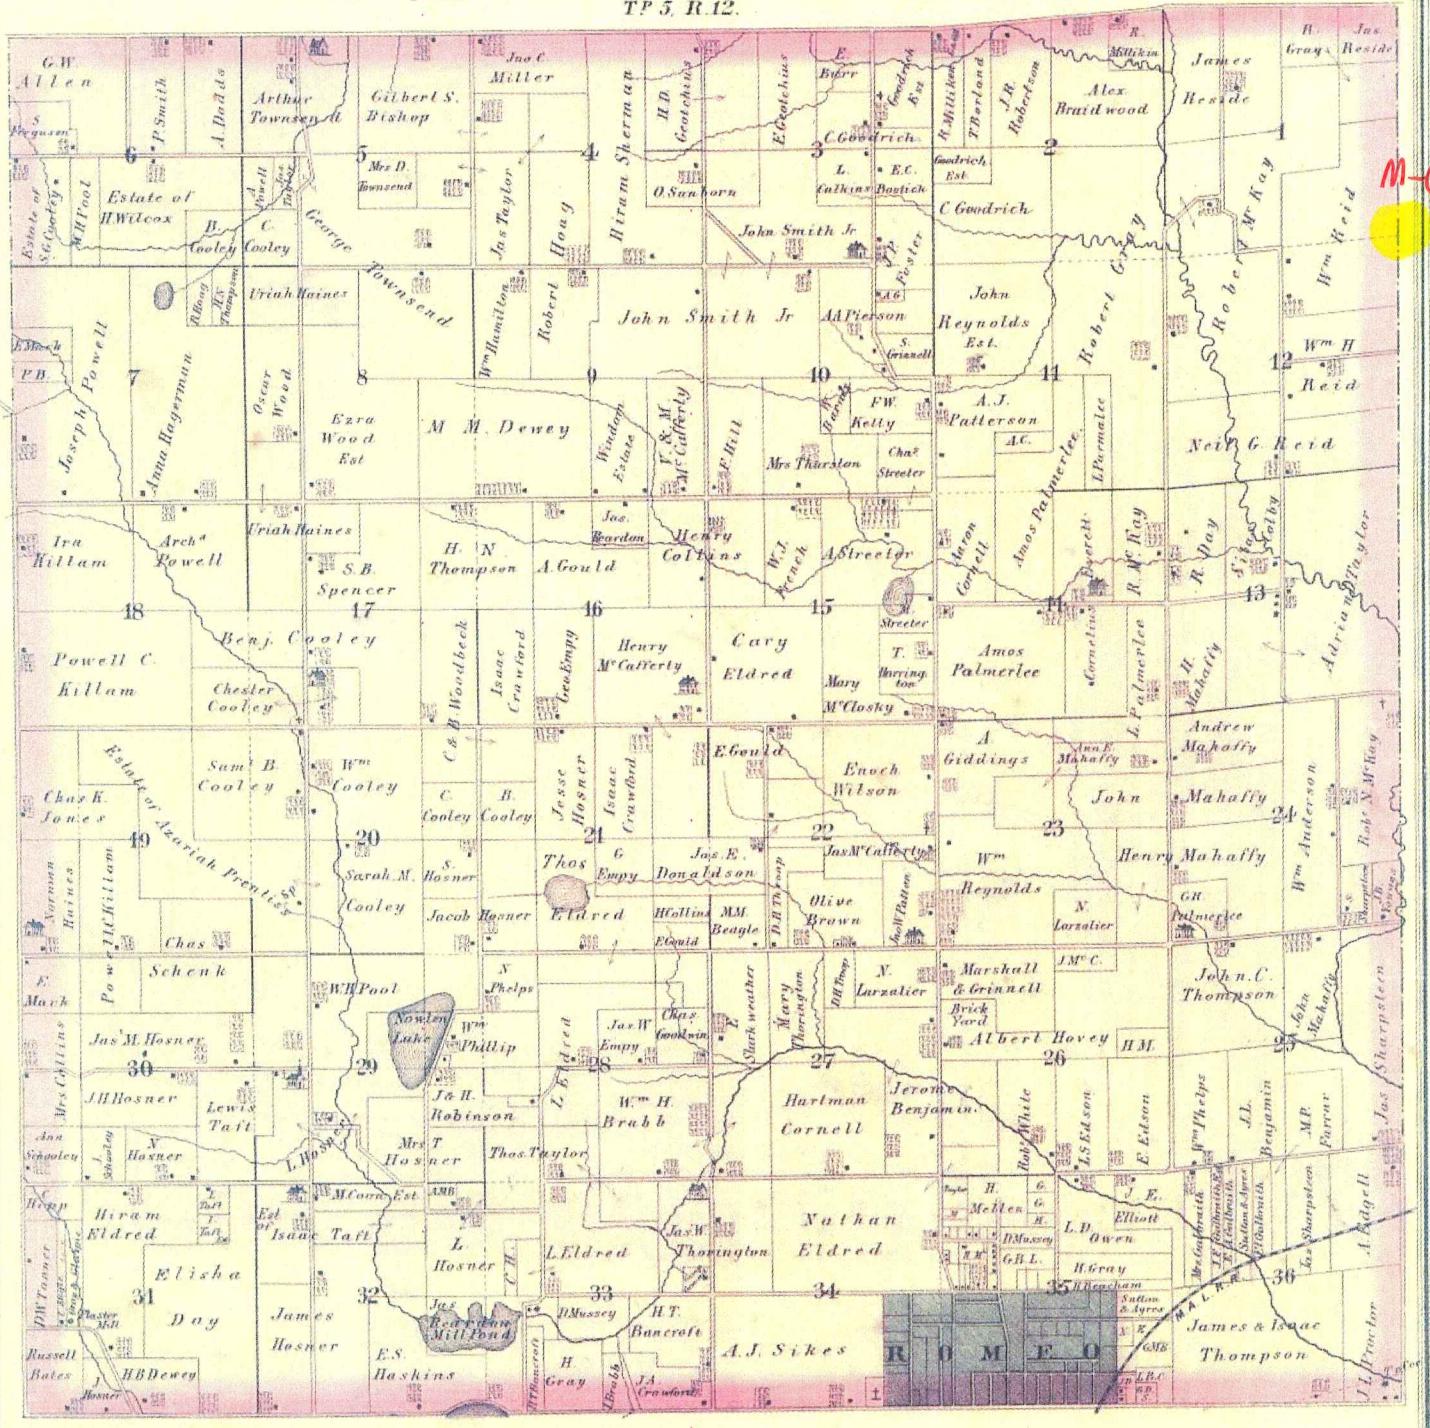


Scanned By:

Searched by:
METCO
Engineers, Architects & Surveyors

Engineers, Architects & Surveyors


1875

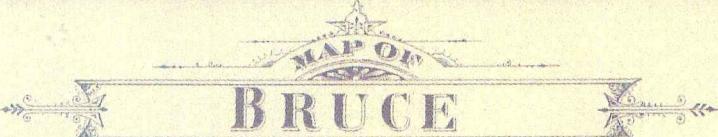
**MAP OF
BRUCE**

Township 5 North Range 12 East

Scale 2 Inches to one Mile.

of the Meridian of Michigan

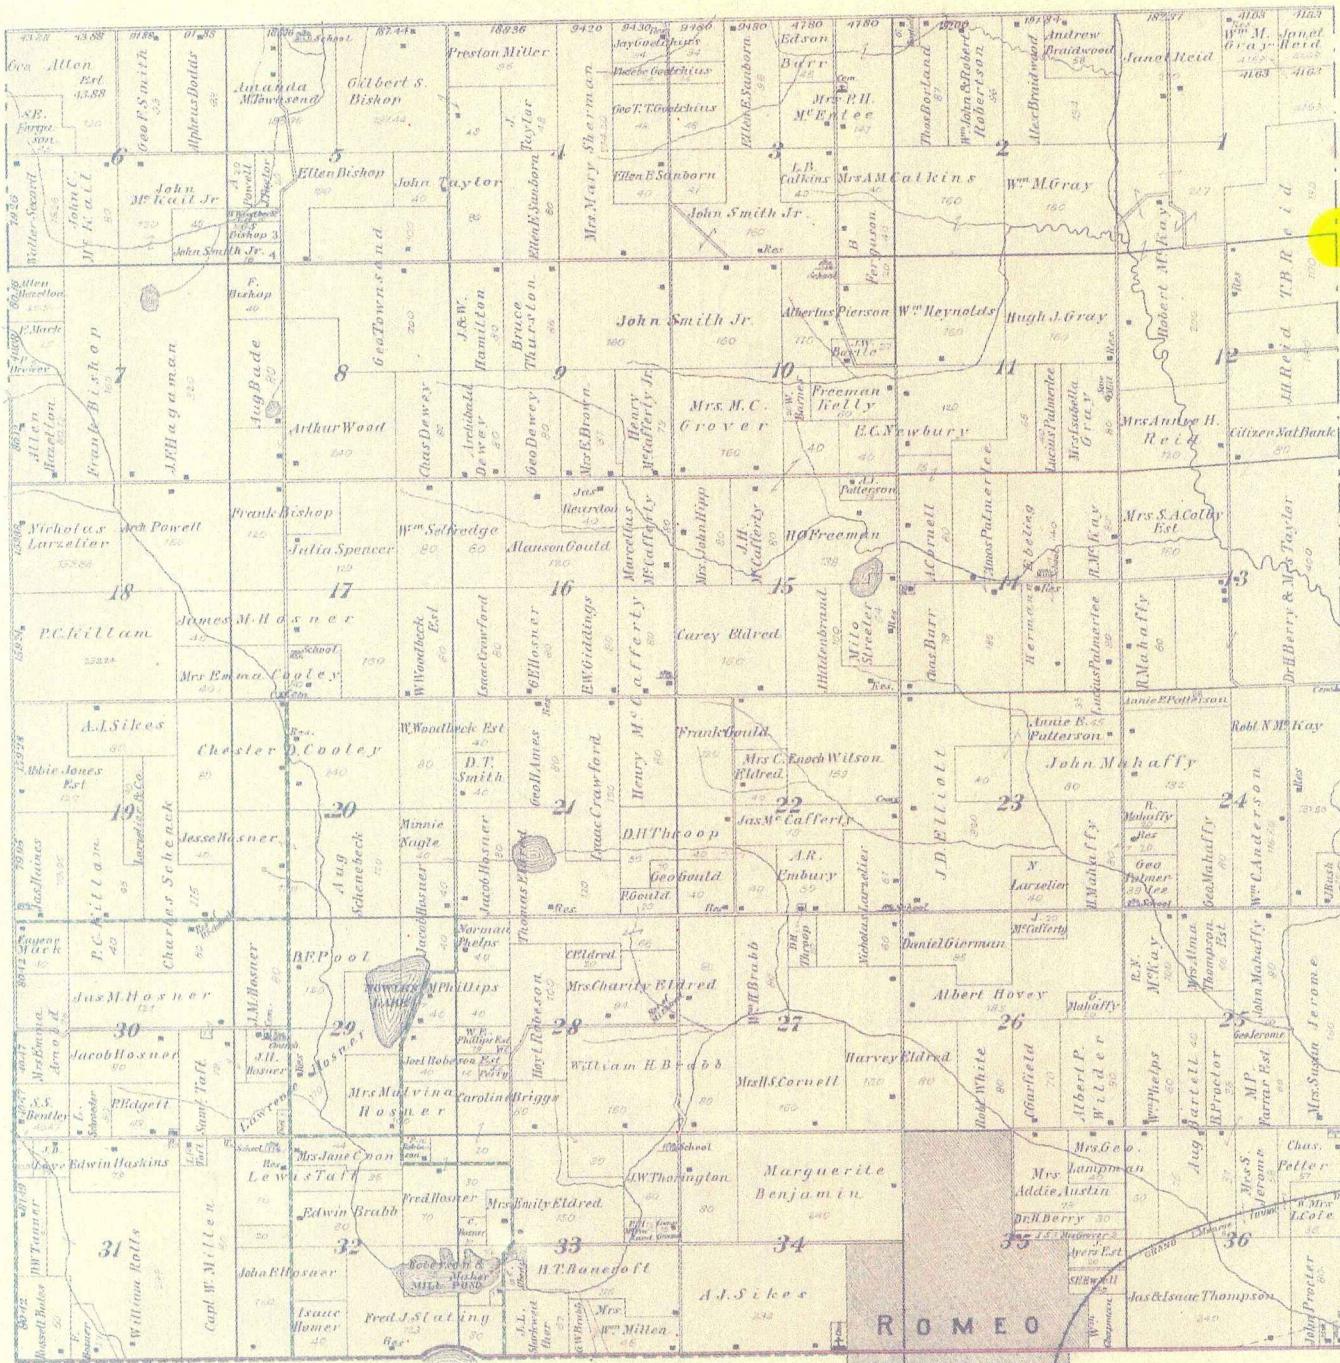

MAP OF
BRUCE

TOWNSHIP


Scale 2 inches to 1 mile

Township 5 North, Range 12 East of the Michigan Meridian

co.

15

1173

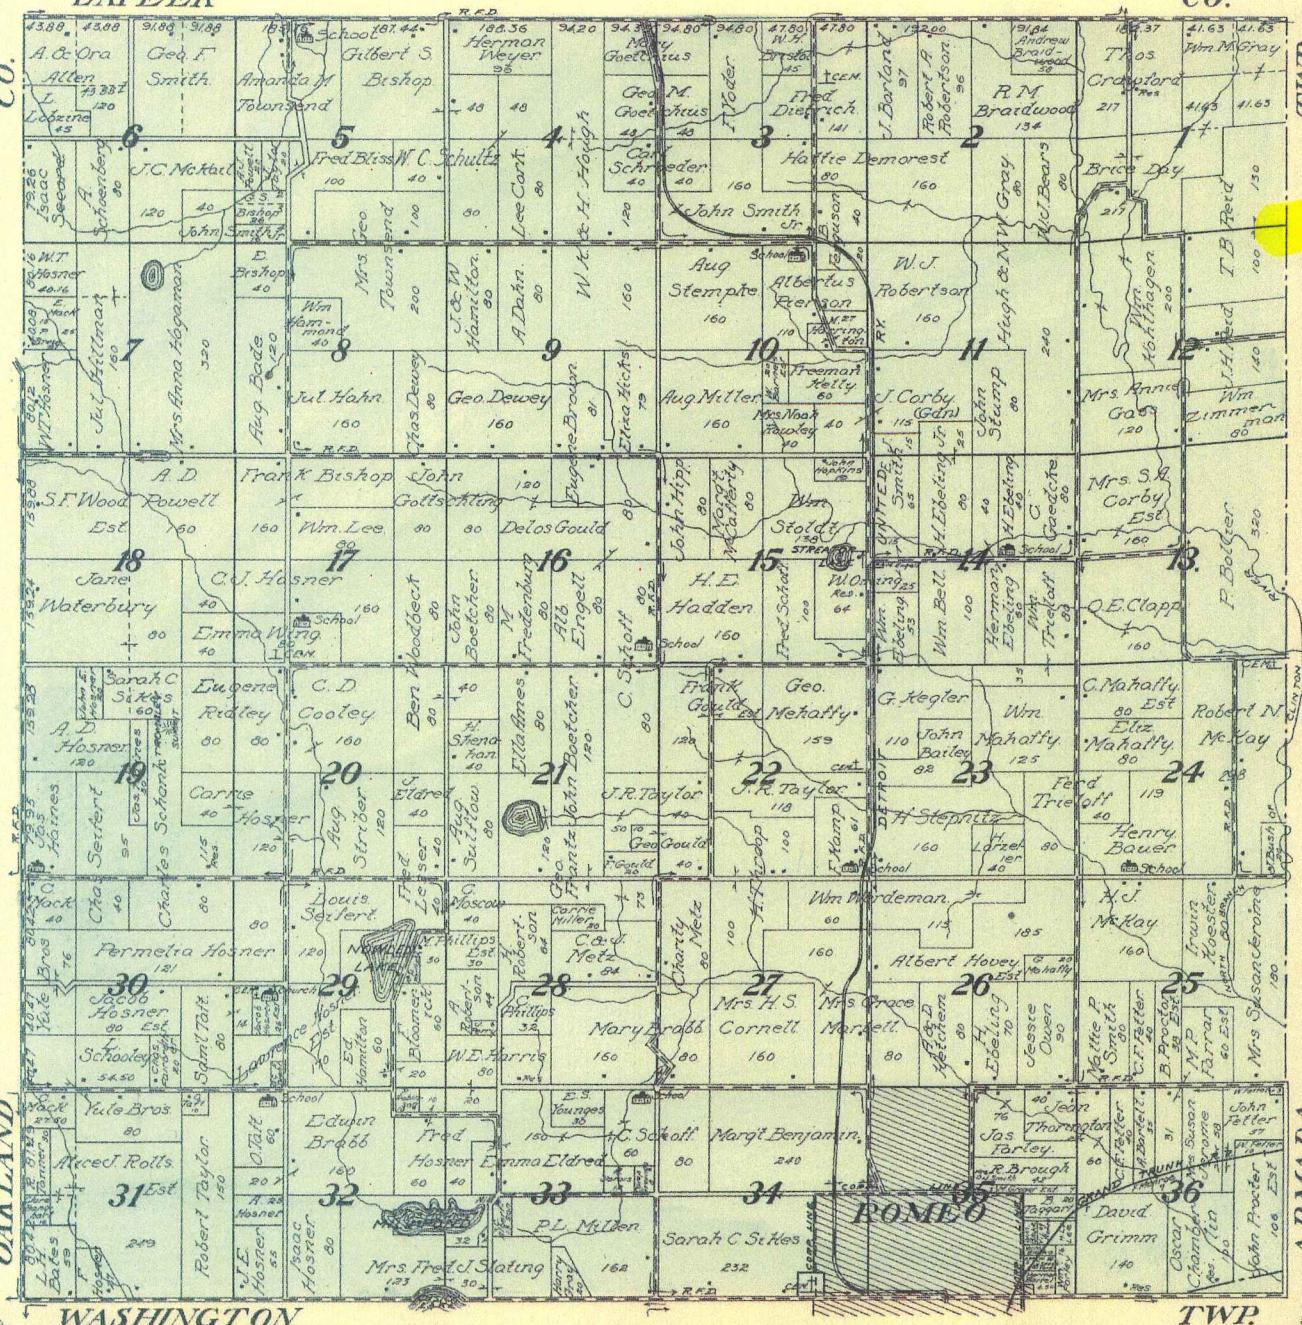

392

Town 5 North Range 13 East

West Between sections 6 + 7
14.30 B. Acre 14 in claim
40.00 Made Cor for 1/4 Sec on an Elm 12 in diam
69.50 Intersected Town boundary 30 ft south
of Cor Made cor for sections 6 + 7 on a
Tamarac 10 in diam
Land 30th part rock
March 26th 1817


A-03

Surveyed by Mr. Preston D.S.

ARMADA

T.5N.-R.13E.

ST. CLAIR COUNTY

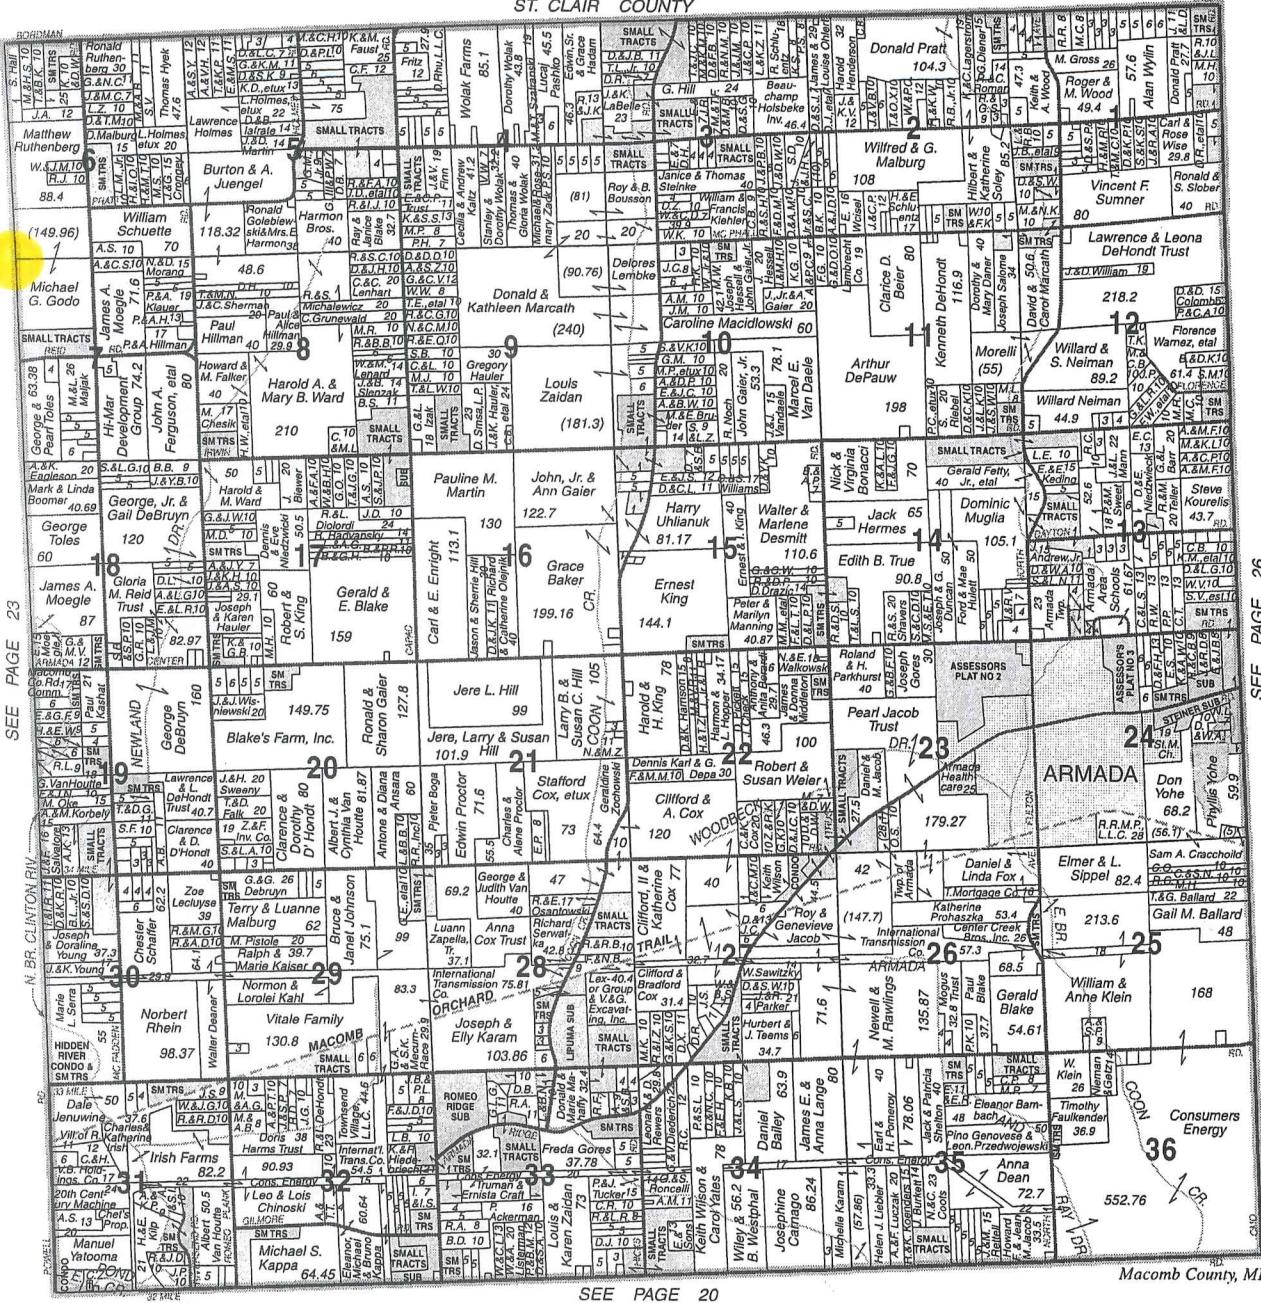

© 2006 Rockford Map Publs., Inc.

The logo for Century 21, featuring the word "Century" in a stylized, italicized font above the number "21". A dotted line graphic of a house roof is positioned between the two words.

Sunrise

Specializing in:

Mary Samulski


samulski@c21sunrise.net

810-798-2111 x109

4260 Van Dyke • Almont, Michigan 48003

((*MAP OF* ARMADA *TOWNSHIP*))


T. 5, R. 13.

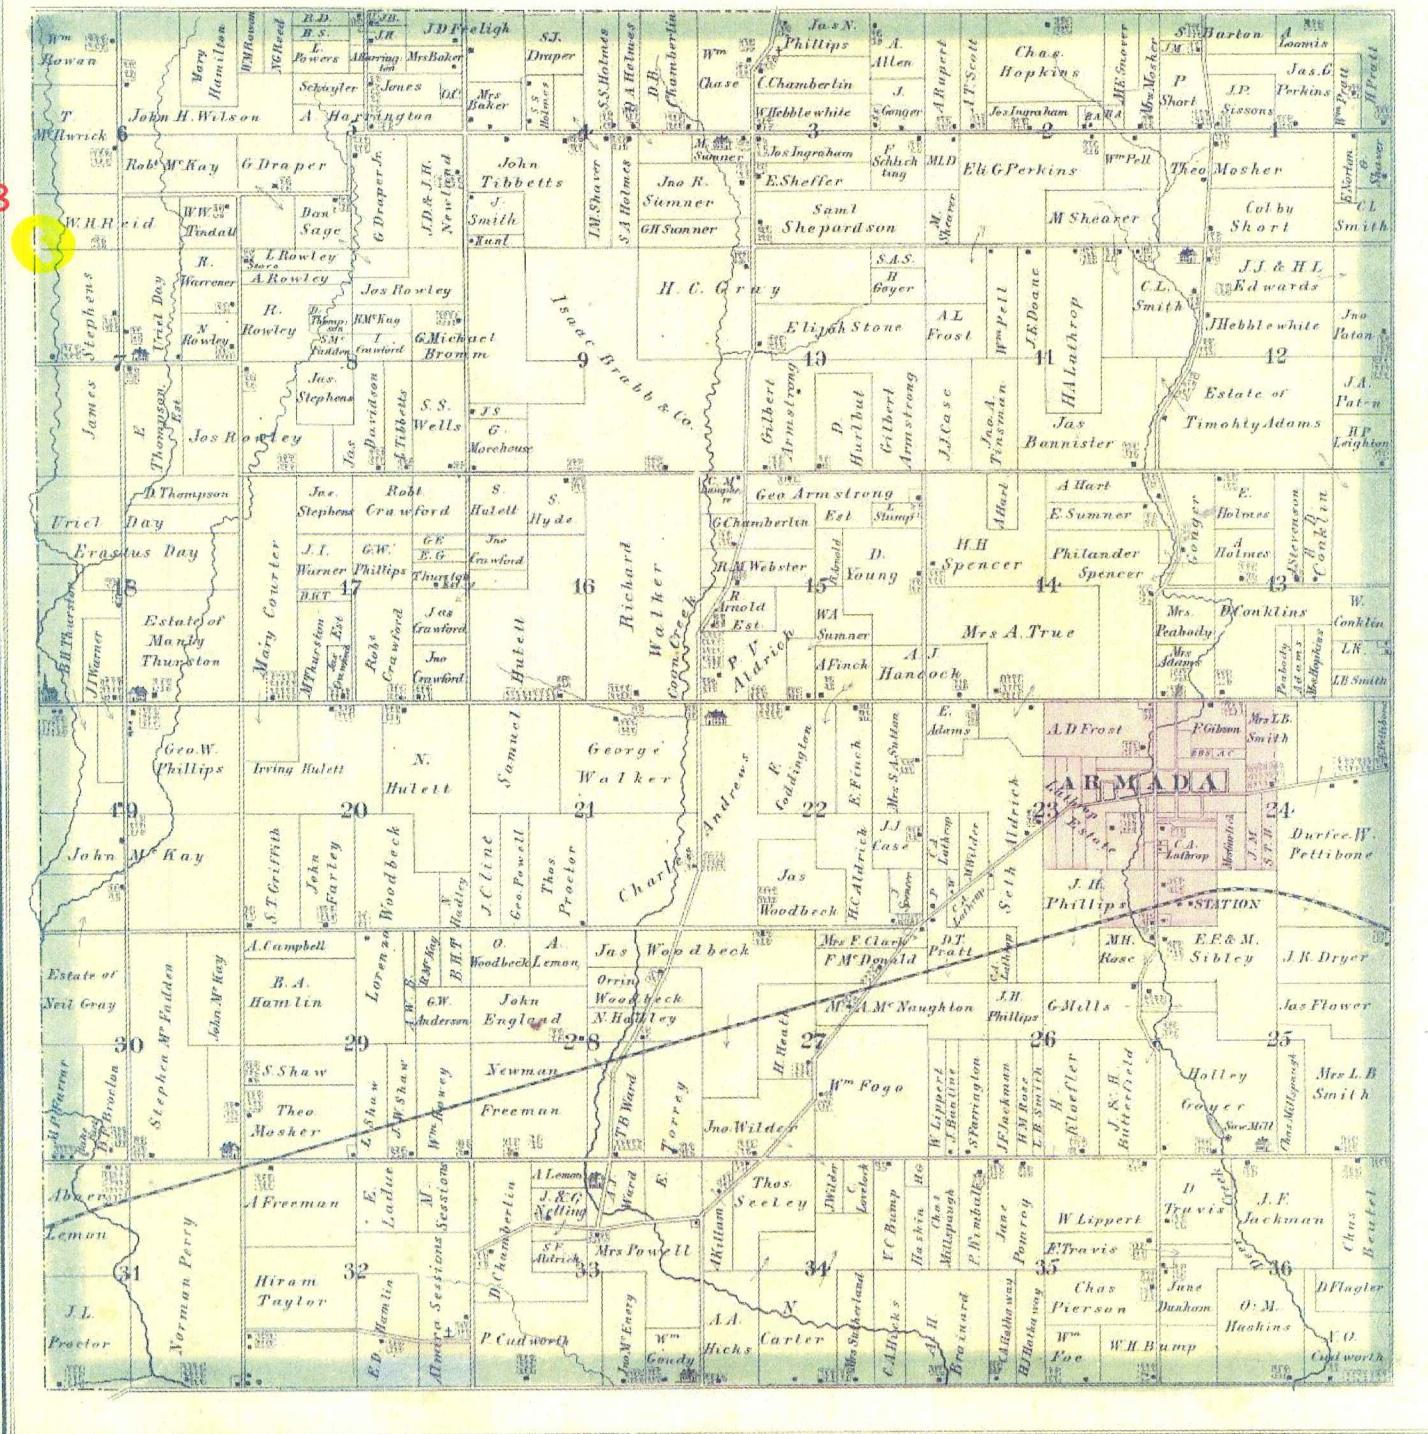

Township 5 North Range 13 East

Scale 2 inches to one Mile.

of the Meridian of Michigan

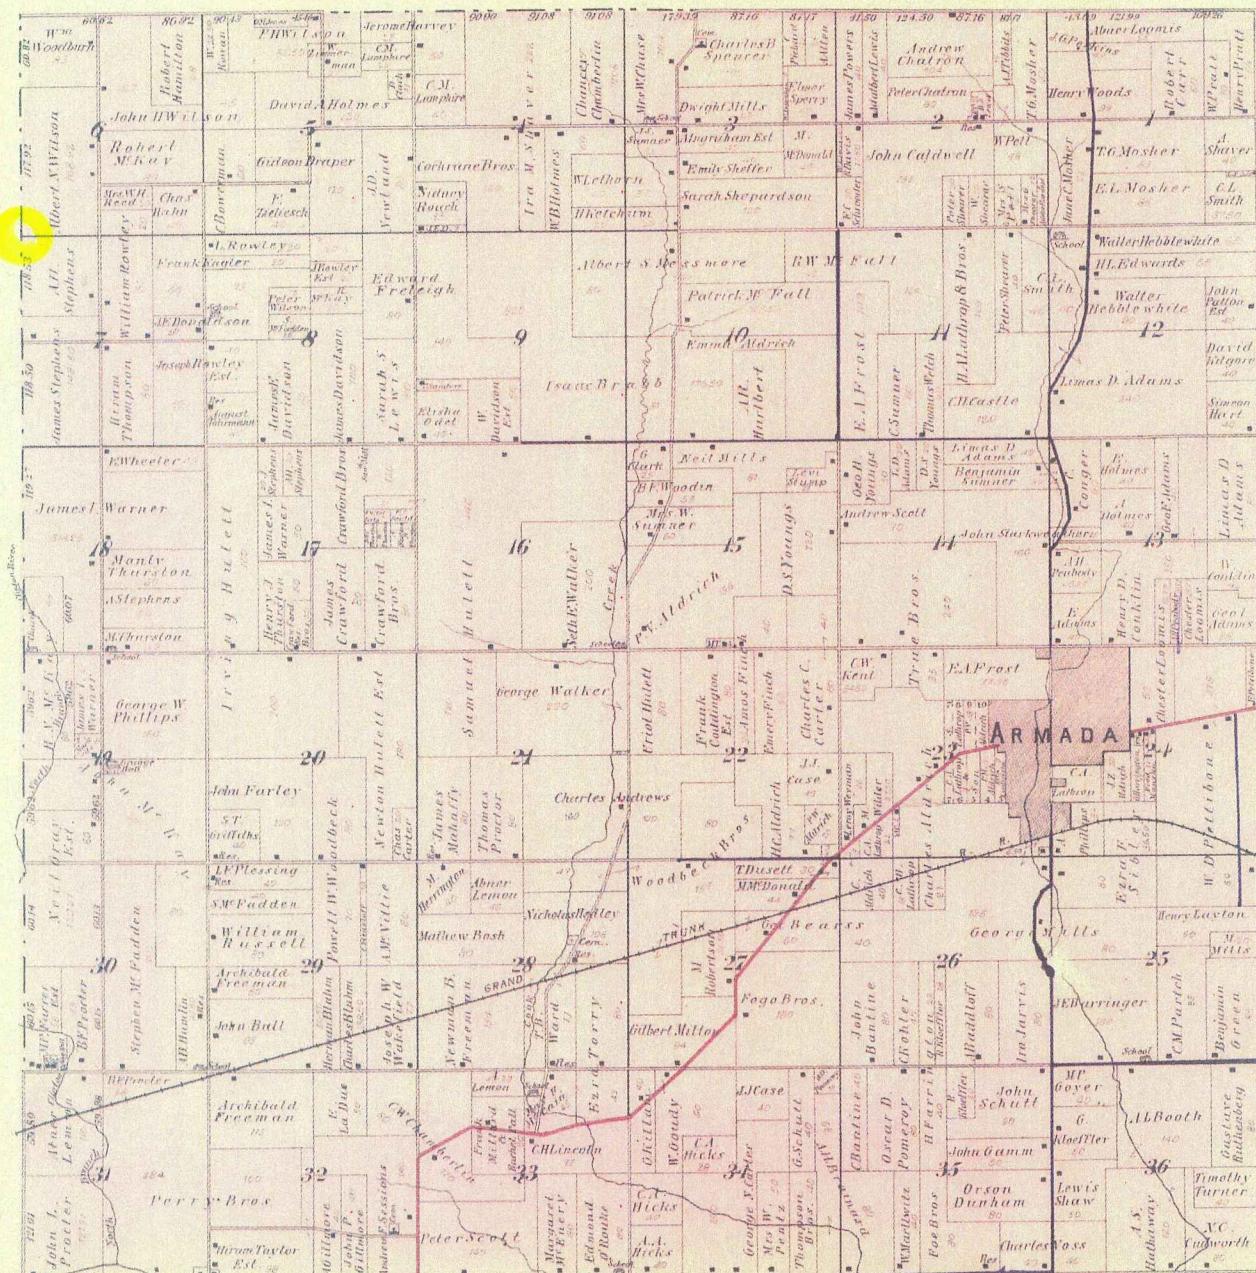

ARMADA

TOWNSHIP

Scale 2 inches to 1 mile

Township 5 North, Range 13 East of the Michigan Meridian


STCLAIR

co

πτῶν

۷۰۱

Ao

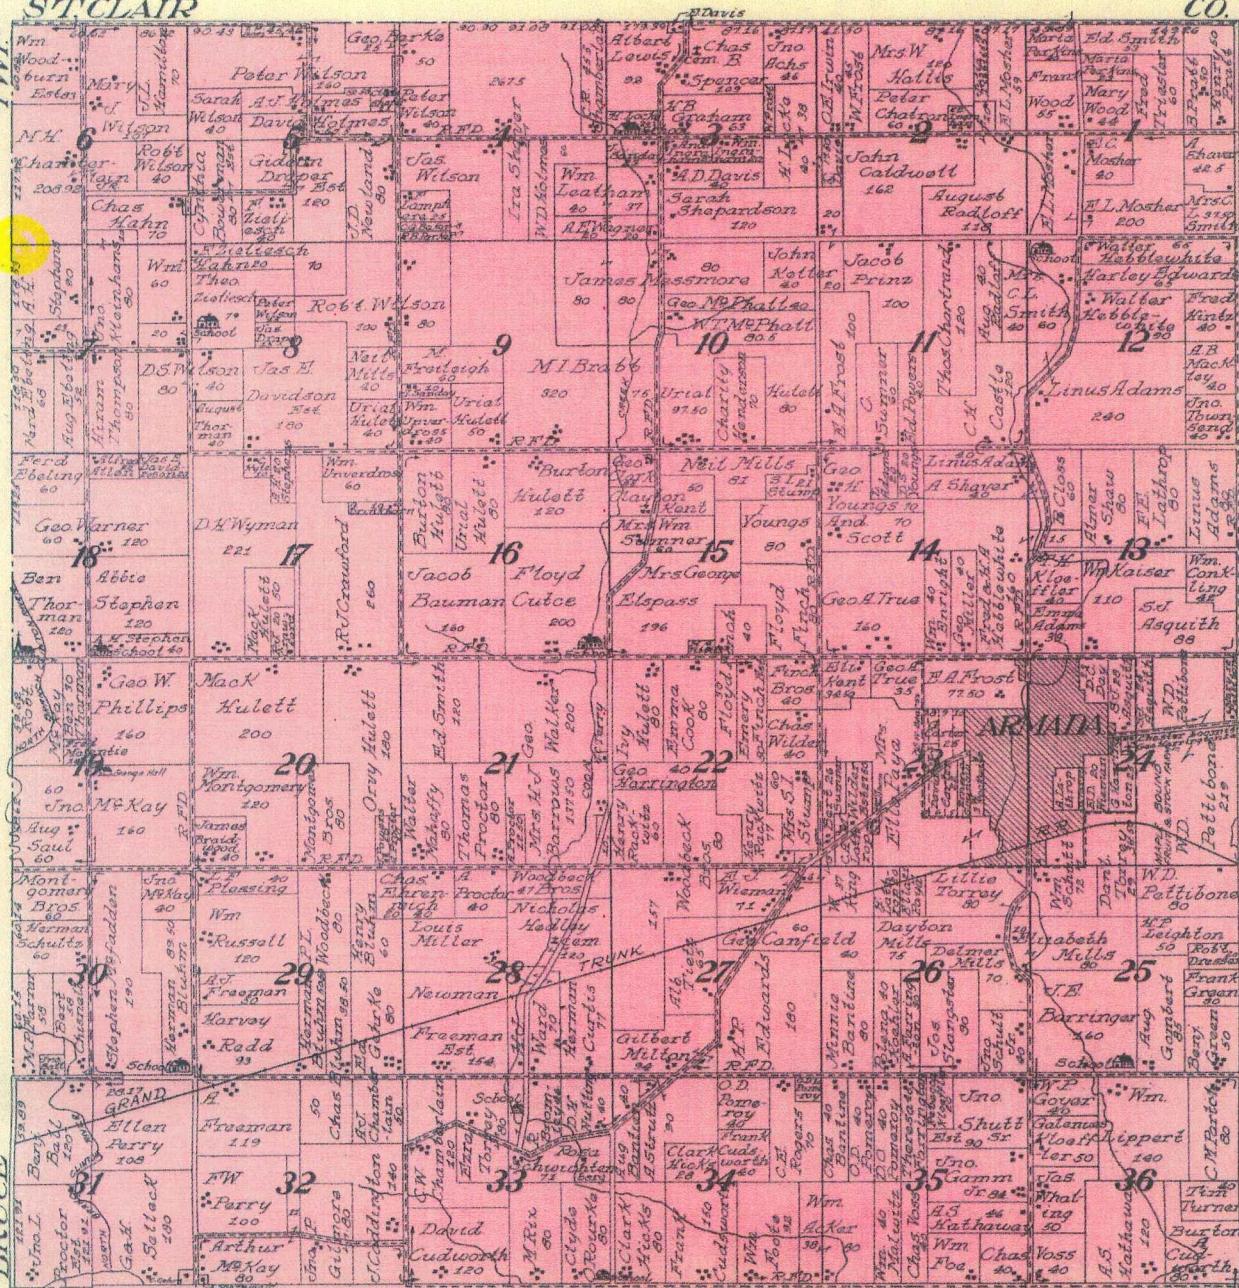

BRICK

RAY

RICHMOND

M-01 to M-13 ~~32,360.25 (Maa)~~ 16.


13 x 40 ch x 66 ~~31,680.00~~ (610) 15.00

66 + ? ch = 67.417
31,680 32,360.25

40 ch = 2696.69

(M-7) 1.5 ch = 101 ft. 1/300

SLK = 52.8 5.39 160
M-02

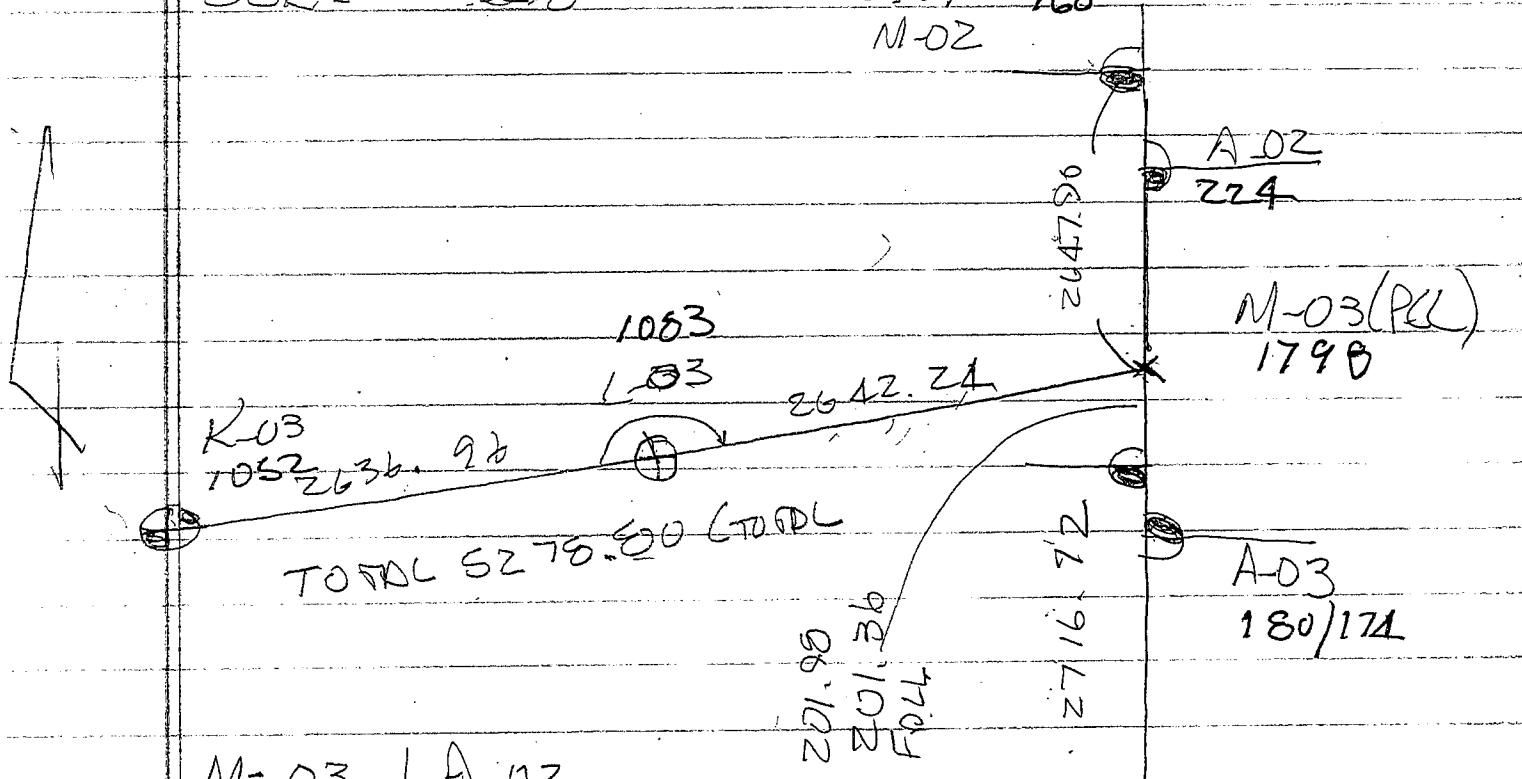

M-04
151

M-03 T5N, R12E, BRUCE TOWNSHIP

K-13 to L-13 N87°34'20" E 2791.14 Ft.	K-05 to L-05 N76°39'54" E 2642.30 Ft.
L-13 to M-13 N73°31'36" E 2516.17 Ft.	L-05 to M-05 N77°19'04" E 2640.39 Ft.
K-13 to M-13 N80°54'54" E 5267.60 Ft.	K-05 to M-05 N76°59'29" E 5282.60 Ft.
K-11 to L-11	K-03 to L-03 N76°24'51" E 2636.56 Ft.
L-11 to M-11 N81°41'22" E 2629.19 Ft.	L-03 to M-03 N80°45'12" E 2612.77 Ft.
K-11 to M-11	K-03 to M-03 N78°34'26" E 5245.56 Ft.
K-09 to L-09 N77°36'12" E 2608.24 Ft.	K-11 to L-01 N85°57'41" E 2605.75 Ft.
L-09 to M-09 N79°07'25" E 2665.56 Ft.	L-01 to M-01 N87°52'24" E 2615.19 Ft.
K-09 to M-09 N78°22'18" E 5273.34 Ft.	K-01 to M-01 N86°55'09" E 5220.22 Ft.
K-07 to L-07 N77°57'07" E 2672.08 Ft.	
L-07 to M-07 N77°28'52" E 2618.92 Ft.	
K-07 to M-07 N77°43'08" E 5290.95 Ft.	

GLO Mea. M-13 to M-01 = 12 x 40 chains x 66 Ft. = 31,360.17 Ft.

Field Mea. M-13 to M-01 = 32,360.17 Ft.

<u>32,360.17 Ft.</u>	<u>Indexed chain</u>
31,680.00 Ft.	66 Ft.

Indexed chain = 67.417 Ft. x
Indexed ½ mile = 67.417 Ft. x 40 = 2696.68 Ft.

<u>PLC to PLC</u>	<u>GLO MEA.</u>	<u>GLO MEA. USING THE INDEXED CHAIN</u>	<u>FIELD MEA.</u>
M-13 to M-12 =	2640.00 Ft.	2696.68 Ft.	2659.17 Ft.
M-12 to M-11 =	2640.00 Ft.	2698.68 Ft.	2743.40 Ft.
M-11 to M-10 =	2640.00 Ft.	2698.68 Ft.	2698.09 Ft.
M-10 to M-09 =	2640.00 Ft.	2698.68 Ft.	2698.01 Ft.
M-09 to M-08 =	2640.00 Ft.	2698.68 Ft.	2666.17 Ft.
M-08 to M-07 =	2640.00 Ft.	2698.68 Ft.	2732.32 Ft.
M-07 to M-06 =	2640.00 Ft.	2698.68 Ft.	2699.54 Ft.
M-06 to M-05 =	2640.00 Ft.	2698.68 Ft.	2700.16 Ft.
M-05 to M-04 =	2640.00 Ft.	2698.68 Ft.	2681.40 Ft.
M-04 to M-03 =	2640.00 Ft.	2698.68 Ft.	2515.43 Ft.
M-03 to M-02 =	2640.00 Ft.	2698.68 Ft.	2849.37 Ft.
M-02 to M-01 =	2640.00 Ft.	2698.68 Ft.	2713.21 Ft.
M-13 to M-04 =	23,760.00 Ft.	24,270.12 Ft.	24,281.20 Ft. (+ 11 Ft.)
M-13 to M-03 =	26,400.00 Ft.	26,966.80 Ft.	26,796.94 Ft. (-170 Ft.)
M-13 to M-02 =	29,040.00 Ft.	29,663.48 Ft.	29,646.62 Ft. (- 17 Ft.)

08/24/11

MACOMB COUNTY TREASURER

TED B. WAHBY

----- TAX HISTORY -----

BRUCE TWP

Property Number: 14-01-01-400-003

Alt. Property Number: 14-01-00-104-500

Property Address: BROWN

School Code: 50050

TAX YEAR	TAX. VALUE	BASE TAX	BASE TAX DUE	INTEREST/FEE'S DUE	TOTAL DUE	LAST PMT
2010			0.00	0.00	0.00	
2009	0		0.00	0.00	0.00	
2008	0		0.00	0.00	0.00	
2007	0		0.00	0.00	0.00	
2006	0		0.00	0.00	0.00	
2005	0		0.00	0.00	0.00	
2004	0		0.00	0.00	0.00	
2003	0		0.00	0.00	0.00	
2002	0		0.00	0.00	0.00	
2001	0		0.00	0.00	0.00	
TOTAL			0.00	0.00	0.00	

Fees Due As Of: 08/24/11

DESCRIPTION OF PROPERTY:

SECS 1 & 12; BEG AT S 1/4 POST SEC 1; TH N0*26'50"W 2532.39 FT ALG N-S 1/4 LINE TO CEN POST; TH CONT N0*26'50"W 69.50 FT; TH N79*27'50"E 670.27 FT; TH S0*03'25"E 1304.74 FT; TH N77*54'35"E 730.05 FT; TH S0*- 17'25"E 204.70 FT; TH N81*40'- 35"E 1237.70 FT TO E LINE SEC 1; TH SLY ALG SD E SEC LINE TO NW COR SEC 7 ARMADA TWP; TH S0*09'35"W 474.84 FT ALG E LINE SEC 12; TH S79*55'W 2638.73 FT; TH N0*17'10"E 643.47 FT ALG N-S 1/4 LINE SEC 12 TO POB. 130.194 A. 50-01-001-000-00

SPLIT FROM 0101400001 & 002 &
0101200002 & 0112200001 FOR 81

History Fees: 0.00


Taxpayer: GODO MICHAEL & PAUL R

4086 HOWLAND

ALMONT

MI 48003


(5)

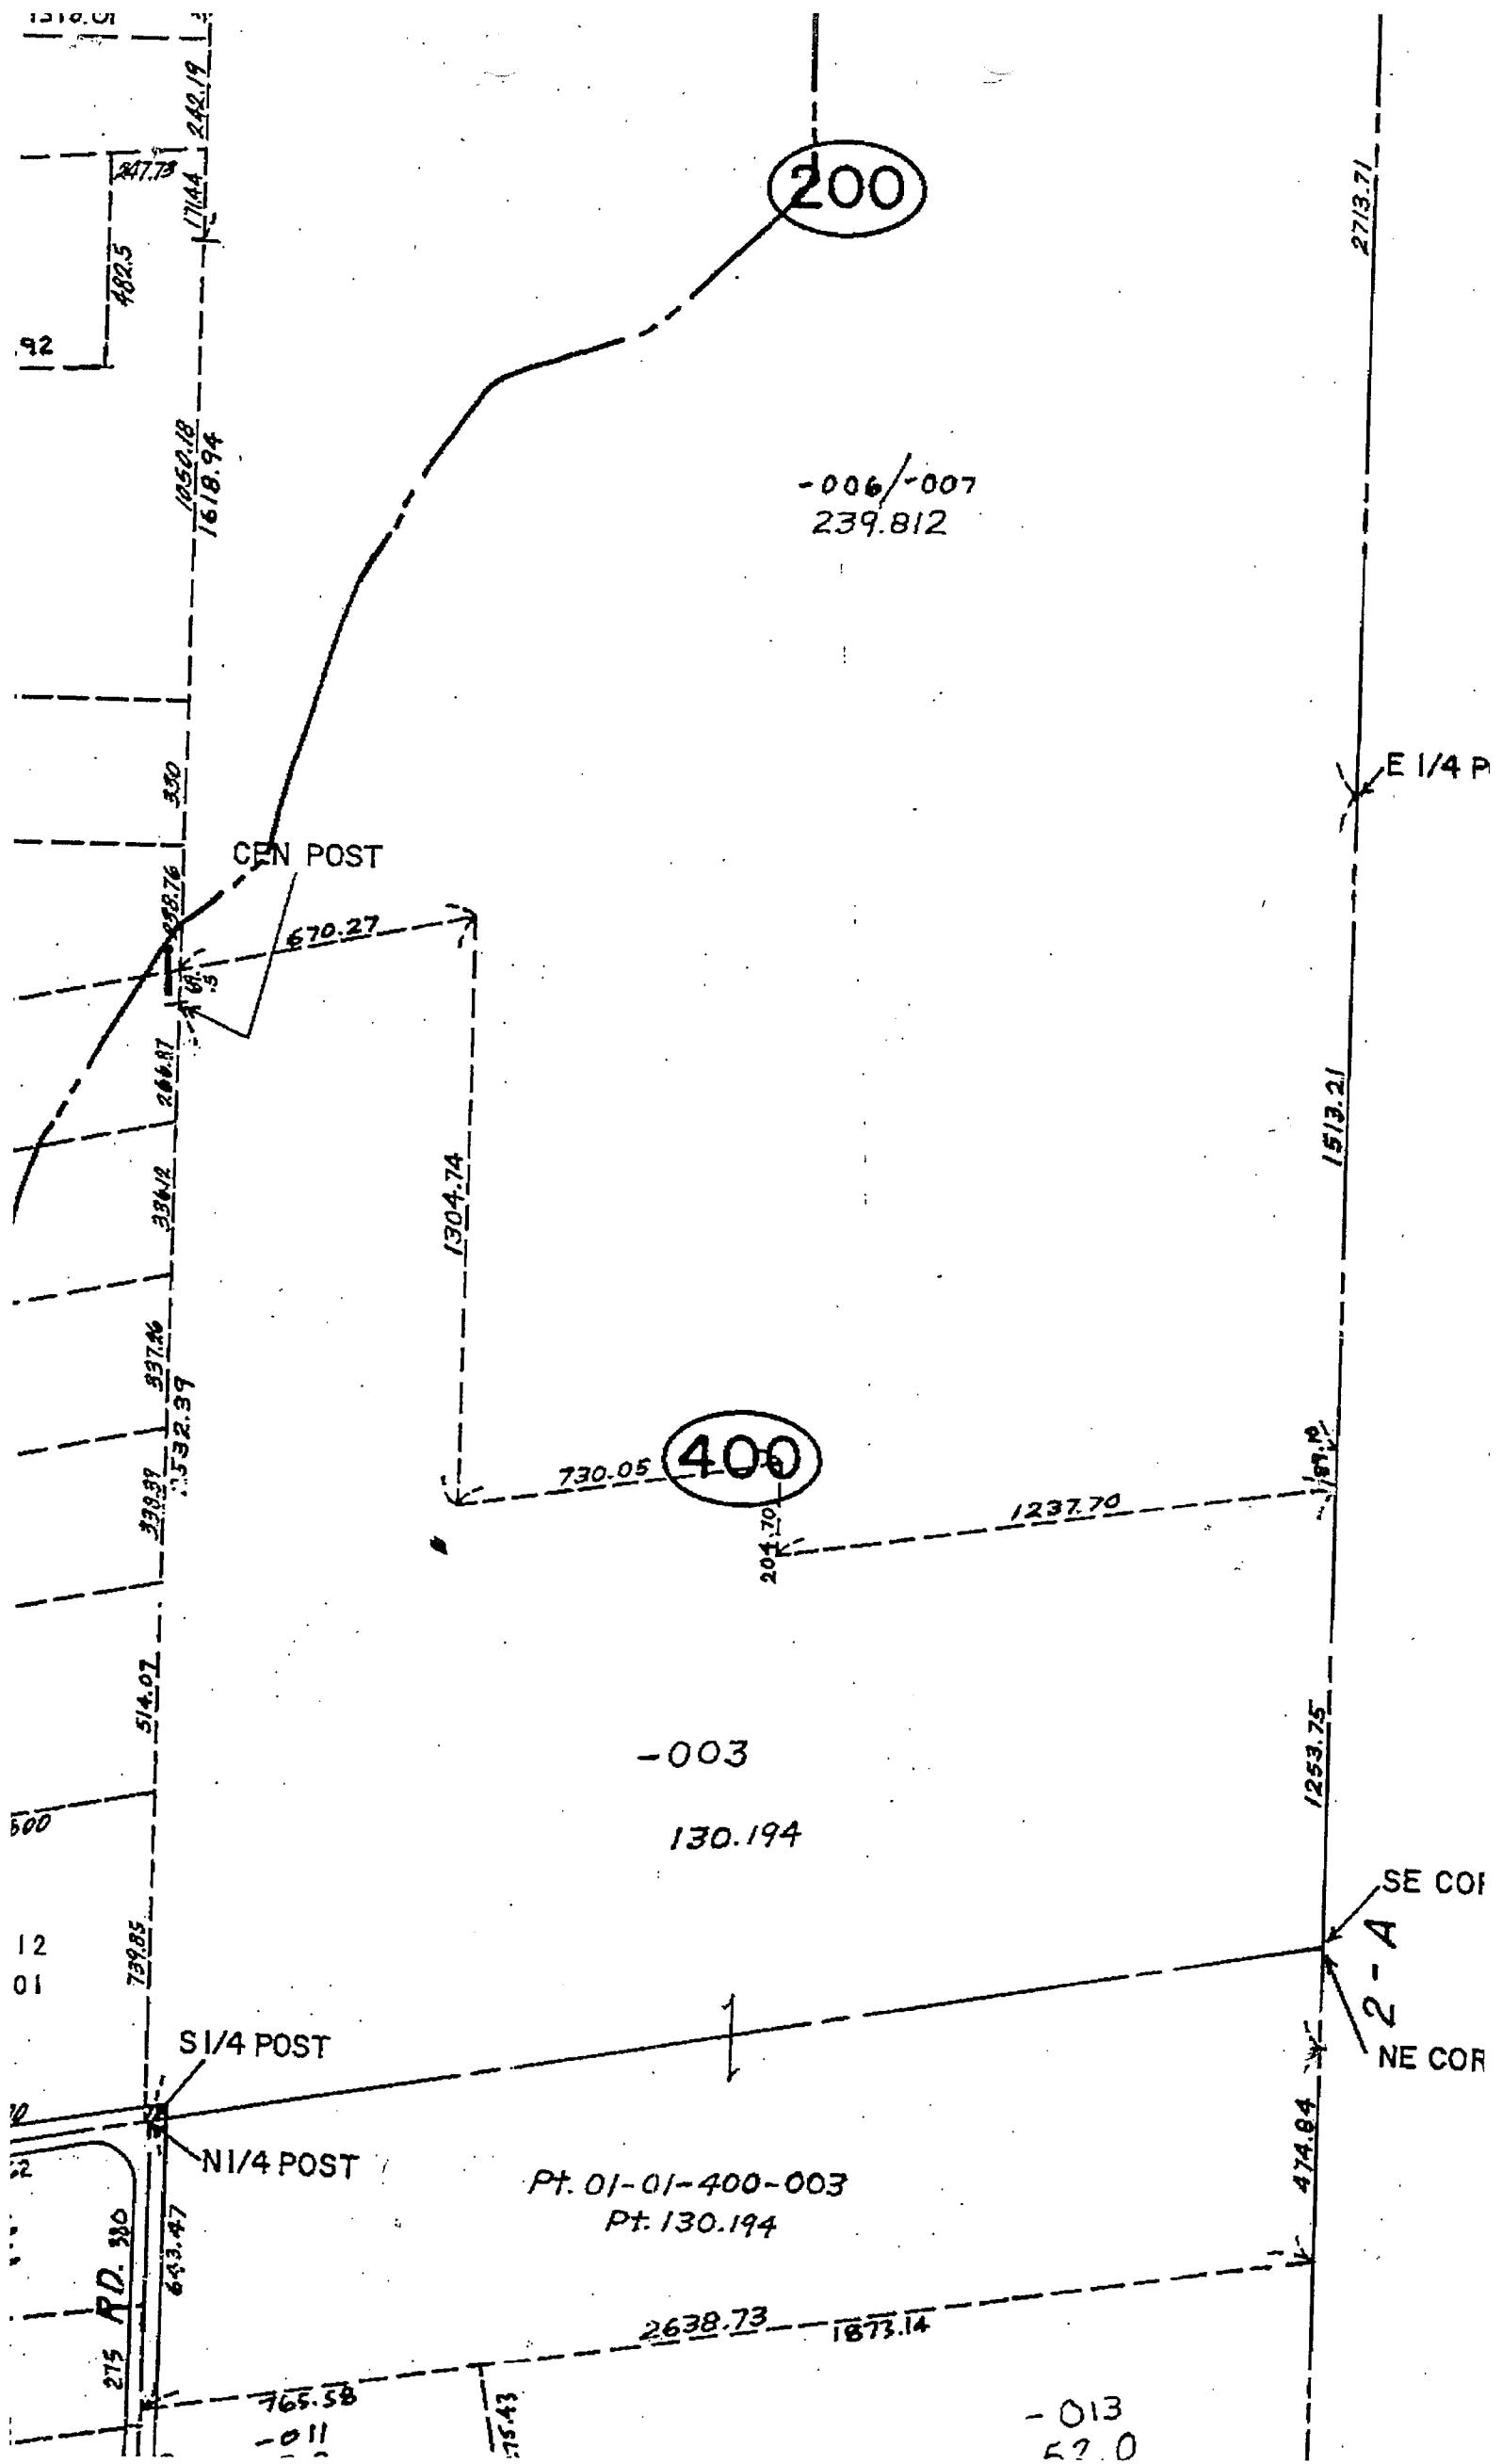

ARMADA TWP - MACOMB COUNTY


T. 4 N., - R. 12 E.

* Coordinates updated 8/1
* Bearing and Distance updated 8/11

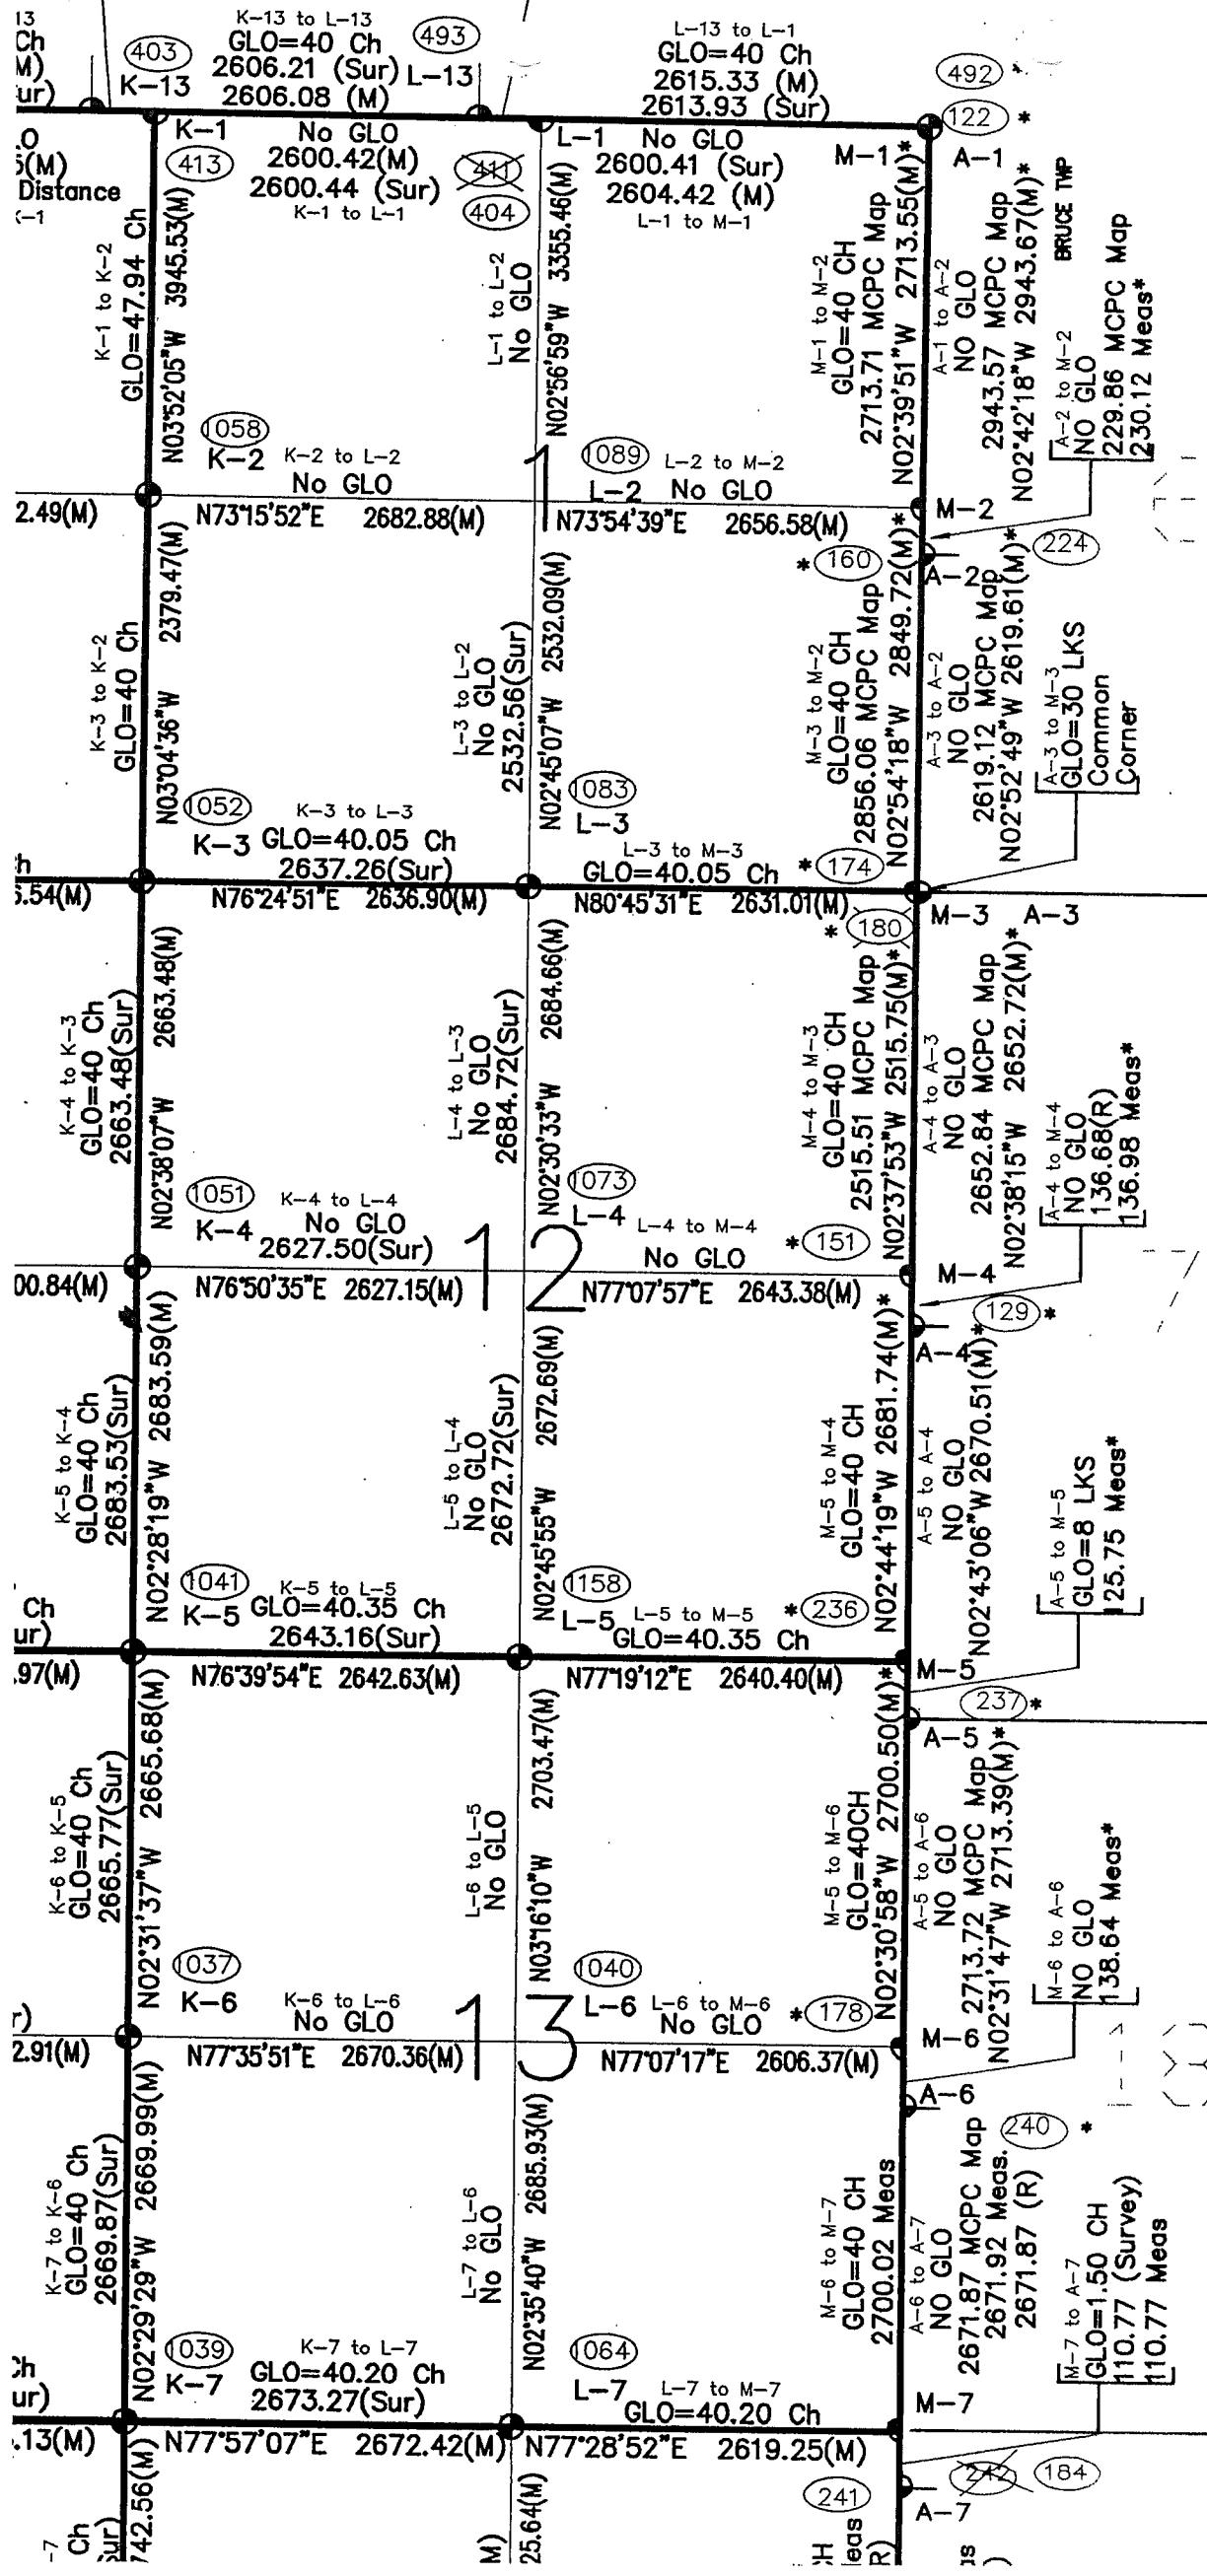

T.6N.-R.12E. (96-4013)

(96-4013)

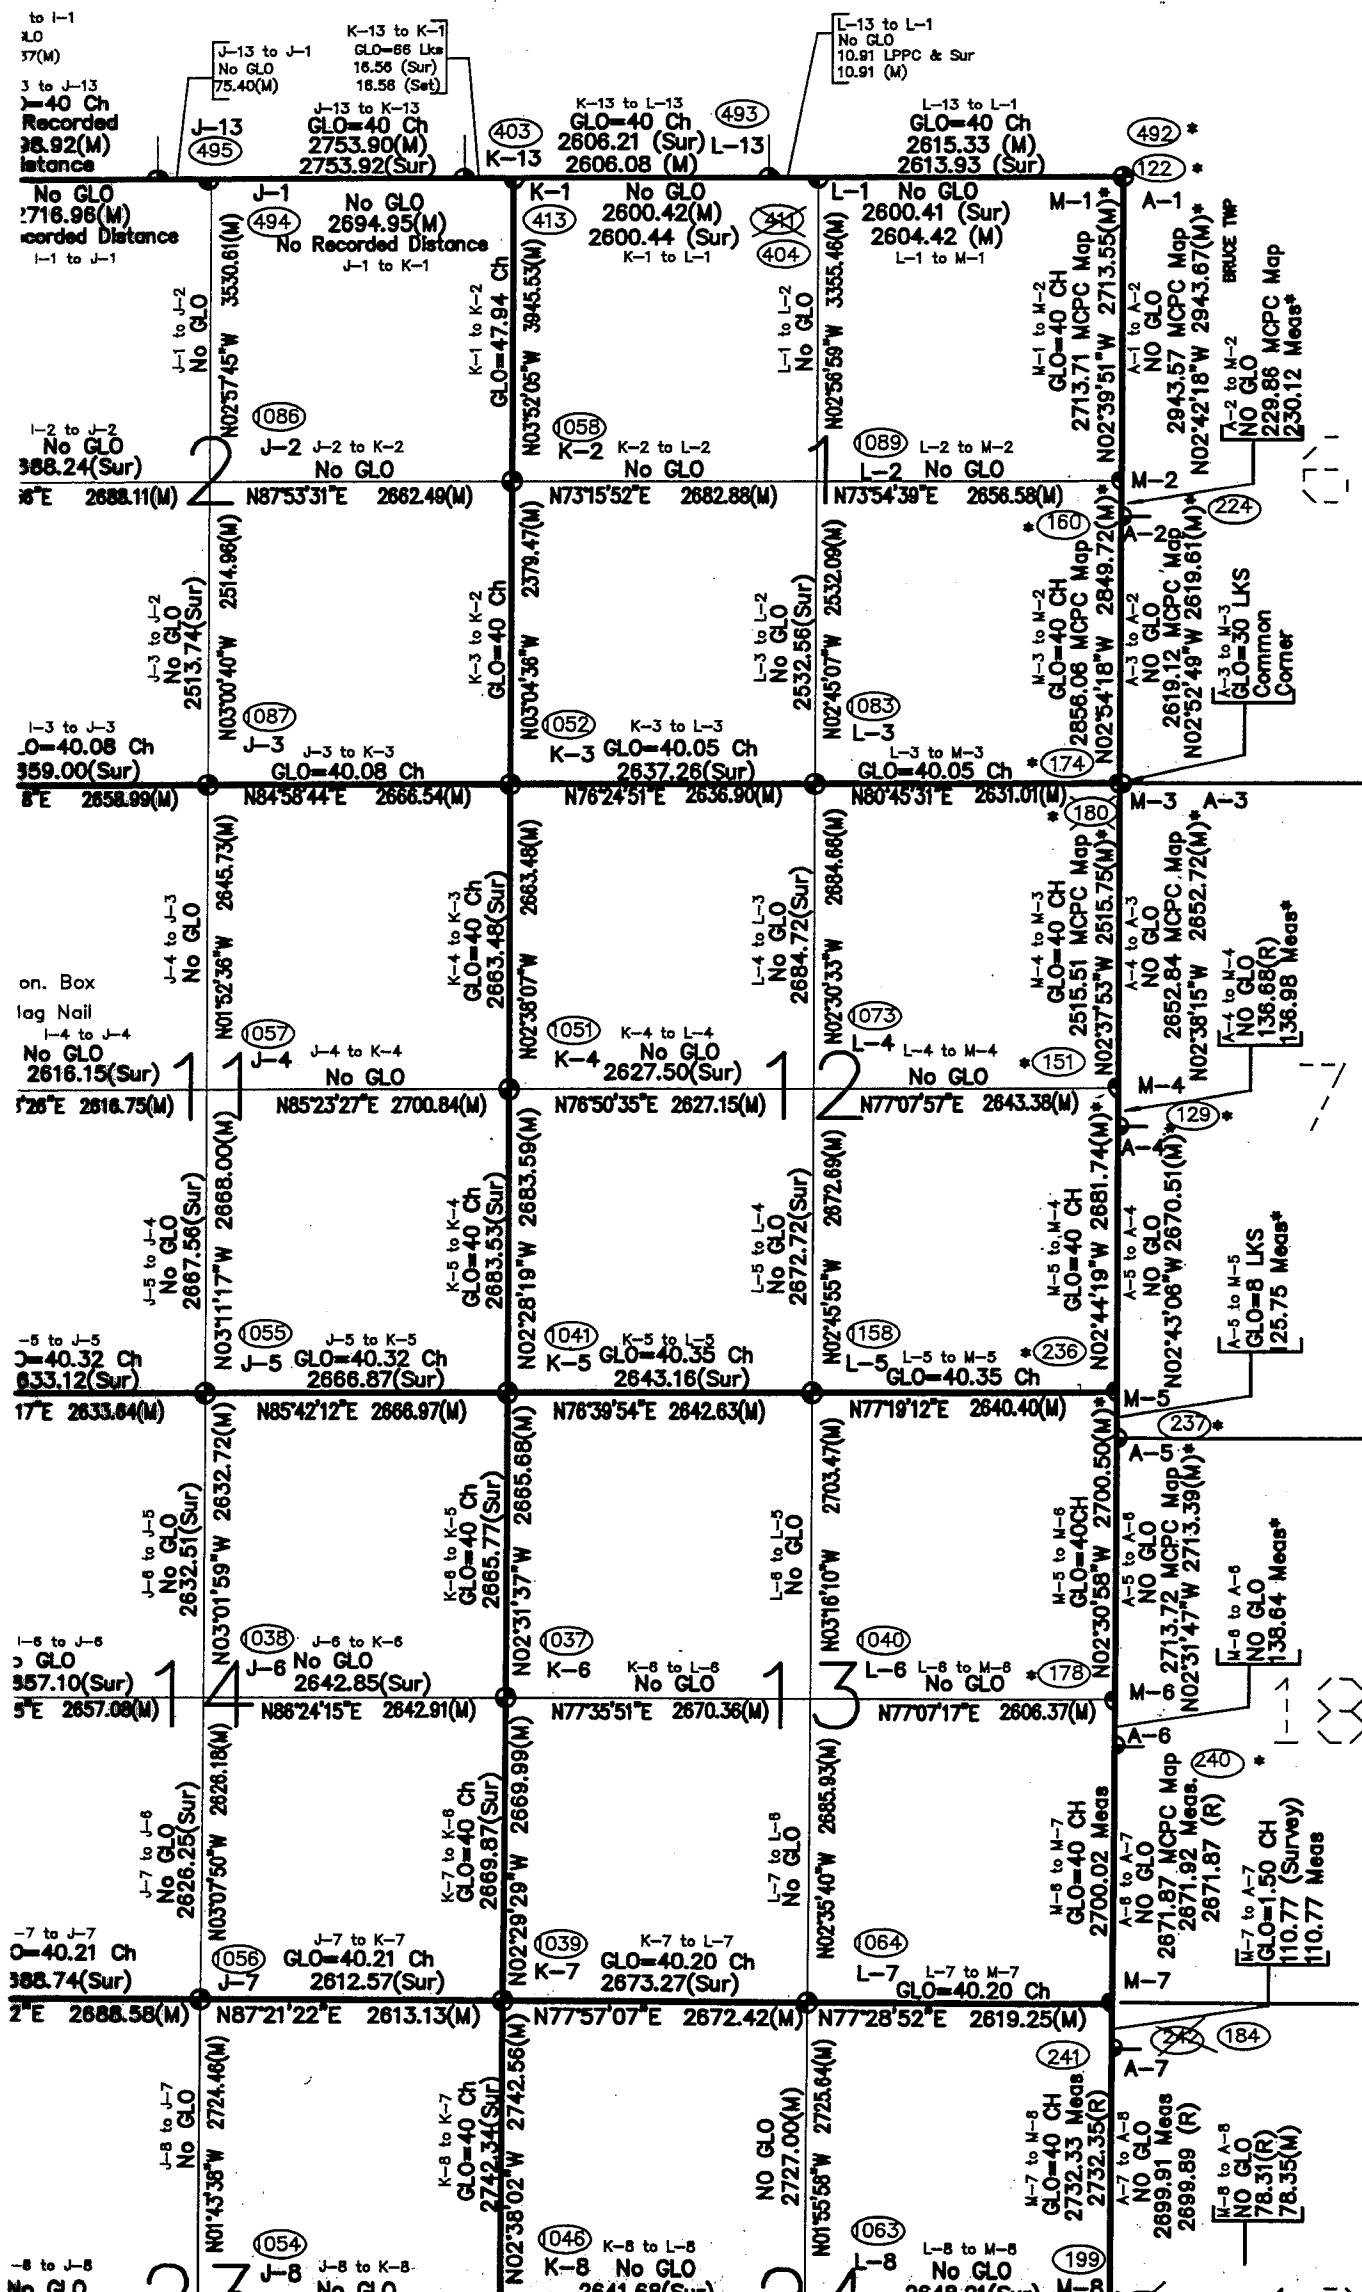


ARMADA TWP-MACOMB COUNTY

T.4N::,-R.12E.

3 / 11
updated 8 / 11

- * Coordinates updated 8/11
- * Bearing and Distance updated 8/1

ARMADA TWP - MACOMB COUNTY
T.4N., -R.13E.

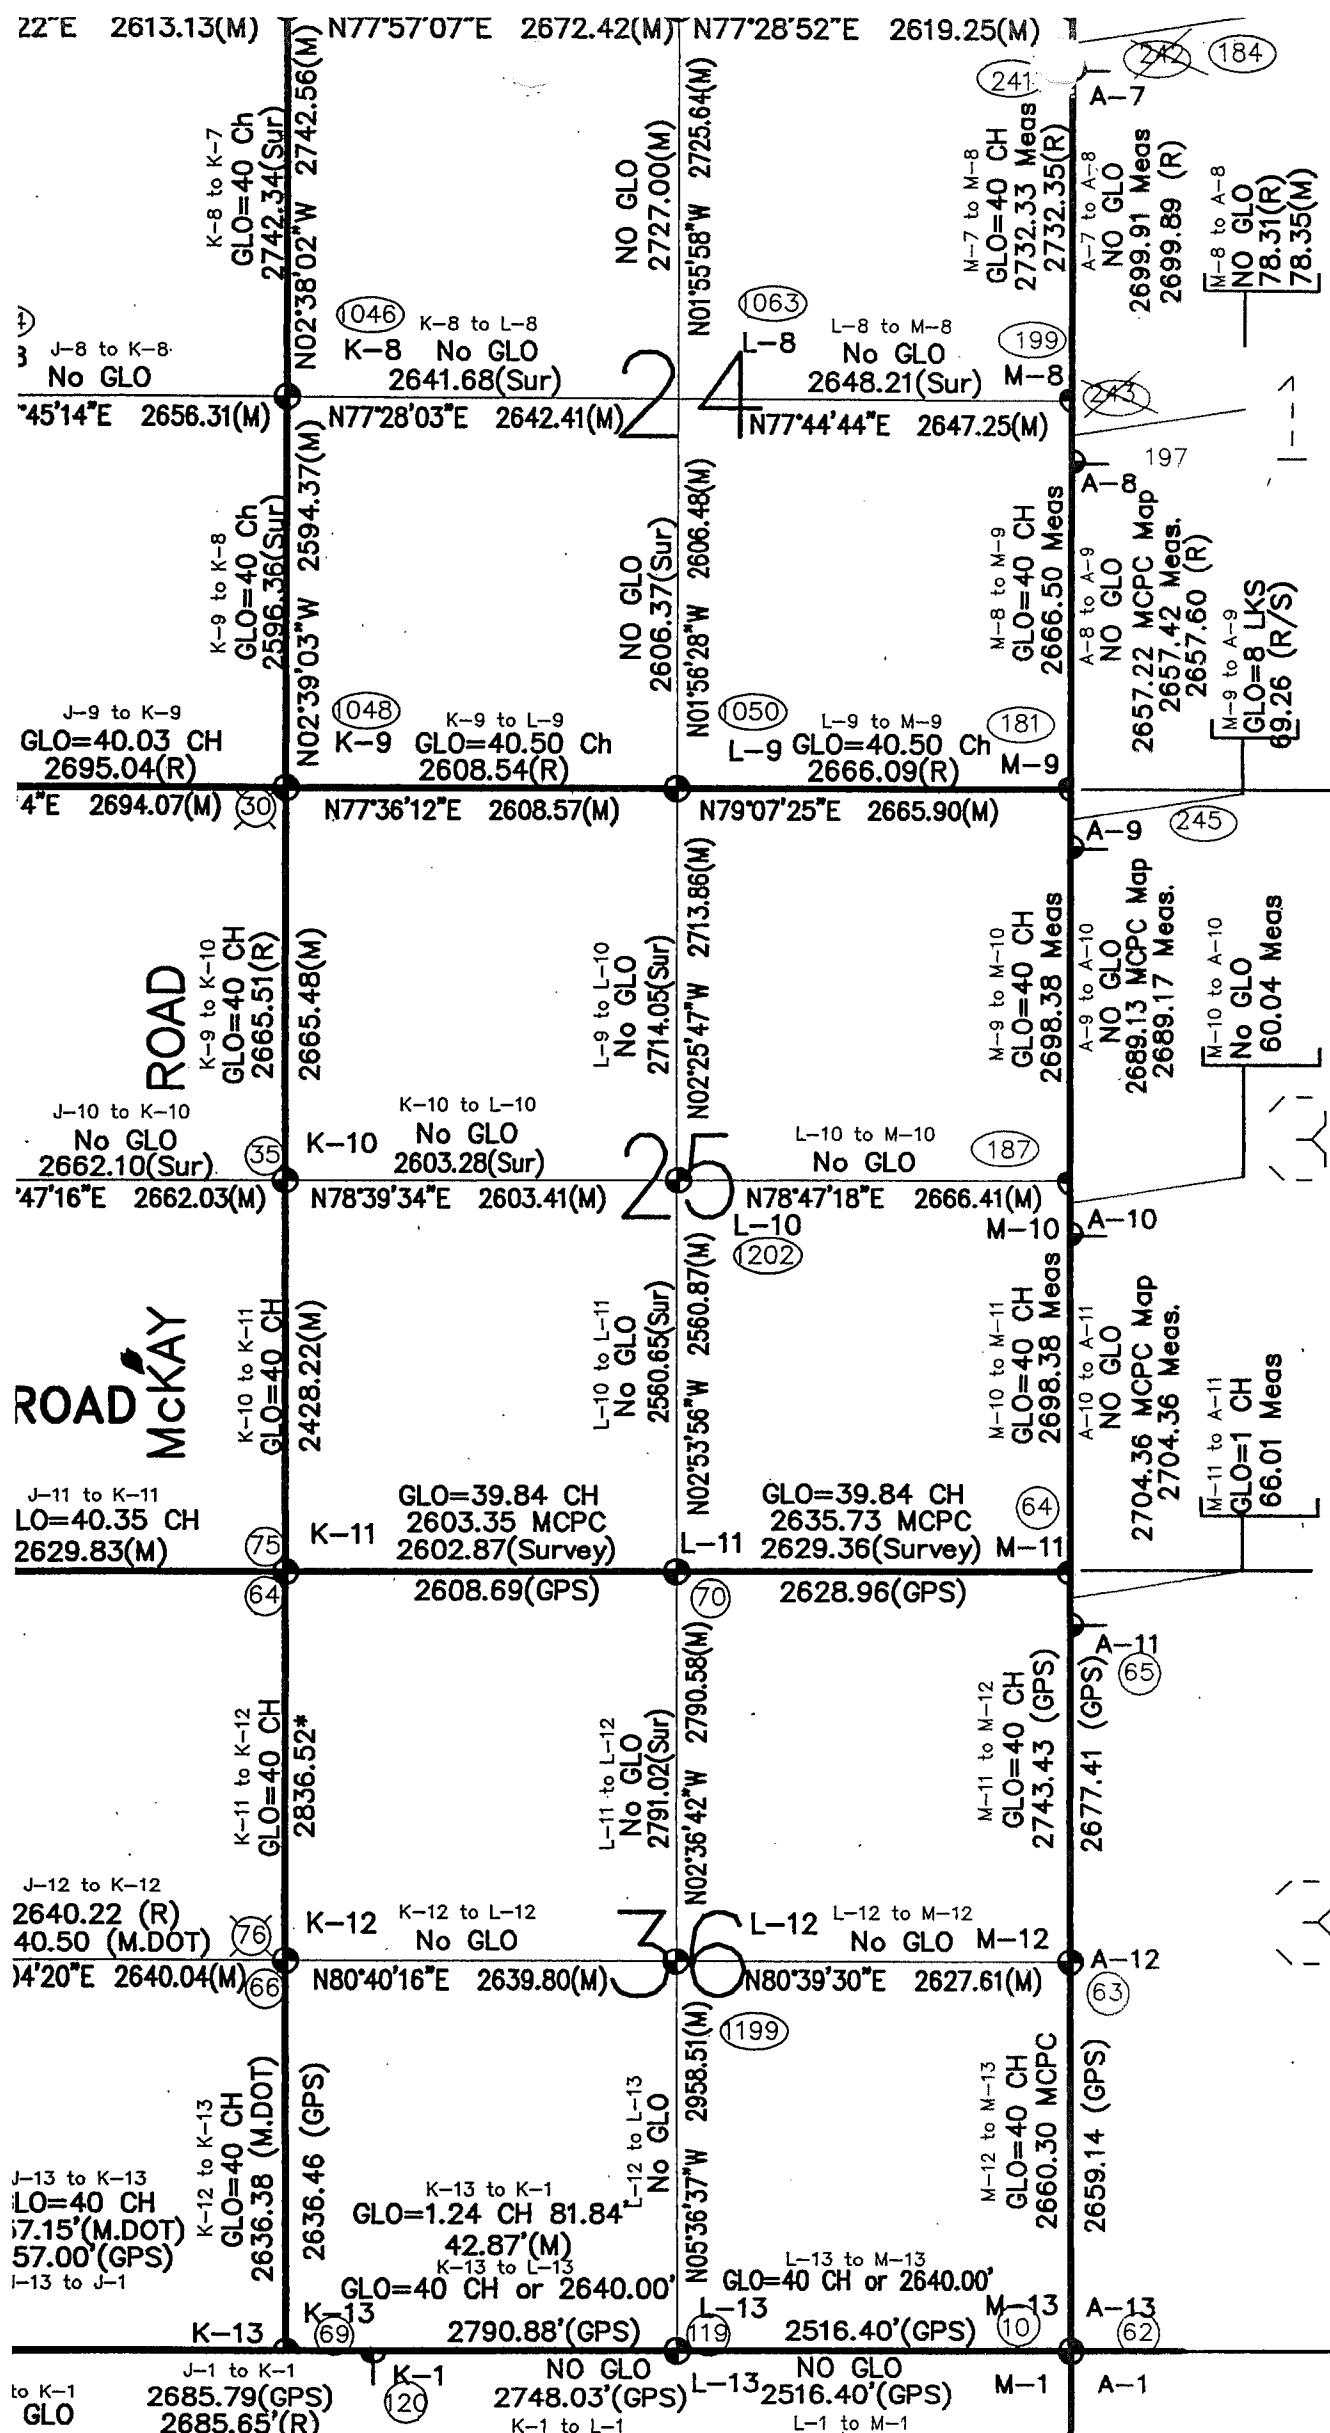

REVISED: 1/5/98
BRUCE TWP (97-4290)
(96-4013)(1999)

96-4013

ROAD
ON TWP


T 4N - R 12E

ARM, /

* Coordinates updated 8/11
* Bearing and Distance updated 8/11

ARMADA TWP-MACOMB COUNTY

T. 4N., -R. 13E.

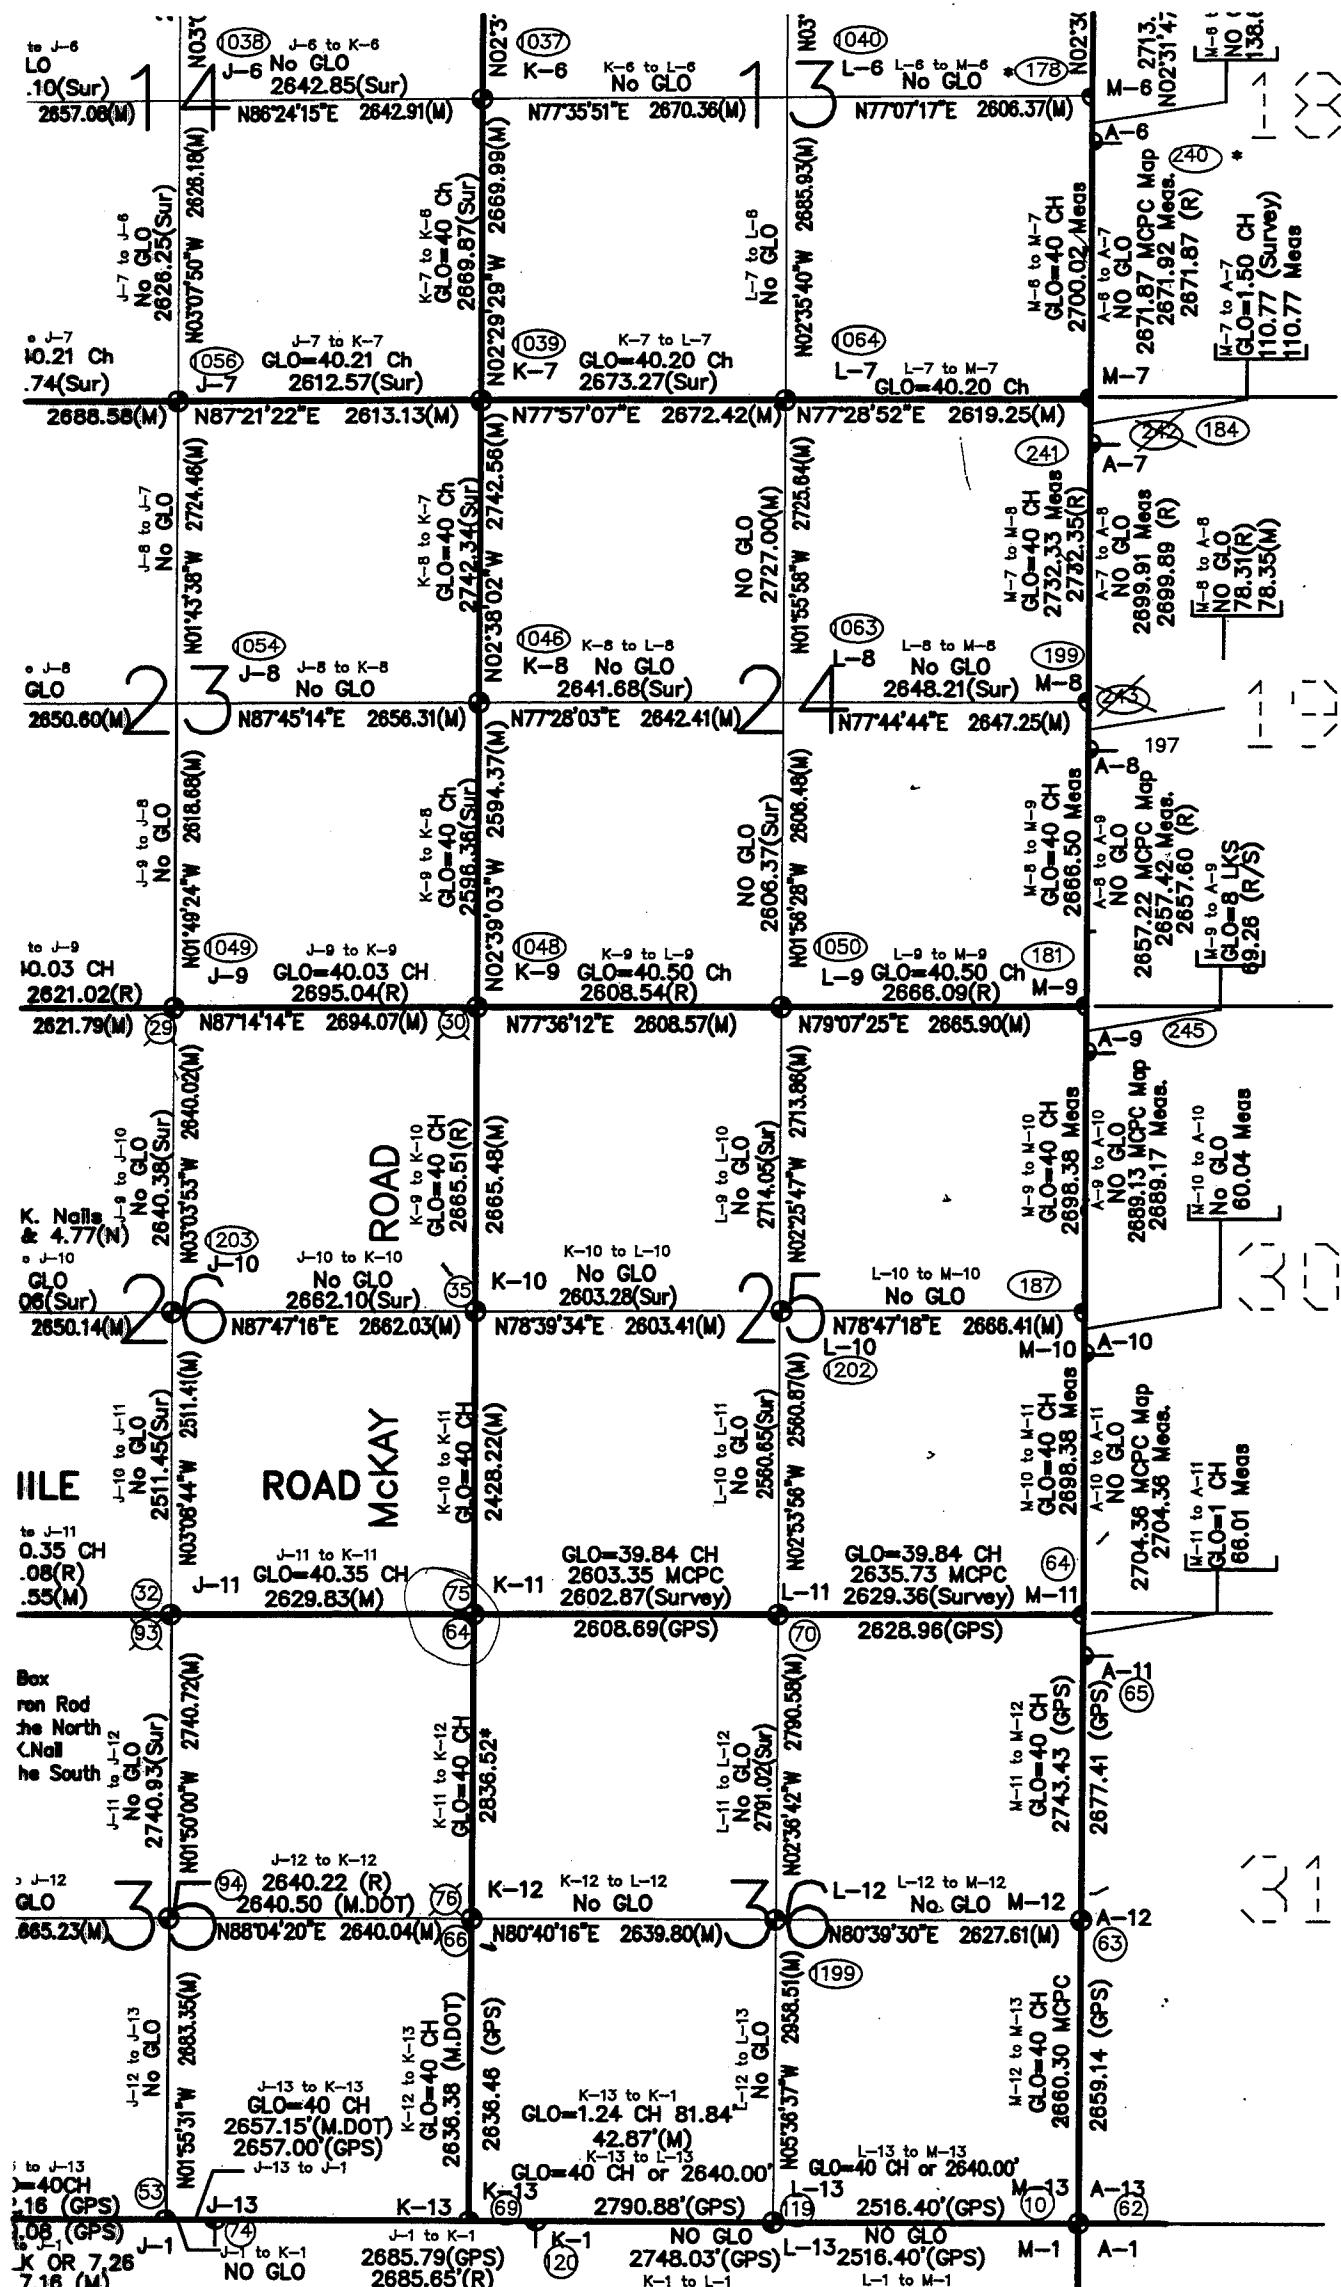

1024265 LIBER:09054 PAGE:814 09:25A 08/17/1999
CARMELLA SABAUGH-MACOMB COUNTY, MI REG/DEEDS

LAND CORNER RECORDATION CERTIFICATE
Filing Requirement of Act 74, Mich. P.A. 1970

For corners in

Macomb (County)	Located In:	Corner Code #
	Bruce Township	
1. Public Land Survey	T 5 N R 12 E	M-3
	T _____	R _____
	T _____	R _____
2. Property Controlling in Section	S _____	R _____
3. Miscellaneous Property in Sec.	S _____	R _____
	S _____	R _____
	S _____	R _____

4. Lot No. _____, Recorded Plat _____
5. Private Claims _____

ACCEPTED BY THE MACOMB COUNTY SURVEY PEER GROUP AS THE OFFICIAL CORNER UNDER MICHIGAN PUBLIC ACT 345 OF 1990 AT A MEETING HELD ON

William E. Soderberg
WILLIAM E. SODERBERG, P.S., CHAIRMAN

Register of Deeds Stamp & File Number

A	B	C	D	E	F	G	H	I	J	K	L	M
1												
2	6		5	4	3		2		1			
3												
4	7		8	9	10	11		12				
5												
6	18		17	16	15	14		13				
7												
8	19		20	21	22	23		24				
9												
10	30		29	28	27	26		25				
11												
12	31		32	33	34	35		36				
13												

I, Huston K. Kennedy, in a field survey on April 15, 1999 do hereby state that under requirements of P.A. 74, Michigan P.A. of 1970, the corner points mentioned in lines 1 and 2 above were in conformance with regulations and rules therefore as required in the current manual of survey instructions of the United States Department of the Interior, Bureau of Land Management or by a decree of a Court of Law and/or that the corner points mentioned in lines 3, 4 and 5 above were in conformance with the rules of the Michigan Board of Land Surveyors or by a Decree of a Court of Law, established, re-established, monumented, recovered, found as expressed below:

NOTE: Not more than 2 corners, all in the same town and range, may be recorded on this certificate.

- A. Description of original monument and accessories and/or subsequent restoration:
1817-GLO Wampler, D.S.; Set Post 12" Sugar Tree East 5 Links; 14" Maple N49°W 14 Links
- B. Description of corner evidence found and/or method applied in restoring or reestablishing corner:
1999-Kennedy Surveying, Inc. – Kennedy, PS #17623 – After a lengthy discussion with the peer group, the corner was recovered on a line between A-3 T5N, R13E, M-4 T5N, R12E, and at the distance shown 2515.51 feet as shown on the M.C.P.C. Map for Bruce Township (1-F) which puts this corner 0.18 feet South of A-3 (Amada Twp.) This position was adjusted 0.18 feet to the North and resulting in a common corner with A-3 (Amada Township). The corner as recovered is located 10 feet West of a existing ditch extending to the North & South. There are no lines of occupation to the East or West.

FIELD MEASUREMENTS BETWEEN

M-3 to A-3

GLO = 30 Links or 19.80 Ft.
M-3 (Bruce Township) as recovered, is a common corner to A-3

M-3 to M-2

GLO = 40 chains or 2640.00 Ft.
2856.06 Ft. (MCPC Map)
2849.63 Ft. (MEA 1999)

M-3 to M-4

GLO = 40 chains or 2640.00 FT
2515.51 Ft. (MCPC Map)
2515.69 Ft. (MEA 1999)

- C. Description of monument for corner and accessories established to perpetuate locating the position of the corner:
M-3 I set a 4" diameter Concrete Monument with a ½" x 36" long Iron Rod w/2" diameter aluminum cap stamped "Macomb County Monument, MI #345", PS #17623
S31°E 96.37' Set Mag Nail & Remon Washer NE face 6" Maple
S46°E 183.26' Set Mag Nail & Remon Washer NE face 8" Elm
S51°E 92.86' Set Mag Nail & Remon Washer NW face 6" Elm
S62°E 83.02' Set Mag Nail & Remon Washer North face 9" Elm

The selected location is accepted by me and is generally accepted by Professional Surveyors as the best available evidence of the position of the original corner.

Signed by: *[Signature]*

Date 0-5-99

Surveyor's Michigan License No. 07623



CERTIFICATE OF SURVEY

CERTIFICATE OF SURVEY

115526 NO 6

DESCRIPTION OF PARCEL "A"

A parcel of land located in the Northwest Fractional Quarter of Section 7, T. 5 N., R. 13 E., Armada Township, Macomb County, Michigan, described as BEGINNING at the Northwest corner of said Section 7 thence proceed S. 00° 09' 35" W. 1918.10 feet along the West line of said Section 7; thence S. 87° 48' 30" E. 548.57 feet; thence N. 00° 09' 35" E. 1935.89 feet; thence N. 89° 30' 00" W. along the North line of said Section 7 to the point of beginning, containing therein 25.076 acres of land, more or less, subject to existing easements of record.

DESCRIPTION OF PARCEL "B"

A parcel of land located in Sections 1 and 12, T. 5 N., R. 12 E., Bruce Township, and also in Sections 6 and 7, T. 5 N., R. 13 E., Armada Township, all in Macomb County, Michigan, being described as BEGINNING at the South Quarter Corner of Section 1, T. 5 N., R. 12 E., Bruce Township, thence proceed N. 00° 26' 50" W. 2532.39 feet along the N-S 1/4 line of said Section 1, thence continue N. 00° 26' 50" W. 69.50 feet; thence N. 79° 27.50" E. 670.27 feet; thence S. 00° 03' 25" W. 130.74 feet; thence N. 77° 54' 35" E. 730.05 feet; thence S. 00° 17' 25" W. 204.70 feet; thence N. 81° 40' 35" E. 1237.10 feet; thence along the West line of Section 6, T. 5 N., R. 13 E., Armada Township, N. 00° 20' 25" W. 89.10 feet; thence S. 88° 26' 55" E. 1955.64 feet; thence S. 00° 03' 25" W. 1342.09 feet along the N-S 1/4 line of said Section 6; thence along the N-S 1/4 line of Section 7, S. 00° 19' 30" E. 2011.29 feet; thence N. 87° 48' 30" W. 1417.36 feet; thence N. 00° 09' 35" E. 1993.89 feet; thence N. 89° 30' 00" W. 548.42 feet; thence S. 00° 09' 35" E. 474.84 feet along the East line of Section 12; thence S. 79° 55' 00" W. 2633.73 feet; thence N. 00° 17' 10" E. 643.47 feet along the N-S 1/4 line of said Section 12 to the point of beginning, containing therein 253.518 acres of land, more or less, subject to road rights of way and existing easements of record.

WITNESSES

Center Sec. 6, T. 5 N., R. 13 E. - Fd. 1" T-Bar
Fd. Nail in Fe. Post - 40.77' SW
Fd. Nail in 12" Ø stump - 26.75' East
Center of Concrete Post Base - 56.80' NW

South 1/4 Cor. Sec. 6 - Fd. 1" T-Bar
Fd. Nail in 24" Oak - 92.15' NW
Fd. Nail in 36" Oak - 27.83' East
Fd. Nail in 24" Stump - 52.50' SW

South 1/4 corner Sec. 1, T. 5 N., R. 13 E. - Fd. 3/4" Pipe.
Nail in 8" Cherry - 4-4.76' NW.
Nail in Anchor Post - 35.85' N.
Nail in 8" Ash - 35.9 NE

Ronald J. Ruszala

SEAL



RONALD JOHN RUSZALA, R.L.S.
8740 Cherrwood Drive
Warren, Michigan 48081

PARCELS "A" & "B"


PARK LANE ESTATES

SECTION ____ TOWN ____ RANGE ____
ARMADA & BRUCE TOWNSHIPS
MACOMB COUNTY, MICHIGAN

DATE SURVEYED: 8/1/23
BY: R.J.R. NO. 21581
DATE OF SURVEY: 8/1/23

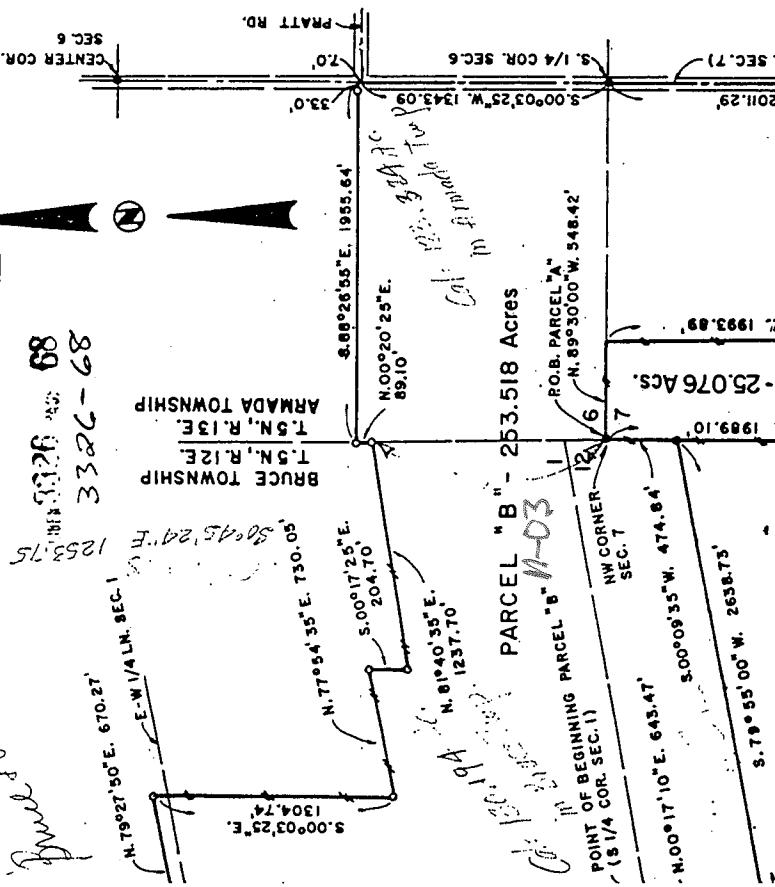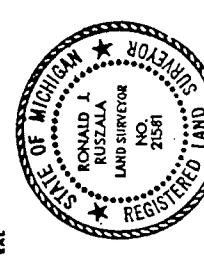

RECORDED IN MACOMB COUNTY
RECORDS AT: 1/2: 30 P. M.
4PR2J 1981.
CLERK, REGISTER OF DEEDS
MACOMB COUNTY, MICHIGAN
BEARING: N. 1/4 LINE SEC. 12

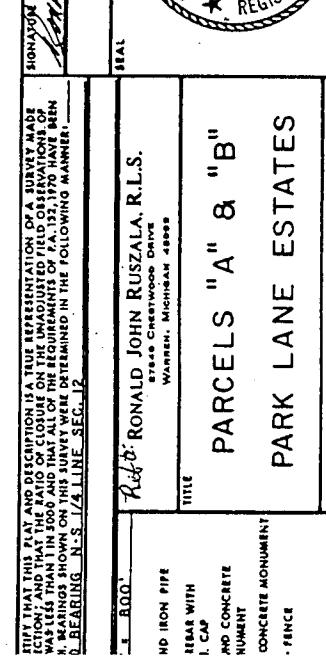

Ronald J. Ruszala

SEAL

RONALD JOHN RUSZALA, R.L.S.
8740 Cherrwood Drive
Warren, Michigan 48081

PARCELS "A" & "B"

PARK LANE ESTATES

SECTION ____ TOWN ____ RANGE ____
ARMADA & BRUCE TOWNSHIPS
MACOMB COUNTY, MICHIGAN

DATE SURVEYED: 8/1/23
BY: R.J.R. NO. 21581
DATE OF SURVEY: 8/1/23

1024268 LIBER:09054 PAGE:817 09:25A 08/17/1999
CARMELLA SABAUGH-MACOMB COUNTY, MI REG/DEEDS

LAND CORNER RECORDATION CERTIFICATE
Filing Requirement of Act 74, Mich. P.A. 1970

For corners in

Macomb _____ (County)	Located In: Armada Township	Corner Code #
1. Public Land Survey	T 5N R 13E	A-3
	T R	_____
	T R	_____
	T R	_____
2. Property Controlling in Section	S T R	_____
3. Miscellaneous Property in Sec.	S T R	_____
	S T R	_____

ACCEPTED BY THE MACOMB COUNTY SURVEY PEER
GROUP AS THE OFFICIAL CORNER UNDER MICHIGAN
PUBLIC ACT 345 OF 1990 AT A MEETING HELD
ON 7-27-99

William E. Soderberg
WILLIAM E. SODERBERG, P.S., CHAIRMAN

Register of Deeds Stamp & File Number

4. Lot No. _____, Recorded Plat _____
5. Private Claims _____

I, Huston K. Kennedy, in a field survey on March 17, 1999 do hereby state that under requirements of P.A. 74, Michigan P.A. of 1970, the corner points mentioned in lines 1 and 2 above were in conformance with regulations and rules therefore as required in the current manual of survey instructions of the United States Department of the Interior, Bureau of Land Management or by a decree of a Court of Law and/or that the corner points mentioned in lines 3, 4 and 5 above were in conformance with the rules of the Michigan Board of Land Surveyors or by a Decree of a Court of Law; established, re-established, monumented, recovered, found as expressed below:

NOTE: Not more than 2 corners, all in the same town and range, may be recorded on this certificate.

	A	B	C	D	E	F	G	H	I	J	K	L	M
1													
2	6		5		4		3		2				1
3													
4	7		8		9		10		11				12
5													
6	18		17		16		15		14				13
7													
8	19		20		21		22		23				24
9													
10	30		29		28		27		26				25
11													
12	31		32		33		34		35				36
13													

A. Description of original monument and accessories and/or subsequent restoration:
1817-GLO Preston, D.S.; No post was set, no witnesses
1.) 1981-Ruszala, PS #21581; Survey L.3326, Pgs. 68 & 69

B. Description of corner evidence found and/or method applied in restoring or reestablishing corner:
1999-Kennedy Surveying, Inc. - Kennedy, PS #17623 - The corner was recovered based upon the tax description for Parcel 01-01-400-003 and is located 10 feet West of the center of a ditch extending to the North & South. No line of occupation to the East & West. M-3 (Bruce Township) as recovered, is a common corner with A-3 (Armada Township).

I found no other evidence to dispute the recovered position of this corner.

FIELD MEASUREMENTS BETWEEN

A-3 to A-2

No GLO
M.C.P.C. Map = 2619.12 Ft.
2619.66 Ft. (MEA 1999)

A-3 to B-3

GLO = 29.50 chains or 1947.00 Ft.
1948.26 Ft. or 1960.36 Ft. per description per 02-07-100800
1942.98Ft. (MEA 1999)

A-3 to A-4

No GLO
M.C.P.C. Map = 2652.84 Ft.
2652.75 Ft. (MEA 1999)

A-3 to M-3

GLO = 30 Links or 19.80 Ft.
M-3 (Bruce Twp.) as recovered, is a common corner to A-3 (Armada Township).



C. Description of monument for corner and accessories established to perpetuate locating the position of the corner:
A-3 I set a 4" diameter Concrete Monument with a 1/2" x 36" long Iron Rod w/2" diameter aluminum cap stamped "Macomb County Monument, MI #345", PS #17623
S31°E 96.37' Set Mag Nail & Remon Washer NE face 6" Maple
S46°E 183.26' Set Mag Nail & Remon Washer NE face 8" Elm
S51°E 92.86' Set Mag Nail & Remon Washer NW face 6" Elm
S62°E 83.02' Set Mag Nail & Remon Washer North face 9" Elm

The selected location is accepted by me and is generally accepted by Professional Surveyors as the best available evidence of the position of the original corner.

Signed by: Huston K. Kennedy

Date 8-5-99

Surveyor's Michigan License No. 17623

MIL 3327 Aut 219

CERTIFICATE OF SURVEY

DESCRIPTION OF PROPERTY

A701238

A parcel of land situated in the Southwest and Northwest Fractional Quarters of Section 6, T. 5 N., R. 13 E., Armada Township, and the Southeast And Northeast Fractional Quarters of Section 1, T. 5 N., R. 12 E., Bruce Township, all being in Macomb County, Michigan, being more particularly described as BEGINNING at the Northwest corner of Section 6, T. 5 N., R. 13 E., thence proceed S. 00° 13' 20" E. 180.90 feet along the west line of said Section 6; thence S. 39° 14' 44" E. 1994.59 feet; thence S. 00° 03' 25" W. 204.70 feet along the N-S 1/4 Line of said Section 6; thence continuing S. 00° 03' 25" W. 296.39 feet; thence N. 89° 35' W. 1090.09 feet; thence S. 00° 03' 25" W. 800.00 feet; thence S. 00° 03' 25" W. 232.66 feet along said N-S 1/4 line of Section 6; thence N. 88° 26' 55" W. 1955.64 feet thence S. 00° 20' 25" W. 89.10 feet along the East Line of Section 1, T. 5 N., R. 12 E.; thence S. 81° 40' 35" W. 1237.70 feet; thence N. 03° 17' 25" W. 204.70 feet; thence S. 77° 35' W. 730.05 feet; thence N. 00° 03' 25" W. 1334.74 feet; thence S. 79° 27' 50" W. 670.27 feet; thence along the N-S 1/4 line of said Section 6, T. 5 N., R. 13 E. 1618.94 feet; thence Continuing along said N-S 1/4 line of Section 1, T. 5 N., R. 12 E. 131.35" E. 244.00 feet; thence N. 00° 13' 20" E. 1178.11 feet; thence S. 89° 31' 35" E. 2356.94 feet along the North line of said Section 1 to the point of beginning, containing therein 329.505 Acres of land, more or less, subject to road rights of way and subject to easements of record.

NW Corner Section 6, T. 5 N., R. 13 E.

(1/2" Iron Bar)

Nail in anchor post SW 20.67 ft.

Nail in 16" Pole NE 60.05 ft.

Nail in stump NE 17.72 ft.

08/24/11

MACOMB COUNTY TREASURER
TED B. WAHBY

----- TAX HISTORY -----

ARMADA TWP

Property Number: 13-02-06-100-003
Property Address: 15300 BORDMAN

Alt. Property Number: 13-02-00-600-110
School Code: 50050

TAX YEAR	TAX. VALUE	BASE TAX	BASE TAX DUE	INTEREST/FEE'S DUE	TOTAL DUE	LAST PMT
2010			0.00	0.00	0.00	
2009	0		0.00	0.00	0.00	
2008	0		0.00	0.00	0.00	
2007	0		0.00	0.00	0.00	
2006	0		0.00	0.00	0.00	
2005	0		0.00	0.00	0.00	
2004	0		0.00	0.00	0.00	
2003	0		0.00	0.00	0.00	
2002	0		0.00	0.00	0.00	
2001	0		0.00	0.00	0.00	
TOTAL			0.00	0.00	0.00	

Fees Due As Of: 08/24/11

DESCRIPTION OF PROPERTY:

T5N, R13E, SEC 6: COMM AT N 1/4 COR SEC 6; TH S89*58'08"W 1595.67 FT ALG N SEC LINE TO POB; TH S0*0'56"W 1830.22 FT; TH N89*56'35"W 366.10 FT; TH N0*0'56"E 1829.65 FT; TH N89*58'08"E 366.10 FT ALG N SEC LINE TO POB. 15.38 AC.

SPLIT FROM 0206100001 FOR 1997

History Fees: 0.00

Taxpayer: STOICK MICHAEL & BRENDA

15300 BORDMAN RD

ARMADA


MI 48005

N.W. COR.

BORDMAN

N. 1/4 POS. 1

Drain

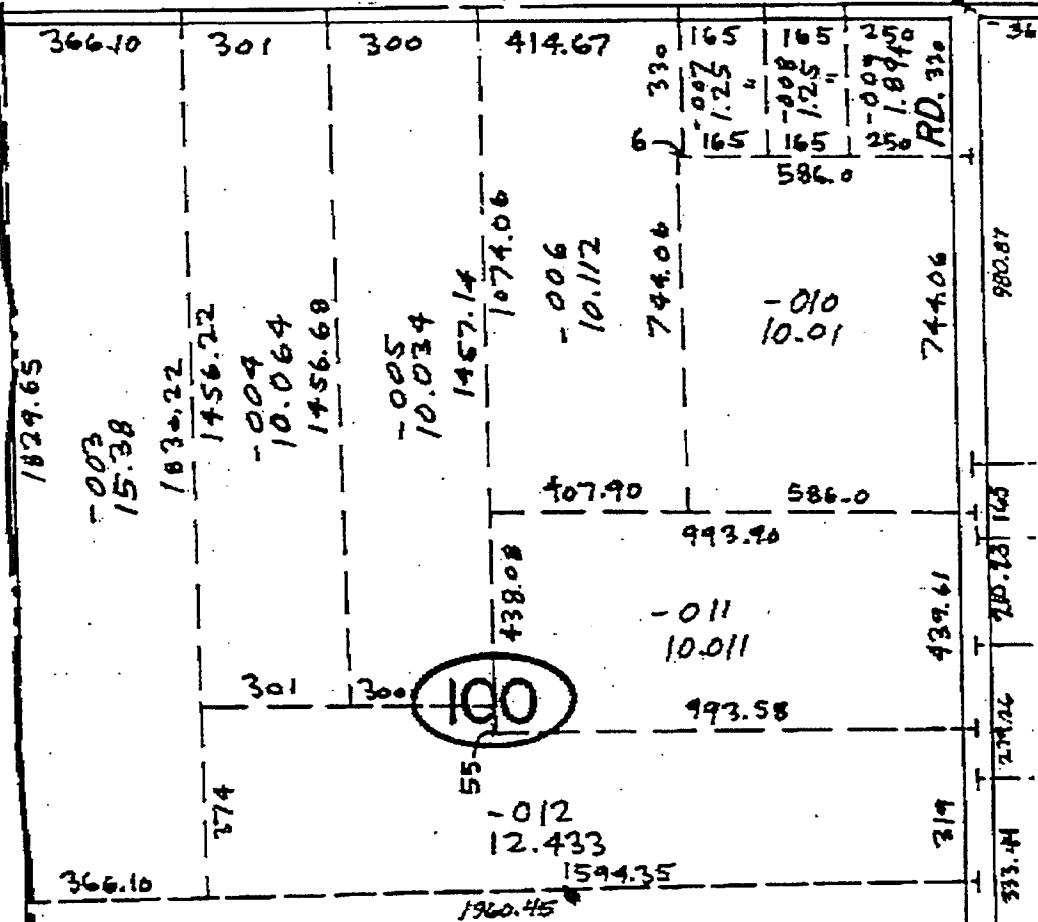

W. 1/4 POST-

三

-002
50.096

1976.08

-005
38.313

1957.63

1090.09
-003

四庫全書

300

-004
10.01
1090.09

— 1 —

08/24/11

MACOMB COUNTY TREASURER
TED B. WAHBY

----- TAX HISTORY -----

ARMADA TWP

Property Number: 13-02-06-100-002

Alt. Property Number: 13-02-00-600-200

Property Address: MCFADDEN

School Code: 50050

TAX YEAR	TAX. VALUE	BASE TAX	BASE TAX DUE	INTEREST/FEE'S DUE	TOTAL DUE	LAST PMT
2010			0.00	0.00	0.00	
2009	0		0.00	0.00	0.00	
2008	0		0.00	0.00	0.00	
2007	0		0.00	0.00	0.00	
2006	0		0.00	0.00	0.00	
2005	0		0.00	0.00	0.00	
2004	0		0.00	0.00	0.00	
2003	0		0.00	0.00	0.00	
2002	0		0.00	0.00	0.00	
2001	0		0.00	0.00	0.00	
TOTAL			0.00	0.00	0.00	

Fees Due As Of: 08/24/11

DESCRIPTION OF PROPERTY:

T5N, R13E, SEC 6, COMM AT N 1/4 COR SEC 6; TH S00*03'25"W 1832.67 FT TO POB; TH EXT S00*03'25"W 1113.92 FT; TH N89*56'35"W 1957.36 FT; TH N00*05'18"W 1113.92 FT; TH S89*56'35"E 1960.45 FT TO POB. 50.096 A.

History Fees: 0.00

Taxpayer: RUTHENBERG MATTHEW
80700 MCFADDEN RD
ARMADA

MI 48005

(2)

N.W. COR.—

BORDMAN

N. 1/4 POS

Drain

W. 1/4 POST-

DO NOT
COLLECT WITH

1957.63

-005
38.313

-005
38.313

1090.09

300

-004
1001

30

08/24/11

MACOMB COUNTY TREASURER
TED B. WAHBY

----- TAX HISTORY -----

ARMADA TWP

Property Number: 13-02-06-300-005

Alt. Property Number: 13-02-00-601-200

Property Address: MCFADDEN

School Code: 50050

TAX YEAR	TAX. VALUE	BASE TAX	BASE TAX DUE	INTEREST/FEES DUE	TOTAL DUE	LAST PMT
2010			0.00	0.00	0.00	
2009	0		0.00	0.00	0.00	
2008	0		0.00	0.00	0.00	
2007	0		0.00	0.00	0.00	
2006	0		0.00	0.00	0.00	
2005	0		0.00	0.00	0.00	
2004	0		0.00	0.00	0.00	
2003	0		0.00	0.00	0.00	
2002	0		0.00	0.00	0.00	
2001	0		0.00	0.00	0.00	
TOTAL			0.00	0.00	0.00	

Fees Due As Of: 08/24/11

DESCRIPTION OF PROPERTY:

T5N;R13E, SEC 6, BEG AT CEN POST SEC 6; TH S00*03'25"W 296.30 FT; TH N89*56'35"W 1090.09 FT; TH S00*03'25"W 800.00 FT; TH S89*56'35"E 1090.09 FT; TH S00*03'25"W 225.74 FT; TH N88*35'34"W 1954.92 FT; TH N00*05'18"W 1276.08 FT; TH S89*56'35"E 1957.63 FT TO POB.
38.313 A.


SPLIT FROM 0206300002 FOR 1981

History Fees: 0.00

Taxpayer: RUTHENBERG MATTHEW
80700 MCFADDEN RD
ARMADA

MI 48005



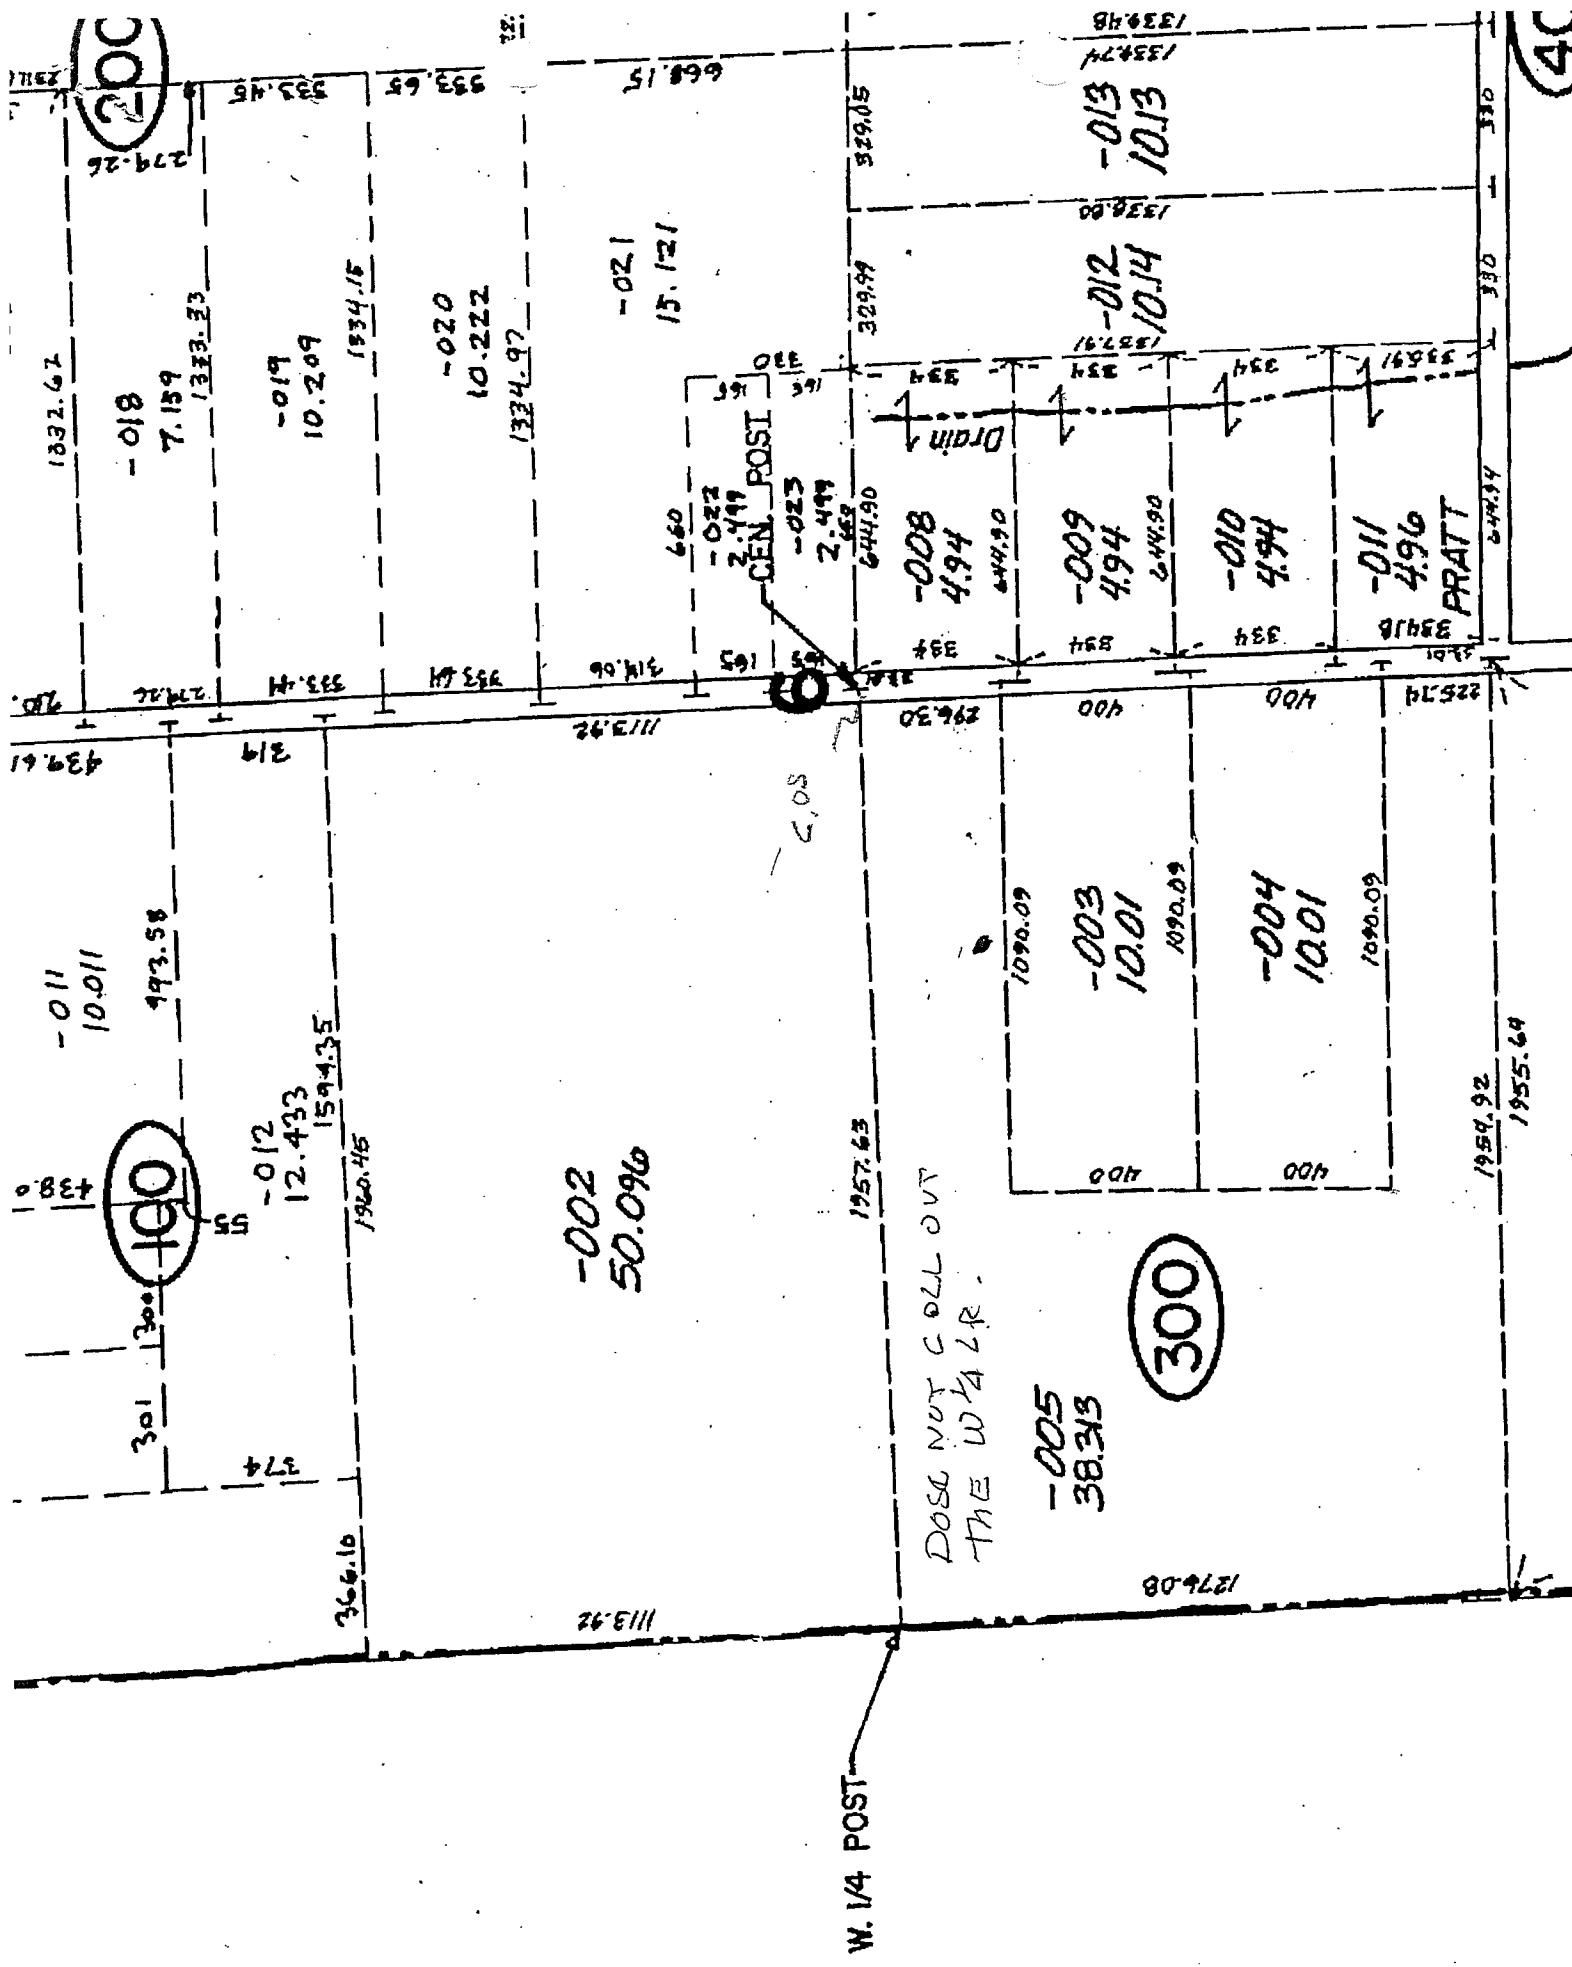

08/24/11

MACOMB COUNTY TREASURER
TED B. WAHBY

----- TAX HISTORY -----

ARMADA TWP

Property Number: 13-02-07-100-009
Property Address: MCFADDEN

Alt. Property Number: 13-02-00-700-150
School Code: 50050

TAX YEAR	TAX. VALUE	BASE TAX	BASE TAX DUE	INTEREST/FEES DUE	TOTAL DUE	LAST PMT
2010			0.00	0.00	0.00	
2009	0		0.00	0.00	0.00	
2008	0		0.00	0.00	0.00	
2007	0		0.00	0.00	0.00	
2006	0		0.00	0.00	0.00	
2005	0		0.00	0.00	0.00	
2004	0		0.00	0.00	0.00	
2003	0		0.00	0.00	0.00	
2002	0		0.00	0.00	0.00	
2001	0		0.00	0.00	0.00	
TOTAL			0.00	0.00	0.00	

Fees Due As Of: 08/24/11

DESCRIPTION OF PROPERTY:

SECS 6 & 7; BEG AT NW COR SEC 7; TH S0*09'35"W 1989.10 FT ALG W LINE SEC 7; TH S87*48'-30"E 1965.93 FT; TH N0*19'30"W 2011.29 FT ALG N-S 1/4 LINE TO N 1/4 POST SEC 7; TH N0*03'25" E 1343.09 FT ALG N-S 1/4 LINE SEC 6; TH N88*26'55"W 1955.64 FT TO W LINE SEC 6; TH S0*15'-29"W 1343.04 FT ALG W LINE SEC 6 TO POB. 149.969 A.

84 COMBINE OF 0207100007 & 008

History Fees: 0.00

Taxpayer: GODO MICHAEL G & R PAUL
4086 HOWLAND RD
ALMONT MI 48003

Coordinates updated 8/11
Bearing and Distance updated 8/11

T. 5 N. - R. 12 E.

B	2653.93'(M) 2654.12'(R)	C-13 C-1
	B-1 to C-1 NO GLO 2658.58'(R) N87°37'16"E 2658.38'	C-1 607 657
	B-1 to B-13 No GLO 367.27'(M) 367.15'(R)	C-1 to C-2 GLO=5.5 362.83'(I)
	B-2 to C-2 NO GLO 2673.90'(Sur) C-2	C-2 to C-2 GLO=44.52 Ch 1752
	N88°42'16"E 2673.57'(M)	N87°49'15"E
PRATT		
	B-3 to C-3 GLO=40 Ch 2678.20'(Sur) C-3	C-2 to C-3 GLO=40 Ch 1760 2691.33'(Sur)
	N89°07'09"E 2677.63'(M)	N88°05'53"E 2691.31(M)
ROAD		
	B-4 to C-4 NO GLO 2659.76'(Sur)	C-3 to C-4 GLO=40 Ch 1788 2669.40'(Sur)
	N89°14'40"E 2659.57'(M)	N88°00'12"E 2668.83'(M)
ROAD		
	B-5 to C-5 GLO=40 Ch	C-4 to C-5 GLO=40 Ch 1794 2663.98'(Sur)
	N89°09'50"E 2653.13'(M)	N88°42'16"W 2663.76'(M)
PLANK		
	B-6 to C-6 NO GLO 2663.88'(Sur) C-6	C-5 to C-6 GLO=40 Ch 1805 2674.32'(Sur)
	N88°44'35"E 2663.83'(M)	N03°08'27"W 2674.03'(M)
ROMEO		
	B-7 to C-7 GLO 40 Ch 2649.54'(Sur) C-7	C-6 to C-7 GLO=40 Ch 1831 2674.02'(Sur)
	N88°50'07"E 2649.31'(M)	N02°46'40"W 2673.60'(M)
ROMEO		
	B-8 to C-8 GLO 40 Ch (Sur) C-8	C-7 to C-8 GLO=40 2673.50' 701.81'(M)
	N88°02'16"E 2673.50'(M)	N88°02'16"E 2673.50'(M)

BRUCE

TOWNSHIP

Survey Points and Data:

- A-1:** M-11 to A-11, GLO=1 CH, 66.01 Meas
- A-2:** M-10 to A-10, No GLO, 60.04 Meas
- A-3:** M-10 to M-11, GLO=40 CH, 2698.38 Meas
- A-4:** M-11 to M-12, GLO=40 CH, 2743.43 (GPS)
- A-5:** N02°27'52"W 2677.30'(M)
- A-6:** N02°27'53"W 2704.02'(M)
- A-7:** A-7 to B-7, GLO=30 Ch, 1986.52'(Sur), N88°30'31"E 1985.72'(M)
- A-8:** A-8 to B-8, No GLO, 1972.79'(Sur), N88°22'57"E 1973.49'(M)
- A-9:** A-9 to B-9, GLO=30 Ch, 1973.73'(Sur), N88°55'33"E 1973.82'(M)
- A-10:** A-10 to B-10, No GLO, 1992.30'(Sur), N87°59'55"E 1992.15'(M)
- A-11:** A-11 to B-11, GLO=30.07 Ch, 2010.01'(URS), N87°42'09"E 2009.76'(M)
- A-12:** M-12 to A-12, No GLO, 2018.36'(Sur), N87°19'11"E 2018.05'(M)
- A-13:** T5N,R12E M-13, GLO=40 CH, 2660.30 MCPC, N02°21'49"W 2659.17'(M)
- A-14:** T5N,R13E A-13, A-13 to B-13, No GLO, N03°21'59"W 2689.95'(M)
- B-1:** N02°48'33"W 2685.91(M)
- B-2:** B-7 to C-7, GLO 40 Ch, 2649.54'(Sur), N88°50'07"E 2649.31'(M)
- B-3:** B-8 to C-8, No GLO, 2670.87'(Sur), N88°57'43"E 2670.34'(M)
- B-4:** B-9 to C-9, GLO=40 Ch, 2683.02'(Sur), N87°49'59"E 2682.47'(M)
- B-5:** B-10 to B-10, No GLO, 2683.26'(Sur), N88°26'52"E 2683.53'(M)
- B-6:** B-11 to B-11, No GLO, 2694.14'(Sur), N87°50'00"E 2683.85'(M)
- B-7:** B-11 to C-11, GLO=40 Ch, 2684.14'(Sur), N87°22'1"
- B-8:** A-8 to B-8, No GLO, 2657.08'(M), N02°33'36"W 2675.79'(M)
- B-9:** B-8 to B-9, No GLO, 2675.95'(Sur), N02°47'42"W 2657.02'(M)
- B-10:** B-9 to B-10, No GLO, 2657.76'(Sur), N88°17'00"E 2691.92'(M)
- B-11:** B-11 to B-12, No GLO, 2664.35'(Sur), N02°38'34"W 2663.95'(M)
- B-12:** B-12 to C-12, No GLO, 2690.29'(Sur), N02°48'34"W 2685.17(M)
- B-13:** B-12 to B-13, No GLO, 2660.30 MCPC, N02°48'27"W 2685.88(M)
- C-1:** C-7 to C-8, GLO=40 CH, 2702.12'(Sur), N02°43'32"W 2701.81(M)
- C-2:** C-8 to C-9, GLO=40 CH, 2673.70'(Sur), N02°50'38"W 2623.31(M)
- C-3:** C-9 to C-10, GLO=40 CH, 2665.31(Sur), N02°51'29"W 2665.06(M)
- C-4:** C-10 to C-11, GLO=40 CH, 2665.31(Sur), N02°48'33"W 2685.91(M)
- C-5:** C-11 to C-12, GLO=40 CH, 2685.40(Sur), N88°17'58"
- ROAD:** C-12 to C-13, GLO=40 CH, 2685.40(Sur), N02°48'33"W 2685.91(M)
- ROMEO PLANK:** C-13 to C-14, GLO=40 CH, 2686.16(Sur), N02°48'33"W 2685.91(M)
- T4N,R12E M-1:** N88°20'5"
- T4N,R13E A-1:** N88°17'58"

5/25/99
TABER
6/29/99
TABER
7/27/99

1999

MACOMB COUNTY REMONUMENTATION PROGRAM FOR BRUCE TOWNSHIP

Research Dossier for M-3

Comm'dr. A.B.
Detroit
Fent

Prepared by:
Kennedy Surveying, Inc.
105 N. Washington St.
Oxford, Michigan 48371

1024265 LIBER:09054 PAGE:614 09:25A 08/17/1999
CARMELLA SABAUGH-MACOMB COUNTY, MI REG/DEEDS

LAND CORNER RECORDATION CERTIFICATE
Filing Requirement of Act 74, Mich. P.A. 1970

For corners in

Macomb
(County)

Located in:
Bruce Township

Corner Code #

1. Public Land Survey
2. Property Controlling
In Section
3. Miscellaneous
Property in Sec.

T5N R12E M-3
T _____
T _____
T _____
S _____
S _____
S _____
S _____

4. Lot No. _____ Recorded Plat _____
5. Private Claims _____

APPROVED BY THE MACOMB COUNTY SURVEY PEER
GROUP AS THE OFFICIAL CORNER UNDER MICHIGAN
PUBLIC ACT 345 OF 1990 AT A MEETING HELD
ON 7-27-99.

Huston K. Kennedy
WILLIAM E. SODERBERG, P.S., CHAIRMAN

Register of Deeds Stamp & File Number

A	B	C	D	E	F	G	H	I	J	K	L	M
1												
2												
3												
4												
5												
6												
7												
8												
9												
10												
11												
12												
13												

I, Huston K. Kennedy, in a field survey on April 15, 1999 do hereby state that under requirements of P.A. 74, Michigan P.A. of 1970, the corner points mentioned in lines 1 and 2 above were in conformance with regulations and rules therefore as required in the current manual of survey instructions of the United States Department of the Interior, Bureau of Land Management or by a decree of a Court of Law and/or that the corner points mentioned in lines 3, 4 and 5 above were in conformance with the rules of the Michigan Board of Land Surveyors or by a Decree of a Court of Law, established, re-established, monumented, recovered, found as expressed below:

NOTE: Not more than 2 corners, all in the same town and range, may be recorded on this certificate.

- A. Description of original monument and accessories and/or subsequent restoration:
1817-GLO Wampler, D.S.; Set Post 12" Sugar Tree East 5 Links; 14" Maple N49°W 14 Links
- B. Description of corner evidence found and/or method applied in restoring or reestablishing corner:
1999-Kennedy Surveying, Inc. - Kennedy, PS #17623 - After a lengthy discussion with the peer group, the corner was recovered on a line between A-3 T5N, R13E, M-4 T5N, R12E, and at the distance shown 2515.51 feet as shown on the M.C.P.C. Map for Bruce Township (1-F) which puts this corner 0.18 feet South of A-3 (Armeda Twp.) This position was adjusted 0.18 feet to the North and resulting in a common corner with A-3 (Armeda Township). The corner as recovered is located 10 feet West of a existing ditch extending to the North & South. There are no lines of occupation to the East or West.

FIELD MEASUREMENTS BETWEEN

M-3 to A-3

GLO = 30 Links or 19.80 Ft.
M-3 (Bruce Township) as recovered, is a common corner to A-3

M-3 to M-4

GLO = 40 chains or 2640.00 FT
2515.51 Ft. (MCP Map)
2515.69 Ft. (MEA 1999)

M-3 to M-3

GLO = 40 chains or 2640.00 FT
2658.08 Ft. (MCP Map)
2849.63 Ft. (MEA 1999)



- C. Description of monument for corner and accessories established to perpetuate locating the position of the corner:
M-3 I set a 4" diameter Concrete Monument with a 1/2" x 36" long Iron Rod w/2" diameter aluminum cap and Macomb County Monument, MI #3457, PS #17623
S31°E 96.37' Set Mag Nail & Remon Washer NE face 6" Maple
S46°E 183.28' Set Mag Nail & Remon Washer NE face 8" Elm
S51°E 82.66' Set Mag Nail & Remon Washer NW face 6" Elm
S62°E 83.02' Set Mag Nail & Remon Washer North face 9" Elm

The selected location is accepted by me and is generally accepted by Professional Surveyors as the best available evidence of the position of the original corner.

Signed by: Huston K. Kennedy

Date 8-5-99

Surveyor's Michigan License No. 07623

REC'D MAY 26 2005

5095049
LIBER 16741 PAGE 342



05/26/2005 03:38:50 P.M.
MACOMB COUNTY, MI
CARMELLA SABAUGH, REGISTER OF DEEDS

SEAL


For corners in

Macomb
(County)

Located In: Corner Code #
Bruce Twp.

1. Public Land Survey	T	S N.	R	12E.	M-3, M-4
		T	R		
		T	R		
2. Property Controlling in Section	S	T	R		
3. Miscellaneous Property in Sec.	S	T	R		
	S	T	R		
4. Lot No.		Recorded Plat			
5. Private Claims					

Register of Deeds Stamp & File Number

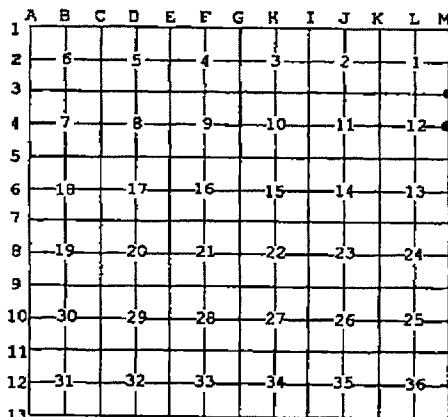

I, Jeffrey A. Wright, in a field survey on 05 October 2004 do hereby state that under requirements of P.A. 74, Michigan P.A. of 1970, the corner points mentioned in lines 1 and 2 above were in conformance with regulations and rules therefore as required in the current manual of survey instructions of the United States Department of the Interior, Bureau of Land Management or by a decree of a Court of Law and/or that the corner points mentioned in lines 3, 4 and 5 above were in conformance with the rules of the Michigan Board of Land Surveyors or by a Decree of a Court of Law; established, re-established, monumented, recovered, found as expressed below:

NOTE: Not more than 2 corners, all in the same town and range, may be recorded on this certificate.

A. Description of original monument and accessories and/or subsequent restoration:

- M-3 LCRC Liber 9054, Page 814
2001-King PS #30085, Job#01041
- M-4 LCRC Liber 9054, Page 815
2001-King PS #30085, Job#01041

B. Description of corner evidence found and/or method applied in restoring or reestablishing corner:

- M-3 F. monument, previously recorded as M.C.R. monument
- M-4 F. M.C.R.M. #17623, as previously recorded



C. Description of monument for corner and accessories established to perpetuate locating the position of the corner:

- | | | | |
|--|-------------|---|--------------------|
| M-3 | F. monument | M-4 | F. M.C.R.C. #17623 |
| 96.34' SE to MAG nail w/MCWT NE side 8" maple | | 54.56' N. to MAG nail w/MCWT W. side U. pole | |
| 83.00' ESE to MAG nail w/MCWT N. side 10" elm | | 45.23' SW to MAG nail w/MCWT SW side 13" cherry | |
| 99.71' SE to MAG nail w/disk #40165 NW side 8" elm | | 37.79' S. to MAG nail w/MCWT E. side 13" cherry | |
| 2515.91' S. to (M-4) E. 1/4 Corner Sec. 12 T.5N., R.12E. | | 58.53' E. to MAG nail w/disk #40165 S. side 18" maple | |
| 2612.96' W. to (L-3) N. 1/4 Corner Sec. 12 T.5N., R.12E. | | | |

Signed by

Surveyor's Michigan License No. 40165

Date:

5 OCTOBER 2004

040829-6914

GLO NOTES

Researching the government survey records for Macomb County shows that the post was set at the Southeast corner of Section 1, and the Northeast corner of Section 12 in 1817 by Joseph Wampler, D.S.

WITNESSES: (Based upon Government Survey Records)

12" Sugar Tree	East	5 Links
14" Maple	N49°W	14 Links

EXISTING CONDITIONS

The original government post has been obliterated and the witness trees have been destroyed. The corner has not been perpetuated. After a lengthy discussion with the peer group, the corner was recovered on a line between A-3 T5N, R13E, M-4 T5N, R12E, and at the distance shown 2515.51 feet as shown on the M.C.P.C. Map for Bruce Twp. (1-F) which puts this corner 0.18 feet South of A-3 (Armada Twp.) This position was adjusted 0.18 feet to the North and resulting in a common corner with A-3 (Armada Twp). The corner as recovered is located 10 feet West of a existing ditch extending to the North & South. There are no lines of occupation to the East or West.

LCRC AND RECORDED SURVEYS

Researching the Macomb County Records for Land Corner Recordation Certificates (LCRC) shows that nothing has been recorded for this corner. I did not receive any other information regarding this corner from any other sources.

FIELD MEASURMENTS BETWEEN

M-3 to A-3

GLO = 30 Links or 19.80 Ft.
M-3 (Bruce Township) as recovered, is a common corner to A-3


M-3 to M-2

GLO = 40 chains or 2640.00 Ft.
2856.06 Ft. (MCPC Map)
2849.63 Ft. (MEA 1999)

M-3 to M-4

GLO = 40 chains or 2640.00 Ft.
2515.51 Ft. (MCPC Map)
2515.69 Ft. (MEA 1999)

Based upon the method used to recover this corner, I therefore, recommend to the Macomb County Peer Group that they accept the recovered position of this corner as the best evidence of the original corner position and as a common corner to A-3 (Armada Township.)

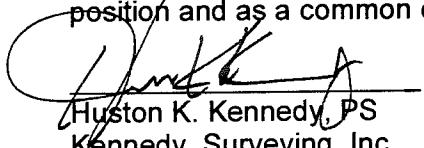
Huston K. Kennedy, PS
Kennedy Surveying, Inc.

473

Trove 1/ North Range. 12 Inst

also an Elm 8 in diam bears N 45 W 20 lbs diet
 58.00 Left Stream
 17.73 A. B. Ash 4 in diam
 80.00 Set 4 miles from for Corn potash 12+13
 from which an Ash 16 in diam bears N 20 E 20 lbs diet
 also a Birch 16 in diam bears N 80 W 30 lbs diet
 Land first half mile 2nd mile last half
prim Timb Beech Alder Mrs Dash Wilk + c

Nov 16.

27.66 c 1 year, & 2.2 in diam
 40.00 Set 44 Sec foot from which
 a Birch 4 in diam bears N 27 W 7 lbs diet
 also an Elm 5 in diam bears N 47 E 21 lbs diet
 65.50 an Elm 14 in diam
 80.00 Set 5 miles from for Corn potash 11+12 from
 which a Sugartree 42 in diam bears East 5 lbs
 also a Maple 14 in diam bears N 19 W 14 lbs diet
 Land first half mile 2nd mile land and dry
 last half same
Timber B. Ash Poplar Beech + c.
Weed growth Beech Born bam + c.

Surveyed 16/11 by Joseph H. Newell Esq.

North

11.21 A. B. Ash 11 in diam
 40.00 Set 44 Sec foot from which
 a Beech 16 in diam bears N 48 W 20 lbs diet
 also a Poplar 11 in diam bears South 65°
 W 27 lbs diet
 61.50 C or 12 lbs wide E S.E.
 74.05 an Elm 12 in diam
 77.00 C or 30 lbs wide E S.E.
 80.00 Made out for Township o N 11 1/2 N 5 in
Ranges 12+13 East on an Ironwood 11 in
 diam - Land first half mile 2nd mile
 Land and dry last half same
Timber B. Wash Wheat Sugar Lime + c.

07-100-002

CERTIFICATE OF SURVEY




**M = MEASURED
R = RECORDED
C = CALCULATED**

JOHN FERGUSON
JOB NO. 512-86 DATE 10-17-86
SCALE 1" = 100' SHEET 1 OF 2
DRAWN BY D.H.K. CHECKED BY H.J.K.

Part of the N.W. 1/4 of Section 7,
Town 5 North, Range 13 East,
Armada Township, Macomb County,
Michigan.

NOTE: Bearings relate to description of record for parcel adjoining West line of delineated parcel.

752-2193

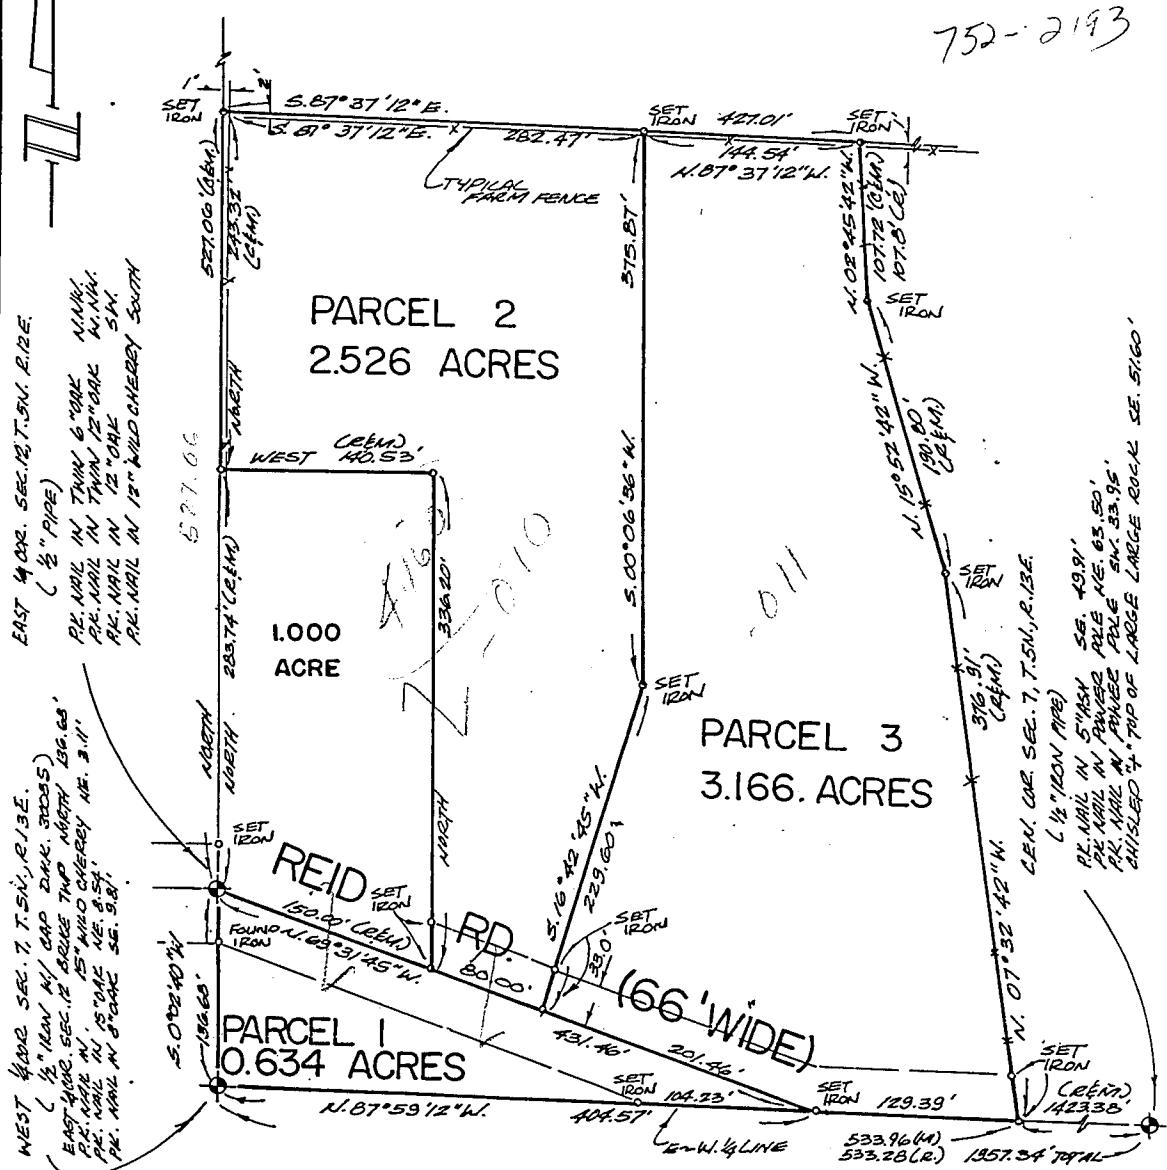

I hereby certify that I have surveyed the parcel(s) of land described and delineated hereon; that said Survey was performed with an error of closure no greater than 1 in 5,000; and that I have fully complied with the requirements of Section 3, Act 132, P.A. 1970.

Donald H. King
DONALD H. KING
LICENSED LAND SURVEYOR
MICHIGAN LICENSE NO. 30085

KK KOBS-KING & ASSOC. INC.

LAND SURVEYING SITE PLANNING

JOB NO. 512-86
FOR: JOHN FERGUSON
Sheet 2 of 2

DESCRIPTION PARCEL 1:

A parcel of land located in and being a part of the N.W.1/4 of Section 7, Town 5 North, Range 13 East, Armada Township, Macomb County, Michigan, and being more particularly described as follows: Commencing at the West 1/4 corner of said Section 7; thence South 87 degrees 59 minutes 12 seconds East 404.57 feet along the East-West 1/4 line of said Section 7; thence North 69 degrees 31 minutes 45 seconds West 431.46 feet along the centerline of Reid Road to the East 1/4 corner of Section 12, Town 5 North, Range 12 East, Bruce Township, Macomb County, Michigan; thence South 00 degrees 02 minutes 40 seconds West 136.68 feet along the West line of said Section 7 to the point of beginning, containing 0.634 acres of land. Subject to the rights of the public in Reid Road and any easements of record.

DESCRIPTION PARCEL 2:

A parcel of land located in and being a part of the N.W.1/4 of Section 7, Town 5 North, Range 13 East, Armada Township, Macomb County, Michigan, and being more particularly described as follows: Commencing at a point on the centerline of Reid Road, said point being South 87 degrees 59 minutes 12 seconds East 404.57 feet along the East-West 1/4 line of said Section 7, and North 69 degrees 31 minutes 45 seconds West 201.46 feet from the West 1/4 corner of said Section 7; thence extending North 69 degrees 31 minutes 45 seconds West 80.00 feet along said centerline of Reid Road; thence North 336.20 feet; thence West 140.53 feet; thence North 243.32 feet along the West line of said Section 7; thence South 87 degrees 37 minutes 12 seconds East 282.47 feet; thence South 00 degrees 06 minutes 36 seconds West 375.87 feet; thence South 16 degrees 42 minutes 45 seconds West 229.60 feet to the point of beginning, containing 2.526 acres of land. Subject to the rights of the public in Reid Road and any easements of record.

DESCRIPTION PARCEL 3:

A parcel of land located in and being a part of the N.W.1/4 of Section 7, Town 5 North, Range 13 East, Armada Township, Macomb County, Michigan, and being more particularly described as follows: Commencing at a point on the East-West 1/4 line of said Section 7, it being 404.57 feet South 87 degrees 59 minutes 12 seconds East 404.57 feet from the West 1/4 corner of said Section 7; thence extending South 87 degrees 59 minutes 12 seconds East 129.39 feet along said East-West 1/4 line of Section 7; thence North 07 degrees 32 minutes 42 seconds West 376.91 feet; thence North 15 degrees 52 minutes 42 seconds West 190.80 feet; thence North 02 degrees 45 minutes 42 seconds West 107.8 feet (recorded)-107.72 feet (measured); thence North 87 degrees 37 minutes 12 seconds West 144.54 feet; thence South 00 degrees 06 minutes 36 seconds West 375.87 feet; thence South 16 degrees 42 minutes 45 seconds West 229.60 feet; thence South 69 degrees 31 minutes 45 seconds East 201.46 feet along the centerline of Reid Road to the point of beginning, containing 3.166 acres of land. Subject to the rights of the public in Reid Road and any easements of record.

PREPARED BY: *Donald H. King*

DONALD H. KING
LICENSED LAND SURVEYOR
NO. 30085

DESCRIPTION PARCEL 2 and 1.000.
ACRE PARCEL COMBINED:

JOB NO. 512-86
FOR: JOHN FERGUSON
Sheet 1 of 1

A parcel of land located in and being a part of the N.W.1/4 of Section 7, Town 5 North, Range 13 East, Armada Township, Macomb County, Michigan, and being more particularly described as follows: Commencing at a point on the centerline of Reid Road, said point being South 87 degrees 59 minutes 12 seconds East 404.57 feet along the East-West 1/4 line of said Section 7, and North 69 degrees 31 minutes 45 seconds West 201.46 feet from the West 1/4 corner of said Section 7; thence extending North 69 degrees 31 minutes 45 seconds West 230.00 feet along said centerline of Reid Road to the East 1/4 corner of Section 12, Town 5 North, Range 12 East, Bruce Township, Macomb County, Michigan; thence North 527.06 along the West line of said Section 7; thence South 87 degrees 37 minutes 12 seconds East 282.47 feet; thence South 00 degrees 06 minutes 36 seconds West 375.87 feet; thence South 16 degrees 42 minutes 45 seconds West 229.60 feet to the point of beginning, containing 3.526 acres of land.
Subject to the rights of the public in Reid Road and any easements of record.

PREPARED BY: Donald H. King
Donald H. King
Licensed Land Surveyor
No. 30085


KK Kobs-King & Assoc. Inc.

111 SOUTH RAWLES

ROMEO, MICHIGAN 48065-0146

LAND SURVEYING
SITE PLANNING

313 • 752-2700

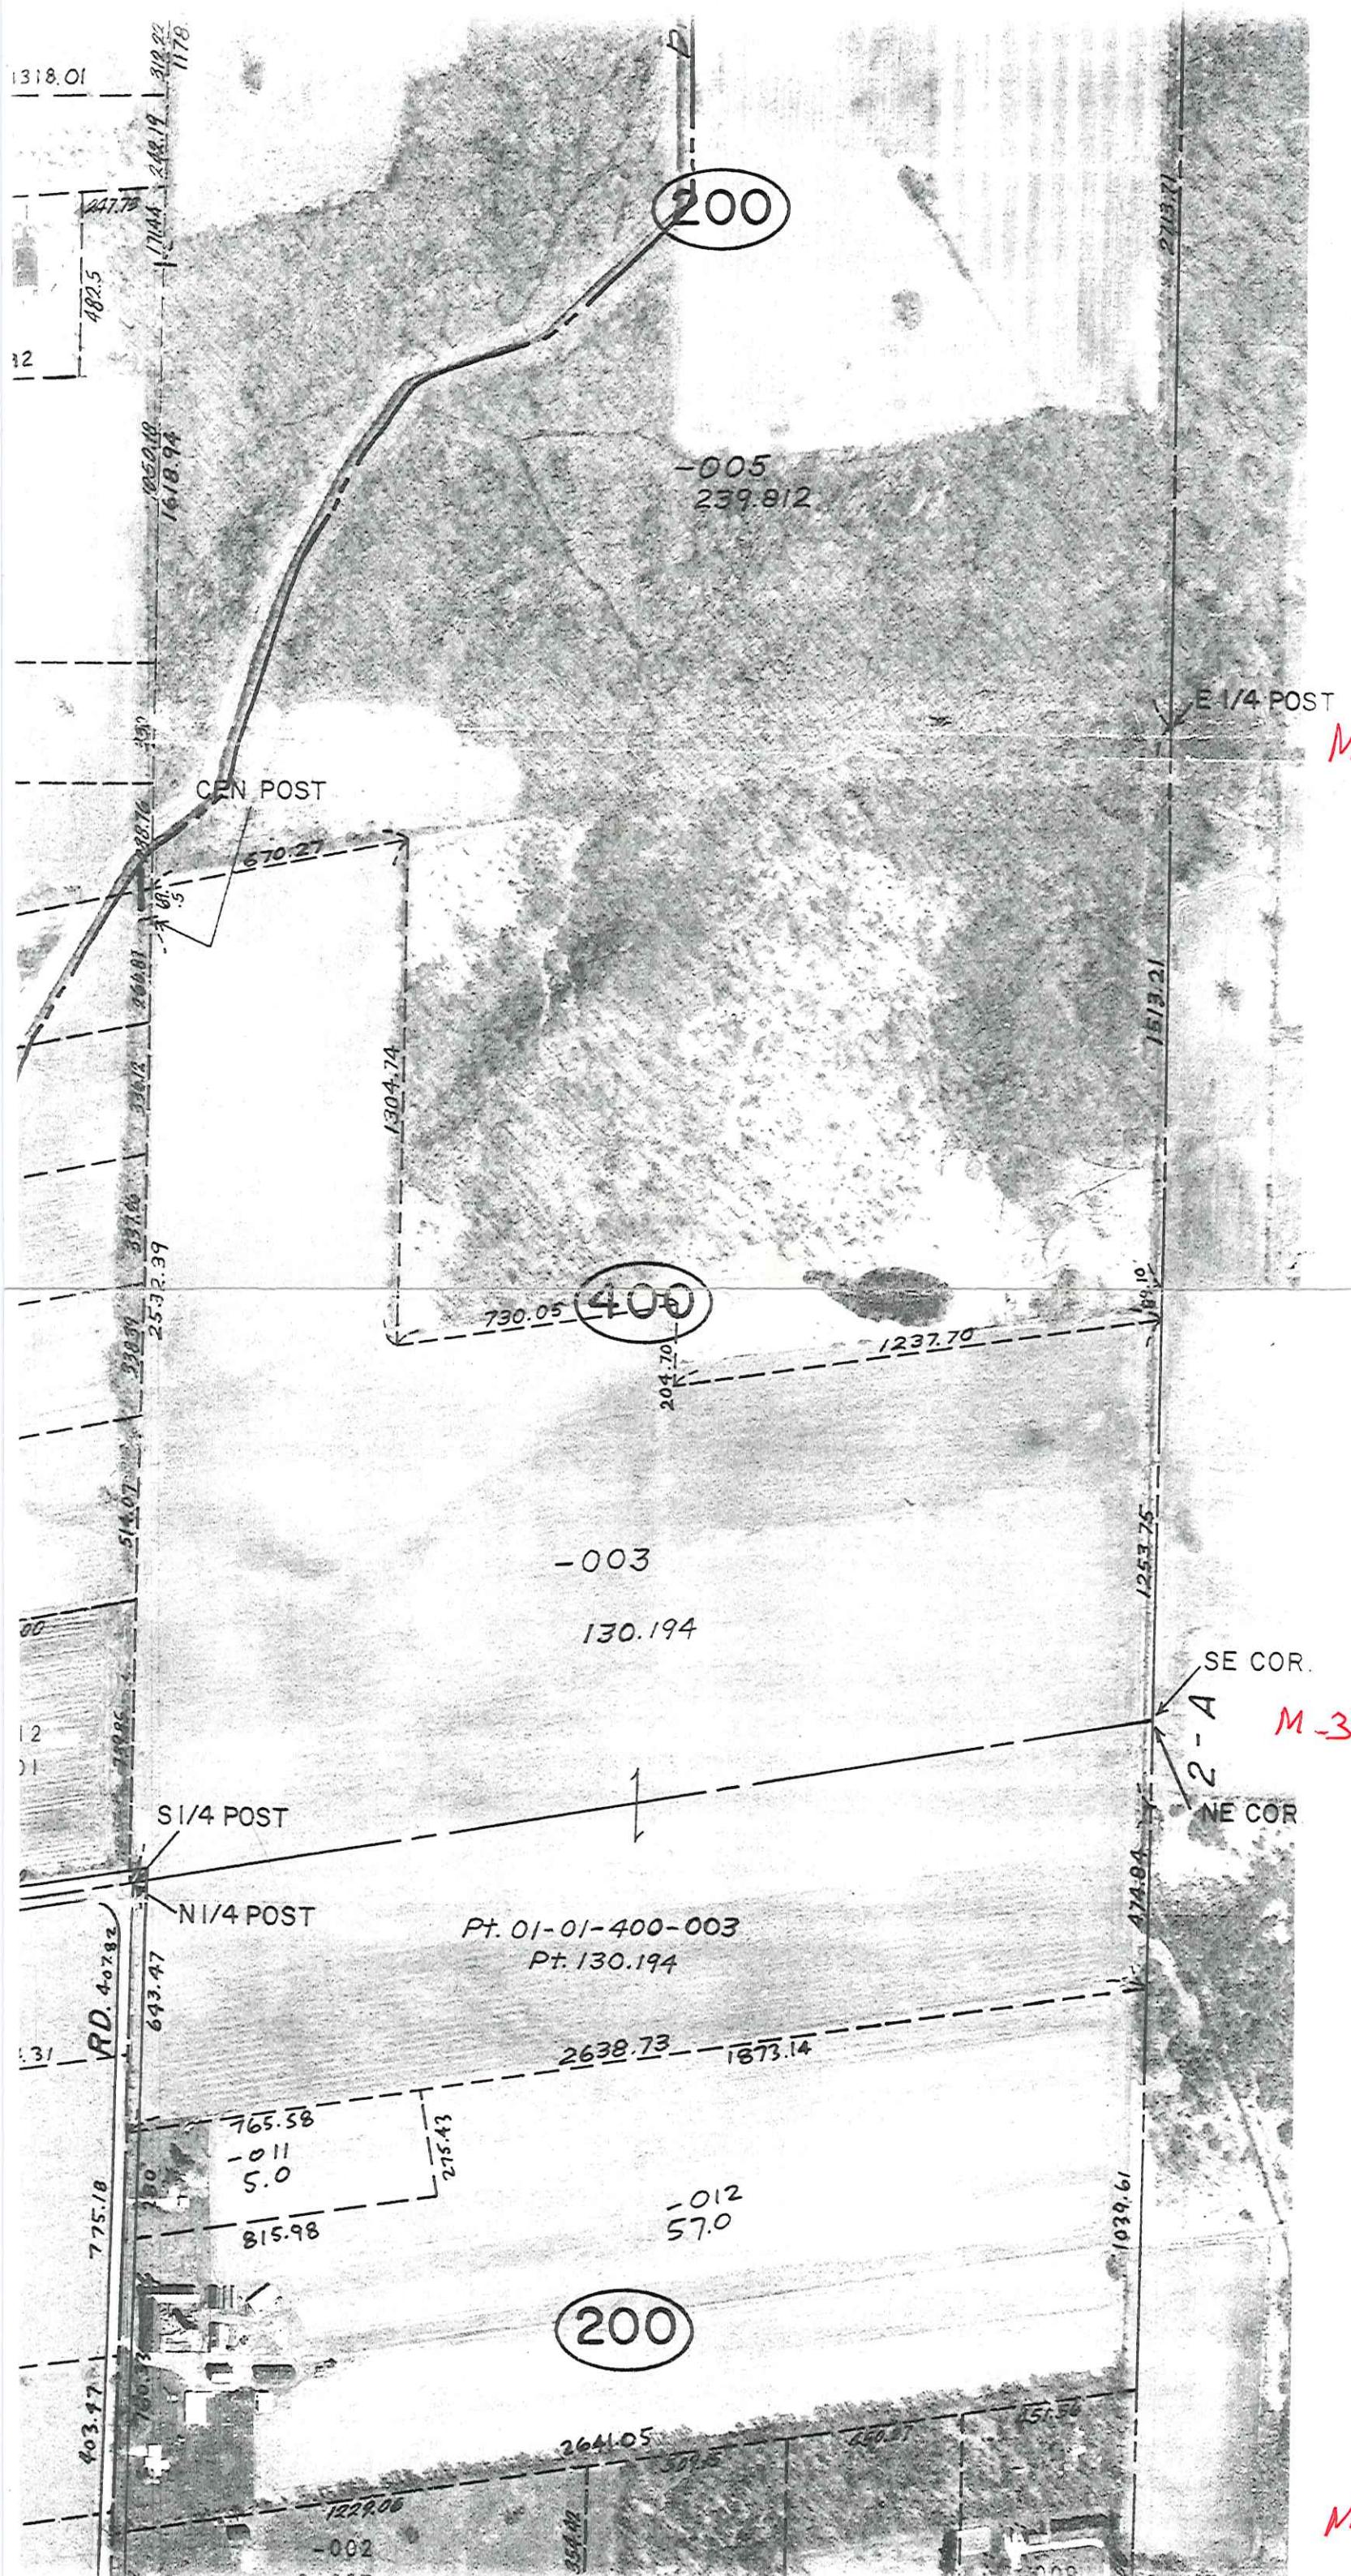

ST. CLAIR CO.

