


LAND CORNER RECORDATION CERTIFICATE
Filing Requirement of Act 74, Mich. P.A. 1970

For corners in

<u>Macomb</u> (County)	Located In: Armada Township Village of Armada	Corner Code #
1. Public Land Survey	T 5N R 13E J-8	_____
	T _____ R _____	_____
	T _____ R _____	_____
2. Property Controlling in Section	S _____ T _____ R _____	_____
	S _____ T _____ R _____	_____
3. Miscellaneous Property in Sec.	S _____ T _____ R _____	_____
	S _____ T _____ R _____	_____


5138890
LIBER 16975 PAGE 211



08/03/2005 01:43:36 P.M.
MACOMB COUNTY, MI
CARNELLA SABAUGH, REGISTER OF DEEDS

Register of Deeds Stamp & File Number

4. Lot No. _____, Recorded Plat _____
5. Private Claims _____

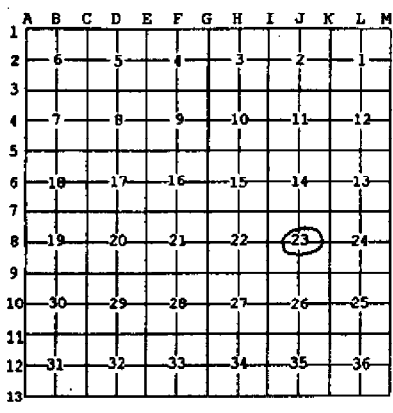

I, Huston K. Kennedy, in a field survey on March 17, 2005 do hereby state that under requirements of P.A. 74, Michigan P.A. of 1970, the corner points mentioned in lines 1 and 2 above were in conformance with regulations and rules therefore as required in the current manual of survey instructions of the United States Department of the Interior, Bureau of Land Management or by a decree of a Court of Law and/or that the corner points mentioned in lines 3, 4 and 5 above were in conformance with the rules of the Michigan Board of Land Surveyors or by a Decree of a Court of Law, established, re-established, monumented, recovered, found as expressed below:

NOTE: Not more than 2 corners, all in the same town and range, may be recorded on this certificate.

- A. Description of original monument and accessories and/or subsequent restoration:
1817-Preston, D.S.; A post was not set during the original government survey
1.) 1993-King, PS #30085; Certificate of Survey L. 5969, pg. 110 - Computed center corner Section 23 (not set)
2.) 1935-"ASSESSOR'S PLAT NO. 2" Liber 16 of plats, page 30
- B. Description of corner evidence found and/or method applied in restoring or reestablishing corner:
2005-Kennedy Surveying, Inc. - Kennedy, PS #17623 - A post was not set during the original government survey and the corner has not been perpetuated. After a discussion of the Macomb County Peer Group Committee it was there general consensus to hold the position as shown on Act 132, survey recorded in Liber 5969, page 110 of Macomb County Records. The corner falls in an existing tree row extending to the North and South. There is an existing fence line extending to the South of Armada Ridge Road that is very close to being on the North-South 1/4 line.


Field Measurements Between Corners

- | | |
|--|--|
| <u>J-8 to J-7</u>
No GLO
Certificate of Survey recorded in Liber 5969, page 110 = 2671.89 Ft.
N02°48'21" W 2671.89 Ft. (mea.) | <u>J-8 to I-7</u>
No GLO
S87°52'28" W 2643.53 Ft. (mea.) |
| <u>J-8 to J-9</u>
No GLO
S02°27'18" E 2689.90 Ft. (mea.) | <u>J-8 to K-8</u>
No GLO
N88°42'48" E 2615.80 Ft. (mea.) |

C. Description of monument for corner and accessories established to perpetuate locating the position of the corner:
J-8 I Set a 4" diameter concrete monument with a 1/2" Iron Rod w/2" diameter aluminum cap stamped "Macomb County Monument, MI Act #345, PS #17623"
N38°E 126.12 Ft. SW corner of church (brick corner)
S78°E 50.91 Ft. Set Mag Nail w/Remon Washer North face 13" Ash
S24°W 16.50 Ft. Set Mag Nail w/Remon Washer SE face 11" Poplar
N74°W 10.46 Ft. Set Mag Nail w/Remon Washer SW face 5" Poplar

The selected location is accepted by me and is generally accepted by Professional Surveyors as the best available evidence of the position of the corner as being perpetuated.

Signed by: [Signature] Date June 29, 2005

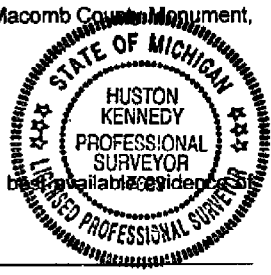

Surveyor's Michigan License No.: 17623
ACCEPTED BY THE MACOMB COUNTY SURVEY PEER GROUP AS THE OFFICIAL CORNER UNDER MICHIGAN PUBLIC ACT 345 OF 1990 AT A MEETING HELD ON 6-28-05
[Signature]
MARTIN C. DIINN P.R. CHAIRMAN

2005

**MACOMB COUNTY REMONUMENTATION
PROGRAM FOR ARMADA TOWNSHIP**

Research Dossier for J-8

Prepared by:
Kennedy Surveying, Inc.
105 North Washington Street
Oxford, Michigan 48371
05-6030 (96-4013)

Sources of Information Researched For Macomb County 2005 Remonumentation Program For Armada Township

- 1) GLO Notes
- 2) Act 74 Recorded LCRC
- 3) Act 132 Recorded Surveys
- 4) Personal History and Records
- 5) Unrecorded LCRC's and Surveys
- 6) Letters to the Following, Requesting Unrecorded information

- a) AES Engineers & Surveyors, Inc.
- b) Anderson, Eckstein & Westrick
- c) BMJ Engineers & Surveyors
- d) David Little Land Surveyor
- e) Dunn Construction
- f) Fenn & Associates Surveying, Inc.
- g) George Jerome & Company
- h) James Land Surveying
- i) Kem-Tec Surveying
- j) King Surveying & Associates, Inc.
- k) Lehner Associates, Inc.
- l) M.C.S. Associates, Inc.
- m) Metco Land Sea Corp.,
- n) Metco-Dunn, Inc.
- o) Michalich & Associates
- p) Milletics & Associates
- q) R.J. Donnelly & Associates, Inc.
- r) RA. Duthler Land Surveyor LLC
- s) Reichert Surveying
- t) Road Commission for Macomb County
- u) Rowe Incorporate
- v) Spalding, DeDecker & Associates
- w) Urban Land Consultants, L.L.C.
- x) Williams & Gorinac Associates

GLO SURVEY HISTORY

Researching the government survey records for Macomb County shows that the North and West lines of Armada Township were surveyed and the township was subdivided into sections with closing corners set on the North and West township lines by William Preston in 1817. A post was not set at the Center of Section 23.

WITNESSES:

(Based upon Government Survey Records)

No Witnesses

EXISTING CONDITIONS

A post was not set during the original government survey and the corner has not been perpetuated. After a discussion of the Macomb County Peer Group Committee it was there general consensus to hold the position as shown on Act 132, survey recorded in Liber 5969, page 110 of Macomb County Records. The corner falls in an existing tree row extending to the North and South. There is an existing fence line extending to the South of Armada Ridge Road that is very close to being on the North-South 1/4 line.

RECORDED LCRC'S AND CERTIFICATE SURVEYS

Researching the Macomb County Records for Land Corner Recordation Certificates (LCRC) and Certificate of Surveys shows that Donald H. King, PS #30085 recorded a Certificate of Survey on August 11, 1993 in Liber 5969, page 110 of Macomb County Records, which states computed center corner Section 23 not set, it also states that the East-West 1/4 line was established by Lehner Associates, Inc., recorded in Liber 2527, page 422. Based on the above position for the center of the section which falls on the West line of "ASSESSOR'S PLAT NO. 2", Liber 16, page 30.

FIELD MEASUREMENTS BETWEEN CORNERS

J-8 to J-7

No GLO

Certificate of Survey recorded in Liber 5969, page 110 = 2671.89 Ft.

N02°48'21" W 2671.89 Ft. (mea.)

J-8 to J-9

No GLO

S02°27'18" E 2689.90 Ft. (mea.)

J-8 to I-7

No GLO


S87°52'28" W 2643.53 Ft. (mea.)

J-8 to K-8

No GLO

N88°42'48" E 2615.80 Ft. (mea.)


I set a 4" diameter concrete monument with a 1/2" Iron Rod with a 2" diameter aluminum cap stamped "Macomb County Monument, MI" Act #345, PS #17623" on the West line of "ASSESSOR'S PLAT NO. 2" using the distance from the North 1/4 corner as shown on the Certificate of Survey recorded in Liber 5969, page 110. I therefore, recommend to the Macomb County Peer Group that they accept the position of this corner as established.

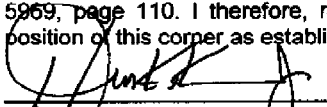
Huston K. Kennedy, P.S.
Kennedy Surveying, Inc.

Job: 1996 MACOMB COUNTY REMONUMENTATION PROGRAM FOR WASHINGTON, BRUCE & RAT TWP.

By: HUSTON K. KENNEDY

Point	Direction	Distance	Northing	Easting	Elevation
Start 1243			490141.8772	13518298.1813	
IN 1402	N 2°27'18.7" W	2689.561	492828.9690	13518182.9656	
PO Temporary Intersection Point	S 2°27'18.7" E	552.128	492277.3478	13518206.6177	
PO 1500	N 87°32'41.3" E <i>EX FENCE LINE</i>	1.530	492277.4133	13518208.1465	
Start 1402			492828.9690	13518182.9656	
PO Temporary Intersection Point	S 2°27'18.7" E	664.760	492164.8197	13518211.4427	
PO 1501	N 87°32'41.3" E <i>EX FENCE LINE</i>	1.030	492164.8638	13518212.4716	
Start 1402			492828.9690	13518182.9656	
PO Temporary Intersection Point	S 2°27'18.7" E	800.607	492029.0968	13518217.2621	
PO 1502	N 87°32'41.3" E <i>EX FENCE LINE</i>	0.503	492029.1183	13518217.7648	
Start 1402			492828.9690	13518182.9656	
PO Temporary Intersection Point	S 2°27'18.7" E	965.692	491864.1632	13518224.3340	
PO 1503	N 87°32'41.3" E <i>EX FENCE LINE</i>	0.689	491864.1927	13518225.0222	
Start 1402			492828.9690	13518182.9656	
PO Temporary Intersection Point	S 2°27'18.7" E	1043.661	491786.2662	13518227.6741	
PO 1504	N 87°32'41.3" E <i>EX FENCE LINE</i>	0.522	491786.2885	13518228.1956	
Start 1402			492828.9690	13518182.9656	
PO Temporary Intersection Point	S 2°27'18.7" E	1222.065	491608.0253	13518235.3166	
PO 1505	N 87°32'41.3" E <i>EX FENCE LINE</i>	0.763	491608.0580	13518236.0786	

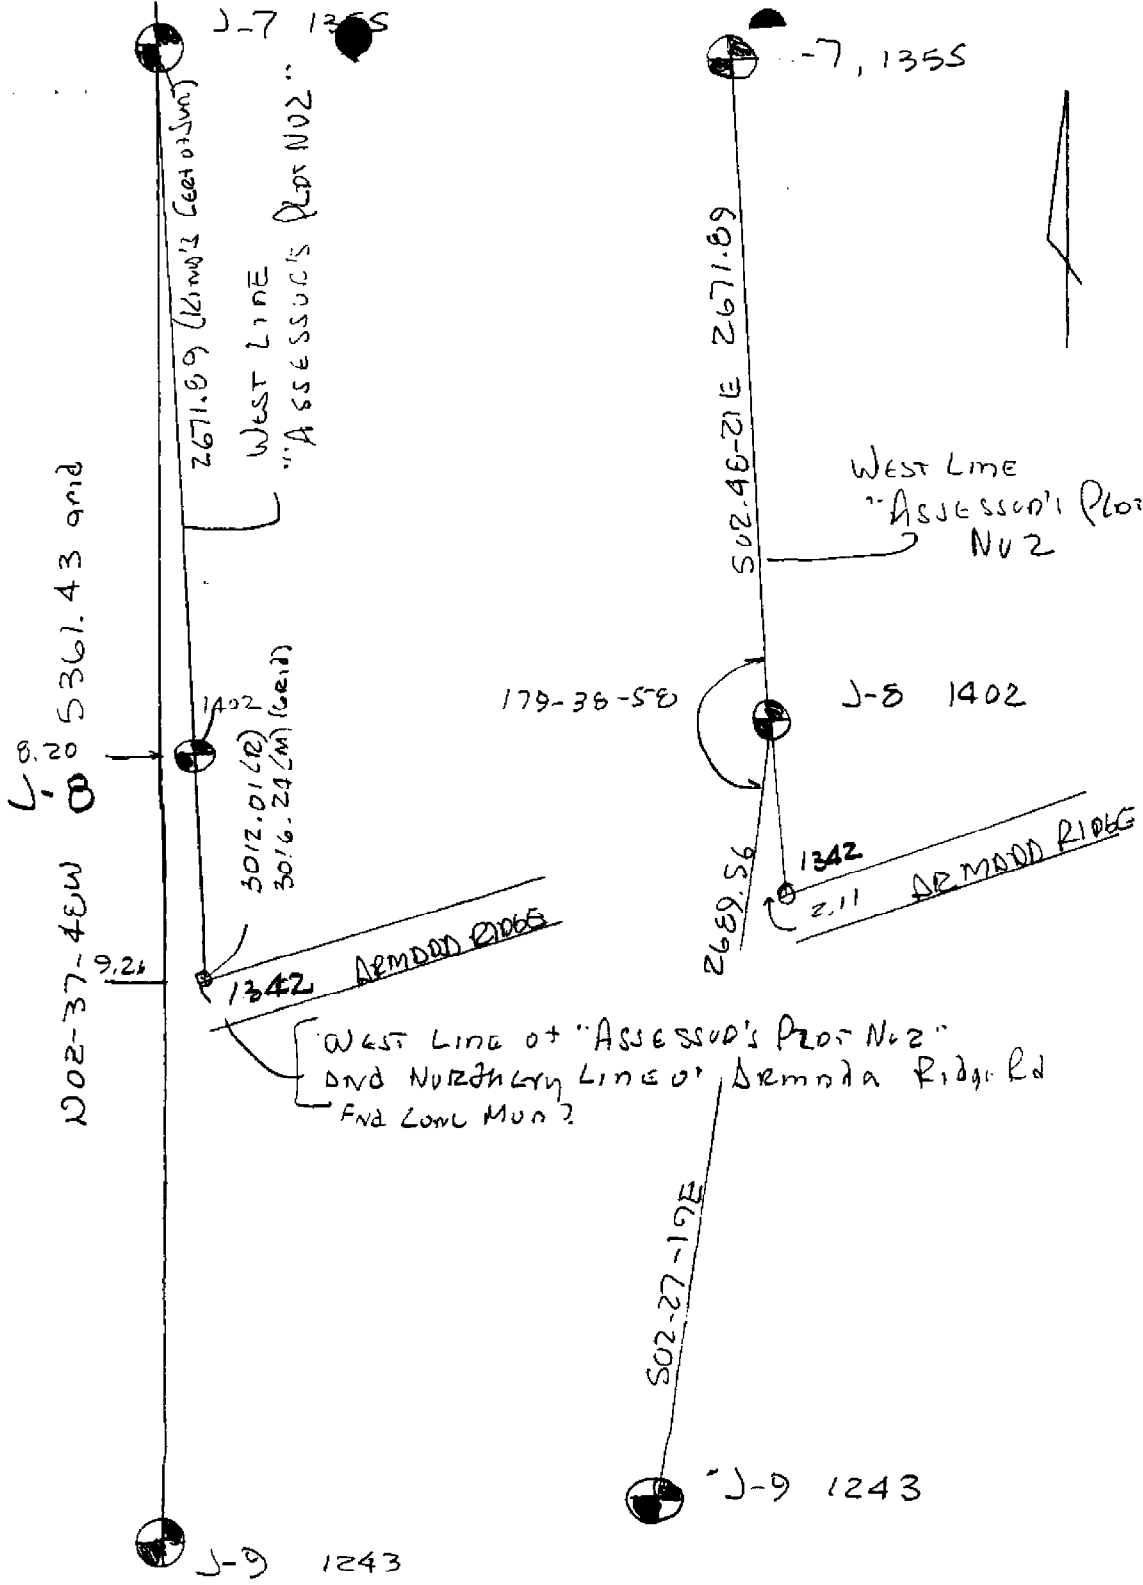

CERTIFICATE OF SURVEY


FOR DANIEL JACOB
 JOB No. 93171 DATE 7-12-93
 SCALE 1" = 400' SHEET 1 of 2
 DRAWN BY M.G.H. CHECKED BY D.H.K.



11924-137

Part of the S.W. 1/4 of Section 23, Town 5 North,
 Range 13 East, Armada Township, Macomb County,
 Michigan.

05969M110

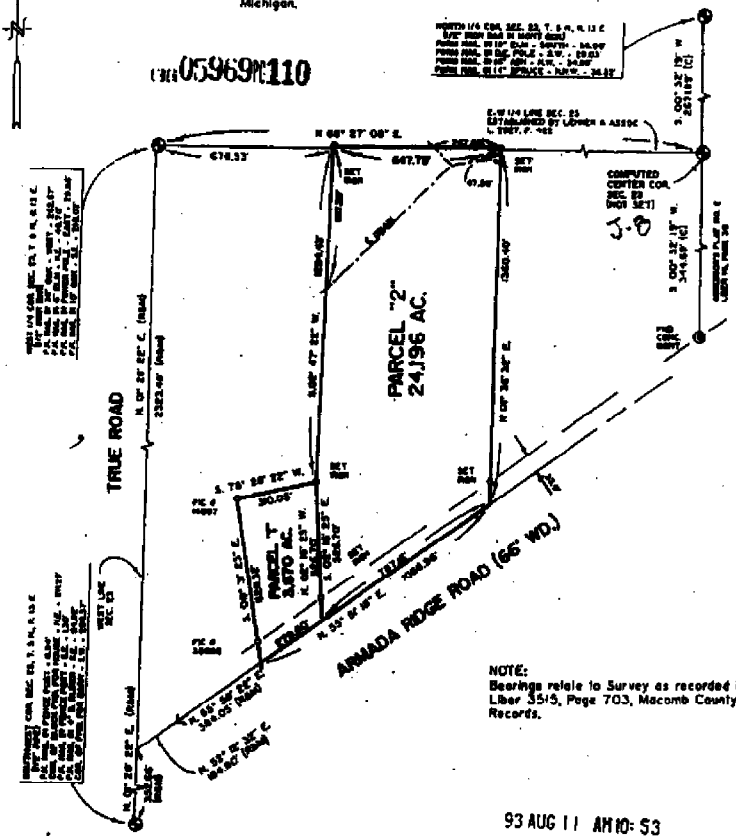


NOTE:
 Bearings relate to Survey as recorded in
 Liber 3515, Page 703, Macomb County
 Records.

I hereby certify that I have surveyed the parcel(s) of
 land described and delineated hereon; that said Survey
 was performed with an error of closure no greater
 than 1 in 5,000; and that I have fully complied with
 the requirements of Section 5, Act 132, P.A. 1970.

93 AUG 11 AM 10:53

CARMELO SABAUGH
 REGISTERED DEEDS
 MACOMB COUNTY, MI

Donald H. King
 DONALD H. KING
 PROFESSIONAL SURVEYOR
 MICHIGAN LICENSE No. 30085

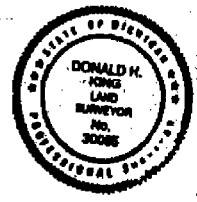

KOBS-KING & ASSOC., INC.

**LAND SURVEYING
 SITE PLANNING**

111 RAMBLE

ANN ARBOR, MICHIGAN 48105

(313) 752-2700

03/15/03

MACOMB COUNTY TREASURER

TED B. WAHBY

DELINQUENT 2004 TAXES "NOT ON FILE"

TAX HISTORY

ARMADA TWP

Property Number: 13-02-23-100-002

Alt. Property Number: 13-02-02-300-200

Property Address: 22100 ARMADA

School Code: 30050

TAX YEAR	TAX VALUE	BASE TAX	BASE TAX DUE	INTEREST/FEES DUE	TOTAL DUE	LAST Pmt
2004			0.00	0.00	0.00	
2003	0		0.00	0.00	0.00	
2002	0		0.00	0.00	0.00	
2001	0		0.00	0.00	0.00	
2000	0		0.00	0.00	0.00	
1999	0		0.00	0.00	0.00	
1998	0		0.00	0.00	0.00	
1997	0		0.00	0.00	0.00	
1996	0		0.00	0.00	0.00	
1995	0		0.00	0.00	0.00	
TOTAL			0.00	0.00	0.00	

Fees Due As Of: 03/31/05

DESCRIPTION OF PROPERTY:

T5N,R13E SEC 23 CORN AT N 1/4 POST SEC 23: TH W 984.9 FT TO PT OF BEG; TH 80°00'30"E 1347.81 FT; TH N89°28'33"W 323.56 FT; TH N0°00'30"W 1344.85 FT; TH E 323.55 FT TO PT OF BEG. 10.0 A.

History Fees: 0.00

Taxpayer: GEORGE L & B FARRELLY JR
22100 ARMADA CENTER RD
ARMADA

MI 48005

DELINQUENT 2004 TAXES "NOT ON FILE"

TAX HISTORY

ARMADA TWP

Property Number: 13-02-23-100-003

Alt. Property Number: 13-02-02-300-360

Property Address: 22322 ARMADA

School Code: 50050

TAX YEAR	TAX VALUE	BASE TAX	BASE TAX DUE	INTEREST/FEES DUE	TOTAL DUE	LAST PMT
2004			0.00	0.00	0.00	
2003	0		0.00	0.00	0.00	
2002	43,630	713.26	0.00	0.00	0.00	03/13/03
2001	0		0.00	0.00	0.00	
2000	0		0.00	0.00	0.00	
1999	0		0.00	0.00	0.00	
1998	0		0.00	0.00	0.00	
1997	0		0.00	0.00	0.00	
1996	0		0.00	0.00	0.00	
1995	0		0.00	0.00	0.00	
TOTAL			0.00	0.00	0.00	

Fees Due As Of: 03/31/05

DESCRIPTION OF PROPERTY:

T5N,R13E SEC 23 NE 1/4 OF NW 1/4 EXC COMM AT N 1/4 POST SEC 23; TH W 984.9 FT TO PT OF BEG; TH S0+00'30"E 1347.81 FT; TH N89+28'33"W 323.55 FT; TH N0+00'30"W 1344.85 FT; TH E 323.55 FT TO PT OF BEG. 30.0 A.

History Fees: 0.00

Taxpayer: GORES JOSEPH
353 LINWOOD
ROCHESTER

MI 48307

MACOMB COUNTY TREASURER

TED B. WAHBY

DELINQUENT 2004 TAXES "NOT ON FILE"

TAX HISTORY

ARMADA TWP

Property Number: 13-02-23-100-004

Alt. Property Number: 13-02-02-300-400

Property Address: 95959 UNKNOWN

School Code: 50050

3

TAX YEAR	TAX VALUE	BASE TAX	BASE TAX DUE	INTEREST/PENAS DUE	TOTAL DUE	LAST PMT
2004			0.00	0.00	0.00	
2003	0		0.00	0.00	0.00	
2002	0		0.00	0.00	0.00	
2001	0		0.00	0.00	0.00	
2000	0		0.00	0.00	0.00	
1999	0		0.00	0.00	0.00	
1998	0		0.00	0.00	0.00	
1997	0		0.00	0.00	0.00	
1996	0	980.70	0.00	0.00	0.00	06/19/97
1995	0	957.27	0.00	0.00	0.00	01/31/97
TOTAL			0.00	0.00	0.00	

Fees Due As Of: 03/31/05

DESCRIPTION OF PROPERTY:

T5N,R13E, SEC 23 S 1/2 OF NW 1/4 80 A.

History Fees: 0.00

Taxpayer: JACOB PEARL TRUST
21921 ARMADA RIDGE RD
ARMADA MI 48005

03/16/05

MACOMB COUNTY TREASURER

TED B. WAHBY

DELINQUENT 2004 TAXES "NOT ON FILE"
TAX HISTORY

ARMADA TWP
Property Number: 13-02-23-300-011
Property Address: 22303 ARMADA

Alt. Property Number: 13-02-02-301-300
School Code: 50050

4

TAX YEAR	TAX VALUE	BASE TAX	BASE TAX DUE	INTEREST/FEES DUE	TOTAL DUE	LAST PMT
2004			0.00	0.00	0.00	
2003	0		0.00	0.00	0.00	
2002	0		0.00	0.00	0.00	
2001	0		0.00	0.00	0.00	
2000	0		0.00	0.00	0.00	
1999	0		0.00	0.00	0.00	
1998	0		0.00	0.00	0.00	
1997	0		0.00	0.00	0.00	06/19/97
1996	0	1,475.66	0.00	0.00	0.00	01/31/97
1995	0	1,635.59	0.00	0.00	0.00	
TOTAL			0.00	0.00		

Fees Due As Of: 03/31/05

DESCRIPTION OF PROPERTY:

TSN, R13E, SEC 23 E 1/2 OF SW 1/4 EXC THE W 14 ACRES OF THAT PART OF E 1/2 OF SW 1/4 S OF HWY 56 A.

History Fees: 0.00

Taxpayer: JACOB PEARL TRUST
21921 ARMADA RIDGE RD
ARMADA MI 48005

Lehner Associates, Inc.

Professional Engineers & Surveyors
 William J. Thompson, PE
 Thomas W. Kellogg, PE
 Robert L. Smith, PS
 Roger J. Stecker, PS

**LehnerFindlan
Architects, LLC**
Architects & Planners

Patrick D. Findlan, AIA

FACSIMILE TRANSMITTAL SHEET

TO: Kennedy Surveying
 ATTENTION: Huston Kennedy
 FAX NUMBER: 248-628-7191
 FROM: Lisa Drouillard, P.S.
 RE: Recorded Survey in Armada

DATE: 3/8/05
 PROJECT NAME:
 PROJECT #: PROJECT LOCATION:
 TOTAL NO. OF PAGES INCLUDING COVER SHEET: 3
 HARD COPY TO FOLLOW:

URGENT FOR APPROVAL FOR REVIEW PLEASE REPLY PLEASE COMMENT AS NOTED

NOTES/COMMENTS:

Mr. Kennedy -
 Attached is the only Certificate of Survey that I could find in our files along the E-W 1/4 line of Sec. 23, Armada Twp. It is likely that it is the survey you are looking for.

However, we did not have a recorded copy of the Survey in the file. I can't tell you if this is the same Survey reference in the King Survey.

I hope this is helpful.

Thanks,
 Lisa

If you do not receive this transmission in its entirety, please contact LehnerFindlan Associates at 586-412-7050 and ask for the person who sent this transmission to you.

FROM: Lehner Associates, Inc.

BY: _____


CC: OWNER
 JOB FILE
 CHRON

LehnerFindlan Associates

17001 Nineteen Mile Road, Suite 3 Clinton Township, MI 48038
 586-412-7050 586-412-7114 fax

Engineering - Surveying
 Architecture - Planning

CERTIFICATE OF SURVEY

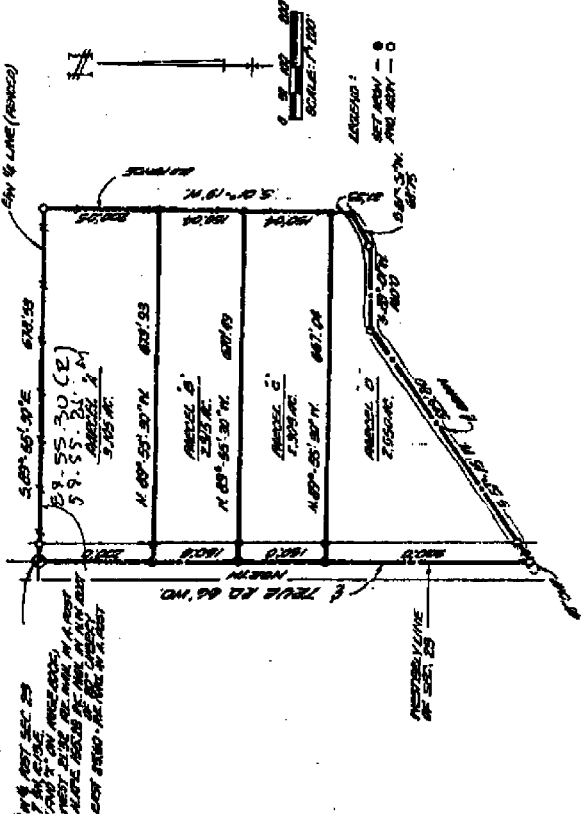

LEHNER ASSOCIATES, INC.
 Registered Land Surveyors
 22900 WELLINGTON CRESCENT
 Mount Clemens, Michigan

I, **ROBERT L. SMITH**, a Registered Surveyor in the State of Michigan, hereby certify that I have surveyed the parcel(s) of land described and delineated hereon; that said plat is a true representation of the survey as performed by me, and that there are no encroachments other than as shown hereon; that said survey was performed with an error of closure no greater than 1 in 20,000; and that I have fully complied with the requirements of Section 13, Act 1132, P. A. 1970.

Robert L. Smith
 ROBERT L. SMITH
 REGISTERED LAND SURVEYOR
 NO. 16052

CERTIFICATE of SURVEY

DESCRIPTION OF PARCEL "A" (3.105 Acres)

A parcel of land located in and being a part of the S.W. 1/4 of Section 23, T. 5 N., R. 13 E., Armada Township, Macomb County, Michigan, and being more particularly described as follows:

Commencing at the West 1/4 corner of said Section 23, and thence extending S. 89°-53'-30" E. 678.53 feet; thence S. 01°-19' W. 200.05 feet; thence N. 89°-53'-30" W. 673.93 feet; thence North 200.0 feet along the West line of Section 23 to the point of beginning and containing 3.105 acres of land.

Reserving easements of record.

DESCRIPTION OF PARCEL "B" (2.315 Acres)

A parcel of land located in and being a part of the S.W. 1/4 of Section 23, T. 5 N., R. 13 E., Armada Township, Macomb County, Michigan, and being more particularly described as follows:

Commencing at a point 200.0 feet South from the West 1/4 corner of said Section 23, and thence extending S. 89°-55'-30" E. 673.93 feet; thence S. 01°-19' W. 150.04 feet; thence N. 89°-55'-30" W. 670.49 feet; thence North 130.0 feet along the West line of said Section 23, to the point of beginning and containing 2.315 acres of land.

Reserving easements of record.

DESCRIPTION OF PARCEL "C" (2.303 Acres)

A parcel of land located in and being a part of the S.W. 1/4 of Section 23, T. 5 N., R. 13 E., Armada Township, Macomb County, Michigan, and being more particularly described as follows:

Commencing at a point 350.0 feet South from the West 1/4 corner of said Section 23, and thence extending S. 89°-55'-30" E. 670.49 feet; thence S. 01°-19' W. 150.04 feet; thence N. 89°-55'-30" W. 667.04 feet; thence North 130.0 feet along the West line of said Section 23 to the point of beginning and containing 2.303 acres of land. Reserving easements of record.

DESCRIPTION OF PARCEL "D" (2.330 Acres)

A parcel of land located in and being a part of the S.W. 1/4 of Section 23, T. 5 N., R. 13 E., Armada Township, Macomb County, Michigan, and being more particularly described as follows:

Commencing at a point 500.0 feet South from the West 1/4 corner of said Section 23, and thence extending S. 89°-53'-30" E. 667.04 feet; thence S. 01°-19' W. 37.33 feet; thence S. 61°-51' W. 68.73 feet; S. 89°-01' W. 160.0 feet, and S. 37°-15' W. 529.80 feet along the centerline of a drain, thence North 360.0 feet along the West line of said Section 23 to the point of beginning and containing 2.330 acres of land. Reserving easements of record.

W. J. HARRIS & SONS, SURVEYORS

"ASSESSOR'S PLAT NO. 2"

A PART OF THE NORTHERLY PORTION OF THE EAST 1/2 OF SEC. 23, T.5N., R.13E.
ARMADA VILLAGE, MACOMB COUNTY, MICH.

W.J. LEHNER, REG. C.E.
MT. CLEMENS, MICH.


Examined and Approved

9/24/35
[Signature]
Deputy Auditor General



Scale: 1"=200'

Point of Beginning
N.E. Cor. Sec. 23

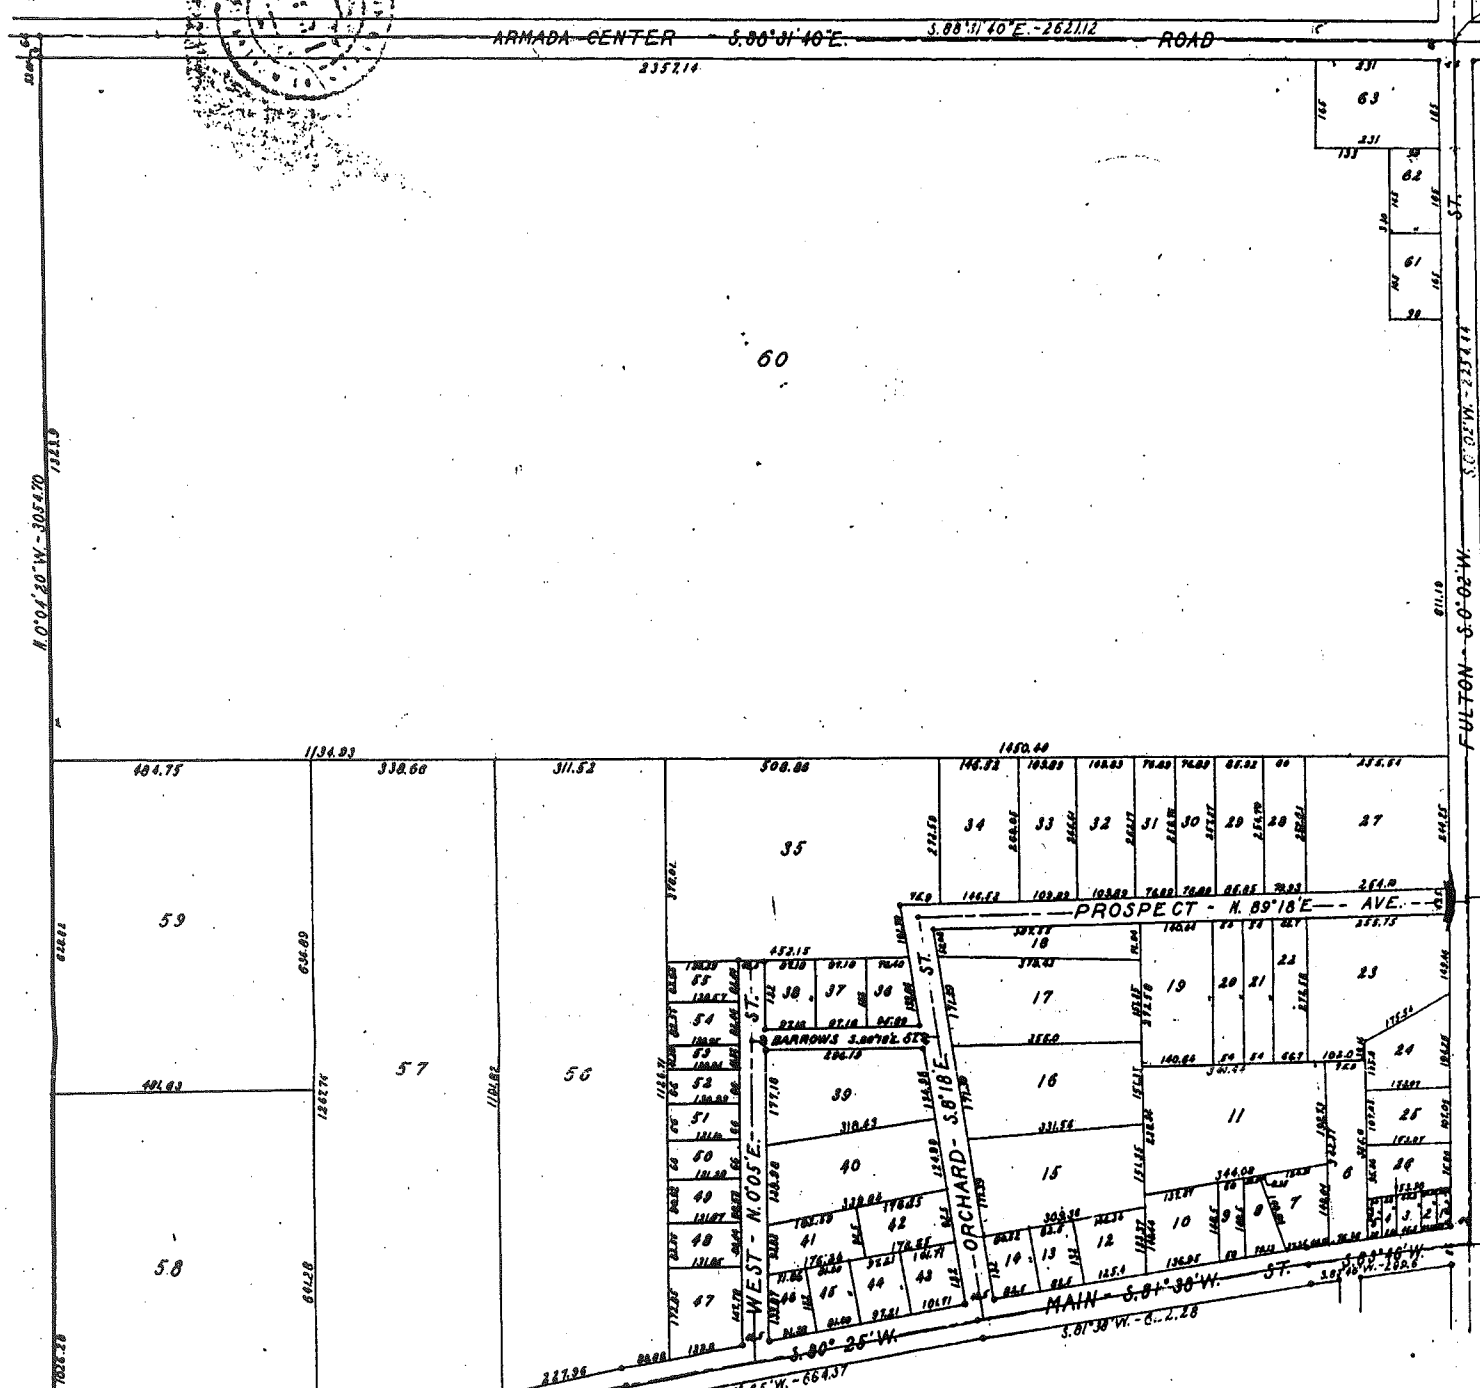

306' 70
- 4'-69
3072.01
3016 24 (m)

030.tif

See Plat No. 1 for Change of Street Name S. 1342
See Current S. 1344 Page 360 (S. 5457)

MUNICIPAL APPROVAL.
This plat was approved by the Village Board of the Village of Armada
Macomb County, Michigan, at a meeting held August 12, 1935
[Signature]
Armada Village Clerk.

DESCRIPTION
The land embraced in the annexed plat of "ASSESSOR'S PLAT NO. 2" a part
of the northerly portion of the E. 1/2 of Sec. 23 T. 5 N.R. 13 E., Armada
Village, Macomb County, Michigan is described as follows:
Commencing at the N.E. corner of said Sec. 23, and thence extending
S. 0°-02' W. 2254.44 ft; thence S. 85°-46' W. 299.60 ft; thence S. 81°-35' W.
622.28 ft; thence S. 80°-25' W. 664.37 ft; thence S. 70°-22' W. 606.25 ft;
thence S. 47°-55' W. 276.55 ft; thence S. 60°-32' W. 317.80 ft; thence N. 0°-
04'-20" W. 3054.70 ft; thence S. 88°-31'-40" E. 2621.12 ft. to the place
of beginning.

SURVEYOR'S CERTIFICATE.
I hereby certify that the plat hereon delineated is a correct one and
that permanent metal monuments of not less than one inch in diameter
and fifteen inches in length set in a concrete base at least four inches
in diameter and forty eight inches in depth have been placed at points
marked thus (o), as shown at all angles in the boundaries of the land
platted, at all intersections of streets within the boundaries of the
plat as shown on said plat.

[Signature]
Registered Civil Engineer.

MACOMB COUNTY BOARD APPROVAL
This plat was approved by the County Board of Macomb County, Michigan,
at a meeting held August 14, 1935

[Signature] Judge of Probate.
[Signature] County Clerk
[Signature] County Treasurer.

DEDICATION.
KNOW ALL MEN BY THESE PRESENTS, That I, *[Signature]*
Assessor for the Village of Armada,
Macomb County, Michigan, by virtue of authority in me vested,
by Sec. 51, Act 172 P. A. 1929, having been duly authorized by the
Village Commission have caused the land embraced in the annexed
plat to be surveyed, laid out and platted, to be known as
"ASSESSOR'S PLAT NO. 2", a part of the northerly portion of the E. 1/2
Sec. 23 T. 5 N.R. 13 E., Village of Armada, Macomb County, Michigan,
and that the streets as shown on said plat are hereby dedicated to the
use of the public.

Witnesses
[Signature] Assessor for Armada Village
[Signature]

STATE OF MICHIGAN }
COUNTY OF MACOMB } SS.

On this 14th day of August A.D. 1935, personally came
the above named *[Signature]* Assessor of the Village of Armada,
known to me to be the person who executed the above dedication and
acknowledged the same to be his free act and deed as such Assessor.

My commission expires July 7, 1939
Notary Public in and for Macomb County.

REGISTER'S OFFICE
County of Macomb
Received for Record this SEP 21 1935
of _____ A.D. 1935 at
_____ o'clock _____ M. and Recorded
in Liber _____ of Plat _____
on Page _____

ALL DIMENSIONS ARE GIVEN IN
FEET AND DECIMALS THERE OF

ORIGINAL