

LAND CORNER RECORDATION CERTIFICATE
 Filing Requirement of Act 74, Mich. P.A. 1970

For corners in


Macomb _____ Located In: _____ Corner Code # _____
 (County) Armada Township

1. Public Land Survey T 5N R 13E K-6
 T _____ R _____
 T _____ R _____
 T _____ R _____

2. Property Controlling S _____ T _____ R _____
 in Section S _____ T _____ R _____

3. Miscellaneous S _____ T _____ R _____
 Property in Sec. S _____ T _____ R _____

5179027
 LIBER 17189 PAGE 892



09/30/2005 09:40:55 A.M.
 MACOMB COUNTY, MI SEAL
 CARMELLA SABAUGH, REGISTER OF DEEDS

Register of Deeds Stamp & File Number

4. Lot No. _____, Recorded Plat _____
 5. Private Claims _____

I, Huston K. Kennedy, in a field survey on March 17, 2005 do hereby state that under requirements of P.A. 74, Michigan P.A. of 1970, the corner points mentioned in lines 1 and 2 above were in conformance with regulations and rules therefore as required in the current manual of survey instructions of the United States Department of the Interior, Bureau of Land Management or by a decree of a Court of Law and/or that the corner points mentioned in lines 3, 4 and 5 above were in conformance with the rules of the Michigan Board of Land Surveyors or by a Decree of a Court of Law; established, re-established, monumented, recovered, found as expressed below:

NOTE: Not more than 2 corners, all in the same town and range, may be recorded on this certificate.

	A	B	C	D	E	F	G	H	I	J	K	L	M
1													
2		6		5		4		3		2		1	
3													
4		7		8		9		10		11		12	
5													
6		18		17		16		15		14		13	
7													
8		19		20		21		22		23		24	
9													
10		30		29		28		27		26		25	
11													
12		31		32		33		34		35		36	
13													

A. Description of original monument and accessories and/or subsequent restoration:
 1817-Preston, D.S.; Marked corner with Plum Tree 6" in diameter, no witnesses
 1.) 1991-King, PS #30085; LCRC L.5101, pg.645 – Fnd a ½" Iron Bar w/cap #14760
 2.) 1982-Coulter, PS #14760; Certificate of Survey L.3411, pg.936 – Object found not stated, no witnesses
 3.) 1985-King, PS #30085; Certificate of Survey L.3900, page 797 – Fnd a ½" Iron w/cap #30085
 4.) 1987-King, PS #30085; Certificate of Survey L.4306, pg.706 – Fnd ½" Iron w/cap #30085
 5.) 1987-King, PS #30085; Certificate of Survey L.4306, pg.739 – Fnd ½" Iron w/cap #30085, used same wit as 1987 Certificate of Survey
 (Cont. on back side LCRC)

B. Description of corner evidence found and/or method applied in restoring or reestablishing corner:
 2005-Kennedy Surveying, Inc. – Kennedy, PS #17623 – Found a ½" Iron Rod w/cap #30085 located 160 feet West of the existing center line of North Avenue extending to the Northeast and Southwest, which has a bituminous surface, also in line with the existing center line of Dayton Road extending to the East, which has a gravel surface.

Witnesses from LCRC #1, Certificate of Surveys #3, 4 & 6 were used to recover and verify the found ½" Iron Rod w/cap #30085.

I accepted the found ½" Iron Rod w/cap #30085 as the best evidence of the corner position as being perpetuated.

Field Measurements Between Corners see back side LCRC

C. Description of monument for corner and accessories established to perpetuate locating the position of the corner:
 K-6 I replaced the found ½" Iron Rod w/cap #30085 with a 4" diameter concrete monument with a ½" Iron Rod 36" long w/2" diameter aluminum cap stamped "Macomb County Monument, MI" Act #345, PS #17623"
 N70°E 16.92 Ft. set Mag Nail w/Remon Wahser South face 16" Maple
 S85°W 4.06 Ft. set Mag Nail w/Remon Washer North face 12" Ash
 S07°W 28.98 Ft. set Mag Nail w/Remon Washer East face 12" Maple
 S21°E 36.89 Ft. set Mag Nail w/Remon Washer NE face 11" Maple

The selected location is accepted by me and is generally accepted by Professional Surveyors as the best available evidence of the position of the corner as being perpetuated.

Signed by: _____ Date August 17, 2005
 Surveyor's Michigan License No.: 17623



FORM APPROVED BY MICHIGAN STATE BOARD OF PROFESSIONAL SURVEYORS, JAN. 28, 1993, REVISED MAY 1993

ACCEPTED BY THE MACOMB COUNTY SURVEY PEER GROUP AS THE OFFICIAL CORNER UNDER MICHIGAN PUBLIC ACT 345 OF 1990 AT A MEETING HELD

ON 8-16-05
Martin C. Dunn
 MARTIN C. DUNN, P.S. CHAIRMAN

Town 5 North, Range 13 East, Armada Township (K-6)

Section "A" Cont.

- 6.) 1990-King, PS #30085; Certificate of Survey L.5014, pg.655 – Fnd a ½" Iron w/cap #30085, used same wit as 1991 LCRC
- 7.) 1992-King, PS #30085; Certificate of Survey L.5831, pg.277 – Fnd a ½" Iron w/cap #30085, used same wit as 1991 LCRC
- 8.) 1993-James, PS #19835; Certificate of Survey L.5832, pg.198 – Fnd Iron w/cap #30085
- 9.) 1997-King, PS #30085; Certificate of Survey L.7430, pg.839 – Fnd ½" Iron w/cap #30085, used same wit as 1991 LCRC
- 10.) 1998-King, PS #30085; Certificate of Survey L.8047, pg.170 – Fnd ½" Iron w/cap #30085, used same wit as 1991 LCRC
- 11.) 1999-King, PS #30085; Certificate of Survey L.9121, pg.25– Fnd ½" Iron w/cap #30085, used same wit as 1991 LCRC
- 12.) 1999-King, PS #30085; Certificate of Survey L.9121, pg.42– Fnd ½" Iron w/cap #30085, used same wit as 1991 LCRC
- 13.) 1999-King, PS #30085; Certificate of Survey L.9121, pg.58– Fnd ½" Iron w/cap #30085, used same wit as 1991 LCRC
- 14.) 2002-King, PS #30085; Certificate of Survey L.12343, pg.348– Fnd ½" Iron w/cap #30085, used same wit as 1991 LCRC
- 15.) 1977-Lehner Associates, Inc., unrecorded witnesses – Set Iron
- 16.) 1992-Lehner Associates, Inc., unrecorded Sketch of Survey – Fnd Iron w/cap #30085
- 17.) 1996-James, PS #19835; unrecorded Certificate of Survey – Fnd Iron w/cap #30085, used same wit as Certificate of Survey recorded in Liber 5832, page 198
- 18.) 1977-Lehner Associates, Inc., unrecorded Sketch of Survey – Object found not stated, no witnesses.
- 19.) 2001-Duthler, PS #47200; unrecorded Certificate of Survey – Fnd a Iron w/cap #30085

Section "B" Cont.

Field Measurements Between Corners

K-6 to K-5

GLO = 40 chains or 2640.00 Ft.

Certificate of Surveys recorded in Liber 7430, page 839, Liber 8047, page 170 = 2667.24 Ft.

N02°26'20" W 2666.98 Ft. (mea.)

K-6 to K-7

GLO = 40 chains or 2640.00 Ft.

Certificate of Survey recorded in Liber 3411, page 936 = 2691.21 Ft.

Certificate of Survey recorded in Liber 4306, page 706 = 2691.47 Ft.

Certificate of Survey recorded in Liber 12343, page 348 = 2691.47 Ft.

Unrecorded Sketch of Survey by Lehner Associates, Inc., dated 1977 = 2679.00 Ft.

Unrecorded Certificate of Survey by Richard A. Duthler, PS #47200 dated August 2, 2001 = 2691.41 Ft.

S02°06'06" E 2691.48 Ft. (mea.)

K-6 to J-6

No GLO

Certificate of Survey recorded in Liber 4306, page 706 = 2630.40 Ft.

Certificate of Survey recorded in Liber 8047, page 170 = 2630.74 Ft.

S88°01'56" W 2630.52 Ft. (mea.)

K-6 to L-6

No GLO

Certificate of Surveys recorded in Liber 3411, page 936, Liber 5014, page 655, Liber 5831, page 277, Liber 9121, page 25, Liber 9121, page 42 = 2708.92 Ft.

Certificate of Survey recorded in Liber 5832, page 198 = 2709.19 Ft.

Certificate of Survey recorded in Liber 7430, page 839, Liber 9121, page 58 = 2608.92 Ft.

Unrecorded Certificate of Survey by Gerald G. James, PS #19835 dated February of 1996 = 2709.19 Ft.

Unrecorded Certificate of Survey by Richard A. Duthier, PS #47200 dated August 2, 2002 = 2708.89 Ft.

N86°35'19" E 2708.90 Ft. (mea.)



K-6
A M O A










02-11H
02-12E
02-140
02-13B
02-14H

02-13E 02-13F



COPYRIGHT 2001
MACOMB COUNTY, MI
All Rights Reserved

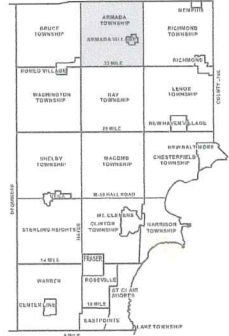

K-6

ARMADA TOWNSHIP SHEET INDEX

SOUTH		NORTH	
13-19-302-018	13-19-302-019	13-19-302-020	13-19-302-021
13-19-302-022	13-19-302-023	13-19-302-024	13-19-302-025
13-19-302-026	13-19-302-027	13-19-302-028	13-19-302-029
13-19-302-498	13-19-302-499	13-19-302-500	13-19-302-501

DESCRIPTION OF PERMANENT REAL ESTATE INDEX NUMBER

13-19-302-018
AREA NUMBER
SUB AREA NUMBER
BLOCK NUMBER
PARCEL NUMBER

- Legend**
- Platted Area Boundary Line
 - Property Line
 - Property Split Line
 - Property Combined Line
 - Property Easement Line
 - Traverse Line
 - Dimension Extent Marks
 - Dimension Start Marks

02-13A

Previously part of 02-44
ARMADA TWP.
W. 1/2 N.W. 1/4 SEC. 13 T. 5N. R. 13E.

Source: Macomb County Department of Planning and Economic Development
- 2004 Digital Orthophotography Project
- Parcel Conversion Project

Note:
Digital Orthophotography horizontal positioning accuracy is 3 feet. Parcel boundary lines should be considered a graphical representation and not in any way a legal survey or engineering document. In general, the horizontal positioning and length accuracy is within 15 feet.

This map is intended for general planning purposes. Site specific evaluation should be verified by field inspection. This is a work in progress and may contain errors and omissions. Please report any potential revisions to (586)469-5285.



GISs MACOMB COUNTY
Planning and Economic
Development Department




02-14H


K-6

400

02-13A 02-14C 02-14D 02-14G 02-15E 02-15A

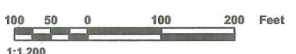

COPYRIGHT 2001
MACOMB COUNTY, MI
All Rights Reserved

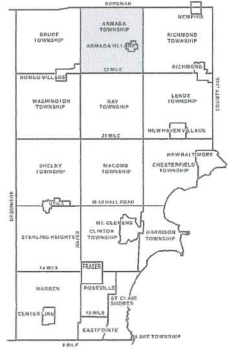

ARMADA TOWNSHIP SHEET INDEX

EAST		WEST	
ROW	COLUMN	ROW	COLUMN
100	100	100	100
100	101	100	101
100	102	100	102
100	200	100	200

DESCRIPTION OF PERMANENT REAL ESTATE INDEX NUMBER

13-19-302-018

- Platted Area Boundary Line
- Property Line
- Property Split Line
- Property Combined Line
- Property Easement Line
- Traverse Line
- Dimension Extent Marks
- Dimension Start Marks

02-14H

Previously part of 02-4I
ARMADA TWP.
E. 1/2 S.E. 1/4 SEC. 14 T.5N. R.13E.

Source: Macomb County Department of Planning and Economic Development
- 2004 Digital Orthophotography Project
- Parcel Conversion Project

Note: Digital Orthophotography horizontal positioning accuracy is 3 feet. Parcel boundary lines should be considered a graphical representation and not in any way a legal survey or engineering document. In general, the horizontal positioning and length accuracy is within 15 feet.
This map is intended for general planning purposes. Site specific evaluation should be verified by field inspection. This is a work in progress and may contain errors and omissions. Please report any potential revisions to (586)468-5285.



GIS MACOMB COUNTY
Planning and Economic
Development Department

Published: Dec 13, 2004

2005

**MACOMB COUNTY REMONUMENTATION
PROGRAM FOR ARMADA TOWNSHIP**

Research Dossier for K-6

Prepared by:
Kennedy Surveying, Inc.
105 North Washington Street
Oxford, Michigan 48371
05-6030 (96-4013)

Sources of Information Researched For Macomb County 2005 Remonumentation Program For Armada Township

- 1) GLO Notes
- 2) Act 74 Recorded LCRC
- 3) Act 132 Recorded Surveys
- 4) Personal History and Records
- 5) Unrecorded LCRC's and Surveys
- 6) Letters to the Following, Requesting Unrecorded information

- a) AES Engineers & Surveyors, Inc.
- b) Anderson, Eckstein & Westrick
- c) BMJ Engineers & Surveyors
- d) David Little Land Surveyor
- e) Dunn Construction
- f) Fenn & Associates Surveying, Inc.
- g) George Jerome & Company
- h) James Land Surveying
- i) Kem-Tec Surveying
- j) King Surveying & Associates, Inc.
- k) Lehner Associates, Inc.
- l) M.C.S. Associates, Inc.
- m) Metco Land Sea Corp.,
- n) Metco-Dunn, Inc.
- o) Michalich & Associates
- p) Milletics & Associates
- q) R.J. Donnelly & Associates, Inc.
- r) RA. Duthler Land Surveyor LLC
- s) Reichert Surveying
- t) Road Commission for Macomb County
- u) Rowe Incorporate
- v) Spalding, DeDecker & Associates
- w) Urban Land Consultants, L.L.C.
- x) Williams & Gorinac Associates

GLO SURVEY HISTORY

Researching the government survey records for Macomb County shows that the North and West lines of Armada Township were Surveyed and the township was subdivided into sections with closing corners set on the North and West township lines by William Preston, D.S. in 1817. A post was set at the West $\frac{1}{4}$ corner of Section 13 and the East $\frac{1}{4}$ corner of Section 14.

WITNESSES:

Marked corner with Plum Tree 6" in diameter, no witnesses

EXISTING CONDITIONS

The corner has been perpetuated with a $\frac{1}{2}$ " Iron Rod w/cap #30085 located 152.7 feet West of the existing center line of North Avenue extending to the Northeast and Southwest, which has a bituminous surface, also in line with the existing center line of Dayton Road extending to the East, which has a gravel surface.

RECORDED LCRC'S AND CERTIFICATE OF SURVEYS

Researching the Macomb County Records for Land Corner Recordation Certificates (LCRC) and Certificate of Surveys shows Donald H. King, PS #30085 recorded a LCRC on May 15, 1991. He found a $\frac{1}{2}$ " Iron Bar w/cap #14760.

WITNESSES:

(Based upon LCRC Recorded in Liber 5101, page 645 of Macomb County Records)

- *PK Nail in 5" Walnut – West – 4.10 Ft.
- *PK Nail in 6" Box Elder – NE – 10.15 Ft.
- *PK Nail in twin 8" Elm – SE – 23.80 Ft.
- *PK Nail in 4" Maple – SW – 29.00 Ft.

William J. Coulter, PS #14760 recorded a Certificate of Survey on May 6, 1982 in Liber 3411, page 936 of Macomb County Records. Object found not stated, no witnesses.

Donald H. King, PS #30085 did a Certificate of Survey on September 12, 1985 and is recorded in Liber 3900, page 797 of Macomb County Records. He found a $\frac{1}{2}$ " Iron w/cap #30085.

WITNESSES:

- East 152.71 Ft. to PK in center line North Avenue (gone)
- *SE 23.80 Ft. PK in 24" tree
- *West 4.10 Ft. to PK in 3" Elm
- *NE 10.15 Ft. to PK in 5" Maple

Donald H. King, PS #30085 recorded a Certificate of Survey on October 20, 1987 in Liber 4306, page 706 of Macomb County Records. He found $\frac{1}{2}$ " Iron w/cap #30085.

WITNESSES:

- PK Nail in center line North Avenue – East 152.71 Ft. (gone)
- *PK Nail in 24" tree – SE – 23.80 Ft.
- *PK Nail in 5" Elm – West – 4.10 Ft.
- *PK Nail in 5" Maple – NE – 10.15 Ft.

Donald H. King, PS #30085 recorded a Certificate of Survey on October 20, 1987 in Liber 4306, page 739 of Macomb County Records. He found a ½" Iron w/cap #30085, and used the same witnesses as those listed on the 1987 recorded Certificate of Survey.

Donald H. King, PS #30085 recorded a Certificate of Survey in December of 1990 in Liber 5014, page 655 of Macomb County Records. He found a ½" Iron w/cap #30085, and used the same witnesses as those listed on the 1991 LCRC.

Donald H. King, PS #30085 did a Certificate of Survey on October 19, 1992 and is recorded in Liber 5831, page 277 of Macomb County Records. He found a ½" Iron w/cap #30085, and used the same witnesses as those listed on the 1991 LCRC.

George G. James, PS #19835 recorded a Certificate of Survey on April 30, 1993 in Liber 5832, page 198 of Macomb County Records. He found a Iron w/cap #30085.

WITNESSES:

- *23.80 Ft. SE PK 24" tree
- *4.10 Ft. West PK 4" Elm
- 76.8 Ft. East Spike in 48" Willow (80 Ft. mea. to the center of a tree)

Donald H. King, PS #30085 recorded a Certificate of Survey on April 23, 1997 in Liber 7430, page 839 of Macomb County Records. He found a ½" Iron w/cap #30085, and used the same witnesses as those listed on the 1991 LCRC.

Donald H. King, PS #30085 recorded a Certificate of Survey on May 12, 1998 in Liber 8047, page 170 of Macomb County Records. He found a ½" Iron w/cap #30085, and used the same witnesses as those listed on the 1991 LCRC.

Donald H. King, PS #30085 recorded a Certificate of Survey on September 23, 1999 in Liber 9121, page 25 of Macomb County Records. He found a ½" Iron w/cap #30085, and used the same witnesses as those listed on the 1991 LCRC.

Donald H. King, PS #30085 recorded a Certificate of Survey on September 23, 1999 in Liber 9121, page 42 of Macomb County Records. He found a ½" Iron w/cap #30085, and used the same witnesses as those listed on the 1991 LCRC.

Donald H. King, PS #30085 recorded a Certificate of Survey on September 23, 1999 in Liber 9121, page 58 of Macomb County Records. He found a ½" Iron w/cap #30085, and used the same witnesses as those listed on the 1991 LCRC.

Donald H. King, PS #30085 recorded a Certificate of Survey on October 21, 2002 in Liber 12343, page 348 of Macomb County Records. He found a ½" Iron w/cap #30085, and used the same witnesses as those listed on the 1991 LCRC.

UNRECORDED SURVEYS AND WITNESSES

Unrecorded witnesses provided by Lehner Associates, Inc., dated November 18, 1977, set Iron.

WITNESSES:

- N85°E 79.62 Ft. PK in South side of 72" Willow (80 Ft. to center of a tree)
- N45°W 59.64 Ft. PK in 18" Elder (gone)
- *S45°E 130.35 Ft. NW corner of NW concrete abut on bridge
- N88°27'45" E 149.85 Ft. PK in center line North Avenue (gone)

Lehner Associates, Inc. did a sketch survey on June 16, 1992 and found Iron w/cap #30085.

Gerald G. James, PS #19835 did a Certificate of Survey in February of 1996. He found a Iron w/cap #30085, and used the same witnesses recorded on a Certificate of Survey in Liber 5832, page 198.

Unrecorded Sketch of Survey by Lehner Associates, Inc., dated 1977. Object found not stated, no witnesses.

R.A. Duthler, PS #47200 did a Certificate of Survey dated August 2, 2001 and found a Iron w/cap #30085.

WITNESSES:

- *4.10 Ft. to PK Nail in North face of 8" Walnut
- *10.15 Ft. NE to PK Nail in 10" Box Elder Maple
- *23.80 Ft. SE to PK Nail in twin 10" Elm
- *29.00 Ft. SE to PK Nail in 10" Maple

FIELD MEASUREMENTS BETWEEN CORNERS

K-6 to K-5

GLO = 40 chains or 2640.00 Ft.

Certificate of Surveys recorded in Liber 7430, page 839, Liber 8047, page 170 = 2667.24 Ft.

N02°26'20" W 2666.98 Ft. (mea.)

K-6 to K-7

GLO = 40 chains or 2640.00 Ft.

Certificate of Survey recorded in Liber 3411, page 936 = 2691.21 Ft.

Certificate of Survey recorded in Liber 4306, page 706 = 2691.47 Ft.

Certificate of Survey recorded in Liber 12343, page 348 = 2691.47 Ft.

Unrecorded Sketch of Survey by Lehner Associates, Inc., dated 1977 = 2679.00 Ft.

Unrecorded Certificate of Survey by Richard A. Duthler, PS #47200 dated August 2, 2001 = 2691.41 Ft.

S02°06'06" E 2691.48 Ft. (mea.)

(Revised 8/1/05 & 8/17/05)

K-6 to J-6

No GLO

Certificate of Survey recorded in Liber 4306, page 706 = 2630.40 Ft.

Certificate of Survey recorded in Liber 8047, page 170 = 2630.74 Ft.

S88°01'56" W 2630.52 Ft. (mea.)

K-6 to L-6

No GLO

Certificate of Surveys recorded in Liber 3411, page 936, Liber 5014, page 655, Liber 5831, page 277, Liber 9121, page 25, Liber 9121, page 42 = 2708.92 Ft.

Certificate of Survey recorded in Liber 5832, page 198 = 2709.19 Ft.


Certificate of Survey recorded in Liber 7430, page 839, Liber 9121, page 58 = 2608.92 Ft.

Unrecorded Certificate of Survey by Gerald G. James, PS #19835 dated February of 1996 = 2709.19 Ft.

Unrecorded Certificate of Survey by Richard A. Duthier, PS #47200 dated August 2, 2002 = 2708.89 Ft.

N86°35'19" E 2708.90 Ft. (mea.)

The witnesses from the above mentioned Land Corner Recordation Certificate, recorded and unrecorded Certificate of Surveys were used to verify the location of the found capped ½" Iron Rod #30085 as of March 17, 2005. I therefore, recommend to the Macomb County Peer Group that they accept the capped ½" Iron Rod #30085 as found as the best evidence of the corner position as be perpetuated.



Huston K. Kennedy, P.S.
Kennedy Surveying, Inc.

*Used to verify the location of the found corner K-6

(Revised 8/1/05 & 8/17/05)

Town 5 North Range 13 East

North Between Sections 23 + 24
 40.00 Set post for cor. of 1/4 S no. bearing tree
 54.12 Crk 30 lbs wide C.S.W.
 58.50 Same - - S.E.
 70.00 Same - - S.W.
 75.00 Beech 12 in diam
 80.00 Set post for cor of sections 13, 14, 23 + 24
 from which a Spruce tree 6 in diam bears
 N71 W 41 lbs distant also a Beech 8 in diam
 bears S. 61 W 45 lbs dist -
 Land first half mile 2nd rate rolling
 and dry last half same Timber fallen
 Undergrowth from Plum Briers +
 March 15th 1817

East On Randon between 13 + 24
 15.50 Crk 30 lbs wide Cour S.W. Gravelly bottom
 40.00 Set temp 1/2 mile post -
 81.00 Intersected E boundary 50 lbs South
 of Cor. Land 2nd rate Timber Beech B. Ash
 Elm part fallen Undergrowth Hawthorn
 Plum Briers Alder +

West Corrected
 40.50 Set post for Cor of 1/4 section from
 which an Elm 12 in diam bears
 S 21 W. 10 lbs dist - also a Beech 6 in
 diam bears N 46 W 10 lbs distant
 81.00 To Section Cor.

North Between Sections 13 + 14
 15.10 an Elm 40 in diam
 38.00 Crk 30 lbs wide Cour S.E.
 40.00 Made Cor for 1/4 S on a Plum tree in

LAND CORNER RECORDATION CERTIFICATE
Filing Requirement of Act 74, Mich. P.A. 1970

RECORDED IN MACOMB COUNTY
RECORDS AT: 8:34A

MAY 15 1991

Signature of Clerk

CLERK - REGISTER OF DEEDS
MACOMB COUNTY, MICHIGAN

Register of Deeds Stamp & File Number

For corners in

MACOMB (County)

Located In:

Corner Code :11

- 1. Public Land Survey T 5N R 13E. K-6 (SEC. 13)
T 5N R 13E. K-7 (SEC. 13)
T 5N R 13E. L-7 (SEC. 13)
2. Property Controlling in Section S T R
3. Miscellaneous Property in Sec. S T R

- 4. Lot No. Recorded Plat
5. Private Claims


I, Donald H. King, in a field survey on July 7, 1984, do hereby certify that under requirements of P.A. 74, Michigan P.A. of 1970, the corner points mentioned in lines 1 and 2 above were in conformance with regulations and rules therefore as required in the current manual of survey instructions of the United States Department of the Interior, Bureau of Land Management or by a decree of a Court of Law and/or that the corner points mentioned in lines 3, 4 and 5 above were in conformance with the rules of the Michigan Board of Land Surveyors or by a Decree of a Court of Law; established, re-established, monumented, re-monumented, recovered, found as expressed below:

NOTE: Not more than 4 corners, all in the same town and range, may be recorded on this certificate.

A. Description of original monument and accessories and/or subsequent restoration:

B. Description of corner evidence found and/or method applied in restoring or reestablishing corner:

- (K-6) Found 1/2" Iron bar w/cap # 14760.
(K-7) Found P.K. nail.
(L-7) Found 1/2" Iron bar.

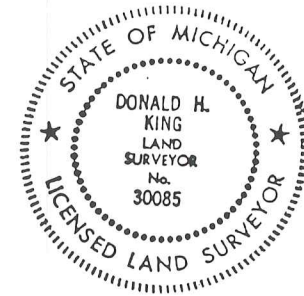

C. Description of monument for corner and accessories established to perpetuate locating the position of the corner:

- (K-6) 1/2" Iron bar. (K-7) P.K. nail.
P.K. nail in 5" walnut - West - 4.10'
P.K. nail in 6" box elder - N.E. - 10.15'
P.K. nail in tw. 8" elm - S.E. - 23.80'
P.K. nail in 4" maple - S.W. - 29.00'
P.K. nail in 18" pear - N.E. - 68.47'
Top centerline hydrant - S.E. - 38.00'
P.K. nail in 30" walnut - S.E. - 58.00'
Form nail in 24" maple - S.W. - 55.11'

- (L-7) 1/2" Iron bar.
S.E. bolt on base of Parking lot light pole - N.W. - 95.51'
Nail in tw. 9" oak - S.E. - 21.90'
Chisled mark top S. end 18" C.M.P. - S.W. 17.87'
Chisled mark top W. end 18" C.M.P. - N.W. - 93.28'

Signed by Donald H. King
Surveyor's Michigan License No. 30085

Date April 8, 1991

45

MAY - 6 1982

A748304

Certificate of Survey

PART OF THE S.W. 1/4 OF SECTION 13
T. 5 N., R. 13 E., ARMADA TOWNSHIP
MACOMB COUNTY, MICHIGAN 46.333 ACRES

Edna H. Hill
CLERK - REGISTER OF DEEDS
MACOMB COUNTY, MICHIGAN


3411 PAGE 936

W. 1/4 COR.
SECT. 13

CENTER POST
SECTION 13

DAYTON ROAD 2708

N. 88° 41' 00" E. 1354.73' E-W 1/4 LINE SEC. 13

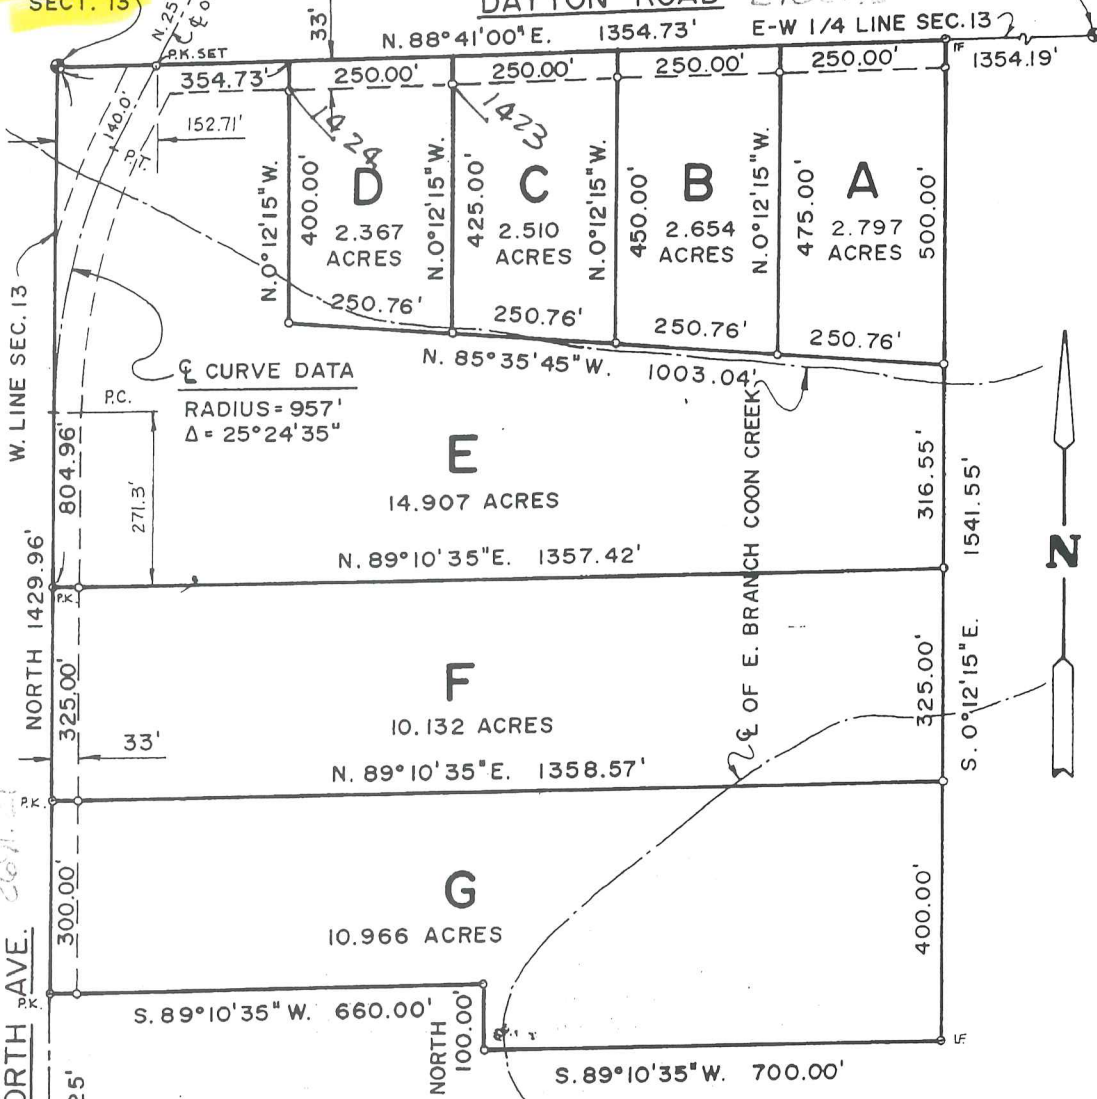


NOTE: Bearings expressed hereon are taken from survey of property to North of site, as recorded in Liber 2866, Page 871, with 1/4 line N. 88° 41' E.

LEGEND

- IRON SET (1/2"x18" ROD)
- ⊙ P.K. P.K. NAIL SET
- ⊙ IF IRON FOUND

K-7

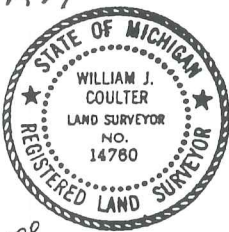

COULTER ASSOCIATES, INC. 48191 BLUEBIRD ST. UTICA, MICHIGAN 48087

I hereby certify that I have surveyed the property described hereon, with a relative error of closure less than 1 in 5000, that I have complied with the requirements of Section 3, Act 132, P.A. 1970, and that this map is a true representation of said survey.

William J. Coulter
William J. Coulter, R.L.S. # 14760

Phone: 739-1141

Date of Survey	Scale	Drawing Number
3-1-82	1" = 200'	ELMLANDS REALTY 5521 - 82

SHEET 1 of 2

ONLY AS GOOD AS THE ORIGINAL

CERTIFICATE OF SURVEY

FOR WILLIAM BARR
 JOB NO. 385-85 DATE 9-12-85
 SCALE 1" = 300' SHEET 1 of 2
 DRAWN BY D.H.K. CHECKED BY H.J.K.




M - MEASURED
 R - RECORDED
 C - CALCULATED

Part of the N.W. 1/4 of Section 13, Town 5 North,
 Range 13 East, Armada Township, Macomb County,
 Michigan.

MACOMB COUNTY B002101
 S:44(2)M

Note: Bearings relate to survey as recorded
 in Liber 2866, Page 871, Macomb County
 Records.

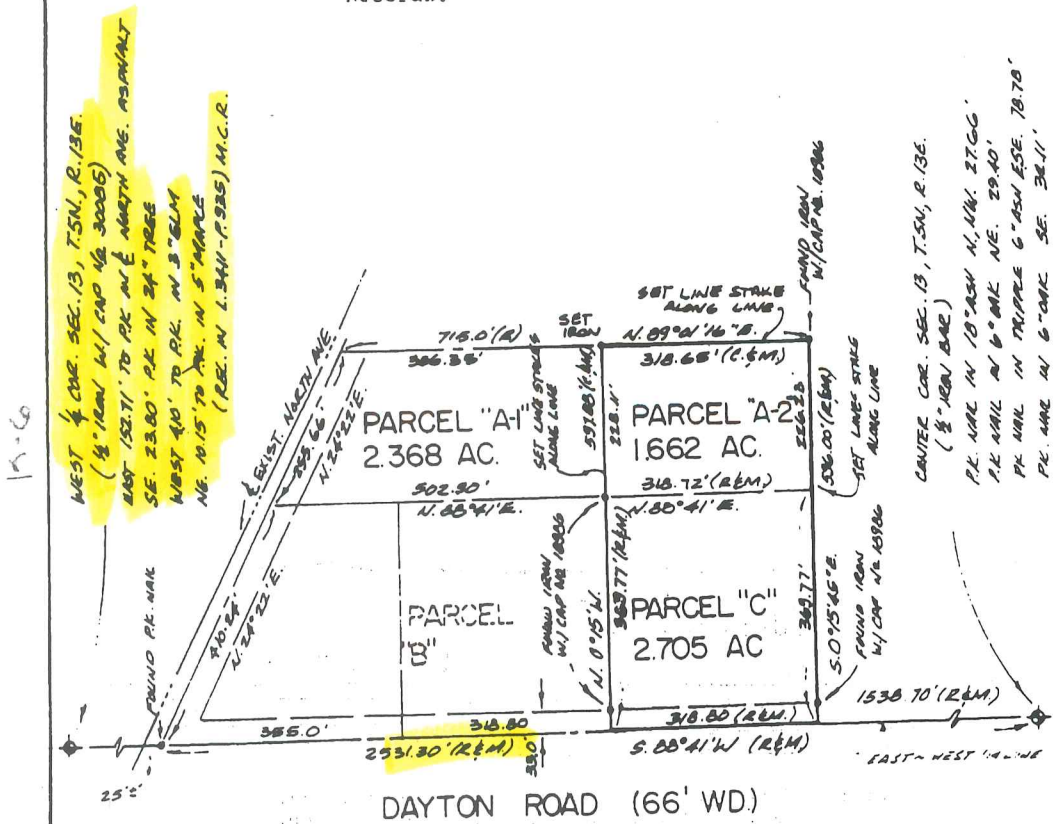

CENTER COR. SEC. 13, T.5N, R.13E.
 (1/4" IRON BAIL)
 PK. NAIL IN 10" BLM N. NW. 27.66'
 PK. NAIL IN 6" BLM NE. 29.40'
 PK. NAIL IN TRIPPLE 6" BLM ESE. 78.70'
 PL. NAIL IN 6" BLM SE. 38.11'

I, the undersigned, being a duly qualified and licensed land surveyor in the State of Michigan, do hereby certify that I have surveyed the premises hereinafter described and delineated thereon that said survey was performed with a high degree of accuracy and that I have fully complied with the requirements of the Michigan Surveying Act of 1978.

William Barr
 William Barr
 Licensed Land Surveyor



NO-D

CERTIFICATE OF SURVEY


FOR BERT HUELETT
 JOB NO. 200-87 DATE 4-1-87
 SCALE 1" = 200' SHEET 1 of 1
 DRAWN BY D.H.K. CHECKED BY H.J.K.



M - MEASURED
 R - RECORDED
 C - CALCULATED

DESCRIPTION:

A parcel of land located in and being a part of the East 1/2 of the S.E. 1/4 of Section 14, Town 5 North, Range 13 East, Armada Township, Macomb County, Michigan, and being more particularly described as follows: Commencing at the South 1/4 corner of said Section 14; thence South 89 degrees 05 minutes 50 seconds East 1311.05 feet along the South line of said Section 14 to the Southwest corner of the East 1/2 of the Southeast 1/4 of said Section 14; thence extending South 89 degrees 05 minutes 50 seconds East 405.24 feet along the South line of said Section 14 to the point of beginning; thence extending South 89 degrees 05 minutes 50 seconds East 202.62 feet along the South line of Section 14; thence North 00 degrees 05 minutes 32 seconds West 1072.50 feet; thence North 89 degrees 05 minutes 50 seconds West 202.62 feet; thence South 00 degrees 05 minutes 32 seconds East 1072.50 feet to the point of beginning, containing 4.988 acres of land. Reserving easements of record.

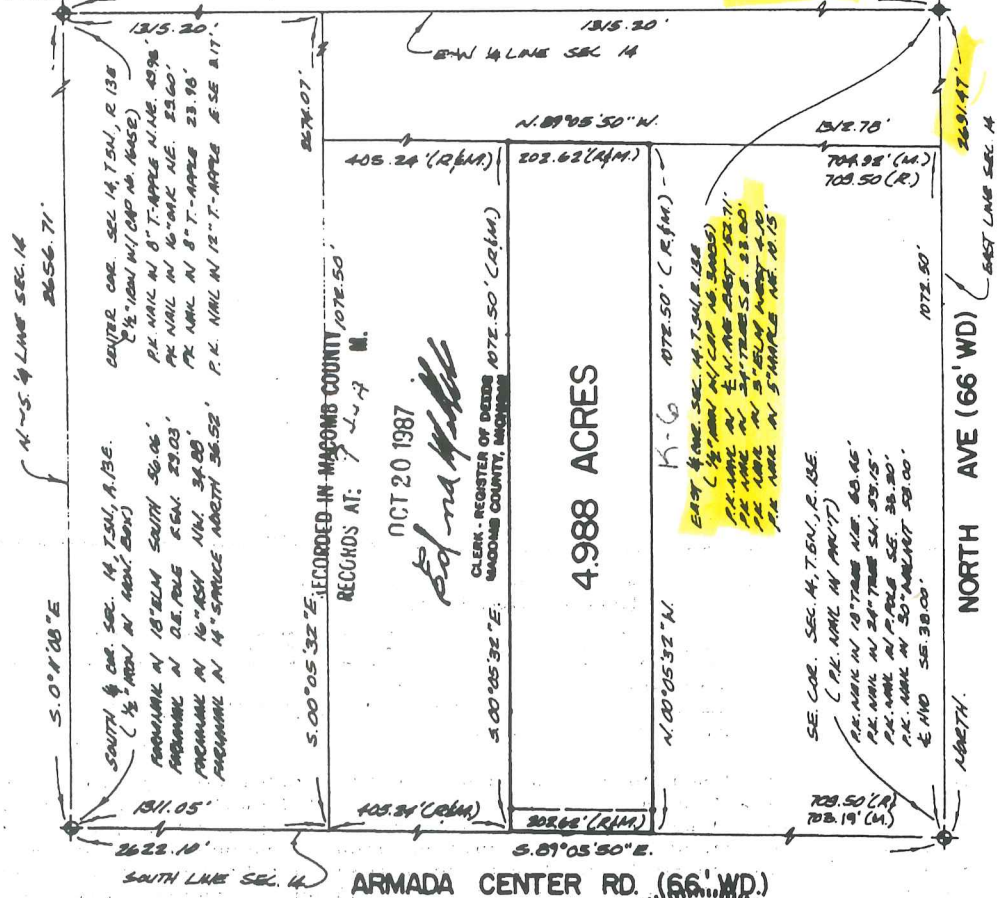

I hereby certify that I have surveyed the parcel(s) of land described and delineated hereon; that said Survey was performed with an error of closure no greater than 1 in 5,000; and that I have fully complied with the requirements of Section 3, Act 132, P.A. 1970.

Donald H. King
 DONALD H. KING
 LICENSED LAND SURVEYOR
 MICHIGAN LICENSE NO. 30085



NOTE: Bearings relate to record North bearing along East line Sec. 14.

KK KOBS-KING & ASSOC. INC.

**LAND SURVEYING
 SITE PLANNING**

CERTIFICATE OF SURVEY


FOR ARMADA AMVETS
 JOB NO. 199-87 DATE 4-1-87
 SCALE 1"=150' SHEET 1 OF 2
 DRAWN BY J. J. F. CHECKED BY D. H. K.



M - MEASURED
 R - RECORDED
 C - CALCULATED

Part of S.E. 1/4 of Section 14,
 Town 5 North, Range 13 East,
 Armada Township, Macomb County,
 Michigan.

NOTE: Bearings relate to record North
 bearing along East line of
 Section 14.

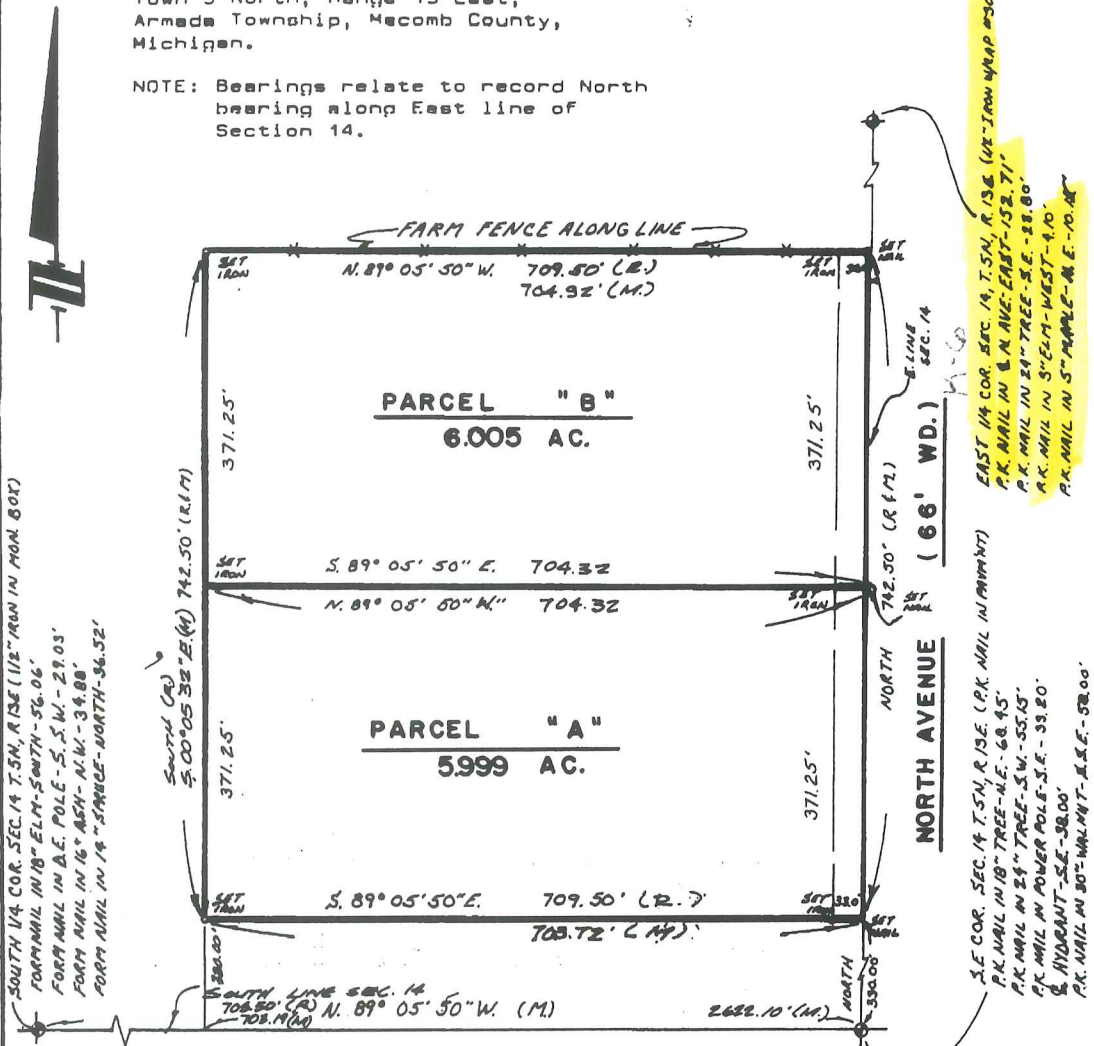

SOUTH 1/4 COR. SEC. 14 T. 5N, R. 13E (1/2" IRON IN MON. BOX)
 FORM NAIL IN 18" ELM - SOUTH - 56.06'
 FORM NAIL IN A.E. POLE - S. 5' W. - 29.03'
 FORM NAIL IN 16" ASH - N.W. - 34.88'
 FORM NAIL IN 14" SANGRE - NORTH - 36.52'

EAST 1/4 COR. SEC. 14, T. 5N, R. 13E (1/2" IRON NAIL #30085)
 P.K. NAIL IN 18" TREE - EAST - 152.71'
 P.K. NAIL IN 24" TREE - S.E. - 88.80'
 P.K. NAIL IN 5" ELM - WEST - 4.10'
 P.K. NAIL IN 5" MAPLE - N.E. - 10.48'

S.E. COR. SEC. 14 T. 5N, R. 13E (P.K. NAIL IN PINNAC)
 P.K. NAIL IN 18" TREE - N.E. - 68.45'
 P.K. NAIL IN 24" TREE - S.W. - 55.15'
 P.K. NAIL IN POWER POLE - S.E. - 33.80'
 HYDRANT - S.E. - 38.00'
 P.K. NAIL IN 80" WALNUT - S.E. - 58.00'

ARMADA CENTER ROAD

RECORDED IN MACOMB COUNTY
 RECORDS AT: 947A M.

OCT 20 1987

Edna Hill
 CLERK - REGISTER OF DEEDS
 MACOMB COUNTY, MICHIGAN

I hereby certify that I have surveyed the parcel(s) of land described and delineated hereon; that said Survey was performed with an error of closure no greater than 1 in 5,000; and that I have fully complied with the requirements of Section 3, Act 132, P.A. 1970.

Donald H. King
 DONALD H. KING
 LICENSED LAND SURVEYOR
 MICHIGAN LICENSE NO. 30085



KK KOBBS-KING & ASSOC. INC.

111 SOUTH RAWLES

ROMEO, MICHIGAN 48065-0146

**LAND SURVEYING
 SITE PLANNING**

313-752-2700

CERTIFICATE OF SURVEY

B871169



M - MEASURED
R - RECORDED
C - CALCULATED

FOR ARMADA AREA SCHOOLS
JOB NO. 437-92 DATE 10-19-92
SCALE 1" = 300' SHEET 1 OF 2
DRAWN BY K.D.R. CHECKED BY D.H.K.


LIBER 05831PC277

Part of the Southwest 1/4 of Section 13, Town 5 North,
Range 13 East, Armada Township, Macomb County, Michigan.

PARCEL "A"

A parcel of land located in the Southwest 1/4 of Section 13, Town 5 North, Range 13 East, Armada Township, Macomb County, Michigan, and being more particularly described as follows: Commencing at the Center Corner of said Section 13; thence South 89 degrees 23 minutes 30 seconds West 60.01 feet along the East-West 1/4 line of said Section 13 to the point of beginning; thence extending South 89 degrees 23 minutes 30 seconds West 634.05 feet along the East-West 1/4 line of Section 13; thence South 00 degrees 31 minutes 40 seconds West 686.61 feet; thence North 89 degrees 23 minutes 30 seconds East 636.31 feet; thence North 00 degrees 20 minutes 20 seconds East 686.57 feet to the point of beginning, containing 10.010 acres of land.

Subject to the rights of the public in Dayton Road. Reserving easements of record.

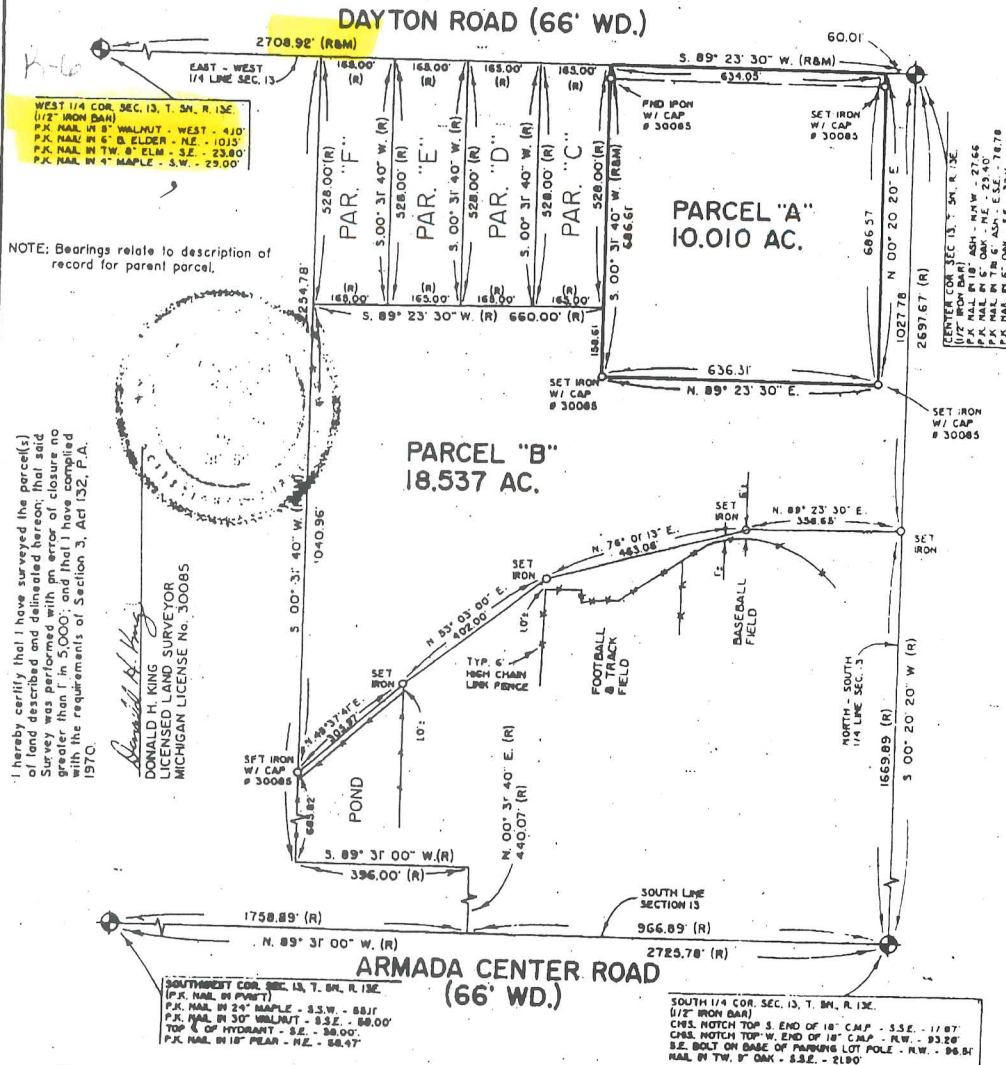

KK KOBBS-KING & ASSOC. INC.
111 SOUTH RAWLES
ROMEO, MICHIGAN 48065-0146

**LAND SURVEYING
SITE PLANNING**
313-752-2700

LIBER 05832PG198

1871549

75330 NORTH AVE


FILE POLICY
D.F. { T935-178 STE

ORIGINAL

DESCRIPTION (as surveyed in field)

A parcel of land being a portion of the SW.1 of the NW.1 of Sec. 13, T.5 N., R.13 E., Armada Twp., Macomb County, Michigan, described as: Commencing at the Center Post of said Sec. 13; Th. S. 88° 41' W. 2531.50 ft. along the E. & W. line; Th. N. 24° 22' E. 665.9 ft. to the P.O.B.; Th. N. 89° 01' 16" E. 900.0 ft. along a previously surveyed line, by others; Th. N. 00° 10' 44" W. 100.0 ft.; Th. S. 89° 01' 16" W. 854.03 ft.; Th. S. 24° 22' W. 110.64 ft. to the P.O.B., said parcel containing 2.01 acres, more or less, and reserving all easements of record. (76330 North Ave., Armada, Michigan)

W. 1/2 COR. SEC. 13 (61-1005)
2531.50 FT. 25' 74EE
410 W. 89° 01' 16" E. 900.0
76.8' E. SP. 18" OAK

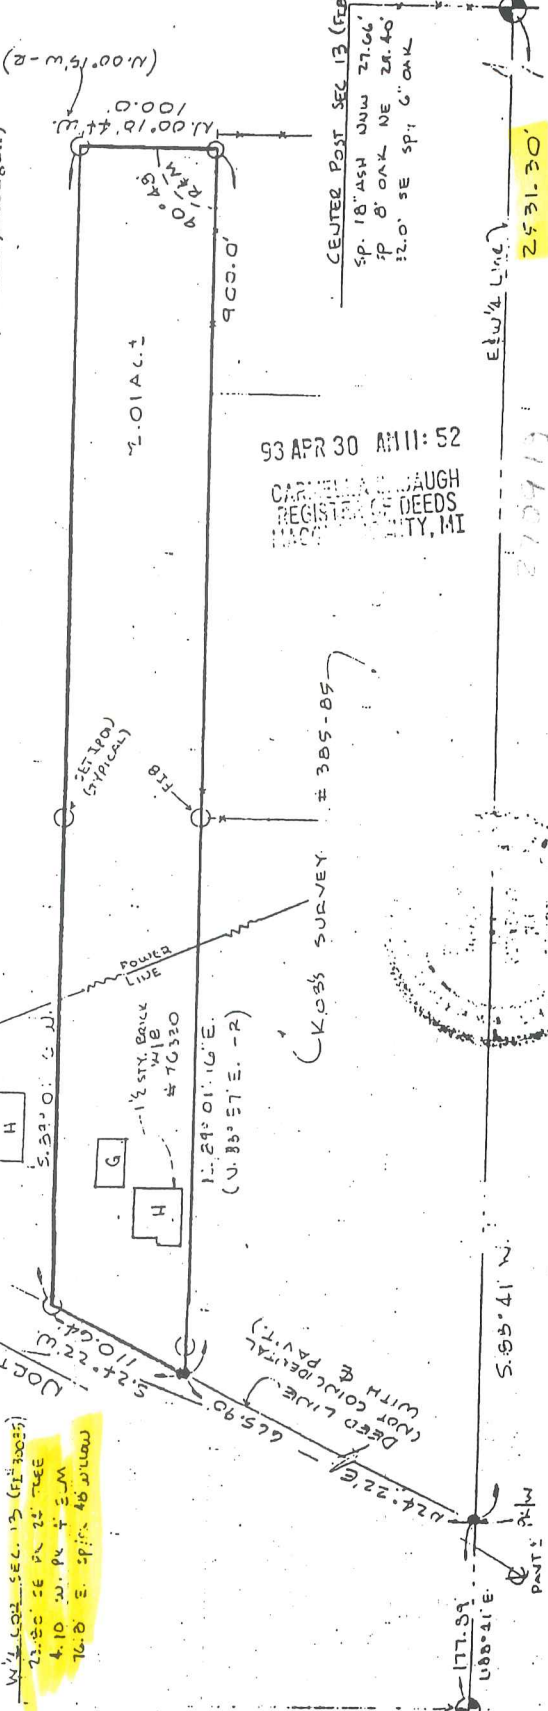

93 APR 30 AM 11:52
CASS COUNTY REGISTERED DEEDS
CASS COUNTY, MI



SCALE 1"=100'

GERALD G. JAMES LAND SURVEYING
P.O. BOX # 238 Marysville, Michigan
SURVEY OF PARCEL 02-13-100-010
IN THE NW 1/4 SEC. 13, T. 5N, R. 13E,
ARMADA TOWNSHIP
MACOMB COUNTY, MICHIGAN

Gerald G. James
GERALD G. JAMES, R.S. 69835

2. RECORDED
M-MEASURED

DR. BY *G. James* APP. BY *G. James* DATE 1 Jul 93 SHT. 1 of 1
K.S. JAMES T. MILLER - ATTY. JB-11/12
DEVA KOPPEL - AGENT

CERTIFICATE OF SURVEY


39.605-ACRE PARCEL

A parcel of land located in the Northeast 1/4 of Section 14, Town 6 North, Range 13 East, Armada Township, Macomb County, Michigan, and being more particularly described as follows: Commencing at the Northeast Corner of said Section 14; thence South 00 degrees 16 minutes 19 seconds East 888.03 feet along the East line of Section 14 to the point of beginning; thence extending South 00 degrees 16 minutes 19 seconds East 665.59 feet along the East line of Section 14; thence North 89 degrees 50 minutes 11 seconds West 2,625.90 feet to the North-South 1/4 line of Section 14; thence North 00 degrees 03 minutes 51 seconds West 649.03 feet along the North-South 1/4 line of Section 14; thence North 89 degrees 48 minutes 08 seconds East 2,623.47 feet to the point of beginning, containing 39.605 acres of land.

Subject to an easement for the East Branch of the Coon Creek, if any exists. Also subject to any easements and/or rights of way, recorded or otherwise.

NOTE: Bearings relate to Survey for Henry Bruder on property located immediately North, Job Number 96304-A, performed on November 17, 1996, by Donald H. King.

KING SURVEYORS & ASSOC. INC.

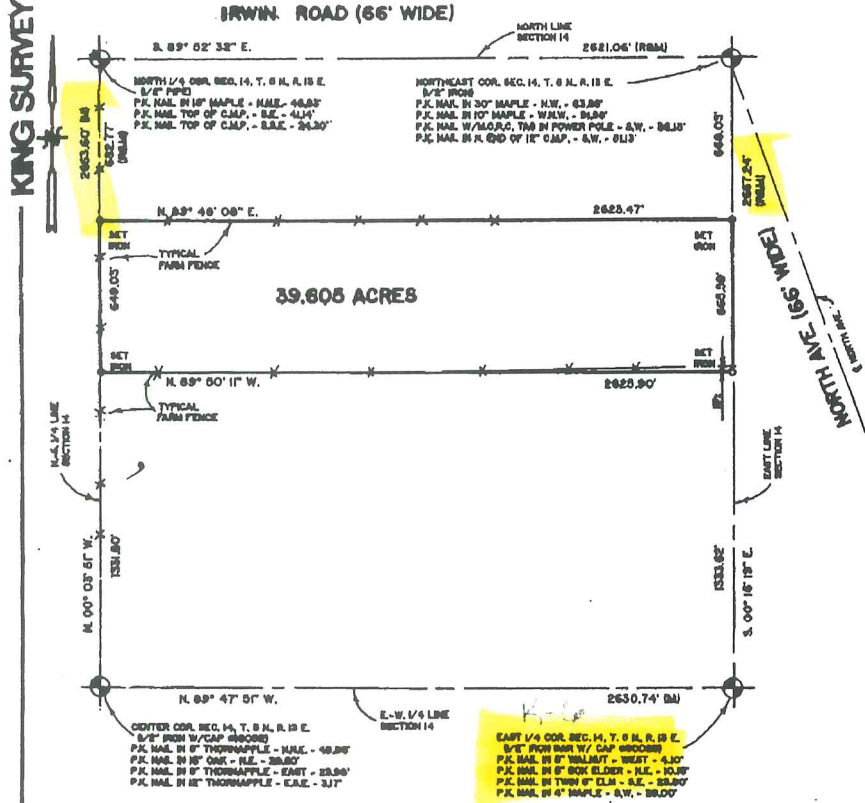

I hereby certify that I have surveyed the parcels of land described and delineated herein; that said Survey was performed with an error of closure no greater than 1 in 5000; and that I have complied with the requirements of Section 5, Act 132, P.A. 1970.

Donald H. King
 DONALD H. KING
 PROFESSIONAL SURVEYOR
 MICHIGAN LICENSE No. 30085



22657 IRWIN ARMADA, MICHIGAN 48005 (810) 764-4800



- LEGEND:**
 R = RECORDED
 M = MEASURED
 C = CALCULATED
 SIC = SET IRON W/ CAP
 FIC = FOUND IRON W/ CAP
 FI = FOUND IRON
 FM = FOUND MONUMENT

CLIENT CHARLES JENUWINE
BARBARA JENUWINE
 DRAWN BY: RG CHK'D BY: D.H.K.



1" = 500'	4-18-97
SCALE SHEET	DATE JOB No.
1 OF 1	97064

CERTIFICATE OF SURVEY

PARCEL "C"


A parcel of land located in the Southwest 1/4 of Section 13, Town 5 North, Range 13 East, Armada Township, Macomb County, Michigan, and being more particularly described as follows: Beginning at a point on the East-West 1/4 line of Section 13, South 89 degrees 07 minutes 10 seconds West (recorded) South 89 degrees 23 minutes 30 seconds West (measured) 694.06 feet from the Center Corner of said Section 13; thence extending South 89 degrees 07 minutes 10 seconds West (recorded) South 89 degrees 23 minutes 30 seconds West (measured) 165.00 feet along the East-West 1/4 line of Section 13; thence South 00 degrees 31 minutes 40 seconds West 528.00 feet; thence North 89 degrees 23 minutes 30 seconds East 165.00 feet; thence North 00 degrees 31 minutes 40 seconds East 528.00 feet to the point of beginning, containing 2.000 acres of land.

Subject to the rights of the public in Dayton Road. Reserving easements of record.

NOTE: Bearings relate to Description of record for Delineated Parcel.

KING SURVEYORS & ASSOC., INC.

DAYTON ROAD (66' WIDE)

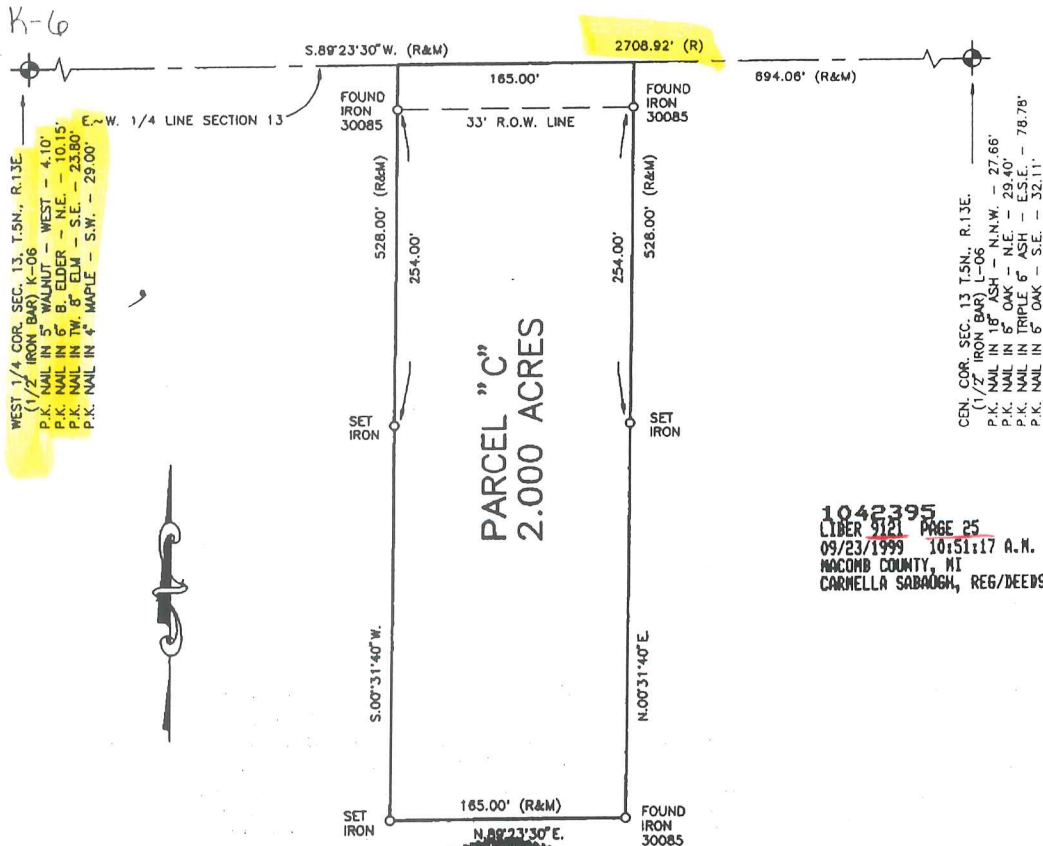

WEST 1/4 COR. SEC. 13, T.5N., R.13E.
(1/2" IRON BAR) K-06
P.K. NAIL IN 5" WALNUT - WEST - 4.10'
P.K. NAIL IN 6" B. ELDER - N.E. - 10.15'
P.K. NAIL IN TW. 8" ELM - S.E. - 23.80'
P.K. NAIL IN 4" MAPLE - S.W. - 29.00'


CEN. COR. SEC. 13, T.5N., R.13E.
(1" IRON BAR) L-06
P.K. NAIL IN 8" ASH - N.W. - 27.66'
P.K. NAIL IN 8" OAK - N.E. - 29.40'
P.K. NAIL IN TRIPLE 5" ASH - E.S.E. - 78.78'
P.K. NAIL IN 5" OAK - S.E. - 32.11'

1042395
LIBER 9121 PAGE 25
09/23/1999 10:51:17 A.M.
MACOMB COUNTY, MI
CARMELLA SABAUGH, REG/DEEDS

I hereby certify that I have surveyed the parcel(s) of land described and delineated hereon; that said Survey was performed with an error of closure no greater than 1 in 5000; and that I have complied with the requirements of Section 3, Act 132, P.A. 1970 as amended.

Donald H. King

DONALD H. KING
PROFESSIONAL SURVEYOR
MICHIGAN LICENSE No.30085

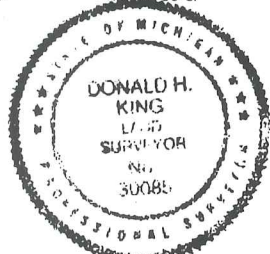

NOTE: A title search was not performed by the Client for purposes of this Survey. Therefore, no guarantee is made that any easements and/or rights of way recorded or otherwise, are shown on this Certificate of Survey.

This Survey and corresponding Legal Descriptions are subject to municipal approval, state division laws and local ordinances. Parts of this drawing may not be drawn to scale for clarity purposes.

22657 IRWIN ROAD ARMADA, MI 48005 (810) 784-4800



- LEGEND
- R = RECORD
 - M = MEASURED
 - C = CALCULATED
 - = SET IRON 30085
 - = FOUND IRON
 - = FOUND MONUMENT

CLIENT KURT SHERIDAN AND
DEBBIE SHERIDAN

DRAWN P.C.K. CHECKED BY D.H.K.



1" = 100'	8-2-99
SCALE	DATE
SHEET	JOB No.
1 OF 1	99099

KING SURVEYORS & ASSOC., INC.

CERTIFICATE OF SURVEY

PARCEL "1"

A parcel of land located in the Southwest 1/4 of Section 13, Town 5 North, Range 13 East, Armada Township, Macomb County, Michigan, and being more particularly described as follows: Commencing at the Center Corner of said Section 13; thence South 89 degrees 23 minutes 30 seconds West 60.01 feet along the East-West 1/4 line of Section 13 to the point of beginning; thence extending South 89 degrees 23 minutes 30 seconds West 211.35 feet; thence South 00 degrees 24 minutes 09 seconds West 686.58 feet; thence North 89 degrees 23 minutes 30 seconds East 212.11 feet; thence North 00 degrees 20 minutes 20 seconds East 686.57 feet to the point of beginning, containing 3.336 acres of land.

Subject to the rights of the public in Dayton Road. Also subject to any easements and/or rights of way, recorded or otherwise.

PARCEL "2"


A parcel of land located in the Southwest 1/4 of Section 13, Town 5 North, Range 13 East, Armada Township, Macomb County, Michigan, and being more particularly described as follows: Commencing at the Center Corner of said Section 13; thence South 89 degrees 23 minutes 30 seconds West 271.36 feet along the East-West 1/4 line of Section 13 to the point of beginning; thence extending South 89 degrees 23 minutes 30 seconds West 211.35 feet; thence South 00 degrees 27 minutes 55 seconds West 686.60 feet; thence North 89 degrees 23 minutes 30 seconds East 212.10 feet; thence North 00 degrees 24 minutes 09 seconds East 686.58 feet to the point of beginning, containing 3.337 acres of land.

Subject to the rights of the public in Dayton Road. Also subject to any easements and/or rights of way, recorded or otherwise.

PARCEL "3"

A parcel of land located in the Southwest 1/4 of Section 13, Town 5 North, Range 13 East, Armada Township, Macomb County, Michigan, and being more particularly described as follows: Commencing at the Center Corner of said Section 13; thence South 89 degrees 23 minutes 30 seconds West 482.71 feet along the East-West 1/4 line of Section 13 to the point of beginning; thence extending South 89 degrees 23 minutes 30 seconds West 211.35 feet; thence South 00 degrees 31 minutes 40 seconds West 686.61 feet; thence North 89 degrees 23 minutes 30 seconds East 212.10 feet; thence North 00 degrees 27 minutes 55 seconds East 686.60 feet to the point of beginning, containing 3.337 acres of land.

Subject to the rights of the public in Dayton Road. Also subject to any easements and/or rights of way, recorded or otherwise.

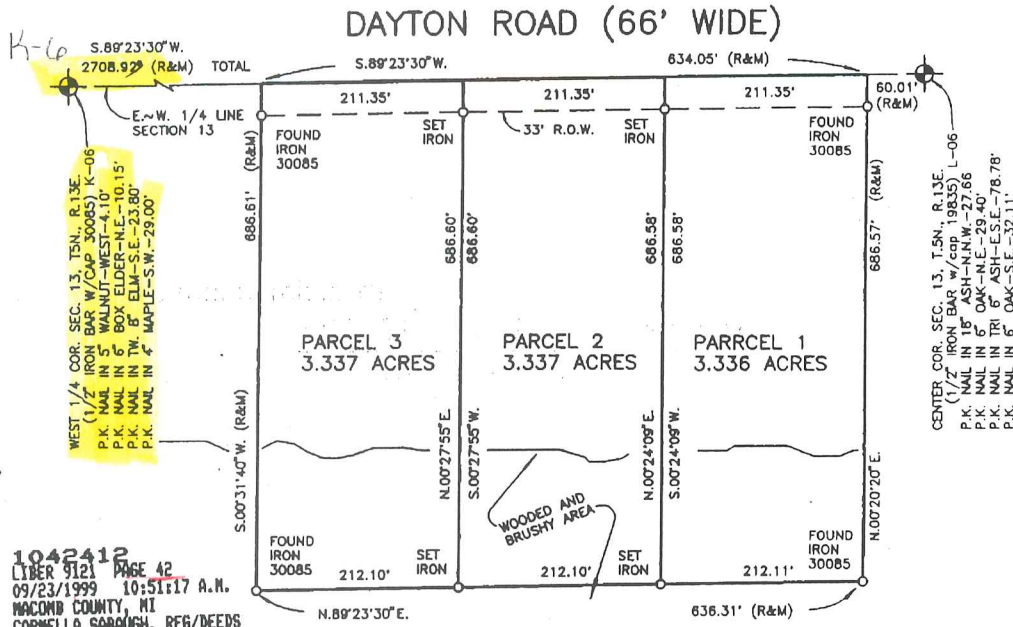


1042412
 LIBER 9121 PAGE 42
 09/23/1999 10:51:17 A.M.
 MACOMB COUNTY MI
 CARMELLA SABAUGH, REG/DEEDS

I hereby certify that I have surveyed the parcel(s) of land described and delineated hereon; that said Survey was performed with an error of closure no greater than 1 in 5000; and that I have complied with the requirements of Section 3, Act 132, P.A. 1970 as amended.

Donald H. King

DONALD H. KING
 PROFESSIONAL SURVEYOR
 MICHIGAN LICENSE No. 30085

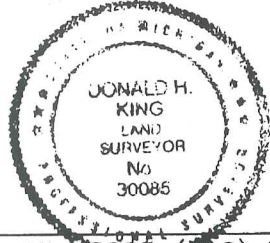

NOTE: A title search was not performed by the Client for purposes of this Survey. Therefore, no guarantee is made that any easements and/or rights of way recorded or otherwise, are shown on this Certificate of Survey.

This Survey and corresponding Legal Descriptions are subject to municipal approval, state division laws and local ordinances. Parts of this drawing may not be drawn to scale for clarity purposes.

22657 IRWIN ROAD ARMADA, MI 48005 (810) 784-4800



LEGEND

- R = RECORD
- M = MEASURED
- C = CALCULATED
- = SET IRON 30085
- = FOUND IRON
- = FOUND MONUMENT

CLIENT


DENNIS NIEDZWIECKI

DRAWN

PCK

CHECKED BY

DHK

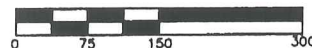

1" = 150'	7-22-98
SCALE	DATE
SHEET	JOB No.
1 OF 1	98121

CERTIFICATE OF SURVEY

DIVISION OF PART OF THE NORTHWEST 1/4 OF SECTION 13, TOWN 5 NORTH,
RANGE 13 EAST, ARMADA TOWNSHIP, MACOMB COUNTY, MICHIGAN.

NOTE: BEARINGS RELATE TO SURVEY BY DONALD H. KING ON 3-9-97 FOR
BILL BARR JOB NO. 97047 AND DESCRIPTION OF RECORD FOR PARENT PARCEL


KING SURVEYORS & ASSOC., INC.

WEST 1/4 COR. SEC. 13 T5N. R.13E
(1/2" IRON BAR W/CAP #30085) K-06
P.K. NAIL IN 5' WALNUT-WEST-4.10'
P.K. NAIL IN 6' BOX ELDER-N.E.-10.15'
P.K. NAIL IN 10' ELM-S.E.-23.80'
P.K. NAIL IN 4' MAPLE-S.W.-29.00'

N.89°44'33"W. (M)
2808.92' (R&M) TOTAL
EAST-WEST 1/4 LINE

WEST (R)
PREVIOUSLY SURVEYED
AND DESCRIBED
E-W 1/4 LINE SEC. 13

DAYTON ROAD (66' WIDE)

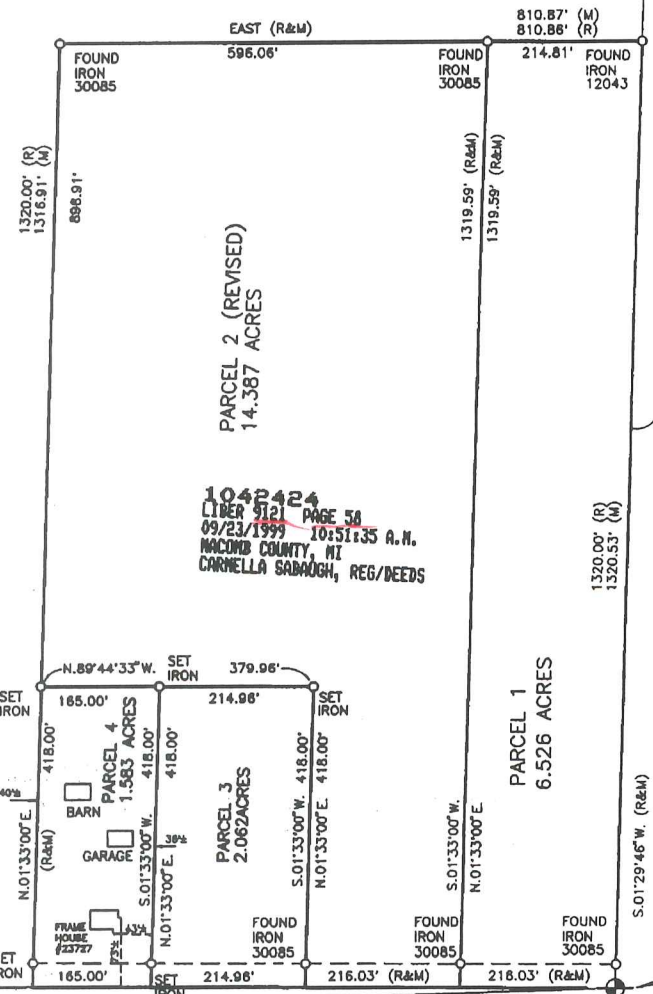

NORTH 1/4 COR. SEC. 13, T5N. R.13E
(SET IRON W/CAP #30035) L-05
P.K. NAIL IN 10' BOX ELDER-S.E.-20.13'
P.K. NAIL IN 12' OAK-S.W.-23.26'
P.K. NAIL IN 12' OAK CLUMP-W.S.W.-76.60'

NORTH-SOUTH 1/4 LINE SECTION 13

1320.00' (R)
1320.53' (M)

1319.59' (R&M)
1319.59' (R&M)

810.87' (E)
810.86' (R)


596.06'

214.81'

I hereby certify that I have surveyed the parcel(s) of land described and delineated hereon; that said Survey was performed with an error of closure no greater than 1 in 5000; and that I have complied with the requirements of Section 3, Act 132, P.A. 1970 as amended.

Donald H. King

DONALD H. KING
PROFESSIONAL SURVEYOR
MICHIGAN LICENSE No.30085

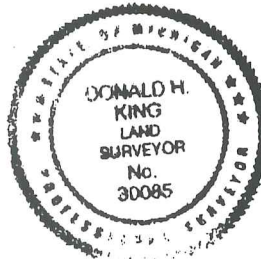

NOTE: A title search was not performed by the Client for purposes of this Survey. Therefore, no guarantee is made that any easements and/or rights of way recorded or otherwise, are shown on this Certificate of Survey.

This Survey and corresponding Legal Descriptions are subject to municipal approval, state division laws and local ordinances. Parts of this drawing may not be drawn to scale for clarity purposes.

22657 IRWIN ROAD ARMADA, MI 48005 (810) 784-4800



- LEGEND**
- REC = RECORD
 - MEAS = MEASURED
 - CALC = CALCULATED
 - SET IRON 30085
 - FOUND IRON
 - FOUND MONUMENT

CLIENT DENNIS NIEDZWIECKI

DRAWN PCK CHECKED BY DHK



1" = 200'	7-16-98
SCALE	DATE
SHEET	JOB No.
1 OF 2	98122

29

CERTIFICATE OF SURVEY

PARCEL "1" (1.072 ACRES)

A parcel of land located in the Southeast 1/4 of Section 14, Town 5 North, Range 13 East, Armada Township, Macomb County, Michigan, and being more particularly described as follows: Commencing at the Southeast Corner of said Section 14; thence North 1,255.00 feet along the East line of Section 14 to the point of beginning; thence extending North 165.00 feet along the East line of Section 14; thence North 89 degrees 02 minutes 48 seconds West 283.00 feet; thence South 165.00 feet; thence South 89 degrees 02 minutes 48 seconds East 283.00 feet to the point of beginning, containing 1.072 acres of land.



Subject to the rights of the public in North Avenue. Also subject to any easements and/or rights of way, recorded or otherwise.

NOTE: Bearings relate to description of record for Parent Parcel and survey as performed by Robert Smith, Lehner Associates, on November 9, 1977, Job Number 77753.

KING SURVEYING, INC.

2248199
LIBER 12343 PAGE 348
10/21/2002 11:00:33 A.M.
MACOMB COUNTY, MI
CARNELLA SABAUGH, REGISTER OF DEEDS

EAST 1/4 COR. SEC. 14, T.5N., R.13E.
(1/2" IRON W/CAP #30085) K-06
P.K. NAIL IN 5" WALNUT WEST 4.10'
P.K. NAIL IN 8" BOX ELDER N.E. 10.15'
P.K. NAIL IN TWIN 8" ELM S.E. 23.60'
P.K. NAIL IN 4" MAPLE S.W. 20.00'

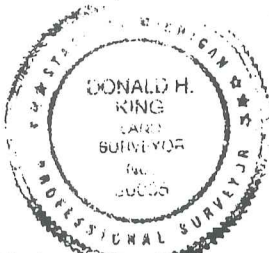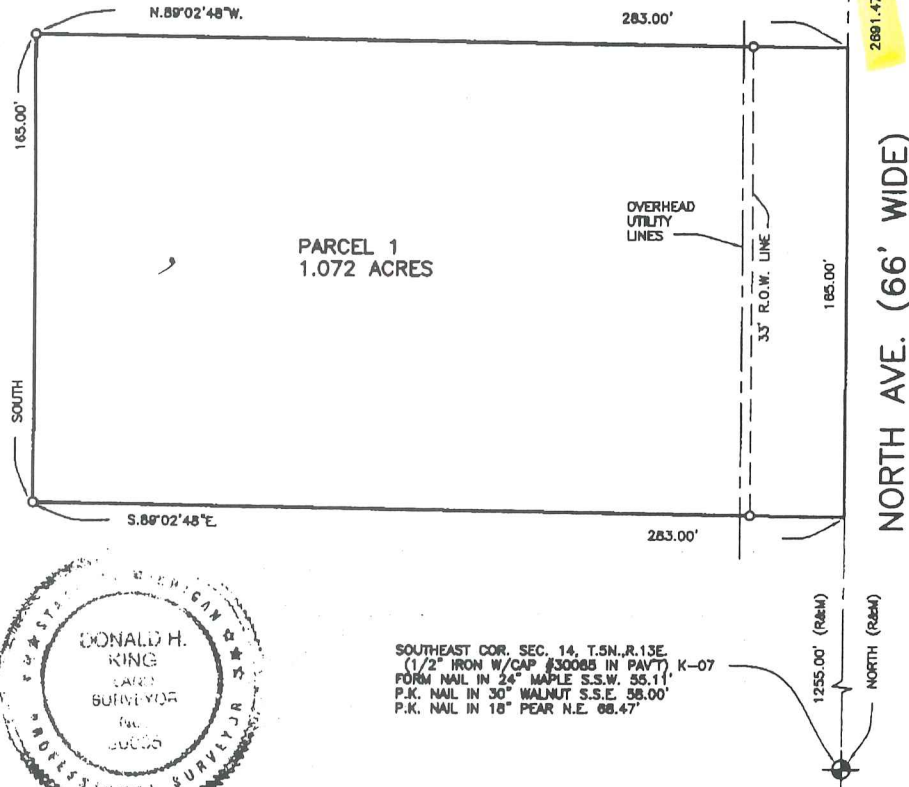

SOUTHEAST COR. SEC. 14, T.5N., R.13E.
(1/2" IRON W/CAP #30085 IN PAVT) K-07
FORM NAIL IN 24" MAPLE S.S.W. 55.11'
P.K. NAIL IN 30" WALNUT S.S.E. 58.00'
P.K. NAIL IN 18" PEAR N.E. 68.47'

I hereby certify that I have surveyed the parcel(s) of land described and delineated hereon; that said Survey was performed with an error of closure no greater than 1 in 5000; and that I have complied with the requirements of Section 3, Act 132, P.A. 1970 as amended.

Donald H. King
DONALD H. KING
PROFESSIONAL SURVEYOR
MICHIGAN LICENSE No. 30085

NOTE: A title search was not performed by the Client for purposes of this Survey. Therefore, no guarantee is made that any easements and/or rights of way recorded or otherwise, are shown on this Certificate of Survey.

This Survey and corresponding Legal Descriptions are subject to municipal approval, state division laws and local ordinances. Parts of this drawing may not be drawn to scale for clarity purposes

22657 IRWIN ROAD ARMADA, MI 48005 (586) 784-4800



- LEGEND**
- R = RECORD
 - M = MEASURED
 - C = CALCULATED
 - O = SET IRON 30085
 - = FOUND IRON
 - ⊙ = FOUND MONUMENT
 - = SET WOOD LINE STAKE

CLIENT DOMINIC A. MUGLIA

DRAWN J.G. CHECKED D.H.K.



1" = 50'	9-9-02
SCALE	DATE
SHEET	JOB No.
1 OF 1	02156

S-13-14

N 1/4 Sec.

Sec. 14, T. 1 N., R. 2 E.

N 25° E 25.85 PL. IN W. SIDE OF
 S 75° S 88.60 PL. IN P. 62 (H. 100)
 N 45° W 42.75 PL. IN 8' SIM.

S 5 COE

END. PL. MAIL

N 45° W 54.85 PL. IN MIST DOGS
 S 35° W 43.90 PL. IN GUY BUGS
 S 45° S 38.05 TOWNUT ON A. HYD.
 N 45° S 68.50 PL. IN 15' CHERRY

S 1/4 COE

1/2" LEAD NUMBUT BOX

S 30° W 28.99 PL. IN S. SIDE OF P. 62
 N 40° W 34.90 NAIL IN 8' ASH
 S 80° S 15.715 PL. IN P. 62

C. Post S-13-14
 SET NEON (Fence S. 5' E)

SOUTH 14.93 PL. IN FENCE POST
 EAST 2.50 PL. IN ALPHABETIC QUINN
 EAST 2300 P.O. A.P. FENCE N. 5' W

E. 1/4 COE S-13-14

S. 1/4 COE

N 85° E 79.62 PL. IN S. SIDE OF
 PL. W. ROAD

N 45° W 59.62 PL. IN 18' BURR

S 45° S 130.35 NAIL ON N. W. CORN.
 ASH ON BARRIS.

N 88° 21' 45" S 149.85 PL. IN E. NORTH
 AVE.

SKETCH OF SURVEY

W. 1/4 COR. SEC. 13
T. 5N., R. 13E.,
ARMADA TWP.,
MACOMB CO., MI.
354.13

F.I.R.D.N.
#30085

N. 88°-41'-00"E

POINT OF
BEGINNING

E/W 1/4 LINE SEC. 13.

E DAYTON RD. N. 88°-41'-00"E.

20' WD GRAVEL 250.00

33' R/W LINE 7



S. 1/2 IRON
33'

S. 1/2 IRON

33'

S. 1/2 IRON

S. 1/2 IRON

N. 00°-12'-15" W. 400.00 TO E

S. 00°-12'-15" E. 425.00 TO E

2.367 AC.

45/35

130'± TO STONE DAM

60'± TO E

S. 1/2 IRON

N. 85°-35'-45" W.

STONE & CONG. DAM

20/10

250.70

S. 1/2 IRON & T1B

SHARON VETTRAINO
11663 LANCER
STERLING HGTS, MI
48313

LEHNER ASSOCIATES, INCORPORATED
ENGINEERS & SURVEYORS
22900 WELLINGTON CRESCENT
MT. CLEMENS, MICHIGAN 48043
(313) 463-4594
FAX (313) 463-0672


SCALE: 1"=60'

DATE: 06/16/92

92-302

SHT. 1 of 2

SBA
NU-D

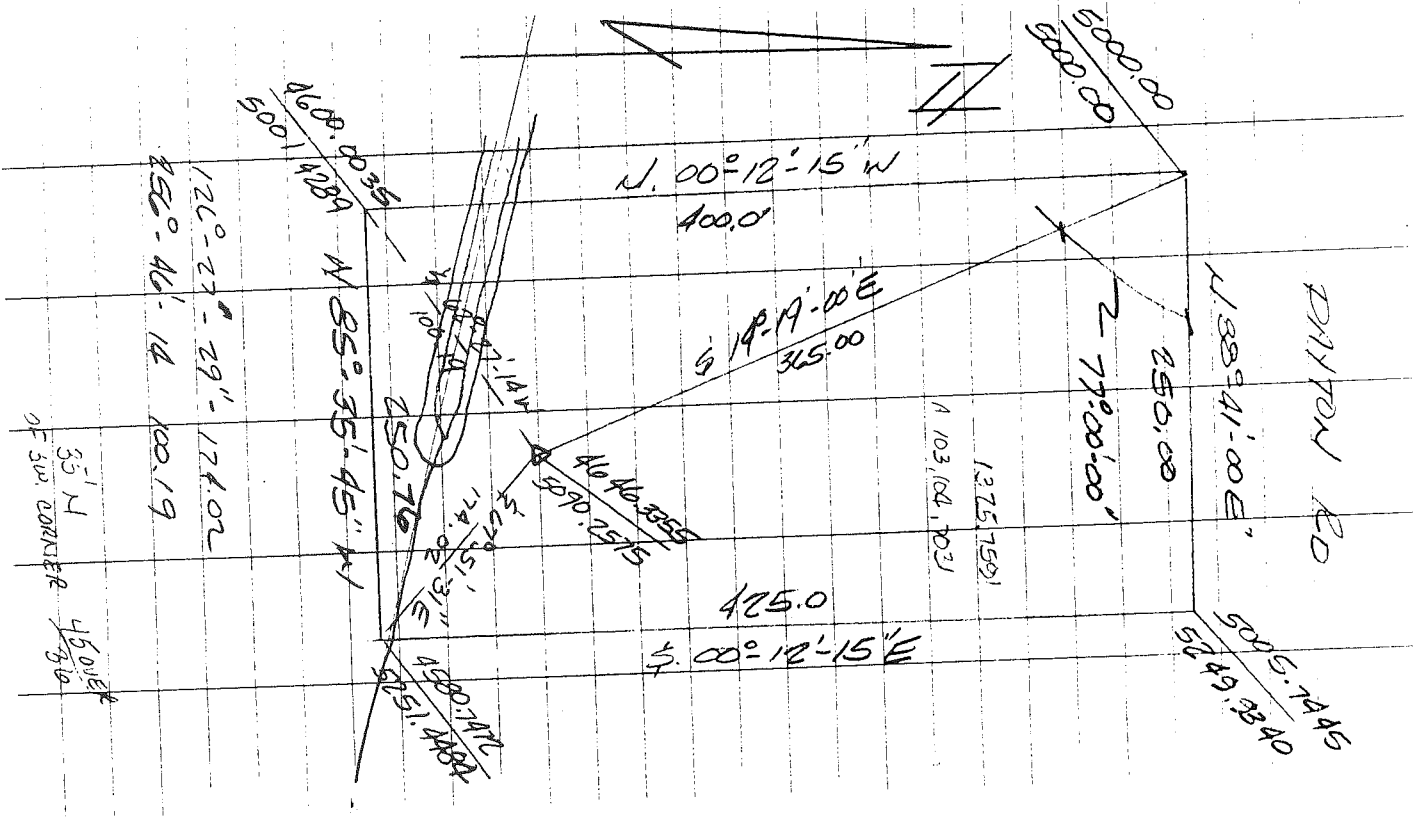


5-13-13

ACREAGE
ADRIAN DA
MACKON B

92-302
SHARON VETTER AND
STACE ROSEN
6/11/92
SADJ

(ACE) BROCKWAY TWP. 13

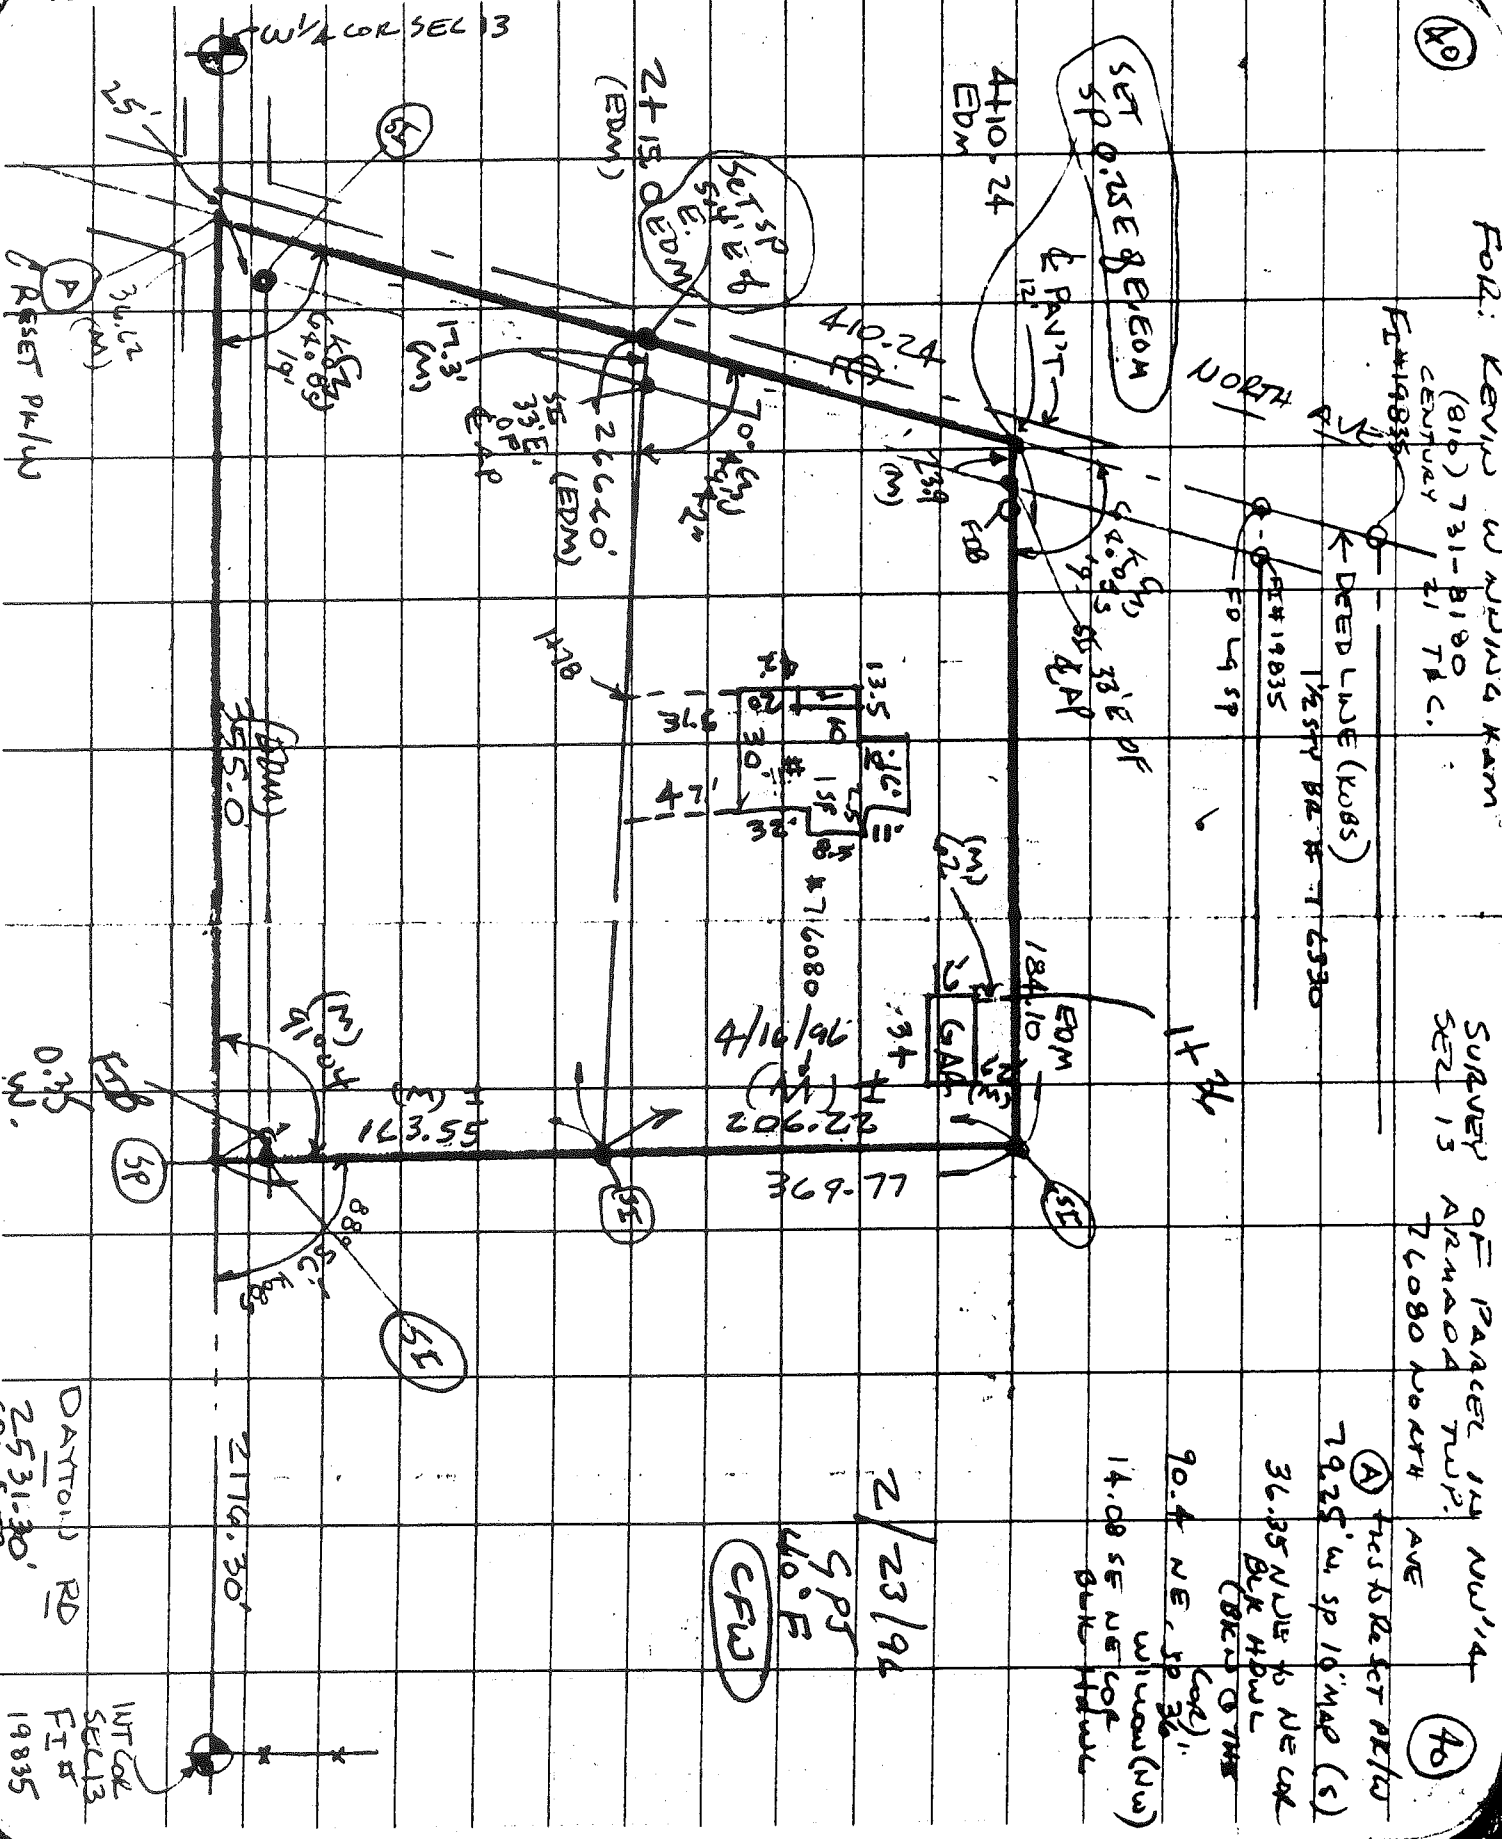

(40)

FOR: KENNEDY W. ADINA KAM
(816) 731-8180
CENTURY 21 TRC.

SURVEY OF PACER IN NW 1/4
SER 15 ARMAADA TWP.
T 6080 NORTH AVE

(40)

(A) THIS RESET PER/D
79.25' W. SP 16" MAR (S)

36.35' N. U/L TO NE COR
BLK 40 W/L
(BLEN O THS
COR)

90.4' NE, SP 36
WILLOW (NW)

14.08' SE NE COR
BLK 40 W/L

2/23/94

SPS
40' F

(CFW)

DAYTON RD
2531-30'
(R) EDM
INT COR
SER 13
FIR
19835

CA, DMS, B51, PMM
25042

K-6

ARMADA TWP.

W 1/4 OF SECTION 13

END 1" PIPE


SE 55.13' COR BLDG

NE 55.39' COR BLDG

NW 49.21' COR BLDG

SW 57.47' EASTERLY COR OF NELY

LEG OF FNB SIGN

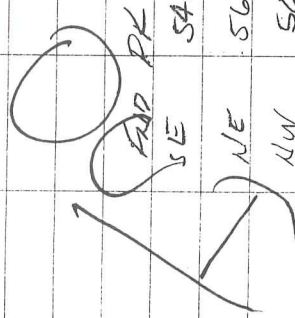

SE 54.30' COR BLDG


NE 56.25' COR BLDG

NW 50.02' COR BLDG

SW 56.60' EASTERLY COR OF NELY

LEG OF FNB SIGN

64
Book # 504

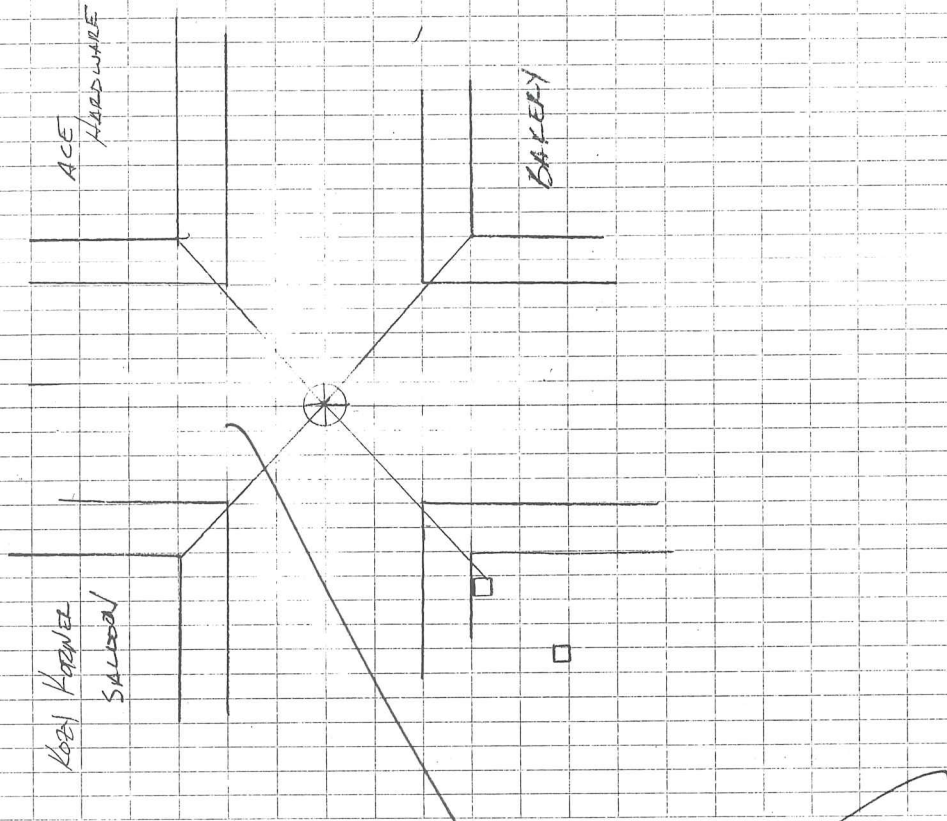


CERTIFIED SURVEY


L6 CENTER POST
SEC. 13
T. 5N., R. 13E.

K6
W 1/4 CORNER
SEC. 13
T. 5N., R. 13E.

PART OF THE SW 1/4 SEC. 13, T.5N., R.13E., ARMADA TWP.
MACOMB COUNTY, MICHIGAN

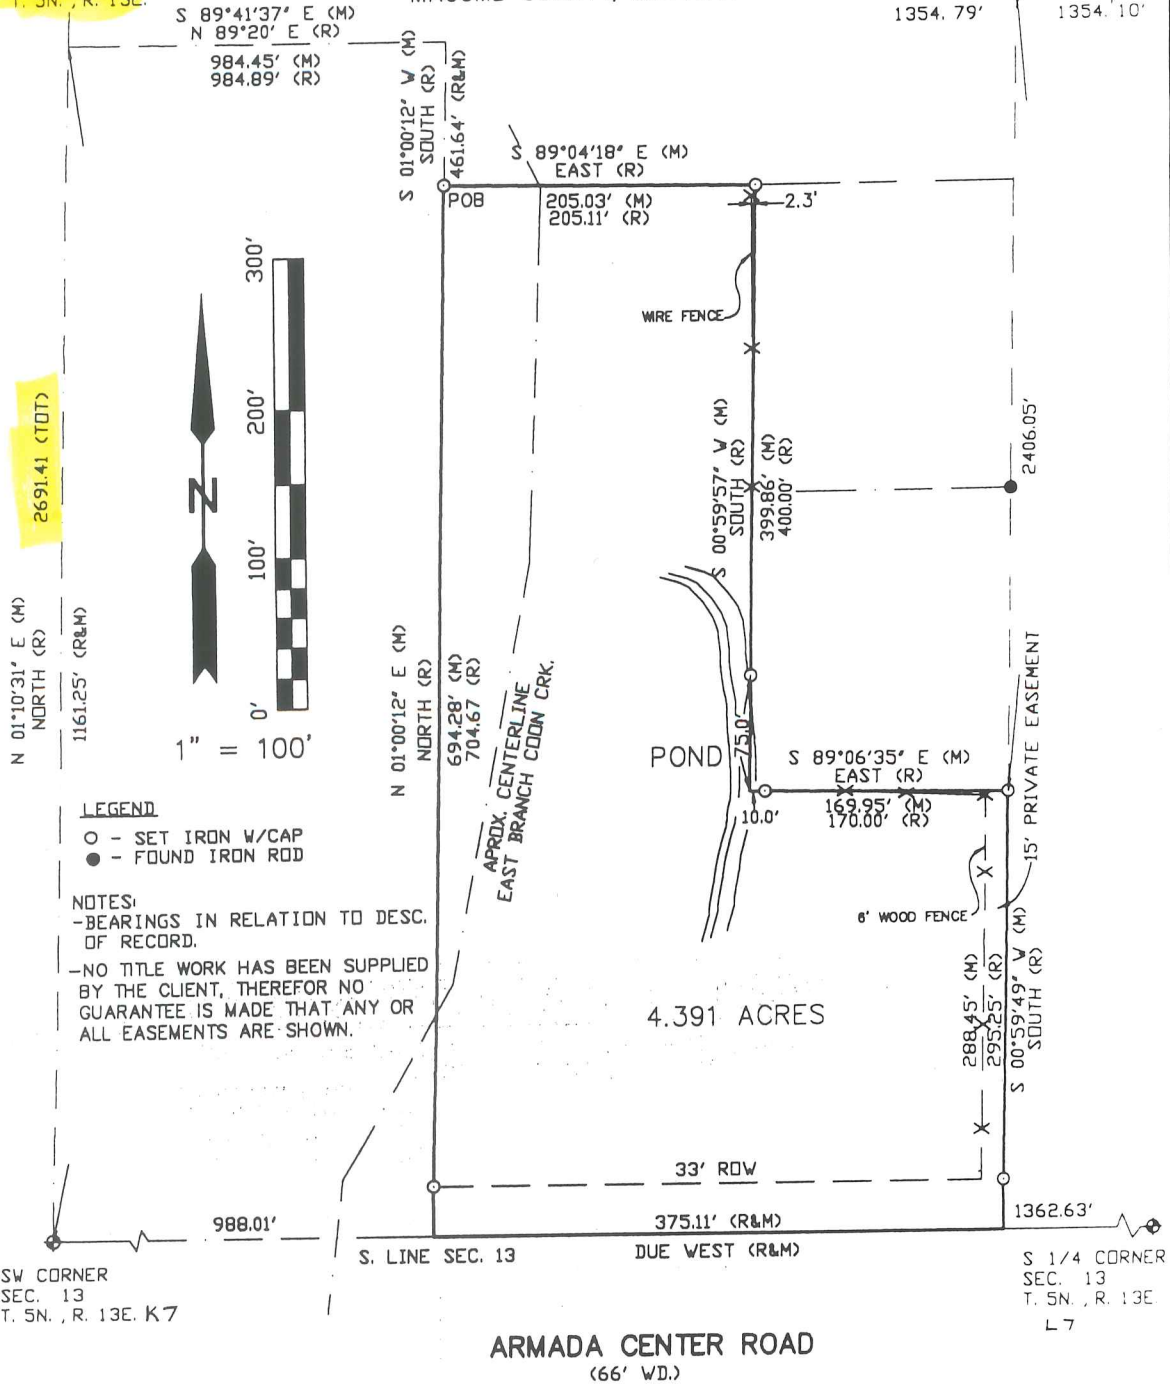

2691.41 (TOT)

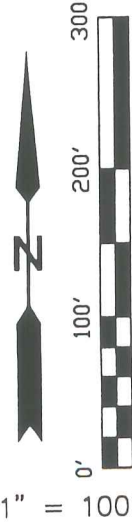

LEGEND

- - SET IRON W/CAP
- - FOUND IRON ROD

NOTES:

- BEARINGS IN RELATION TO DESC. OF RECORD.
- NO TITLE WORK HAS BEEN SUPPLIED BY THE CLIENT, THEREFOR NO GUARANTEE IS MADE THAT ANY OR ALL EASEMENTS ARE SHOWN.

SURVEYOR'S CERTIFICATE

I hereby certify that I have surveyed and mapped the land above described on August 2, 2001 and that the ratio of closure on the unadjusted field observations of such survey was no greater than 1/174,114 and that all of the requirements of P. A. 132 1970 have been complied with.

R.A. DUTHLER
LAND SURVEYOR LLC

256 FAIRGROVE
ROMED, MI 48065
TEL. (810) 752-6423
FAX (810) 336-4719

RICHARD A. DUTHLER
LICENSED LAND SURVEYOR
No. 47200

PREPARED FOR: MR. NIND ALVARADO

JOB# 010802
DATE AUG. 2, 2001
SHEET 1 OF 2

LEGAL DESCRIPTION

A parcel of land in the SW. 1/4 of Section 13, T.5N., R.13E., Armada Township, Macomb County, Michigan is described as: Commencing at the SW Corner of said Section 13; thence N.01°10'31"E. (Due North record), 1161.25 feet along the West Section line of said Section 13 and the centerline of North Avenue; thence S.89°41'37"E. (N.89°20'E. record), 984.45 feet (984.89' record); thence S.01°00'12"W. (South record), 461.64 feet to the Point of Beginning; thence S.89°04'18"E., (Due East record) 205.03 feet (205.11 feet record); thence S.00°59'57"W. (Due South record), 399.86 feet (400.00 feet record); thence S.89°06'35"E. (Due East record), 169.95 feet (170.00 feet record); thence S.00°59'49"W. (Due South record), 288.45 feet (295.25 feet record), to a point on the South Section Line of said Section 13 and the Centerline of Armada Center Road; thence along said South Line, Due West, 375.11 feet; thence N.01°00'12"E. (Due North record), 694.28 feet (704.67 feet record) to the Point of Beginning and containing 4.391 acres.

Subject to the rights of the public for highway purposes along Armada Center Road and to a private easement for ingress and egress across the most easterly 15' of the property and to all other easements of record.

WITNESSES

(K-6)

W 1/4 CORNER SEC. 13

FOUND #30085

4.10' W. TO A PK NAIL IN THE NORTH FACE OF AN 8" WALNUT

10.15' NE TO A PK NAIL IN A 10" BOX ELDER MAPLE

23.80' SE TO A PK NAIL IN A TWIN 10" ELM

29.00' SW TO A PK NAIL IN A 10" MAPLE

(K-7)

SW CORNER SEC. 13

FOUND PK NAIL

46.85' SE TO THE CENTERLINE TOP OF HYDRANT

47.62' NW TO A NAIL WITH DISK IN THE NE FACE OF A U. POLE

55.11' SW TO A NAIL IN A 24" MAPLE

58.00' SE TO A PK NAIL IN A 30" WALNUT

(L-6)

CENTER POST SEC 13

FOUND #19835

33.00' SOUTH TO #30085

32.06' SE TO A NAIL IN A 6" OAK

29.40' NE TO A PK NAIL IN A 6" OAK

27.66' NNW TO A PK NAIL IN AN 18" ASH

(L-7)

S 1/4 CORNER SEC 13

FOUND 1/2" BAR

33.04' N TO 30085

93.30' NW TO CHISLED MARK ON THE TOP OF AN 18" CMP

43.94' SW TO A CHISLED "X" ON THE TOP OF CURB @ EAST END OF RET.

24.19' NE TO A MAG NAIL IN THE SE FACE OF A MAILBOX POST

SURVEYOR'S CERTIFICATE

I hereby certify that I have surveyed and mapped the land above described on August 2, 2001 and that the ratio of closure on the unadjusted field observations of such survey was no greater than 1/174,114 and that all of the requirements of P. A. 132 1970 have been complied with.

R.A. DUTHLER
LAND SURVEYOR LLC

256 FAIRGROVE
ROMEO, MI 48065
TEL. (810) 752-6423
FAX (810) 336-4719

RICHARD A. DUTHLER
LICENSED LAND SURVEYOR
No. 47200

PREPARED FOR: MR. NIND ALVARADO

JOB# 010802
DATE AUG. 2, 2001
SHEET 2 OF 2

Job: 1996 MACOMB COUNTY REMONUMENTATION PROGRAM FOR WASHINGTON, BRUCE & RAT TWP.

By: HUSTON K. KENNEDY

Point	Direction	Distance	Northing	Easting	Elevation
<i>L-6 ↓ K-6</i>					
Start					
1400			498403.2899	13523278.3280	
IN	S 86°33'21.9" W	2707.460			
1418			498240.6481	13520575.7580	
PO	N 86°33'21.9" E	204.142			
Temporary Intersection Point			498252.9112	13520779.5310	
PO	S 3°26'38.1" E	26.523			
1420			498226.4357	13520781.1243	
Start					
1418		<i>354.73 R.</i>	498240.6481	13520575.7580	
PO	N 86°33'21.9" E	352.922			
Temporary Intersection Point			498261.8487	13520928.0424	
PO	S 3°26'38.1" E	31.058			
1424		<i>33 R.</i>	498230.8467	13520929.9081	
Start					
1418		<i>604.73 R.</i>	498240.6481	13520575.7580	
PO	N 86°33'21.9" E	602.723			
Temporary Intersection Point			498276.8547	13521177.3929	
PO	S 3°26'38.1" E	29.729			
1423		<i>33 R.</i>	498247.1790	13521179.1788	
Start					
1418			498240.6481	13520575.7580	
PO	N 86°33'21.9" E	229.053			
Temporary Intersection Point			498254.4077	13520804.3969	
PO	N 3°26'38.1" W	34.218			
1421			498288.5643	13520802.3413	
Start					
1418			498240.6481	13520575.7580	
PO	N 86°33'21.9" E	532.102			
Temporary Intersection Point			498272.6124	13521106.8990	
PO	N 3°26'38.1" W	35.643			
1422			498308.1913	13521104.7578	
Start					
1418			498240.6481	13520575.7580	

