

REC'D NOV 15 2007 4:00 PM

LAND CORNER RECORDATION CERTIFICATE
Filing Requirement of Act 74, Mich. P.A. 1970

For corners in

MACOMB
(County)

Located in:
HARRISON TWP.

Corner Code #

7158664
LIBER 19067 PAGE 919
11/29/2007 09:06:32 A.M.
MACOMB COUNTY, MI
CARMELLA SABAUGH, REGISTER OF DEEDS

- 1. Public Land Survey T 2N R 14E PC-006
- T R
- 2. Property Controlling S T
- in Section S T
- 3. Miscellaneous S T
- Number
- Property in Sec. S T R

Register of Deeds Stamp & File

- 4. Lot No. _____, Recorded Plat _____
- 5. Private Claims PC-006, Southeast Corner of Private Claim 633 Common w/Southwest Corner of Private Claim 178

I, Steven E. Dunn, in a field survey on May 17, 2007, do hereby certify that under requirements of P.A. 74, Michigan P.A. of 1970, the corner points mentioned in lines 1 and 2 above were in conformance with regulations and rules therefore as required in the current manual of survey instructions of the United States Department of the Interior, Bureau of Land Management or by a decree of a Court of Law and for that the corner points mentioned in lines 3, 4 and 5 above were in conformance with the rules of the Michigan Board of Land Surveyors or by a Decree of a Court of Law; established, re-established, monumented, re-monumented, recovered, found as expressed below:

NOTE: Not more than 2 corners, all in the same town and range, may be recorded on this certificate.

A. Description of original monument and accessories and/or subsequent restoration:
No evidence of original corner found.

- 1906 An iron rod Map of Survey of Louis DeHale Est., Unrecorded, Samuel Crocker.
- 1915 1/2" gas pipe "Lakeshore Gardens", L. 3, P. 1 & 2.
- 1923 Unreadable "Hamon Acres Subd'n.", L. 7, P. 19

B. Description of corner evidence found and/or method applied in restoring or reestablishing corner:
PC 006 Southeast corner of Private Claim No. 633 common with the southwest corner of Private Claim No. 178. No evidence of existing monument found. First, we established the south line of Private Claims 167, 176, 833, 178 and 175 as follows:

We found a concrete monument at the southwest corner of Private Claim 176 and a 1/2" steel rod on the south line of Private Claim 176 (also being the south right-of-way line of Tucker Avenue, 50' wide) at the corner common with Lot No. 165 and 166 of "Lakeside Gardens" as recorded in Liber 2 of Plats on Page 233 (MCR). Field measurement from the concrete monument east to the steel rod is 1053.96', within 0.43' of the calculated record (1053.53'). I then compared monumentation found along the north right-of-way line of Tucker Avenue with the south PC line as established above. The north right-of-way line appears to be parallel with the south PC line but falls ± 2.00' short of the recorded width of Tucker Avenue (± 48.00' measured, 50.00' record). I held the line as established above as the south Private Claim line.

(continued on back)

FIELD MEASUREMENTS AND RECORD MEASUREMENTS (see back):

C. Description of monument for corner and accessories established to perpetuate locating the position of the corner:
PC 006 Southeast corner of Private Claim No. 633 common with the southwest corner of Private Claim No. 178. Set 1/2" steel rod.

I replaced the 1/2" steel rod with a 4" X 36" concrete monument with aluminum disc stamped "Macomb County Monument Mi. Act # 345, PC 006".

WITNESSES:


- N.31°W. 71.95' Southwest corner concrete block footing of wood frame garage.
- North 49.82' Set Mag nail w/Macomb County Witness Tag in east face 20" tree.
- N.87°E. 13.31' Set Mag nail w/Macomb County Witness Tag in northwest face of 10" Hickory.
- N.86°W. 92.01' Set Mag nail w/Macomb County Witness Tag in north face utility pole.
- N.73°W. 162.51' Center top nut of hydrant.
- S.17°W. 46.80' North edge concrete pavement of westbound Metropolitan Parkway @ Station 286.

THE SELECTED LOCATION IS ACCEPTED BY ME AND IS GENERALLY ACCEPTED BY PROFESSIONAL SURVEYORS AS THE BEST AVAILABLE EVIDENCE OF THE POSITION OF THE ORIGINAL CORNER.

ACCEPTED BY THE MACOMB COUNTY SURVEY PEER GROUP AS THE OFFICIAL CORNER UNDER MICHIGAN PUBLIC ACT 345 OF 1990 AT A MEETING HELD ON 6-5-07
Martin C. Dunn
MARTIN C. DUNN, P.S. CHAIRMAN

Signed by Steven E. Dunn
Surveyor's Michigan License No. 28408

Date October 23, 2007

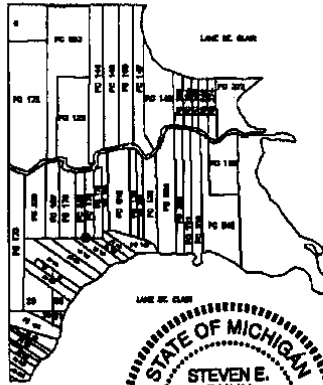

For corners in

MACOMB Located In: Corner Code #
 (County) HARRISON TWP.

1. Public Land Survey T 2N R 14E PC-006
 T R
5. Private Claims PC-006, Southeast Corner of Private Claim 633 Common w/Southwest Corner of Private Claim 178

A. Description of original monument and accessories and/or subsequent restoration:

B. Description of corner evidence found and/or method applied in restoring or reestablishing corner:

PC 006 Southeast corner of Private Claim No. 633 common with the southwest corner of Private Claim No. 178. Set ½" iron rod.

(continued from front)

Using monumentation found along the west right-of-way line of Winkler Street I did a bearing-bearing intersection with the south Private Claim line. Field measurement from PC 005 to the west right-of-way line of Winkler Street extended south to the south PC line is 848.50', within 0.50' of record (849.00'). I then pro-rated the field measurement with the record measurement to re-establish the location of PC 006 and set a ½" steel rod.

FIELD MEASUREMENTS AND RECORD MEASUREMENTS:

PC 006 to PC 005:

585.70' – Record, "Hamon Acres Subd'n".
 585.35' – Field.

PC 006 to PC 008:

1330.29' – Calculated Record, "Lakeshore Gardens".
 1330.18' – Calculated Record, "Winkler's Sub. No. 1".
 1330.29' – Field.

MACOMB COUNTY
INDEX OF SUPPORTING DOCUMENTATION FOR

T. 2 N. R. 14 E.

CORNER CODE PC-006
Southeast Corner PC 633 common with Southwest Corner PC 178

ITEM #	ITEM TYPE	ITEM DATE
1	Standard Atlas – Map of Harrison Township, P. 25	1875
2	Standard Atlas – Map of Harrison Township, P. 33	1895
3(2)	Map – Unrecorded, Samuel Crocker	April, 1906
4(2)	Lakeshore Gardens – L. 3, P. 1 & 2	7-13-1915
5	Standard Atlas – Map of Harrison Township, P. 81	1916
6	Standard Atlas – Map of Lakeshore Gardens and Lakeside Gardens, P. 51	1916
7	“Hamon Acres Subd’n” – L. 7, P. 19	10-31-1923
9(3)	Macomb County, Composites – 12-19F, G & H	2005
10	Field Notes	2-19-2007
11(2)	Field Notes	2-22-2006
12	Field Notes	5-17-2007
13(3)	Before Pictures	5-23-2007
14	Survey Report	5-24-2007

Survey Report
PC 006
SE Cor. PC 633
Common w/SW Cor. PC 178
T.2N., R.14E., Harrison

Letters asking for unrecorded information were sent to:

AEW, Inc. – Shelby Twp.
Fenn & Associates, Inc. - Shelby Twp.
GWE – Rochester Hills
Kennedy Surveying, Inc. - Oxford
Lehner Associates, Inc. – Clinton Twp.
GLA Surveyor – Plymouth
Professional Engineering Assoc. Inc. – Troy
R. J. Donnelly & Associates Inc. – Troy
George Jerome & Company – Roseville
King Surveying, Inc. – Armada
Michigan Surveying Inc. – Livonia
David C. Adams & Son – Redford
Urban Land Consultants – Shelby Township

GENERAL: Traverse points were set and points located then tied in with a Leica System 500 GPS unit. Corners from previous years were shot also and used to apply a scale factor to match the coordinates of the existing corners. Points not able to locate by GPS were side-shot off previously located points with a Leica TCA1103 Electronic Theodolite.

CORNER: Southeast corner of Private Claim No. 633 common with the southwest corner of Private Claim No. 178. No evidence of existing monument found. First, we established the south line of Private Claims 167, 176, 633, 178 and 175 as follows:

We found a concrete monument at the southwest corner of Private Claim 176 and a ½" steel rod on the south line of Private Claim 176 (also being the south right-of-way line of Tucker Avenue, 50' wide) at the corner common with Lot No. 165 and 166 of "Lakeside Gardens" as recorded in Liber 2 of Plats on Page 233 (MCR). Field measurement from the concrete monument east to the steel rod is 1053.96', within 0.43' of the calculated record (1053.53'). I then compared monumentation found along the north right-of-way line of Tucker Avenue with the south PC line as established above. The north right-of-way line appears to be parallel with the south PC line but falls ± 2.00' short of the recorded width of Tucker Avenue (± 48.00' measured, 50.00' record). I held the line as established above as the south Private Claim line.

Using monumentation found along the west right-of-way line of Winkler Street I did a bearing-bearing intersection with the south Private Claim line. Field measurement from PC 005 to the west right-of-way line of Winkler Street extended south to the south PC line is 848.50', within 0.50' of record (849.00'). I then pro-rated the field measurement with the record measurement to re-establish the location of PC 006 and set a ½" steel rod.

5-24-2007

OBSERVATIONS: Field measurement from PC 006 to PC 005 is 585.35', within 0.35' of record (585.70') of "Hamon Acres Subd'n." as recorded in Liber 7 of Plats on Page 19 (MCR).

Field measurement from PC 006 to PC 008 is 1330.47', within 0.18' of calculated record (1330.29') of "Lakeshore Gardens" as recorded in Liber 3 of Plats on Page 1 and 2 (MCR).

RECOMMENDATION: My recommendation to the Peer Review Board is to accept the ½" steel rod as the proper location for the corner.

Respectfully submitted,

Steven E Dunn, PS #28408

07-100 Macdon Co.

PC 006

72.40

R5-12 00000 264.65

220 -194° 56' 53" 11.424
N 31° W 71.95

226 53-48-08 52.685 SW CORNER CORNERS

227 108° 14' 10" 49.82

227 51-45-34 45.949 E. FACE 20" TREE

228 179-31-36 73.986 NW FACE 10" HICKORY

229 350-13-47 81.500 N. FACE VILL. POLE

230 11-79-24 76.251 HYDRANT

230 4-49-45 151.217

231 517° W, 46.880

202-57-41 49.859

@ STATION 286 STAMPED IN CONC.

HARRISON TWP
MACOMB

07-106

- 6 1030 SET PK 2' OFF EAST EDGE
- 8 1031 SET 1/2" I.R. WITH TAU CAP II
- 9 1036 F/D R.R. SPIKE 37865 WINKLER
- 10 1037 F/D CAPED IRON ROD 37854 WINKLER
- 11 1038 F/D 1/2" I-rod NE COR WINKLER 3
- 12 1042 F/D 1/2" I-rod NE COR TUCKER & HAMON
- 13 1043 F/D 1/2" I-rod 37885 HAMON

TC
RD
DD

2-07 FB-520

(6)

OF GAMMEL ROAD (HAZEL) 1 SOUTH OF
30081 SUBJECT


ROUND SPIKE

TUCKER

7

FEB 22, 2007 FS-520
FILE: 022207ITG

FG
RD
00

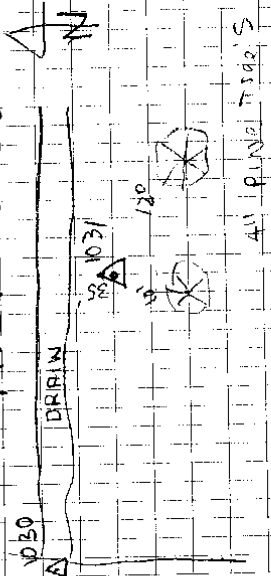

FD 1/2" I.R. B599Z

"1039 - LEARNING RIGHT ON ELEC. POLE"

SOUTH SIDE OF TUCKER
NORTH SIDE TUCKER BETWEEN WINKEL & HAMMON

HAMMON TWP
MACOMB

07-100

7	FD 1021				
8	DS 1030	0-00-00	322.395		
83	1032	11-28-20	268.118	FD 1/2" #5779	
84	1033	150-25-26	137.649	FD 1/2" I.P.	
85	1034	188-06-53	129.186	FD 1/2" I.R.	
86	1035	220-05-25	182.463	FD 1/2" I.R.	

10 RD 1037

85 1038 0-0-00 346.188

87 FS 1039 180-05-19 99.947 F/D 1/2" I.R.

1040

10 1036

10 RD 1038

88 DS 1037 0-0-00 346.177

88 FS 1040 265-30-24 50.262 F/D 1/2" I.R.

10 1012

259-57-25 329.182

89 1041 267-59-27 321.105 "Wood Fence Post"

Ac 520 ①

2-19-2007

S. O. S. T. A. R.

07-100 MACARA Co.
HARRISON TWP.

30 1001 FO. 1/4 Acre w/ 1/4 Town Hall Rd
61' WIDE GREENE AVE.

31 1002 FO. 1/4 1.000 w/ C/O. (SOUTH)
SW COR LOT 159 "CHRYSTIE ACRES"

32 1003 & 33 1004 SET 1/2 1.000 w/ TRAV. C/O'S


1005 FO. 1/4 1.000 w/ C/O. #19836
LOT 41-42 "S.P. No. 1" 60' R/W
(No base G.P.S.)

34 35 1006, 1007 SET 1/4 AC. NAILS
36
1008

37 1009 FO. 1/4 1.000 w/ C/O. # 17641
LOT 125-146 "LORRINE GARDENS"

38 1010 SET 1/4 1.000 w/ TRAV. C/O.
NE QUINCY "TUMBLE"

39 1011 SET 1/4 AC. NAILS NEAR RC 176-1638

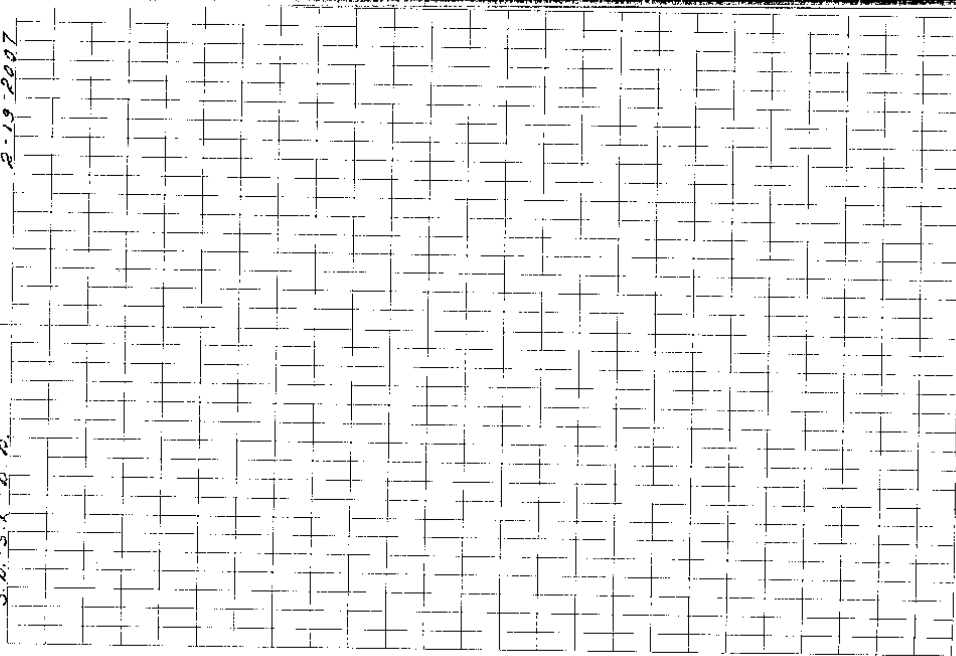

07-100 HARRISON

PG. 633

5-09-2007

HARDON ACRES

CHARTER ACRES SUB

LAKE SHORE GARDENS SUB

WILLOWHILL ST

HARDON AVE.

HARDON AVE.

TUCKER AVE.

5122.15' R.
522.65' N.

2124.95' R.
225.49' N.

46.35'
141.75' R.
112.01' N.

45.37'
264.72' N.

585.70' R.
578.49' N.

848.50' N.
849.00' E.

LAKE SHORE GARDENS SUB

PC 005

PC 006

234.78' N.
234.97' R.

133.96' N.
134.00' R.

179.80' N.
184.00' E.

267.14' E.

2450.82' N.
2451.53' R.



07-100 HARRISON

PC 175-178

5-09-2007



HANNON ACRES SUB.

WINDLEFF'S SUB.

WINDLEFF'S SUB. NO. 1

LAKE SHORE

GARDENS

511,000
4445.53 R
446.02' N

511,000
3445.50' R
346.08' N

3129.00 R
329.48' N

511,000
0.53' E
511,000
0.54' W
511,000
0.27' E

HARRON

HARRON

511,000
264.72' N

511,000
275.90' N

511,000
56.84' WINDLEFF

511,000
58.78' WINDLEFF

267.74' R
TUCKER


268.12' R
ST

535.61' N
530.87' R
PC006

PC007
1330.29' R. CALC.

4361.57' N.
PC008

3299.32' N. → METROPOLITAN PARKWAY
3300.36' R

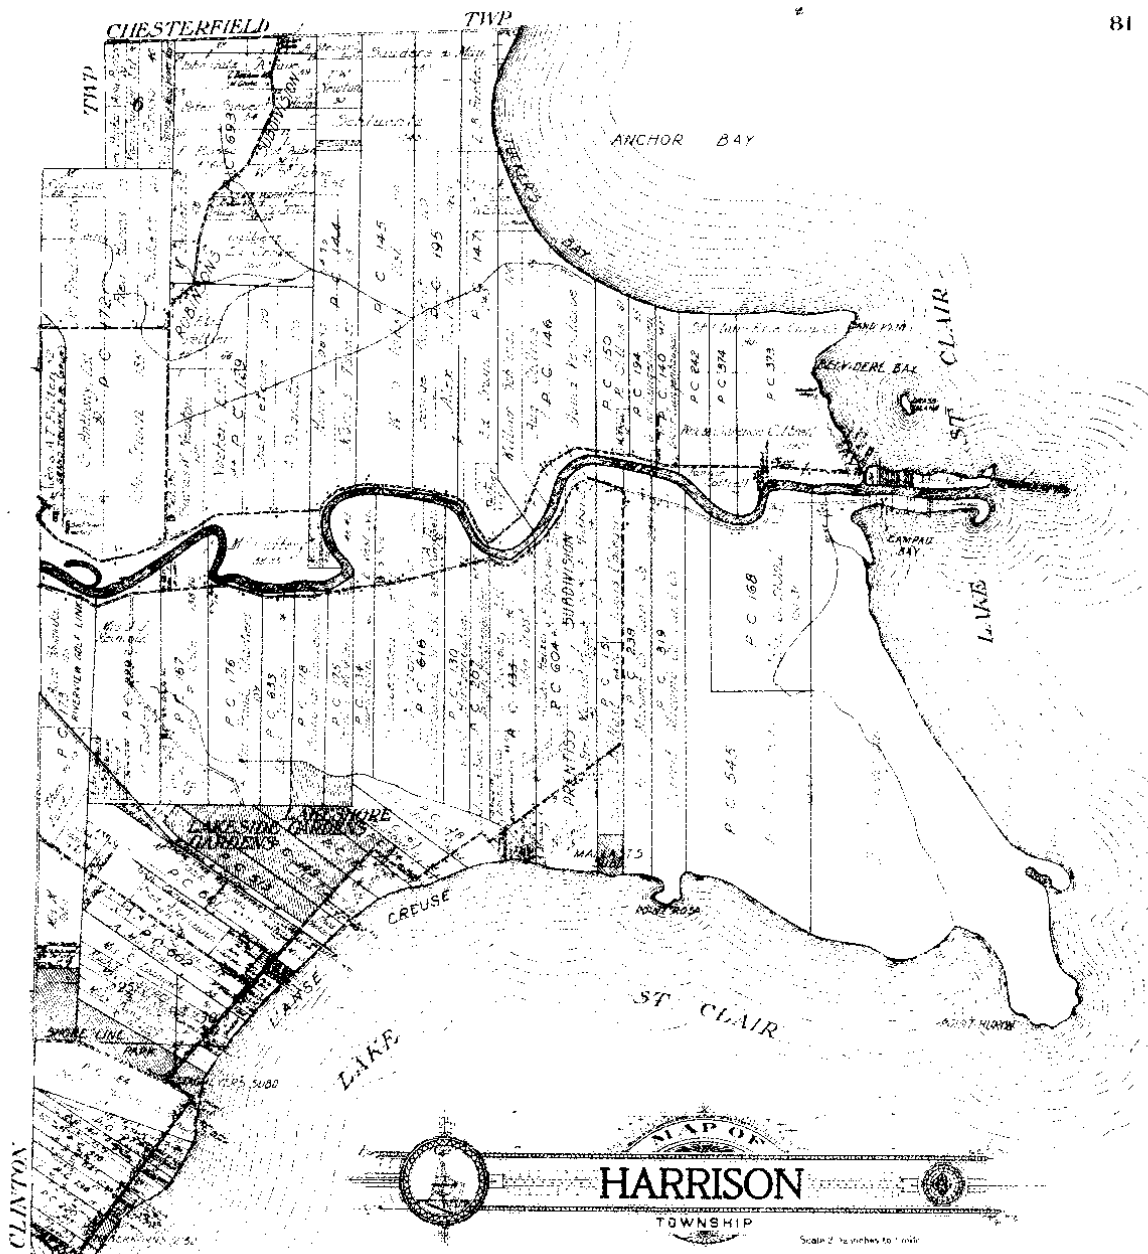

Part of Fractional Township 2 North, Range 13 East and
 Fractional Township 2 North, Range 14 East
 of the Michigan Meridian


South Line of Private Claims
N. 86°-56' W.

S. 3°-09' W. West line
963.7'

Antwine De Hale
13.55 Acres

N. 3°-07' E 616'

W.

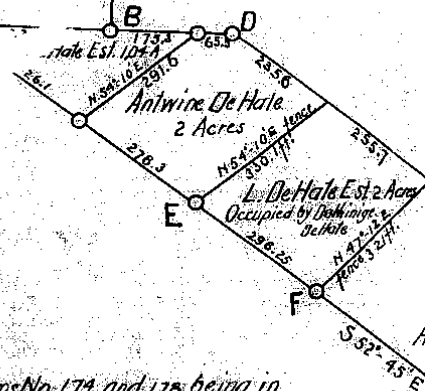

MAP

of Survey of Louis De Hale Est. in Private Claims No. 177 and 178 being in Harrison Tp. Macomb County Michigan, April 1906. The lower tract contains 9.14 acres; the tract occupied by Dominique De Hale contains 2 acres; The three cornered tract contains 1.04 acres; the tract in P.O. 178 south of the Venre De Beuf creek; contains 13.55 acres - total of 25.73 acres


Description of corners

- A - An iron pipe $1\frac{1}{2} \times 48$ - a hickory N. 46°-02' E 14d. 92ft. dist.
a birch 14" diam. N. 3°-08' W. 57ft. dist.
a soft maple 20" N. 74°-32' W. 82.8ft. dist.
- B - an oak stake - D - an oak stake - E - an oak stake
- F - " " - G - an iron pipe $1\frac{1}{4} \times 30$ - H - a gun barrel
- I - an iron rod - J - a gun barrel driven in decayed remains of stake
- D - a hickory 15" diam. S. 40°-52' E 96.8ft. dist.
N. 80°-54' E 147.8 " "

Scale 300ft. = 1 inch



All measurements of bearing trees are to center of tree.

Samuel Crocker Surveyor

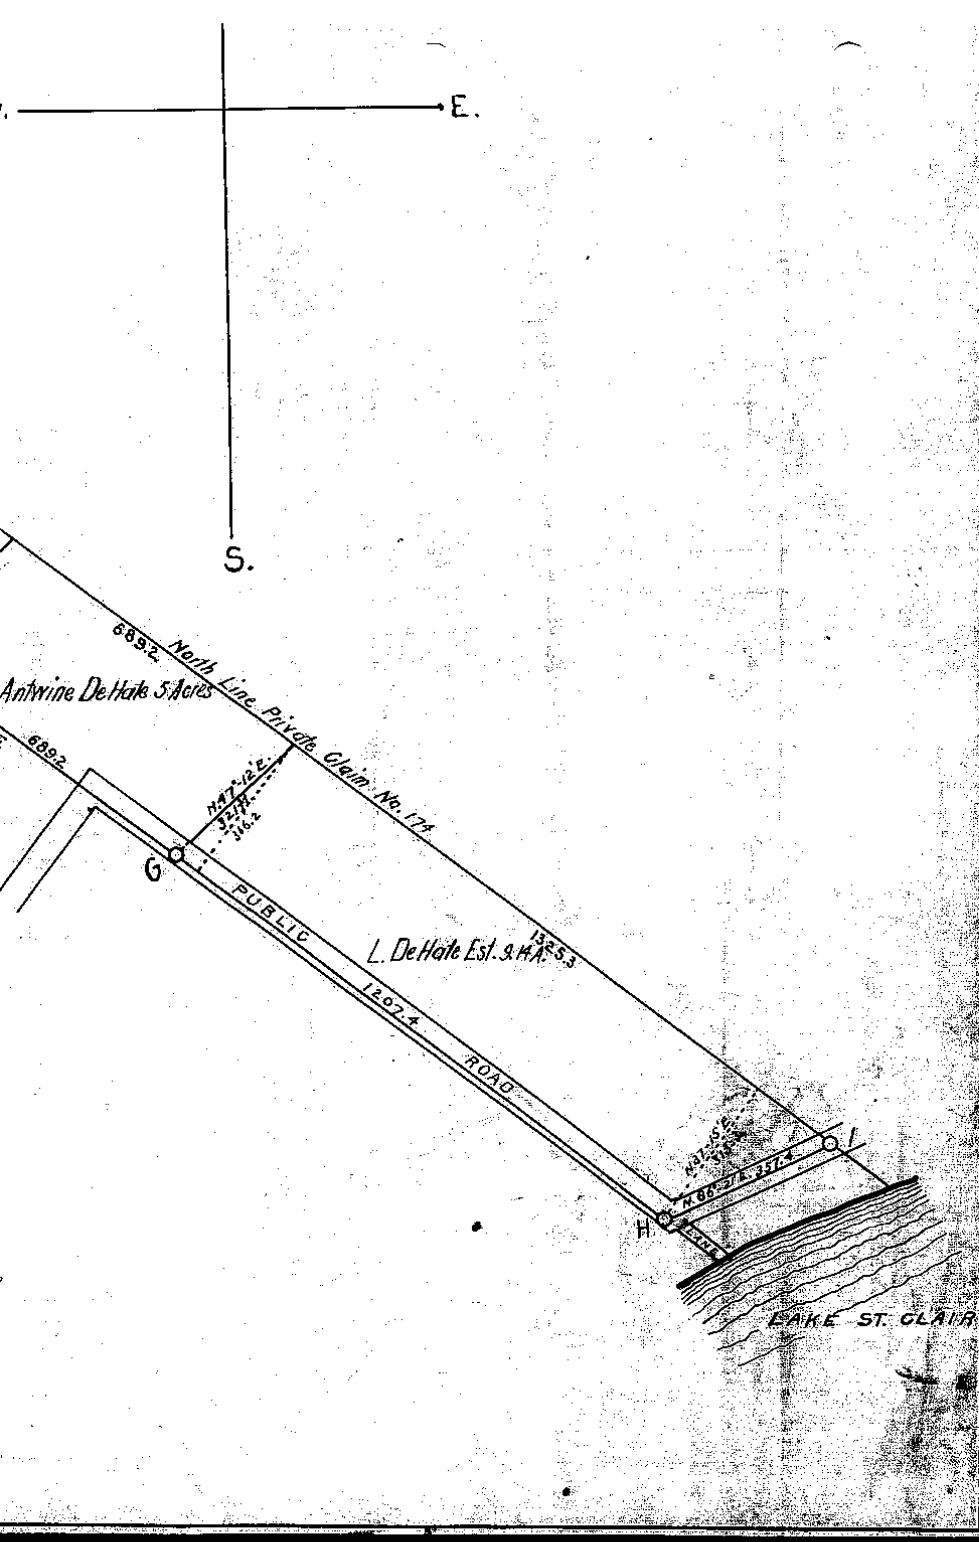

PG 30


3-1

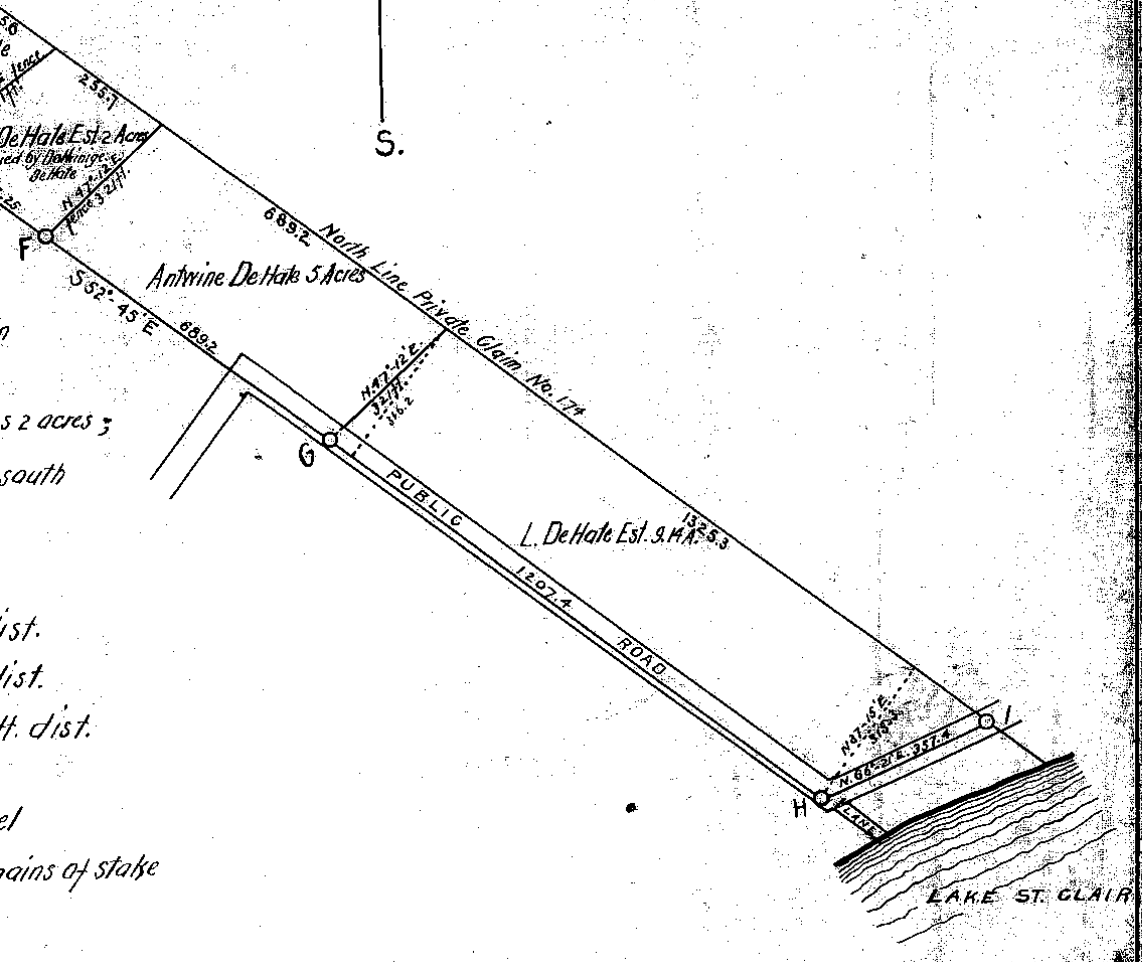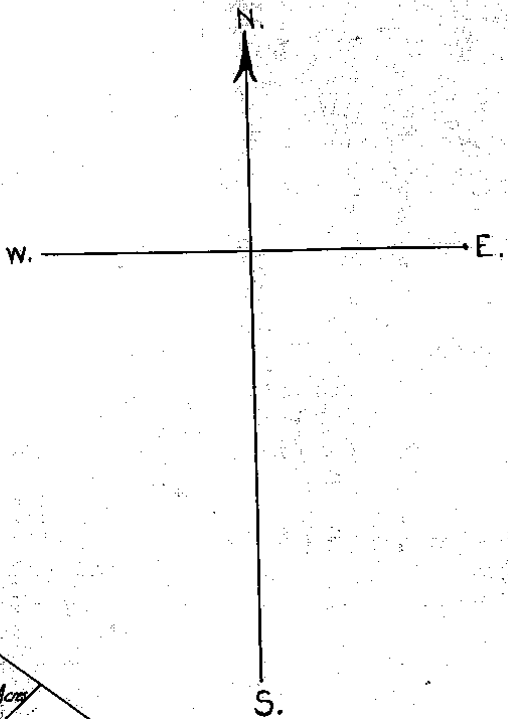

s 2 acres ;
 south
 list.
 list.
 4. dist.
 el
 rains of stake

MAP OF HARRISON

Township 2 North Range 11 East

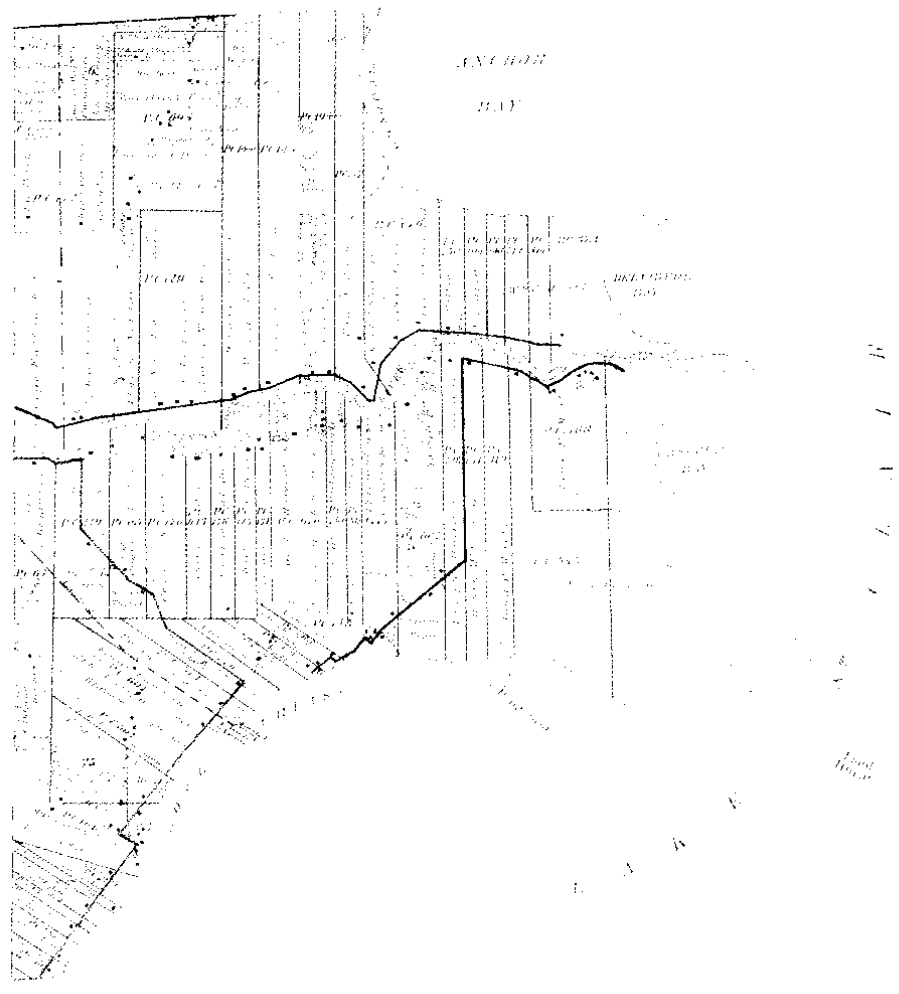

2

1904

"HAMON ACRES SUBDN"


OF P.C. 633 HARRISON TWP.

MACOMB CO., MICH.

Scale = 200 Ft. per inch.

WALTER C. WOODCO
CIVIL ENGINEER,
111 MADISON BLDG.,
DETROIT, MICH.

Examined and
Certified
this 29th day of
Sept. 1923

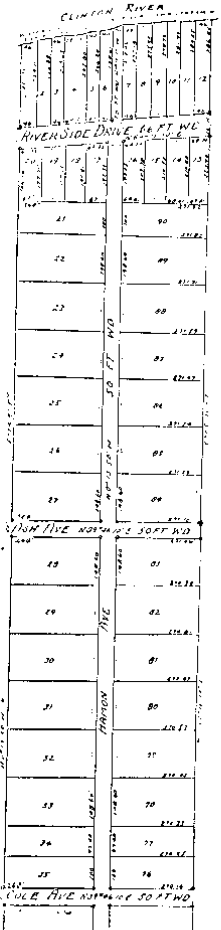

That all lots here shown, together with the streets and roads shown thereon, are the property of the said Harrison Twp. Macomb Co., Mich., and that the same are being offered for sale to the highest bidder, and that the proceeds of the sale shall be used for the purpose of paying the debts of the said Harrison Twp. Macomb Co., Mich., and that the same are being offered for sale to the highest bidder, and that the proceeds of the sale shall be used for the purpose of paying the debts of the said Harrison Twp. Macomb Co., Mich.

WALTER C. WOODCO
CIVIL ENGINEER
111 MADISON BLDG.
DETROIT, MICH.

WALTER C. WOODCO
CIVIL ENGINEER
111 MADISON BLDG.
DETROIT, MICH.

This plan was approved by the Board of Supervisors of Harrison Twp. Macomb Co., Mich. on the 29th day of September 1923.

Walter C. Woodco
Civil Engineer
111 Madison Bldg.
Detroit, Mich.
Sept 1-1923

John H. ...
Hamon Acres Subd.
31
Sept 1923
John H. ...

DESCRIPTIONS
The lots here shown are bounded as follows: ...



LAKESHORE GARDENS

A SUBDIVISION OF PART OF PRIVATE CLAIMS 163, 174, 165, 149, 175 & 178

SHEET NO.
9274

HARRISON TOWNSHIP
MACOMB CO., MICH.

COMPRISING 2 SHEETS
SCALE 200 FT. = 1 IN.

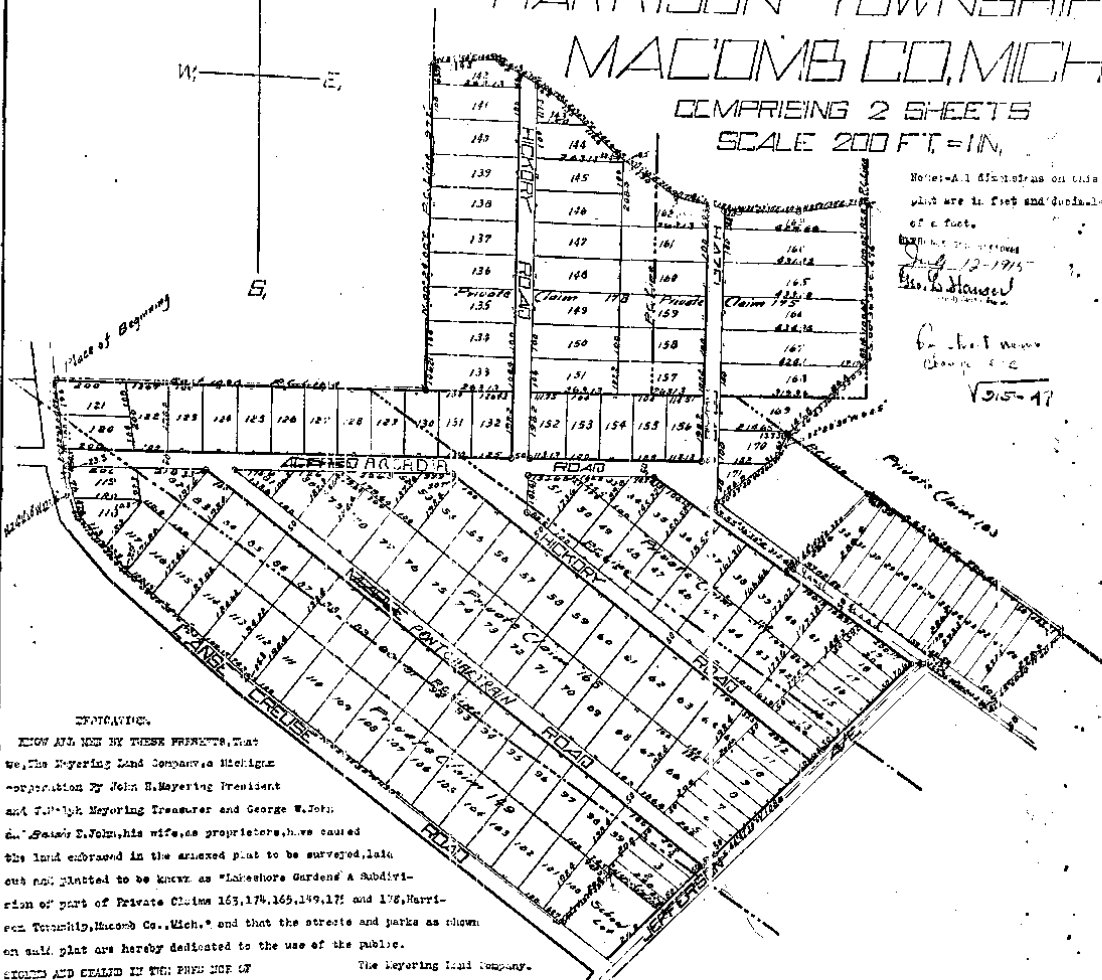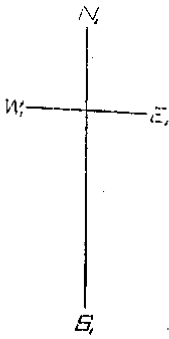

Note: All dimensions on this plat are in feet and fractions of a foot.

Subd. 12-1918
Geo. W. Irwin

Geo. W. Irwin
Notary Public
1918-47

WITNESSETH.
KNOW ALL MEN BY THESE PRESENTS, that we, The Meyerling Land Company, a Michigan corporation, by John H. Meyerling, President and J. Ralph Meyerling, Treasurer and George W. John, Secretary, his wife, as proprietors, have caused this land embraced in the annexed plat to be surveyed, laid out and platted to be known as "Lakeshore Gardens" a subdivision of part of Private Claims 163, 174, 165, 149, 175 and 178, Harrison Township, Macomb Co., Mich., and that the streets and parks as shown on said plat are hereby dedicated to the use of the public.

SIGNED AND SEALED IN THE PRESENCE OF
..... J. W. Verbitz
..... Geo. W. Irwin

The Meyerling Land Company,
John H. Meyerling, President,
J. Ralph Meyerling, Treasurer,
George W. John (L.S.),
Geo. W. John (L.S.)

STATE OF MICHIGAN ss. On this 20th day of April A.D. 1918, before me, a Notary Public in and for said county appeared John H. Meyerling and J. Ralph Meyerling, to me personally known, who being each by me duly sworn did say that they are the President and Treasurer respectively of The Meyerling Land Company, a Michigan corporation, and that the seal affixed to said instrument is the corporate seal of said corporation, and that said instrument was signed and sealed in behalf of said corporation by and that said instrument was signed and sealed in behalf of said corporation by and authority of its Board of Directors and the said John H. Meyerling, President and J. Ralph Meyerling, Treasurer, acknowledged said instrument to be the free act and deed of said corporation.

Geo. W. Irwin
Notary Public, Macomb Co., Mich.

My Commission expires December 29th 1918.

STATE OF MICHIGAN ss. On this 20th day of April A.D. 1918, before me, a Notary Public in and for said county, personally came the above named George W. John and Geo. W. John, his wife. Shows to me to be the persons who executed the above dedication, and acknowledged the same to be their free act and deed.

Geo. W. Irwin
Notary Public, Macomb Co., Mich.

My Commission expires December 29th 1918.

Witness my hand and seal of office this 20th day of April 1918.

John H. Meyerling
J. Ralph Meyerling
Geo. W. John

Geo. W. Irwin
Notary Public, Macomb Co., Mich.

Filed in Public Office of Notary Public, Macomb Co., Mich. on the 20th day of April 1918.

Geo. W. Irwin
Notary Public, Macomb Co., Mich.

LAKE SHORE GARDENS

SHEET NO. 2
9274

A SUBDIVISION OF PART OF PRIVATE CLAIMS 163, 174, 165, 149, 175 AND 178 HARRISON TOWNSHIP MACOMB CO., MICH. COMPRISING 2 SHEETS SCALE 200 FT. = 1 IN.

DESCRIPTION OF LAND PLATTED.

The land embraced in the annexed plat of Lakeshore Gardens A Subdivision of part of Private Claims 163, 174, 165, 149, 175 and 178, Harrison Township, Macomb County, Mich. is described as follows:— Beginning at a point on the easterly line of the L'Anse au Loup Road where the same is intersected by the northerly line of Private Claim 165; thence easterly along the northerly line of Private Claim 165 and Private Claim 174 a distance of ten hundred and ninety (1090) feet to the westerly line of Private Claim 175; thence N. 00° 24' 00" E. along the westerly line of said Private Claim 175 a distance of nine hundred and seventy-two (972) feet to the center of the Verreux DeBoeuf Creek; thence N. 85° 54' 00" E. a distance of one hundred eighty-four and five tenths (184.5) feet; thence S. 12° 25' 30" E. a distance of two hundred eight and seven tenths (208.7) feet; thence S. 43° 19' 30" E. a distance of the hundred forty-four and eight tenths (144.8) feet; thence S. 53° 21' 30" E. a distance of two hundred Twenty-eight and five tenths (228.5) feet; thence S. 77° 46' 30" E. a distance of one hundred and eighty-eight (188) feet; thence E. 85° 22' 30" E. a distance of one hundred and eighty-four (184) feet; thence E. 85° 21' 30" E. a distance of two hundred and eighteen (218) feet to a point where the center of the Verreux DeBoeuf Creek is intersected by the easterly line of Private Claim 175; thence S. 00° 36' 30" E. along the easterly line of Private Claim 175 a distance of four hundred and seventy-four (474) feet; thence N. 40° 45' 30" W. a distance of three hundred twenty and five tenths (320.5) feet; thence S. 22° 29' 30" W. a distance of sixty-two and five tenths (62.5) feet; thence S. 50° 57' 30" W. a distance of two hundred sixty-five and nine tenths (265.9) feet; thence S. 55° 36' 30" E. a distance of three hundred twenty and six tenths (320.6) feet; thence N. 44° 19' 30" E. a distance of three hundred and twenty (320) feet; thence S. 51° 36' 30" E. a distance of seven hundred and twenty-three hundredths (700.23) feet; thence S. 45° 26' 30" W. a distance of three hundred twenty-one and one tenth (321.1) feet; thence S. 55° 56' 30" W. a distance of two hundred eleven and two tenths (211.2) feet; thence S. 41° 47' 30" W. a distance of ten hundred and eighty-six (1086) feet; thence N. 52° 12' 30" W. a distance of two hundred and eight (208) feet; thence S. 04° 27' 30" W. a distance of two hundred nine and one tenth (209.1) feet; thence N. 52° 30' 30" W. a distance of eleven hundred and ninety (1190) feet; thence N. 49° 20' 30" W. a distance of four hundred and eighty-three and three tenths (483.3) feet; thence S. 43° 19' 30" W. a distance of two hundred six and eight tenths (206.8) feet; thence N. 28° 11' 30" W. a distance of one hundred twenty-three and four tenths (123.4) feet; thence E. 7° 40' 00" W. a distance of two hundred seventy-three and seven tenths (273.7) feet to place of beginning.

ENGINEER'S CERTIFICATE.

I do hereby certify that the plat herein delineated is a correct one, and that permanent monuments, consisting of 1" x 2" gas pipe have been planted at points marked thus (S) as thereon shown at all angles & the boundaries of the land platted and at all intersections of streets.

Jno. C. Irwin Civil Engineer.

COUNTY TREASURER'S CERTIFICATE.

Office of County Treasurer, Macomb County,
State of Mich., April 17, 1915.

I DO HEREBY CERTIFY that there are no tax liens or titles held by the State on the lands described above, and that there are no tax liens or titles held by individuals on said lands for the five years preceding the 17th day of April 1915, and that the taxes for said period of five years are paid, as shown by the records of this office.

William M. Kruse County Treasurer.

CERTIFICATE OF TOWN BOARD.

This plat was approved by the Town Board of the Township of Harrison, Macomb County, Michigan at a meeting held April 17, 1915
Edward LeFevre Clerk.

CERTIFICATE OF BOARD OF SUPERVISORS.

This plat was approved by the Board of Supervisors of the County of Macomb and State of Michigan at a meeting held April 20, 1915

Ivy Hulet Chairman,
Geo. A. Dunker Director.