

**LAND CORNER RECORDATION CERTIFICATE**  
**Filing Requirement of Act 74, Mich. P.A. 1970**

For corners in

MACOMB  
 (County)

IRA TOWNSHIP  
 Located In:

Corner Code #

- |                                       |      |             |       |
|---------------------------------------|------|-------------|-------|
| 1. Public Land Survey                 | T    | R           | _____ |
|                                       | T    | R           | _____ |
|                                       | T    | R           | _____ |
|                                       | T    | R           | _____ |
| 2. Property Controlling<br>in Section | S 18 | T 3 N R 15E | 009   |
|                                       | S    | T R         | _____ |
| 3. Miscellaneous<br>Property in Sec.  | S    | T R         | _____ |
|                                       | S    | T R         | _____ |
| 4. Lot No. _____, Recorded Plat _____ |      |             |       |
| 5. Private Claims _____               |      |             |       |


BY THE MACOMB COUNTY SURVEYOR  
 AT THE OFFICIAL CORNER UNDER THE  
 ACT 345 OF 1950 AT A MEETING  
 HELD AT ST. CLAIR, MI  
 12/13/2001

1246435  
 LIBER 11091 PAGE 357  
 12/13/2001 10:50:00 A.M.  
 MACOMB COUNTY, MI  
 CARMELLA SABAUGH, REGISTER OF DEEDS

Register of Deeds Stamp & File Number

I, ROBERT H. BIRKETT, in a field survey on SEPTEMBER 16, 2001 do hereby certify that under requirements of P.A. 74, Michigan P.A. of 1970, the corner points mentioned in lines 1 and 2 above were in conformance with regulations and rules therefore as required in the current manual of survey instructions of the United States Department of the Interior, Bureau of Land Management or by a decree of a Court of Law and /or that the corner points mentioned in lines 3, 4 and 5 above were in conformance with the rules of the Michigan Board of Land Surveyors or by a Decree of a Court of Law; established, re-established, monumented, re-monumented, recovered, found as expressed below:

**NOTE: Not more than 2 corners, all in the same town and range, may be recorded on this certificate.**

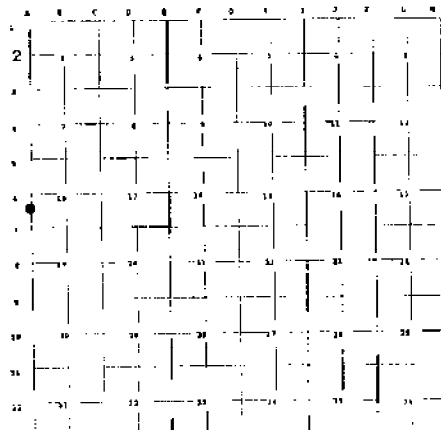

A. Description of original monument and accessories and/or subsequent restoration:  
 CHESTERFIELD AND IRA TOWNSHIP LINE NEAR LAKE ST. CLAIR.  
 1818, W. PRESTON, G. L. O., 12" BEECH  
 UNDATED, ANDERSON & ASSOCIATES, UNRECORDED LOT SURVEY  
 1953, "ASSESSORS PLAT OF HIGHVIEW SUB", J. LEHNER, L. 29 OF PLATS, P. 12, M.C.R.

B. Description of corner evidence found and/or method applied in restoring or reestablishing corner:  
 CHESTERFIELD AND IRA TOWNSHIP LINE NEAR LAKE ST. CLAIR.  
 FOUND 1/2" IRON ON THE SOUTH RIGHT OF WAY LINE OF MAIN STREET.

**FIELD MEASUREMENTS**  
 TO THE INTERSECTION OF THE SOUTHERLY LINE P. C. 614 AND THE TOWNSHIP LINE.  
 1818, G. L. O. - 2259.18' (34.23 CH)  
 2001, REMON - 1563.91'

C. Description of monument for corner and accessories established to perpetuate locating the position of the corner:  
 CHESTERFIELD AND IRA TOWNSHIP LINE NEAR LAKE ST. CLAIR.  
 REPLACED 1/2" IRON WITH 1/2" X 36" RE-BAR ENCASED IN CONCRETE CAPPED WITH AN ALUMINUM CAP STAMPED  
 "MACOMB COUNTY MONUMENT, MI ACT 345, P. C. C.41094."

- AZ. 45° 57.72' SET REMON TAG IN NORTHWEST FACE UTILITY POLE.
- AZ. 235° 39.03' SET REMON TAG IN NORTHEAST FACE MULTIPLE 10" MAPLE.
- AZ. 250° 39.70' SET REMON TAG IN NORTHEAST FACE UTILITY POLE.
- AZ. 335° 11.96' CENTER TOP HYDRANT.



THE SELECTED LOCATION IS ACCEPTED BY ME AND IS GENERALLY ACCEPTED BY PROFESSIONAL SURVEYORS AS THE BEST AVAILABLE EVIDENCE OF THE POSITION OF THE ORIGINAL CORNER.

Signed by Robert H. Birkett Date 11-30-01  
 Surveyor's Michigan License No. 41094