

**LAND CORNER RECORDATION CERTIFICATE**  
 Filing Requirement of Act 74, Mich. P.A. 1970

For corners in


MACOMB (County)	Located in: Clinton Township	Corner Code #
1. Public Land Survey	T <u>2N</u> R <u>13E</u>	<u>A-1</u>
	T _____ R _____	_____
	T _____ R _____	_____
	T _____ R _____	_____
2. Property Controlling In Section	S _____ T _____ R _____	_____
	S _____ T _____ R _____	_____
3. Miscellaneous Property in Sec.	S _____ T _____ R _____	_____
	S _____ T _____ R _____	_____

Register of Deeds Stamp & File Number

4. Lot No. \_\_\_\_\_, Recorded Plat \_\_\_\_\_  
 5. Private Claims \_\_\_\_\_

I, Randy Kolehouse, in a field survey on November 20 19 94, do hereby certify that under requirements of P.A. 74 Michigan P.A. of 1970, the corner points mentioned in lines 1 and 2 above were in conformance with regulations and rules therefore as required in the current manual of survey instructions of the United States Department of the Interior, Bureau of Land Management or by a decree of a Court of Law and/or that the corner points mentioned in lines 3, 4 and 5 above were in conformance with the rules of the Michigan Board of Land Surveyors or by a Decree of a Court of Law; established, re-established, monumented, re-monumented, recovered, found, as expressed below:

NOTE: Not more than 4 corners, all in the same town and range, may be recorded on this certificate.

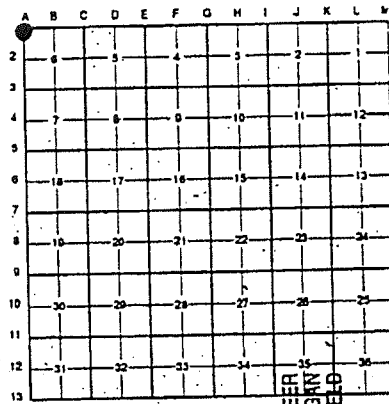

A. Description of original monument and accessories and/or subsequent restoration:

A-1.	1817	G.L.O. Notes	Preston	N/A	Post
	1934	MCRRC Notes	N/A	N/A	Placed Iron at "+" in Pavement
	1974	L.C.R.C. L. 2500 P. 794 & MDOT Notes	Jones	#2934	1" Iron Rod in Mon. Box
	1978	L.C.R.C. L. 2940 P. 349	Patterson	#17631	Iron in Mon. Box
	1979	Cert. Survey L. 3208 P. 664	Titsworth	#17637	1" Iron in Mon. Box
	1979	L.C.R.C. L. 3184 P. 575	Fenn	#23505	1/4" Iron in Mon. Box
	1980	D.E. Co. Notes	N/A	N/A	Mon. Box
	1986	L.C.R.C. L. 4080 P. 891	Avey	#30076	1/2" Bar in Mon. Box
	1986	L.C.R.C. L. 4131 P. 656	Griggs	#23511	Monument Box with Rod
	1991	L.C.R.C. L. 5290 P. 290	Avey	#30076	1/2" Bar in Mon. Box
	1993	L.C.R.C. L. 6161 P. 237	Antcliff	#25826	Macomb Co. Remon. Marker

ACCEPTED BY THE MACOMB COUNTY SURVEY PEER GROUP AS THE OFFICIAL CORNER UNDER MICHIGAN PUBLIC ACT 345 OF 1980 AT A MEETING HELD ON 12-13-94  
*William E. Soderberg*  
 WILLIAM E. SODERBERG, P.S., CHAIRMAN

B. Description of corner evidence found and/or method applied in restoring or reestablishing corner:

A-1 Previous remonumentation iron and cap have been destroyed during M-59 reconstruction. Reset iron in an existing monument box from one witness L.C.R.C. L. 6161 P. 237 ("+" NE bolt sign base S 43° E 99.57') and recorded distances South and East.

Measures East to B-13 = 2086.38' (L.C.R.C. L. 3184 P. 575 = 2086.41') (L.C.R.C. L. 4790 P. 790 = 2086.54)  
 (MDOT = 2086.49') (AEW 1992 = 2086.47')  
 Measures South to A-2 = 2703.12' (MDOT = 2703.12') (AEW 1992 = 2703.15')


C. Description of monument for corner and accessories established to perpetuate locating the position of the corner:

A-1 I set a 3/4" x 24" iron rod w/2" diameter aluminum cap stamped "Macomb County Monument MI Act 345 #25854" in an existing monument box.

PK & Macomb Co. Remon. Tag W Edge Conc. Walk N 58° E 70.76'  
 "+" NE Bolt Sign Base S 43° E 99.57'  
 PK & Macomb Co. Remon. Tag SE Face Util. Pole S 36° W 100.68'  
 PK & Macomb Co. Remon. Tag C/L Conc. Walk N 60° W 61.47'

The selected location is accepted by me and is generally accepted by professional surveyors as the best available evidence of the position of the original corner.

Signed by Randy J. Kolehouse Date 12/16/94  
 Surveyor's Michigan License No. 25854

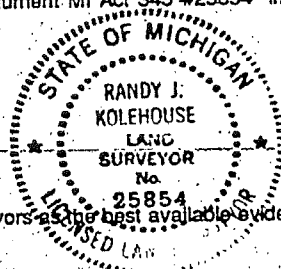

LAND CORNER RECORDATION CERTIFICATE

B997887

Filing Requirement of Act 74, Mich. P.A. 1970 93 DEC 22 AM 9: 04

For corners in

MACOMB  
(County)

Located In: Corner Code #

CLINTON TWP

- |                                    |                          |            |
|------------------------------------|--------------------------|------------|
| 1. Public Land Survey              | T <u>2N</u> R <u>13E</u> | <u>A-1</u> |
|                                    | T _____ R _____          | _____      |
|                                    | T _____ R _____          | _____      |
|                                    | T _____ R _____          | _____      |
| 2. Property Controlling in Section | S _____ T _____ R _____  | _____      |
|                                    | S _____ T _____ R _____  | _____      |
| 3. Miscellaneous Property in Sec.  | S _____ T _____ R _____  | _____      |
|                                    | S _____ T _____ R _____  | _____      |

CARMELLA SABAUGH  
REGISTER OF DEEDS  
MACOMB COUNTY, MI

LIBER 06161 PG 237

Register of Deeds Stamp & File Number

4. Lot No. \_\_\_\_\_, Recorded Plat \_\_\_\_\_  
5. Private Claims \_\_\_\_\_

I, BRUCE ANTCLIFF, in a field survey on NOVEMBER 22, 19 93, do hereby certify that under requirements of P.A. 74, Michigan P.A. of 1970, the corner points mentioned in lines 1 and 2 above were in conformance with regulations and rules therefore as required in the current manual of survey instructions of the United States Department of the Interior, Bureau of Land Management or by a decree of a Court of Law and/or that the corner points mentioned in lines 3, 4 and 5 above were in conformance with the rules of the Michigan Board of Land Surveyors or by a Decree of a Court of Law; established, re-established, monumented, re-monumented, recovered, found as expressed below:

A	B	C	D	E	F	G	H	I	J	K	L	M
2	6	5	4	3	2	1						
3												
4	7	8	9	10	11	12						
5												
6	18	17	16	15	14	13						
7												
8	19	20	21	22	23	24						
9												
10	30	29	28	27	26	25						
11												
12	31	32	33	34	35	36						
13												


**NOTE: Not more than 4 corners, all in the same town and range, may be recorded on this certificate.**

A. Description of original monument and accessories and/or subsequent restoration:

- |   |  |   |
|---|--|---|
| GLO-Post, NO WITS. REMAIN                     | LCRC (1986) L4080,P891-1/2" BAR IN MON BOX   | LCRC (1991) L5290,P290-1/2" BAR/MON BOX |
| MCRC (1934) PLACED IRON-NO WITS REMAIN        | NW BOLT SIGN POST BASE, SE, 98.66'           | MDOT N&T SE SIDE PP, WSW, 85.64'        |
|   | SE BOLT SIGN POST BASE, SW, 108.37'          | PK SE SIDE PP, SSW, 86.53'              |
| MDOT & LCRC (1974) L2500,P794-1" IRON/MON BOX | MCRC N&T SE FACE GUY POLE, NE, 62.29'        | PK SW SIDE PP, NW, 96.53'               |
| POWER POLE, N30W, 68.30'                      | CONC. NAIL NW FACE UTIL POLE, NW, 68.23'     | PK NW SIDE PP, NE, 91.80'               |
| POWER POLE, S25W, 91.98'                      |  |   |
| TEL. POLE, N25E, 61.00'                       | LCRC (1987) L4131,P656-ROD IN MON BOX        | MDOT (1990)-1/2" IRON IN MON BOX        |
|   | N&T IN UTIL POLE, N05E, 59.47'               | MDOT N&T IN GUY POLE, N30E, 62.40'      |
| EDISON FIELD NOTES (1980)-MON BOX             | N&T IN UTIL POLE, N60E, 118.10'              | MDOT N&T IN GUY POLE, N30W, 68.35'      |
| NAIL IN POLE, N45E, 62.4'                     | PK IN UTIL POLE, S50E, 92.30'                | NE BOLT SIGN BASE, S40E, 99.58'         |
| NAIL IN POLE, N45W, 68.1'                     |  | MDOT N&T IN PP, S60W, 85.54'            |
| NAIL IN POLE, S45W, 91.8'                     | THIS CORNER IS COMMON TO ALL FOUR TOWNSHIPS. |   |

B. Description of corner evidence found and/or method applied in restoring or reestablishing corner:  
FOUND 1/2" BAR/MON. BOX


FOUND AND VERIFIED ONE OF THE ABOVE WITNESSES

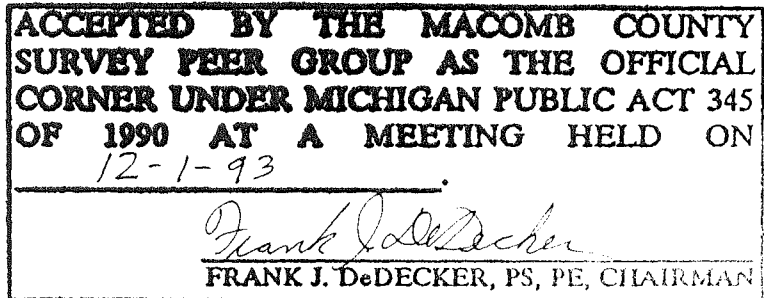

C. Description of monument for corner and accessories established to perpetuate locating the position of the corner:

SET MACOMB COUNTY REMONUMENTATION MARKER AND CAP #25826 IN EXIST. MON. BOX.  
WITNESSES

- FND NE BOLT SIGN BASE, S47E, 99.57'
- SET N&T - PK & MC TAG IN SE FACE P POLE, S57W, 85.85'
- SET N&T - PK & MC TAG IN SW FACE P POLE, N44W, 83.59'
- SET N&T - PK & MC TAG IN N FACE P POLE, S68E, 149.67'

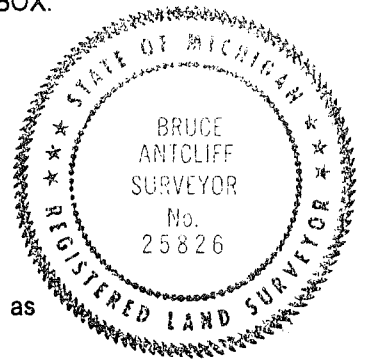

The selected location is accepted by me and is generally accepted by Professional Surveyors as the best available evidence of the position of the original corner.

Signed by Bruce Antcliff

Date 12-9-93

Surveyor's Michigan License No. 25826


11/22/93

T 2 N, R 12 E M-13

HALL ED. & HAYES

T BS 0-00-00 MAG. NORTH

	HOR. $\angle$	H. D.	CALC. BEARING	CALC. DIST
FND. 1/2" BAR / MON. BOX	311° 41' 07"	72.07'		
FND. NE BOLT SIGN BASE, S 40° E	136° 39' 52"	27.58'	S 47° E	99.57
SET N&T- PK & MC TAG IN SE <sup>FACE</sup> P. POLE S 70° W	270° 23' 03"	125.61'	S 57° W	85.85
SET - " - " " SW FACE P. POLE N 50° W	313° 41' 50"	154.58'	N 44° W	82.59
SET " " " " N FACE P. POLE S 75° E	95° 04' 50"	85.51'	S 68° E	149.67

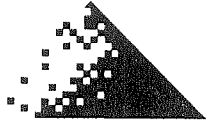

Date: 11-16-93

Client: MC REMON

Project No.: 92528

T3N, R12E

CORNER M-13

1817 GLO - S $\frac{1}{4}$  36 to SE 36 = 2640

SE 36 to E $\frac{1}{4}$  36 = 2640

1993 WWES -

CORNER M-13

GLO - POST

1987 LCRC - MON BOX WITH ROD

1991 LCRC -  $\frac{1}{2}$ " BAR IN MON BOX

1993 WWES -

Road File No. \_\_\_\_\_

File Point No. \_\_\_\_\_

Date Filed

6-29-1939

Assessment District No.

90

Station No.

210+38.12

Township

Clinton Sterling

Section Corner

NE Sec 5 T2N  
NW Sec 6 C1416

Type of Surface

Width

Description of Monument

X in Pav't


Drilled & iron placed 3/16

Monument in Relation to Center Line of Pavement

WITNESSES:

- |    |                      |    |       |
|----|----------------------|----|-------|
| 1. | Spike in DE Guy Pole | NW | 46.15 |
| 2. | " " Tel. " "         | NE | 39.15 |
| 3. | " " DE Pole          | SE | 58.8  |
| 4. |                      |    |       |

T2N, R12E  
M-1

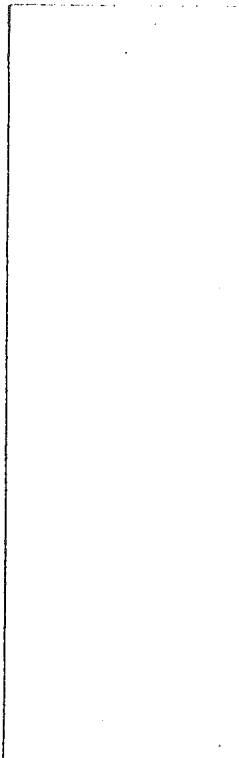

CORNER. Connou  
TO SEC.  
36, 31, 1, 6



N87-35-25E  
2886.49

S 1/4 cor 31

E 1/4 cor SEC 1  
T21N R12E


Form 280  
(Rev. 11/67)

GOV'T. MONUMENT WITNESSES RECORD

CO. MACOMB TWP. STERLING

T. 2N R. 2E SEC. NO. 1

DESCRIPTION

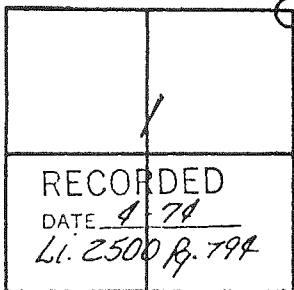

N.E. COR. SEC. 1  
FOUND 1" ROD IN MON.  
BOX AT INTERSECTION  
OF M-59 & HAYES RD.

WITNESSES

N30°W - 68.30' - PWR. POLE  
S25°W - 91.98' - PWR. POLE  
N25°E - 61.00' - TEL. POLE

C.L. Lindgren  
SURVEY CHIEF

14098

2-26-74

REG. NO. M-1 DATE

LAND CORNER RECORDATION CERTIFICATE  
Filing Requirement of Act 74, Mich. P.A. 1970

For corners in

Macomb  
(County)

Located In: Sec. 36 Corner Code ##  
Shelby Township

RECORDED IN MACOMB COUNTY  
RECORDS AT: 8:37A .R.

JAN - 6 1992

CLERK - REGISTER OF DEEDS  
MACOMB COUNTY, MICHIGAN

Register of Deeds Stamp & File Number

- 1. Public Land Survey      T 3N R 12E      M-12  
                                   T 3N R 12E      M-13  
                                   T     R            \_\_\_\_\_  
                                   T     R            \_\_\_\_\_
- 2. Property Controlling    S     T     R            \_\_\_\_\_  
    in Section                S     T     R            \_\_\_\_\_
- 3. Miscellaneous            S     T     R            \_\_\_\_\_  
    Property in Sec.         S     T     R            \_\_\_\_\_

- 4. Lot No. \_\_\_\_\_, Recorded Plat \_\_\_\_\_
- 5. Private Claims \_\_\_\_\_

	A	B	C	D	E	F	G	H	I	J	K	L	M
2	6		5		4		3		2		1		
3													
4	7		8		9		10		11		12		
5													
6	18		17		16		15		14		13		
7													
8	19		20		21		22		23		24		
9													
10	30		29		28		27		26		25		
11													
12	31		32		33		34		35		36		
13													

I, Warren C. Avey, in a field survey on December 10, 1991, do hereby certify that under requirements of P.A. 74, Michigan P.A. of 1970, the corner points mentioned in lines 1 and 2 above were in conformance with regulations and rules therefore as required in the current manual of survey instructions of the United States Department of the Interior, Bureau of Land Management or by a decree of a Court of Law and/or that the corner points mentioned in lines 3, 4 and 5 above were in conformance with the rules of the Michigan Board of Land Surveyors or by a Decree of a Court of Law; established, re-established, monumented, re-monumented, recovered, found as expressed below:

NOTE: Not more than 4 corners, all in the same town and range, may be recorded on this certificate.

A. Description of original monument and accessories and/or subsequent restoration:

B. Description of corner evidence found and/or method applied in restoring or reestablishing corner:

M-12 Found 1/2" Bar in Mon. Box

M-13 Found 1/2" Bar in Mon. Box

C. Description of monument for corner and accessories established to perpetuate locating the position of the corner:

M-13 85.64' W.S.W. to form nail in MDOT Shiner S.E. side P. Pole  
86.53' S.S.W. to PK nail in S.E. side P. Pole  
96.53' N.W. to PK nail in S.W. side P. Pole  
91.80' N.E. to PK nail in N.W. side P. Pole

M-12 67.96' S.W. to nail in MDOT shiner S.E. side P. Pole  
77.11' S.E. to PK nail, N.E. side P. Pole  
87.66' N.E. to form nail in MDOT shiner S.E. side P. Pole  
2677.07' South to 1/2" bar in Mon. Box



Signed by Warren C. Avey Date December 10, 1991  
Surveyor's Michigan License No. 30076



LAND CORNER RECORDATION CERTIFICATE  
Filing Requirement of Act 74, Mich. P.A. 1970

For corners in  
Macomb

Country	Located In:	Corner Code #/
Public Land Survey	Sec. 36 T 3N R 12E	M-12
	Sec. 36 T 3N R 12E	M-13
	Sec. 1 T 2N R 12E	L-1
Property Controlling in Section	T R	
	S T R	
Miscellaneous Property in Sec.	S T R	
	S T R	

Register of Deeds Stamp & File Number

Lot No. \_\_\_\_\_, Recorded Plat \_\_\_\_\_  
Private Claims \_\_\_\_\_

Dennis A. Griggs in a field survey on September 30, 1986, hereby certify that under requirements of P.A. 74, Michigan P.A. of 1970, the corner points mentioned in lines 1 and 2 above were in conformance with regulations and rules therefore as required in the current manual of survey instructions of the United States Department of the Interior, Bureau of Land Management or by a decree of a Court of Law and/or that the corner points mentioned in lines 3, 4 and 5 above were in conformance with the rules of the Michigan Board of Land Surveyors or by a Decree of a Court of Law; established, re-established, monumented, re-monumented, recovered, found as expressed below:

NOTE: Not more than 4 corners, all in the same town and range, may be recorded on this certificate.

Description of original monument and accessories and/or subsequent restoration:

	A	B	C	D	E	F	G	H	I	J	K	L	M
2	6	5	4	3	2	1							
3													
4	7	8	9	10	11	12							
5													
6	18	17	16	15	14	13							
7													
8	19	20	21	22	23	24							
9													
10	30	29	28	27	26	25							
11													
12	31	32	33	34	35	36							
13													

RECORDED IN MACOMB COUNTY  
RECORDS AT: 9:32A M.


FEB 17 1987

*Edna Hill*

CLERK - REGISTER OF DEEDS  
MACOMB COUNTY, MICHIGAN

Description of corner evidence found and/or method applied in restoring or reestablishing corner:

- East 1/4 corner of Section 36 - found monument box with rod.
- Southeast corner of Section 36 - found monument box with rod.
- North 1/4 corner of Section 1 - found P.K. nail.

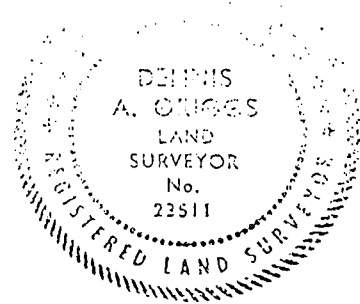

Description of monument for corner and accessories established to perpetuate locating the position of the corner:

- |   |  |   |
|---|--|---|
| East 1/4 Corner:                              | Southeast Corner:                              | North 1/4 Corner:                                 |
| P.K. nail 28" maple -<br>S 84° W - 43.35'     | Nail & tag in power pole -<br>S 25° W = 92.00' | Nail & tag in utility pole -<br>N 05° E - 59.47'  |
| P.K. nail in 12" oak -<br>S 45° W - 62.95'    | Nail & tag in power pole -<br>N 25° E - 60.95' | Nail & tag in utility pole -<br>N 60° E - 118.10' |
| P.K. nail in power pole -<br>S 15° E - 64.10' | Nail & tag in power pole -<br>N 30° W - 68.10' | P.K. nail in utility pole -<br>S 50° E - 92.30'   |

Signed by Dennis A. Griggs Date 1/27/87

Surveyor's Michigan License No. 23511

01261

4080 891  
4080 891

LAND CORNER RECORDATION CERTIFICATE  
Filing Requirement of Act 74, Mich. P.A. 1970

For corners in City of Sterling  
Macomb Heights  
County:

Located In: Sec. 1 Corner Code #

1	Public Land Survey	T .2N	R .12E.	L-1
		T .2N	R .12E.	M-1
		T	R	
		T	R	
2.	Property Controlling in Section	S	T	R
		S	T	R
3.	Miscellaneous Property in Sec.	S	T	R
		S	T	R

8090934

Register of Deeds Stamp & File Number

4. Lot No. \_\_\_\_\_ Recorded Plat \_\_\_\_\_  
5. Private Claims \_\_\_\_\_

A	B	C	D	E	F	G	H	I	J	K	L	M
2	6	5	4	3	2	1						
3												
4	7	8	9	10	11	12						
5												
6	18	17	16	15	14	13						
7												
8	19	20	21	22	23	24						
9												
10	30	29	28	27	26	25						
11												
12	31	32	33	34	35	36						
13												

I, Warren C. Avey in a field survey on September 25, 19 86, do hereby certify that under requirements of P.A. 74, Michigan P.A. of 1970, the corner points mentioned in lines 1 and 2 above were in conformance with regulations and rules therefore as required in the current manual of survey instructions of the United States Department of the Interior, Bureau of Land Management or by a decree of a Court of Law and/or that the corner points mentioned in lines 3, 4 and 5 above were in conformance with the rules of the Michigan Board of Land Surveyors or by a Decree of a Court of Law, established, re-established, monumented, re-monumented, recovered, found as expressed below

NOTE: Not more than 4 corners, all in the same town and range, may be recorded on this certificate.

A Description of original monument and accessories and/or subsequent restoration:

B. Description of corner evidence found and/or method applied in restoring or reestablishing corner:

L-1 Found P.K. Nail in c/l of Pvm't.

M-1 Found 1/2" Bar in Monument Box

RECORDED IN MACOMB COUNTY  
RECORDS AT: 9:40 A M.

DEC - 1 1986

*Edna Hubbell*

CLERK - REGISTER OF DEEDS  
MACOMB COUNTY, MICHIGAN

C. Description of monument for corner and accessories established to perpetuate locating the position of the corner:

L-1 59.39' N.NE to Form Nail in MDSH Disc in W. Face D.E. Pole  
118.33' NE to Conc. Nail in SE face D.E. Pole  
92.34' SE to P.K. Nail in SW face D.E. Pole  
75.47' S.SE to NE Cor of Steel Light Pole Base

M-1 98.66' SE to NW Bolt of Sign Post Base  
108.37' SW to SE Bolt of Sign Post Base (AMCCO)  
62.29' NE to Form Nail in MCRC Disc in SE Face Guy Pole  
68.23' NW to Conc. Nail in NW Face Utility Pole



Signed by Warren C. Avey

Date September 26, 1986.

Surveyor's Michigan License No. 30076

01250

LAND CORNER RECORDATION CERTIFICATE

FILING REQUIREMENT OF ACT 74, MICH. P.A.1970

		Macomb			
FOR CORNERS OF--: Sec. 31		LOCATED IN--Twp.		CORNER CODE NUMBER	
1. PUBLIC LAND SURVEY	T. 3	N. 13	E. 13	A-12, A-13	
		W.	W.		
2. PROPERTY CONTROLLING IN SECTION	T. _____	N. _____	E. _____		
		S. _____	W. _____		
3. MISCELLANEOUS PROPERTY IN SECTION	T. _____	N. _____	E. _____		
		S. _____	W. _____		
4. LOT NO. _____	, RECORDED PLAT _____				
5. PRIVATE CLAIMS _____					

A624077

RECORDED IN MACOMB COUNTY RECORDS AT: 2:44 P.M.

NOV 21 1979

*Edna Hill*  
CLERK - REGISTER OF DEEDS  
MACOMB COUNTY, MICHIGAN

REGISTER OF DEEDS STAMP AND FILING NUMBER

I, John R. Fenn, do hereby certify that under requirements of P.A. 74, Michigan P.A. of 1970, the corner points mentioned in lines 1 and 2 above were, in a field survey on October 11, 1979, established, re-established, monumented, re-monumented, recovered or restored as expressed below and in conformance with regulations and rules therefore as required in the current manual of survey instructions of the United States Department of the Interior, Bureau of Land Management or by a decree of a court of law. Furthermore, that the corner points mentioned in lines 3, 4 and 5 above were, in a field survey on October 11, 1979, found, recovered, restored, established or re-established as expressed below and in conformance with the rules of the Michigan State Board of Registration for Land Surveyors or, by a Decree of a Court of law:


A. Description of original monument and accessories and/or subsequent restoration:

B. Description of corner evidence found and/or method applied in restoring or re-establishing corner:

A-12 1/2" ReRod in mon. box  
A-13 1/4" Iron in mon. box

C. Description of monument for corner and accessories established to perpetuate locating the position of the corner:

A-12	E 23.33 Nail & tag M.D.S.H. in DE pole	A-13	NE 62.40 nail & Tag M.D.S.H. M.B.T. pole
	SW 51.70 PK nail 10" Wild cherry		SE 101.40 PK nail MBT pole
	WNW 39.95 PK nail 10" Maple		SW 92.00 Nail & tag M.D.S.H. De pole
	NW 68.83 PK nail 26" Maple		NW 68.15 Nail & tag M.D.S.H. DE pole
	S 2615.14 Iron		N 2615.14 Iron
	E 2080.10 Pipe		E 2086.41 PK nail

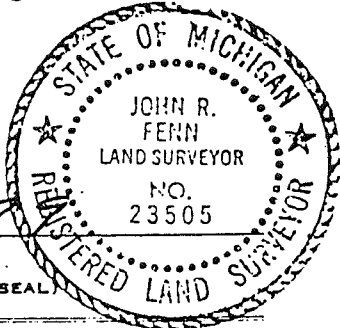

SIGNED BY John R. Fenn

DATE 10-5-79

SURVEYOR'S MICHIGAN REGISTRATION NO. 23505

FOR STATE AND UNITED STATES AGENCIES:

SIGNED BY \_\_\_\_\_ DATE \_\_\_\_\_  
CHIEF OF SURVEY PARTY

APPROVED AND SIGNED BY \_\_\_\_\_ DATE \_\_\_\_\_  
MICHIGAN REGISTERED LAND SURVEYOR

SURVEYOR'S MICHIGAN REGISTRATION NO. \_\_\_\_\_

LAND CORNER RECORDATION CERTIFICATE

FILING REQUIREMENT OF ACT 74, MICH. P.A.1970

A495071

MACOMB TWP. FOR CORNERS OF-- SEC. 31 LOCATED IN-- CORNER CODE NUMBER

1. PUBLIC LAND SURVEY \_\_\_\_\_ T. 3 N. K. R. 13 J. XX A-13, B-13, A-12

2. PROPERTY CONTROLLING IN SECTION \_\_\_\_\_ T. \_\_\_\_\_ N. S. R. \_\_\_\_\_ E. W. \_\_\_\_\_

3. MISCELLANEOUS PROPERTY IN SECTION \_\_\_\_\_ T. \_\_\_\_\_ N. S. R. \_\_\_\_\_ E. W. \_\_\_\_\_

4. LOT NO. \_\_\_\_\_, RECORDED PLAT \_\_\_\_\_

5. PRIVATE CLAIMS \_\_\_\_\_

RECORDED IN MACOMB COUNTY RECORDS AT: 1:09 P.M. MAY - 2 1978

*Edna H. Hill*  
CLERK - REGISTER OF DEEDS  
MACOMB COUNTY, MICHIGAN

REGISTER OF DEEDS STAMP AND FILING NUMBER

I, Robert J. Patterson, do hereby certify that under requirements of P.A. 74, Michigan P.A. of 1970, the corner points mentioned in lines 1 and 2 above were, in a field survey on March 17, 1978, established, re-established, monumented, re-monumented, recovered or restored as expressed below and in conformance with regulations and rules therefore as required in the current manual of survey instructions of the United States Department of the Interior, Bureau of Land Management or by a decree of a court of law. Furthermore, that the corner points mentioned in lines 3, 4 and 5 above were, in a field survey on \_\_\_\_\_, 19\_\_\_\_, found, recovered, restored, established or re-established as expressed below and in conformance with the rules of the Michigan State Board of Registration for Land Surveyors or, by a Decree of a Court of law:

A. Description of original monument and accessories and/or subsequent restoration:

A-13, (S.W. Corner) Found Iron in Monument Box - C.L. of Hall Road & Hayes Road, No Data Available.  
B-13, (S.1/4 Corner) set P.K. Nail in the Centerline of Hall Road & Tilch Road.  
A-12, (W.1/4 Corner) Found Iron in Monument Box - L. 2500 P. 798 M.C.R.

B. Description of corner evidence found and/or method applied in restoring or re-establishing corner:

A-13, Iron in Monument Box matched previous Surveys and Legal Descriptions.  
B-13, P.K. Nail, matched previous Surveys and Legal Descriptions.  
A-12, Iron in Monument agrees in part K.C. Jones\*02934.

C. Description of monument for corner and accessories established to perpetuate locating the position of the corner:

A-13, witness points - Found Nail & Tag (MDSH) in util. pole N E'ly 60.95 Ft.; Found Nail & Tag (MDSH) in util. pole S W'ly 92.00 Ft.; Found Nail & Tag (MDSH) in util. pole N W'ly 68.10 Ft.  
B-13, witness points - Found Nail & Tag in util. pole N E'ly 61.62 Ft.; set P.K. Nail in 12" Tree S E'ly 112.18 Ft.; Set P.K. Nail in util. pole N W'ly 117.72 Ft.  
A-12, witness points - Found Nail & washer in util. pole E'ly 23.32 Ft.; set P.K. Nail in 12: Tree S W'ly 51.67 Ft.; set P.K. Nail in 8" Tree N W'ly 39.98 Ft.

SIGNED BY Robert J. Patterson DATE 3/23/78


SURVEYOR'S MICHIGAN REGISTRATION NO. 17631 (SEAL)

FOR STATE AND UNITED STATES AGENCIES:

SIGNED BY \_\_\_\_\_ DATE \_\_\_\_\_  
CHIEF OF SURVEY PARTY

APPROVED AND SIGNED BY \_\_\_\_\_ DATE \_\_\_\_\_  
MICHIGAN REGISTERED LAND SURVEYOR

SURVEYOR'S MICHIGAN REGISTRATION NO. \_\_\_\_\_

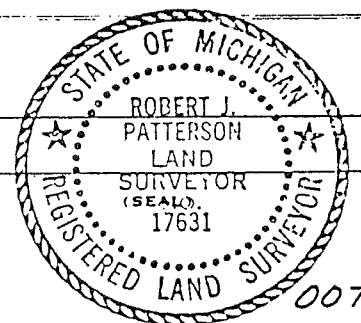

# LAND CORNER RECORDATION CERTIFICATE

FILING REQUIREMENT OF ACT 74, MICH. P.A. 1970

LIBER **2500** PAGE **794**

A245637

FOR CORNERS OF--	LOCATED IN--	CORNER CODE NUMBER
1. PUBLIC LAND SURVEY _____	T. <u>2N</u> N. S., R. <u>12E</u> E. W.	<u>M-1</u>
2. PROPERTY CONTROLLING IN SECTION _____	T. _____ N. S., R. _____ E. W.	_____
3. MISCELLANEOUS PROPERTY IN SECTION _____	T. _____ N. S., R. _____ E. W.	_____
4. LOT NO. _____, RECORDED PLAT _____		
5. PRIVATE CLAIMS _____		

RECORDED IN MACOMB COUNTY  
RECORDS AT: 1:00 P M

MAY 23 1974

*Edna J. Mills*

CLERK - REGISTER OF DEEDS  
MACOMB COUNTY, MICHIGAN

REGISTER OF DEEDS STAMP AND  
FILING NUMBER

I, N.C. Jones do hereby certify that under requirements of P.A. 74, Michigan P.A. of 1970, the corner points mentioned in lines 1 and 2 above (identified with circles on index code diagram - over) were, in a field survey on Feb 26 1974, established, re-established, monumented, re-monumented, recovered or restored as expressed below and in conformance with regulations and rules therefore as required in the current manual of survey instructions of the United States Department of the Interior, Bureau of Land Management or by a decree of a court of law. Furthermore, that the corner points mentioned in lines 3, 4 and 5 above were, in a field survey on \_\_\_\_\_ 19\_\_\_\_, found, recovered, restored, established or re-established as expressed below and in conformance with the rules of the Michigan State Board of Registration for Land Surveyors or, by a Decree of a Court of law:

A. Description of original monument and accessories and/or subsequent restoration:

B. Description of corner evidence found and/or method applied in restoring or re-establishing corner:

Found 1" Iron Rod in Monument Box at the Intersection of M-59 and Hayes Road.

C. Description of monument for corner and accessories established to perpetuate locating the position of the corner:  
1" Iron Rod in Monument Box.

N30W	68.30'	Power Pole
S25W	91.98'	Power Pole
N25E	61.00'	Telephone Pole

SIGNED BY \_\_\_\_\_ DATE \_\_\_\_\_

SURVEYOR'S MICHIGAN REGISTRATION NO. \_\_\_\_\_ (SEAL)

FOR STATE AND UNITED STATES AGENCIES:

SIGNED BY Clifford E. Lindgren DATE Feb 26, 1974  
CHIEF OF SURVEY PARTY

APPROVED AND SIGNED BY [Signature] DATE 4/17/74  
MICHIGAN REGISTERED LAND SURVEYOR  
Michigan Department of State Highways (SEAL)



SURVEYOR'S MICHIGAN REGISTRATION NO. 03934

00419

STERLING HEIGHTS  
 STAKING POLE LINE IN SEC. 1

1-16-80  
 R. TERRY  
 J. SPARROW  
 C. JACOBS

T24 RIZE  
 M-1  
 M-2

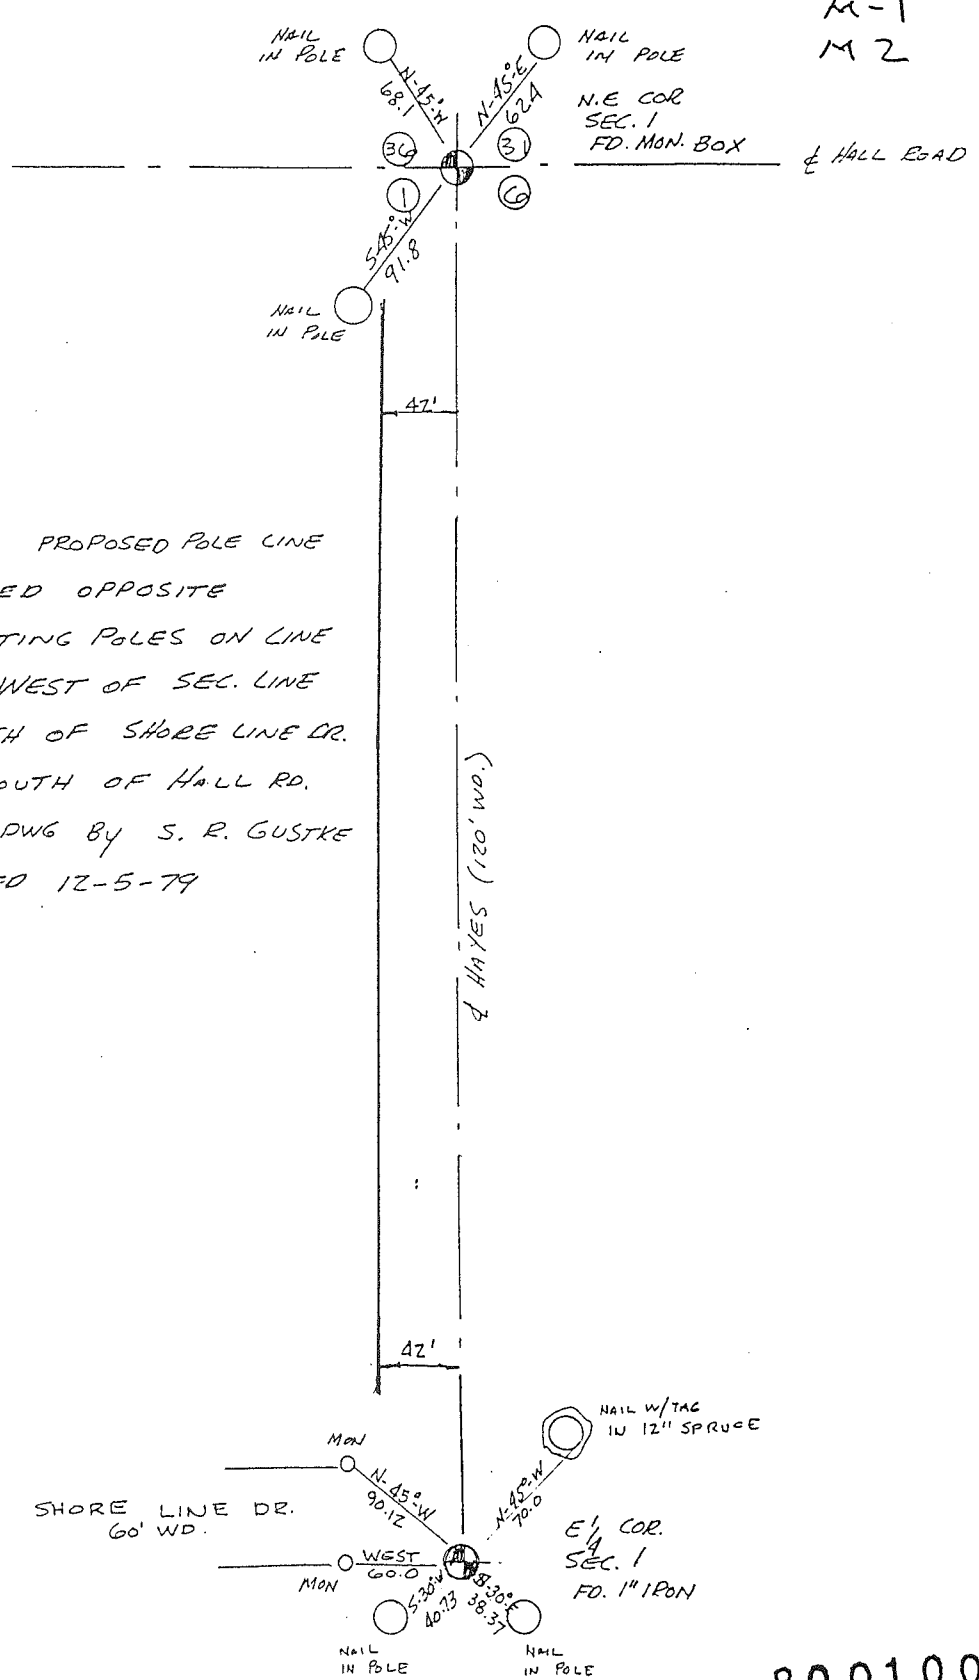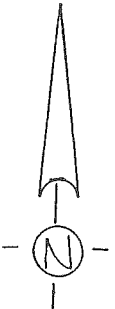

NOTE: PROPOSED POLE LINE  
 STAKED OPPOSITE  
 EXISTING POLES ON LINE  
 42' WEST OF SEC. LINE  
 NORTH OF SHORE LINE DR.  
 & SOUTH OF HALL RD.  
 PER DWG BY S. R. GUSTKE  
 DATED 12-5-79

8001003



1/4 COR. SEC. 1  
T2L, R12 E. CITY OF  
STERLING HEIGHTS,  
MACOMB COUNTY,  
MICHIGAN.

1187°-09'-09"E  
73.67'

POINT OF  
BEGINNING

EASTBROOK DR. 86' WD.  
1187°-50'-51"W 394.50'

Scale 1" = 200'

RAD. 999.36'  
Δ 25°-52'-46"  
CHD. 165.25'  
CHD. 89.04'  
1109°-08'-32"E

1121°-01'-55"E  
23.67'

RAD. 704.56'  
Δ 16°-25'-17"  
CHD. 89.04'  
CHD. BEG. 1157°-31'-12"W

PROPOSED PRIVATE  
ESMT FOR PUBLIC UTILITIES

T2N, R12E

L-1  
M-1

1149°-17'-03"N 190.71'  
RAD. 704.56'  
Δ 07°-24'-05"  
CHD. 102.82'  
CHD. BEG. 1145°-54'-56"W

FOUND IRON  
- SET IRON - CAPPED RLS - 17637

10' PRIVATE ESMT. AS RECORDED  
IN LIBER 2565 PAGE 947-949  
MACOMB COUNTY RECORDS.

1/2 HALL RD. (M-59) 60' WD.  
1187°-09'-09"E 928.53'

PROPOSED PRIVATE ESMT.  
FOR PUBLIC UTILITIES

NORTH LIE OF SEC. 1  
1649.99'  
502°-50'-51"E 150.32'

33' PRIVATE ESMT. AS RECORDED IN  
LIBER 2830, PAGE 885-892  
MACOMB COUNTY RECORDS.

50' PRIVATE ESMT. AS  
RECORDED IN LIBER 2808,  
PAGE 825-853 MACOMB  
COUNTY RECORDS.

14.153 ACRES

8' PRIVATE ESMT.  
AS RECORDED IN  
LIBER 2623, PAGE 207  
MACOMB COUNTY RECORDS.

LAKE WOOD DRIVE 70' WD.  
549°-39'-31"N 449.00'  
L. 112 P. 27 THRU P. 40  
LAKE WOOD DRIVE 70' WD.  
549°-39'-31"N 449.00'

1145°-09'-29"N 11.51'  
Δ 01°-22'-26"  
CHD. 29.59'

RAD. 1234.06'  
Δ 01°-22'-26"  
CHD. 29.59'  
CHD. BEG. 550°-51'-44"W

7.7  
11/4/1980

PA. 1980, and the date of return 11/4/1980.

PROPOSED PRIVATE ESMT.  
FOR PUBLIC UTILITIES

502°-50'-51"E 150.32'  
1649.99'

RAD. 490.24'  
Δ 12°-16'-18"  
CHD. 104.80'  
CHD. BEG. 503°-17'-18"W

535°-34'-32"E 11.22'

PROPOSED PRIVATE ESMT  
FOR PUBLIC UTILITIES.

RAD. 498.24'  
Δ 39°-30'-18"  
CHD. 336.77'  
CHD. BEG. 530°-05'-22"W

WITNESSES

1/4 COR. SECTION 1  
S. 15', W. 57.43' POWER POLE  
N. 05', E. 59.47' TELE. POLE  
N. 30', E. 63.88 9" PEAR TREE  
SOUTH 60' COLC. MON.

L.E. COR. SEC. 1  
1" IRON 1/4" MON. BOL  
L. 30', W. 68.30' P. POLE  
S. 25', W. 91.98' P. POLE  
L. 25', E. 61.00' TELE. POLE

RECORDED IN MACOMB COUNTY  
RECORDS AT 2:36 P. M.  
OCT 4 1980

*John A. Johnson*  
REGISTER OF DEEDS  
MACOMB COUNTY, MICHIGAN

**JOHNSON & ANDERSON INC.**  
CONSULTING ENGINEERS  
PONTIAC, MICHIGAN 48056



PARCEL OF LAND IN LIE 1/4 SEC. 1  
TOWN 2 NORTH, RANGE 12 EAST  
CITY OF STERLING HEIGHTS,  
MACOMB COUNTY, MICHIGAN

DATE	9-30-79	BY	J.K.M.	PLC.	7014-00
FILE NO.	11633	BOOK	11633	PAGE	1 OF 2

