

LAND CORNER RECORDATION CERTIFICATE
 Filing Requirement of Act 74, Mich. P.A. 1970

For corners in

<u>MACOMB</u> (County)	Located in: Clinton Township	Corner Code # _____
1. Public Land Survey	T <u>2N</u> R <u>13E</u>	<u>B-1</u>
	T _____ R _____	_____
	T _____ R _____	_____
	T _____ R _____	_____
2. Property Controlling In Section	S _____ T _____ R _____	_____
	S _____ T _____ R _____	_____
3. Miscellaneous Property in Sec.	S _____ T _____ R _____	_____
	S _____ T _____ R _____	_____
4. Lot No. _____, Recorded Plat _____		
5. Private Claims _____		


Register of Deeds Stamp & File Number

I, Randy Kolehouse, in a field survey on November 20 19 94, do hereby certify that under requirements of P.A. 74 Michigan P.A. of 1970, the corner points mentioned in lines 1 and 2 above were in conformance with regulations and rules therefore as required in the current manual of survey instructions of the United States Department of the Interior, Bureau of Land Management or by a decree of a Court of Law and/or that the corner points mentioned in lines 3, 4 and 5 above were in conformance with the rules of the Michigan Board of Land Surveyors or by a Decree of a Court of Law; established, re-established, monumented, re-monumented, recovered, found as expressed below:

NOTE: Not more than 4 corners, all in the same town and range, may be recorded on this certificate.

A. Description of original monument and accessories and/or subsequent restoration:

B-1	1817	G.L.O. Notes	Preston	N/A	Post
	1992	Cert. Survey Unrecorded	Soderberg	#17635	N/A

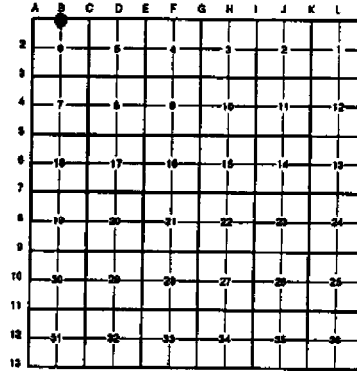

B. Description of corner evidence found and/or method applied in restoring or reestablishing corner:

B-1 No evidence of a previous corner point was found. Corner removed during 1994 construction of M-59. Reset corner on line between B-13 and C-13 of T3N R13E Macomb Township using AEW distance of 592.21' per AEW survey in Section 6 T2N R13E. This point falls on line of tree row running South.

Measures East to C-1 = 2666.86' (AEW = 2666.87)
 Measures East to C-13 = 2072.05' (AEW = 2072.00')
 Measures West to B-13 = 592.21' (AEW = 592.21)
 Measures West to A-1/A-13 = 2678.58' (AEW = 2678.68')

ACCEPTED BY THE MACOMB COUNTY SURVEY PEER
 GROUP AS THE OFFICIAL CORNER UNDER MICHIGAN
 PUBLIC ACT 345 OF 1990 AT A MEETING HELD
 ON 12-13-94

William T. Soderberg
 WILLIAM T. SODERBERG, SURVEYOR

C. Description of monument for corner and accessories established to perpetuate locating the position of the corner:

B-1 I set a 3/4" x 24" iron rod w/2" diameter aluminum cap stamped "Macomb County Monument MI Act 345 #25854" in a new monument box.

PK & Macomb Co. Remon. Tag Top Curb N Side Eastbound M-59 N 22° E 35.95'
 "+ " in Sta. Stencil "408+00" S Side Eastbound M-59 S 63° E 112.90'
 PK & Macomb Co. Remon. Tag SW Face Util. Pole S 31° E 84.04'
 "+ " in Sta. Stencil "407+00" S Side Eastbound M-59 S 02° E 31.08'
 PK & Macomb Co. Remon. Tag NW Face Util. Pole S 70° W 169.93'

The selected location is accepted by me and is generally accepted by professional surveyors as the best available evidence of the position of the original corner.



Signed by Randy J. Kolehouse Date 12/16/94
 Surveyor's Michigan License No. 25854