
MACOMB COUNTY 2016 REMONUMENTATION GRANT PROGRAM FOR CLINTON TOWNSHIP D-04

Section One

Index

Pictures in the four cardinal directions; found monumentation and after setting the required monumentation.

Section Two

Surveyor's Report

Land Corner Recordation Certificate

Section Three

1-3. Field Notes

4. Map of Clinton Township – 1875

5. Map of Clinton Township – 1895

6. Map of Clinton Township – 1916

7. Map of Clinton Township – 2006

8. Macomb County Composite Map 11-08B

9. Macomb County Composite Map 11-08C

10. Macomb County Composite Map 11-08F

11. Macomb County Composite Map 11-08G

Section Four

1. Certificate of Survey L. 2357, Pages 391-392, Pages one and two of two

2. "EAST WINDS SUBDIVISION NO. 2", Liber 68, Pages 1-2, Sheets one and two of two

3. Land Corner Recordation Certificate, L. 2900, Page 936, Page one of one

4. "EDWARD SCHULTZ SUBDIVISION", Liber 73, Pages 47-48, Sheets one and two of two

5. Certificate of Survey, Liber 3106, Page 715, Page one of one

6. "LEXINGTON SQUARE SUBDIVISION", Liber 76, Pages 30-31, Sheets one and two of two

7. Certificate of Survey, Liber 3461, Page 311, Page one of one

8. Certificate of Survey, Liber 3785, Pages 676-677, Page one and two of two

9. "ALDEN SQUARE SUBDIVISION", Liber 84, Pages 46-49, Sheets one thru three of three

10. "ANDREW'S KNOLL SUBDIVISION", Liber 97, Pages 25-30, Sheets one thru five of five

11. "GREENFIELD VILLA SUBDIVISION", Liber 89, Pages 50-52, Sheets one thru three of three

12. "ANDREW'S KNOLL SUBDIVISION", Liber 116, Pages 37-39, Sheets one thru three of three

**D-04
T2N, R13E
CLINTON
TOWNSHIP**









Part A: Corner History:

- 1.) 1818-Preston, D.S., Center of Section 8 was not monumented during the original government survey
- 2.) 1972-Soderberg, RLS #17635; Certificate of Survey L. 2357, pgs. 391-392 – Fnd a ½" iron, no witnesses
- 3.) 1976-"EAST WINDS SUBDIVISION NO. 2", L. 68, pgs. 1-2
- 4.) 1978-Soderberg, RLS #17635; LCRC, Liber 2900, pg. 936 – Fnd a re-rod
- 5.) 1978-"EDWARD SCHULTZ SUBDIVISION", L. 73, pgs. 47-48
- 6.) 1979-Soderberg, RLS #17635; Certificate of Survey L. 3106, pg. 715 – Fnd an iron, set monument (Liber 2900, Page 936) east and west ¼ line
- 7.) 1980-"LEXINGTON SQUARE SUBDIVISION", L. 76, pgs. 30-31
- 8.) 1982-Smith, RLS #16052; Certificate of Survey L. 3461, pg. 311, previously recorded in Liber 2900, page 936, no witnesses
- 9.) 1985-Stecker, LLS #30103; Certificate of Survey L. 3785, pgs. 676-677 – Fnd a ½" re-rod
- 10.) 1988-"ALDEN SQUARE SUBDIVISION", L. 84, pgs. 46-49
- 11.) 1992-"ANDREWS KNOLL SUBDIVISION", L. 97, pgs. 25-30
- 12.) 1996-"GREENFIELD VILLA SUBDIVISION", L. 89, pgs. 50-52
- 13.) 1996-"ANDREW'S KNOLL SUBDIVISION NO. 2", L. 116, pgs. 37-39

Part B: Surveyor's Report on Perpetuation, Restoration, Reestablishment or Monumentation of Corner:

The Center of Section 8 was not monumented in the original government survey. The center has been perpetuated with a 4" diameter concrete monument with a ½" iron rod that falls 0.3' north of a 4' high chain link fence extending to the east and west.

Monumentation found in the "ALDEN SQUARE SUBDIVISION" and "GREENFIELD VILLA SUBDIVISION" along with the comparison of the recorded distance to the measured distance between the following adjacent public land corners to the north (D-03), south (D-05) west (C-04) and east (E-04) were used to validate the found 4" diameter concrete monument with a ½" iron rod as the best evidence for the Center of Section 8 (D-04) to be perpetuated.

RECORDED, UNRECORDED AND FIELD MEASUREMENTS BETWEEN ADJACENT CORNERS

D-04 to D-03

No GLO

"EAST WINDS SUBDIVISION NO. 2", Liber 68, pages 1-2 = 2676.19 (cal.)
 "EDWARD SCHULTZ SUBDIVISION", Liber 73, pages 47-48 = 2676.32 Ft.
 "GREENFIELD VILLA SUBDIVISION", Liber 89, pages 50-52 = 2676.07 Ft.
 N03°13'42" W 2676.23 Ft. (mea. 2016)

D-04 to D-05

NO GLO

"ALDEN SQUARE SUBDIVISION", Liber 84, pages 46-49 = 2647.79 Ft. (cal.)
 S02°45'35" E 2647.21 Ft. (mea. 2016)

D-04 to C-04


No GLO

"ALDEN SQUARE SUBDIVISION", Liber 84, pages 46-49 = 2706.53 Ft.
 "GREENFIELD VILLA SUBDIVISION", Liber 89, pages 50-52 = 2706.53 Ft.
 S87°36'41" W 2706.28 Ft. (mea. 2016)

D-04 to E-04

No GLO

Certificate of Survey recorded in Liber 3106, page 715 = 2723.53 Ft.
 "ALDEN SQUARE SUBDIVISION", Liber 84, pages 46-49 = 2723.28 Ft.
 "ANDREW'S KNOLL SUBDIVISION", Liber 97, pages 25-30 = 2723.78 Ft.
 "GREENFIELD VILLA SUBDIVISION", Liber 89, pages 50-52 Ft. = 2723.78 Ft.
 "ANDREW'S KNOLL SUBDIVISION NO. 2", Liber 116, page 37-39 = 2723.78 Ft.
 N87°39'48" E 2723.63 Ft. (mea. 2016)

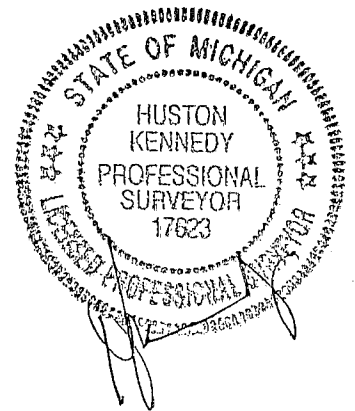


Part C: Field Evidence of Perpetuation or Monumentation of Corner:

D-04 I accepted the found 4" diameter concrete monument with ½" iron rod and placed a 2" diameter aluminum cap stamped "Macomb County Monument, MI Act #345, PS #17623" (D-04) on the found concrete monument

Accessories:

Due West 10.22' Set Mag nail w/washer stamped "Macomb County Witness Tag" south face 12" Oak
 N06°E 44.71' SW corner of house #17760
 N40°E 12.19' Set Mag nail w/washer stamped "Macomb County Witness Tag" SE face 30" Oak
 S31°E 56.55' NE corner of house #17731

I, Huston K. Kennedy, P.S., in a field survey on June 4, 2016, certify under the requirements of the State Survey and Remonumentation Act, 1990 PA 345, MCL 54.261 to 54.279, and the Corner Recordation Act, 1970 PA 74, MCL 54.201 to 54.210d, that the corner identified and described hereon has been perpetuated or monumented as described in Parts A, B, and C above, pursuant to the laws and rules of the State of Michigan.

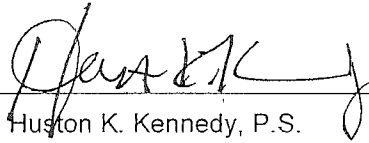

 Huston K. Kennedy, P.S.

September 12, 2016

Date

Professional Surveyor's License No.: 17623

Prepared by:
 Huston K. Kennedy, PS
 105 North Washington Street
 Oxford, Michigan 48371

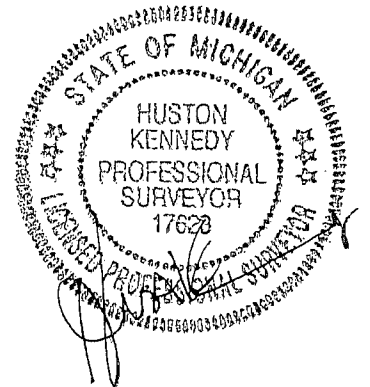

Geodetic Coordinate Data for corner:

Corner Code and Narrative Description: D-04, T02N, R13E


Date of Observation	Latitude	Longitude	Datum and Adjustment Year	Epoch Date
14 June 2016	N42°36'21.078178"	W-82°56'33.338292"	NAD83 (2011)	2010.0000

Method for Latitude-Longitude determination: Dual Frequency Static Observations constraining to the CORS stations of Auburn Hills (AJ5557), Livonia (DK7841) and Brighton (AJ5553), with 3 dimensional least square adjustment.

Disclaimer on accuracy of values reported relative to their use: 1' ±.

State Plane Coordinates in international feet: N-411584.83 E-13506466.38
 Standard Deviation: 0.04 N-0.05 E
 Zone South
 Combined Factor: 0.99989
 NGSPID: = Washington Station (DH 9019)
 Survey Method: GPS C2-II
 Orthometric Height: 599.09
 Elev. Datum: NAVD 88

I, Joseph C. Kapelczak, state under the requirements of the State Survey and Remonumentation Act, 1990 PA 345, MCL 54.261 to 54.279, that the Latitude and Longitude reported hereon were observed by me for the corner identified hereon and that the data reported meets the requirements prescribed for the State Survey and Remonumentation Program.

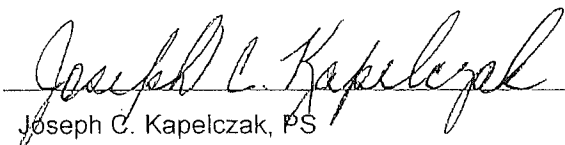
 Joseph C. Kapelczak, PS

SEPT. 12, 2016


Date

Professional Surveyor's License No.: 24598

JCK Group, Inc.
 8615 Richardson Road
 Suite 100
 Commerce Township, MI 48390



I, Martin C. Dunn, state that the corner(s) identified and described hereon and perpetuated or monumented as described in Parts A, B, and C above was presented to and reviewed by the Peer Review Group on July 12, 2016 and is accepted for filing in the Macomb County Remonumentation Program.

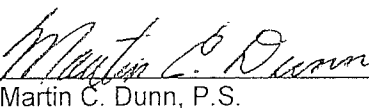
 Martin C. Dunn, P.S.

9-30-2016

Date

Macomb County Surveyor Representative
 License No. 30081

**2016
MACOMB COUNTY REMONUMENTATION
GRANT PROGRAM FOR
CLINTON TOWNSHIP
Research Dossier
D-04**

Prepared by:
Kennedy Surveying, Inc.
105 North Washington Street
Oxford, Michigan 48371

Sources of Information Researched For Macomb County 2016 Remonumentation Grant Program for Clinton Township

- 1) GLO Notes
- 2) Act 74 Recorded LCRC
- 3) Act 132 Recorded Surveys
- 4) Personal History and Records
- 5) LCRC's and Surveys
- 6) Letters to the Following, Requesting Unrecorded information
 - a) Anderson, Eckstein & Westrick
 - b) BMJ Engineers & Surveyors
 - c) Community Engineering & Surveying
 - d) David Little Land Surveyor
 - e) David P. Smith & Associates, Inc.
 - f) Fenn & Associates Surveying, Inc.
 - g) George Jerome & Company
 - h) Grant Ward Surveyors
 - i) Great Lakes Geomatics
 - j) JCK Group, Inc.
 - k) James Land Surveying
 - l) Kem-Tec & Associates
 - m) Kieft Engineering, Inc.
 - n) Lehner Associates, Inc.
 - o) Metco Land Sea Corp.,
 - p) Milletics & Associates
 - q) R. A. Duthler Land Surveyor, LLC
 - r) Reichert Surveying
 - s) R. J. Donnelly & Associates
 - t) Road Commission for Macomb County
 - u) Rowe Professional Services
 - v) Spalding, DeDecker & Associates
 - w) Urban Land Consultants, LLC
 - x) William J. Angus & Associates

D-04 TOWN 02 NORTH, RANGE 13 EAST, CLINTON TOWNSHIP

Recorded and unrecorded surveys, LCRC's, plats and condominium plans that were used to recover and verify the location of D-04.

EXISTING FILED CONDITIONS

Found a 4" diameter concrete monument with a ½" iron rod 0.3' north of a 4' chain link fence line extending to the east and west.

GLO HISTORY

1818 – W. Preston, D.S. The township was divided into sections with closing corners set on the south and east lines of the township. The Center of Section 8 was not monumented during the original government survey.

RECORDED AND UNRECORDED INFORMATION USED TO RECOVER AND VERIFY THE LOCATION OF THIS CORNER

December 29, 1972 – William E. Soderberg, RLS #17635 recorded a Certificate of Survey in Liber 2357, pages 391-392 of Macomb County Records. He found a ½" iron, no witnesses.

August 4, 1976 – "EAST WINDS SUBDIVISION NO. 2", Liber 68, pages 1-2.

January 11, 1978 – William E. Soderberg, RLS #17635 recorded a LCRC in Liber 2900, page 936 of Macomb County Records. He found a re-rod.

WITNESSES:

Northwest 15.42 Ft. PK nail in 5" Oak (gone)
Northeast 12.20 Ft. PK nail in 8" Maple (gone)
Southeast 16.67 Ft. PK nail in 9" Poplar (gone)
Southwest 21.77 Ft. PK Nail in 5" Maple (gone)

November 24, 1978 – "EDWARD SCHULTZ SUBDIVISION", Liber 73, pages 47-48.

May 25, 1979 – William E. Soderberg, RLS #17635 recorded a Certificate of Survey in Liber 3106, page 715 of Macomb County Records. He found an iron, set monument (Liber 2900, page 936) east and west ¼ line.

January 22, 1980 – "LEXINGTON SQUARE SUBDIVISION", Liber 76, pages 30-31.

September 13, 1982 – Robert L. Smith, RLS #16052 recorded a Certificate of Survey in Liber 3461, page 311, previously recorded in Liber 2900, page 936 of Macomb County Records, no witnesses.

March 17, 1985 – Roger J. Stecker, LLS #30103 recorded a Certificate of Survey in Liber 3785, pages 676-677 of Macomb County Records. He found a ½" re-rod

March 16, 1988 – "ALDEN SQUARE SUBDIVISION", Liber 84, pages 46-49.

October 16, 1992 – "ANDREW'S KNOLL SUBDIVISION", Liber 97, pages 25-30.

January 11, 1996 – "GREENFIELD VILLA SUBDIVISION", Liber 89, pages 50-52.

October 1, 1996 – "ANDREW'S KNOLL SUBDIVISION NO. 2", Liber 116, pages 37-39.

(Revised 07/13/16)

RECORDED, UNRECORDED AND FIELD MEASUREMENTS BETWEEN ADJACENT CORNERS

D-04 to D-03

No GLO

"EAST WINDS SUBDIVISION NO. 2", Liber 68, pages 1-2 = 2676.19 (cal.)

"EDWARD SCHULTZ SUBDIVISION", Liber 73, pages 47-48 = 2676.32 Ft.

"GREENFIELD VILLA SUBDIVISION", Liber 89, pages 50-52 = 2676.07 Ft.

N03°13'42" W 2676.23 Ft. (mea. 2016)

D-04 to D-05

NO GLO

"ALDEN SQUARE SUBDIVISION", Liber 84, pages 46-49 = 2647.79 Ft. (cal.)

S02°45'35" E 2647.21 Ft. (mea. 2016)

D-04 to C-04

No GLO

"ALDEN SQUARE SUBDIVISION", Liber 84, pages 46-49 = 2706.53 Ft.

"GREENFIELD VILLA SUBDIVISION", Liber 89, pages 50-52 = 2706.53 Ft.

S87°36'41" W 2706.28 Ft. (mea. 2016)

D-04 to E-04

No GLO

Certificate of Survey recorded in Liber 3106, page 715 = 2723.53 Ft.

"ALDEN SQUARE SUBDIVISION", Liber 84, pages 46-49 = 2723.28 Ft.

"ANDREW'S KNOLL SUBDIVISION", Liber 97, pages 25-30 = 2723.78 Ft.

"GREENFIELD VILLA SUBDIVISION", Liber 89, pages 50-52 Ft. = 2723.78 Ft.

"ANDREW'S KNOLL SUBDIVISION NO. 2", Liber 116, page 37-39 = 2723.78 Ft.


N87°39'48" E 2723.63 Ft. (mea. 2016)

D-04 (as monumented) to D-04 intersection of the ¼ lines)

S81°11'10" W 10.94 Ft. (cal. 2016)

SURVEYOR'S RECOMMENDATION

Monumentation found in "ALDEN SQUARE SUBDIVISION" and "GREENFIELD VILLA SUBDIVISION" along with the comparison of the recorded distance to the measured distance between the following public land corners to the north (D-03), south (D-05), west (C-04) and east (E-04) were used to validate the location of the found 4" diameter concrete monument with a ½" iron rod as the Center of Section 8 (D-04) as of June 22, 2016. I, therefore recommend to the Macomb County Survey Peer Group that they accept the found 4" diameter concrete monument with ½" iron as the best evidence for the Center of Section 8 (D-04) to be perpetuated.


Huston K. Kennedy, PS
Kennedy Surveying, Inc.

HKK/clh

*Used to verify the location of the found corner (D-04)

**2016
MACOMB COUNTY REMONUMENTATION
GRANT PROGRAM FOR
CLINTON TOWNSHIP D-04**

6/22/16

16-7610



Greenfield Rd

Christine Blvd.

LOT 4

LOT 7

LOT 6

81

20

15

D-04

41

40


77

76

78

MAP OF CLINTON TOWNSHIP

TP 2 N R 3E

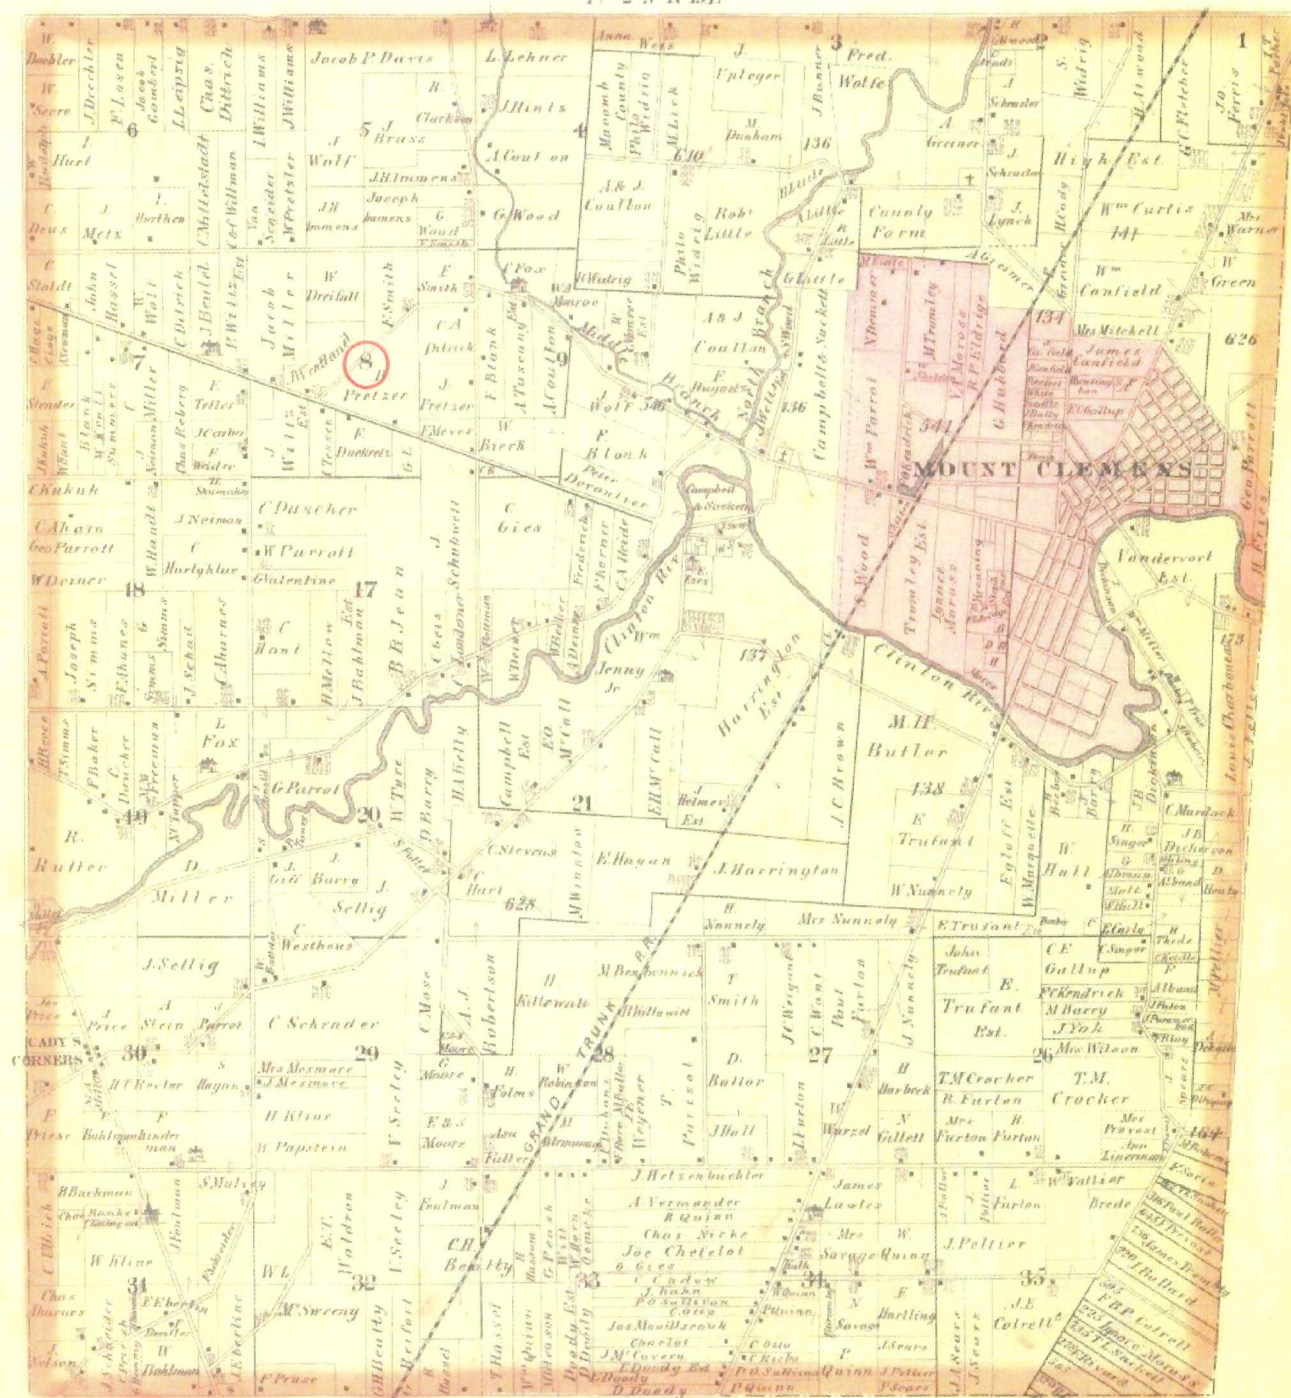

Drawn and Compiled by O.D. Cress


④ 1875

MAP OF CLINTON


Township 2 North Range 13 East

Scale 2 Inches To one Mile

of the Meridian of Michigan

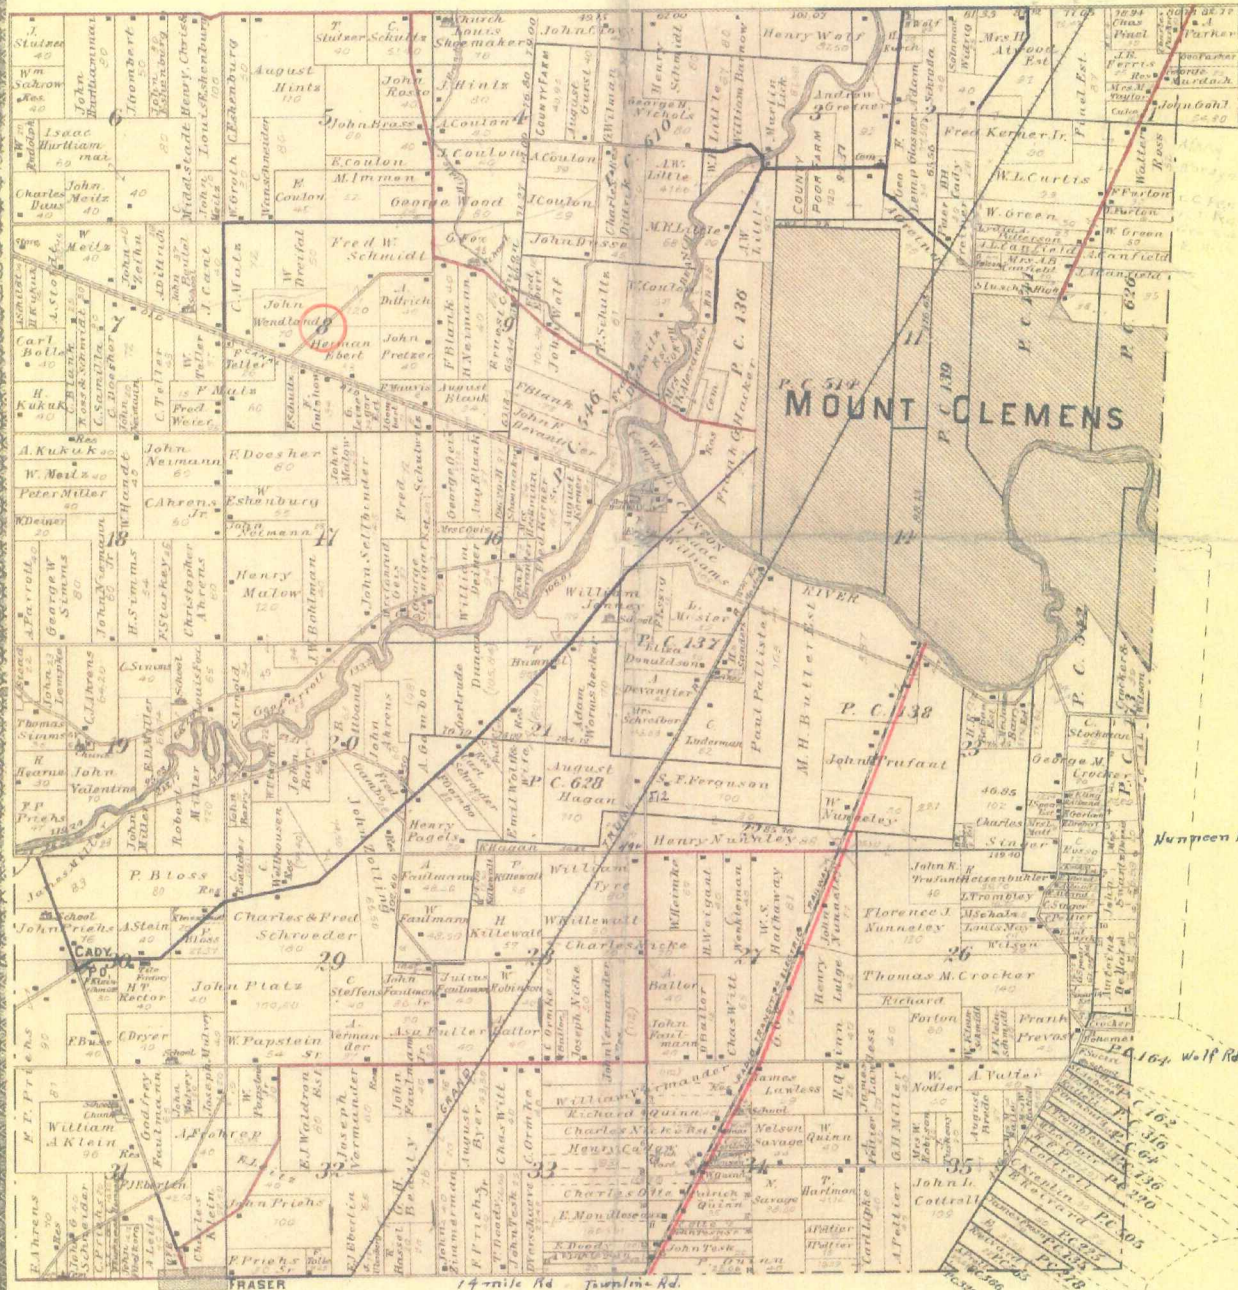


5 1895

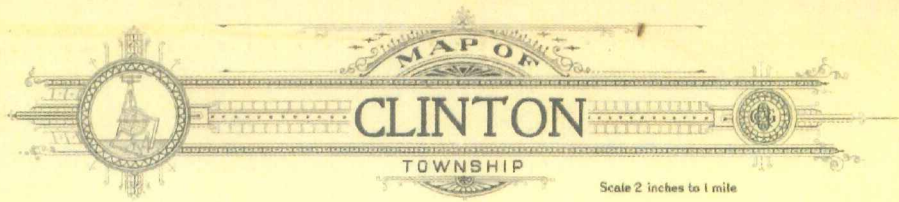

MAP OF
CLINTON
 TOWNSHIP


Scale 2 inches to 1 mile

Fractional Township 2 North, Range 13 East of the Michigan Meridian

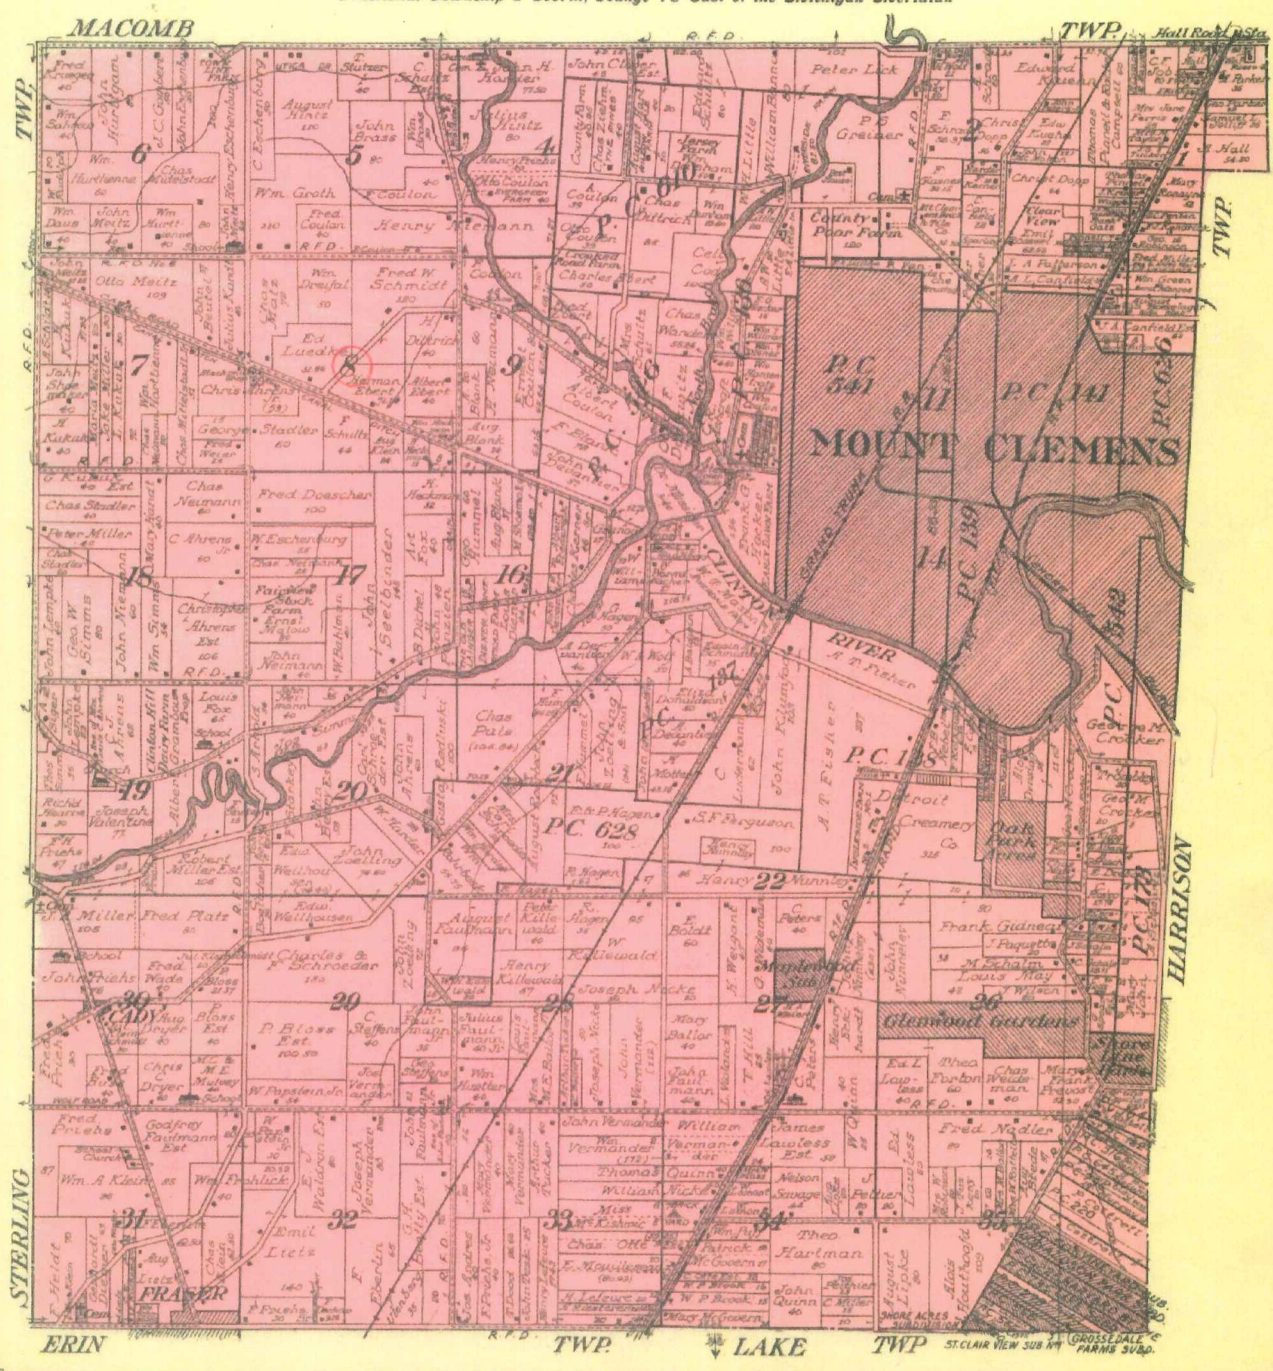

6 1914

SEE PAGE 15

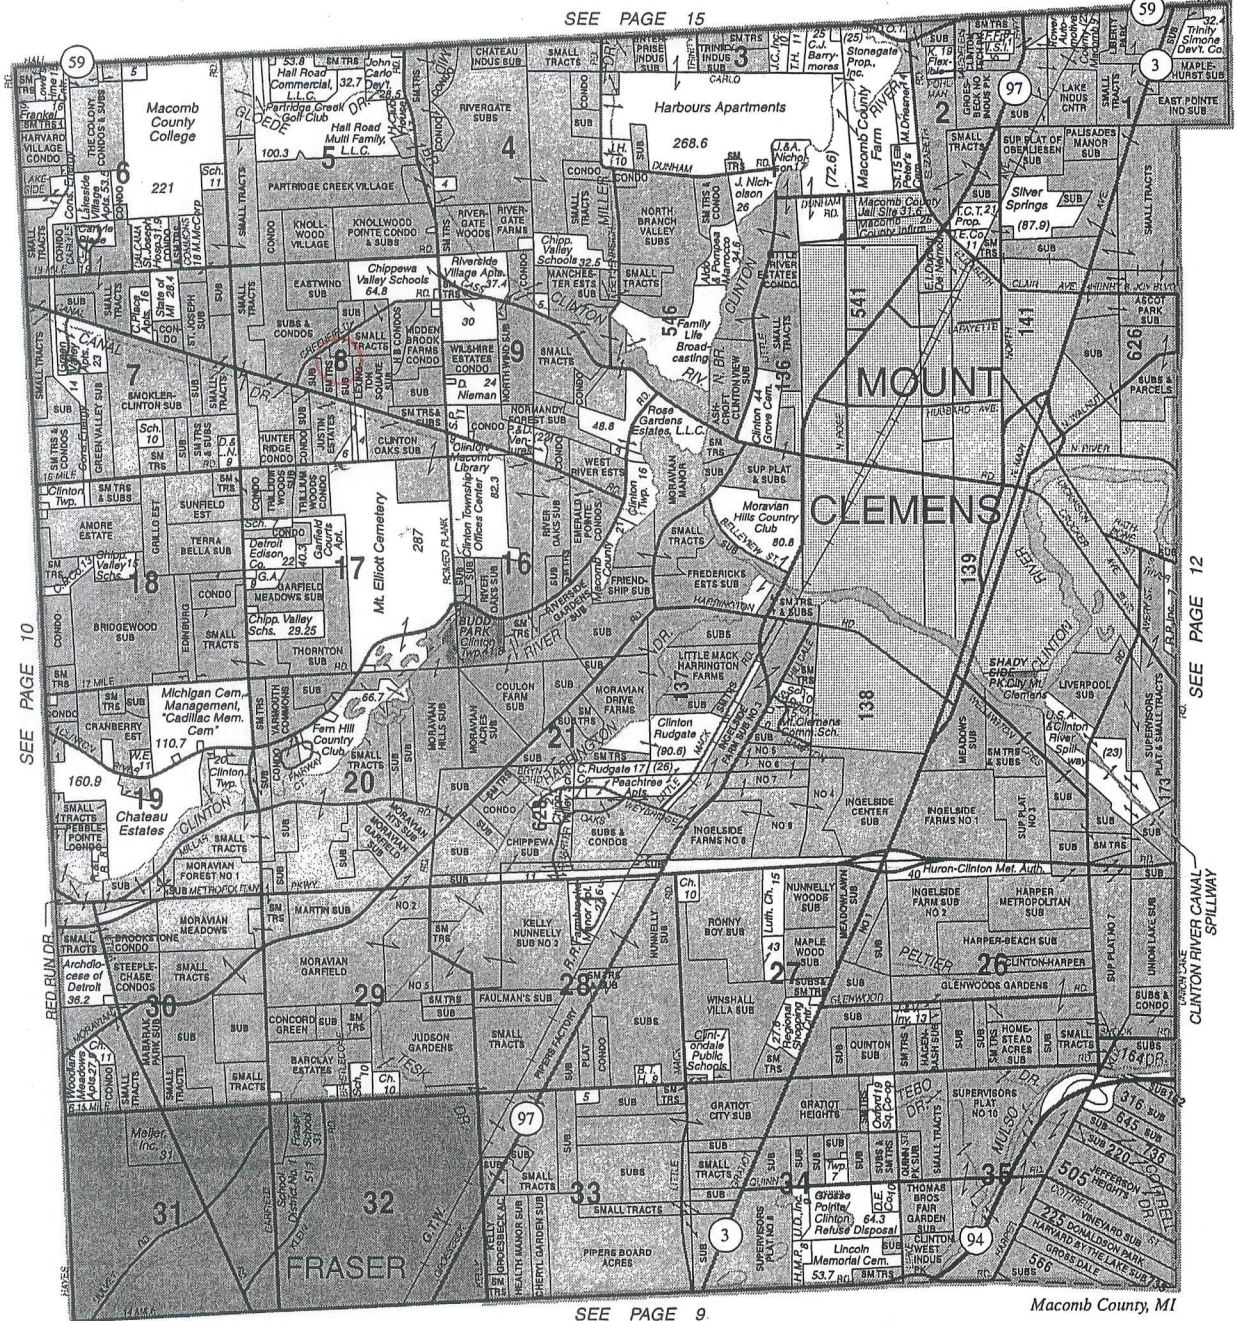

SEE PAGE 10

SEE PAGE 12

SEE PAGE 9

Macomb County, MI

© 2006 Rockford Map Publs., Inc.

2006



BOSS ENGINEERING

engineers • surveyors • planners • landscape architects

3121 EAST GRAND RIVER • HOWELL, MI 48843 • (517) 546-4836
 24435 HALSTED • FARMINGTON HILLS, MI 48335 • (248) 626-2677
www.bosseng.com

- Residential Subdivisions
- Commercial Developments
- Planned Unit Developments

- Wastewater Treatment Plants
- Septic System Design
- Construction Staking

- Land Divisions
- Boundary and Lot Surveys
- Topographical Surveys
- ALTA Surveys








Date of Photography: Spring 2012
 100 50 0 100 200 Feet

CLINTON TWP SHEET INDEX

DESCRIPTION OF PERMANENT REAL ESTATE INDEX NUMBER
13-19-302-018

11-08B

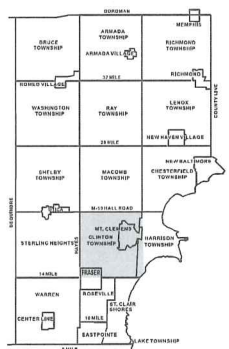

AREA NUMBER	SUB AREA NUMBER	BLOCK NUMBER	PARCEL NUMBER
13	19	302	018
13	19	302	019
13	19	302	020
13	19	302	100

Legend

- Platted Area Boundary Line
- Property Line
- Property Split Line
- Property Combined Line
- Township Boundary Line
- Traverse Line
- Dimension Extent Marks
- Dimension Start Marks

CLINTON TWP.
 E. 1/2 N.W. 1/4 SEC. 8 T. 2N. R. 13E.

Source: Macomb County Department of Planning and Economic Development
 - 2008 Digital Orthophotography Project
 - Parcel Conversion Project

Note: Digital Orthophotography horizontal positioning accuracy is 3 feet. Parcel boundary lines should be considered a graphical representation and not in any way a legal survey of engineering document. In general, the horizontal positioning and length accuracy is within 15 feet.

This map is intended for general planning purposes. Site specific evaluation should be verified by field inspection. This is a work in progress and may contain errors and omissions. Please report any potential revisions to (586)469-5285.






Date of Photography: Spring 2012
 100 50 0 100 200 Feet

CLINTON TWP SHEET INDEX

DESCRIPTION OF PERMANENT REAL ESTATE INDEX NUMBER
13-19-302-018

11-08C
 CLINTON TWP.

W.1/2 N.E.1/4 SEC.8 T.2N. R.13E.

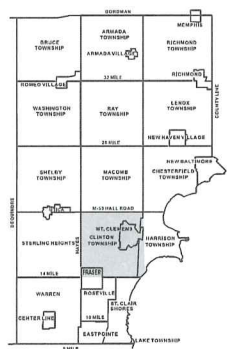

AREA NUMBER	SUB AREA NUMBER	BLOCK NUMBER	PARCEL NUMBER
13	19	302	018
13	19	302	019
13	19	302	020
13	19	302	100

Legend

- Platted Area Boundary Line
- Property Line
- Property Split Line
- Property Combined Line
- Township Boundary Line
- Traverse Line
- Dimension Extent Marks
- Dimension Start Marks

Source: Macomb County Department of Planning and Economic Development
 - 2008 Digital Orthophotography Project
 - Parcel Conversion Project

Note: Digital Orthophotography horizontal positioning accuracy is 3 feet. Parcel boundary lines should be considered a graphical representation and not in any way a legal survey or engineering document. In general, the horizontal positioning and length accuracy is within 15 feet.

This map is intended for general planning purposes. Site specific evaluation should be verified by field inspection. This is a work in progress and may contain errors and omissions. Please report any potential revisions to (586)469-5285.





Date of Photography: Spring 2012
 100 50 0 100 200 Feet



CLINTON TWP SHEET INDEX

DESCRIPTION OF PERMANENT REAL ESTATE INDEX NUMBER
13-19-302-018

11-08F

CLINTON TWP.

E.1/2 S.W.1/4 SEC.8 T.2N. R.13E.

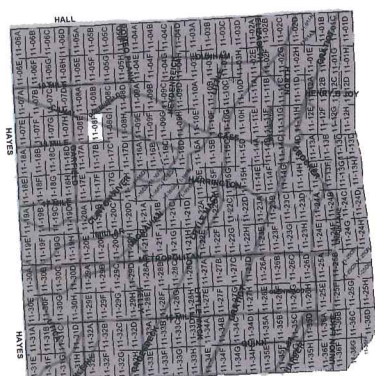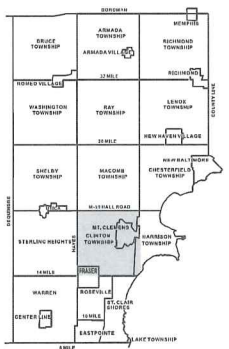

- Legend**
- Platted Area Boundary Line
 - Property Line
 - - - Property Spill Line
 - - - Property Combined Line
 - - - Township Boundary Line
 - - - Traverse Line
 - Dimension Extent Marks
 - Dimension Start Marks

Source: Macomb County Department of Planning and Economic Development
 - 2008 Digital Orthophotography Project
 - Parcel Conversion Project

Note:
 Digital Orthophotography horizontal positioning accuracy is 3 feet. Parcel boundary lines should be considered a graphical representation and not in any way a legal survey or engineering document. In general, the horizontal positioning and length accuracy is within 15 feet.

This map is intended for general planning purposes. Site specific evaluation should be verified by field inspection. This is a work in progress and may contain errors and omissions. Please report any potential revisions to (586)469-5265.

COPYRIGHT 2009
 MACOMB COUNTY, MI
 All Rights Reserved



GIS MACOMB COUNTY
 Planning and Economic
 Development

Published: Jun 06 2013




Date of Photography: Spring 2012
 100 50 0 100 200 Feet

CLINTON TWP SHEET INDEX

DESCRIPTION OF PERMANENT REAL ESTATE INDEX NUMBER
13-19-302-018

11-08G
 CLINTON TWP.

W. 1/2 S.E. 1/4 SEC. 8 T. 2N. R. 13E.

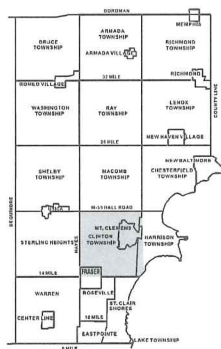

AREA NUMBER (PROPERTY UNDER SURVEY)	SUB AREA NUMBER (SUBDIVISION)	BLOCK NUMBER (STREET BLOCK)	PARCEL NUMBER (PARCELS WITHIN BLOCK)
13-19-302-018	1	1	1-10
13-19-302-018	1	2	11-20
13-19-302-018	1	3	21-30
13-19-302-018	1	100	991-1000

Legend

- Platted Area Boundary Line
- Property Line
- Property Split Line
- Property Combined Line
- Township Boundary Line
- Traverse Line
- Dimension Extent Marks
- Dimension Start Marks

Source: Macomb County Department of Planning and Economic Development
 - 2008 Digital Orthophotography Project
 - Parcel Conversion Project

Note:
 Digital Orthophotography horizontal positioning accuracy is 3 feet. Parcel boundary lines should be considered a graphical representation and not in any way a legal survey of engineering document. In general, the horizontal positioning and length accuracy is within 15 feet.

This map is intended for general planning purposes. Site specific evaluation should be verified by field inspection. This is a work in progress and may contain errors and omissions. Please report any potential revisions to (586)469-5268.



CERTIFICATE OF SURVEY

D-04

Center Post
Section 8
T.2N., R.13E.
(Found Iron)

East 1/4 Post
Section 8
T.2N., R.13E.
(Found Boat Spike)

East & West 1/4 line Section 8
S. 88° 03' 25" E. 1368.12

Found 1" Brass Bar
in 2" Dia. Cone Cylinder
Said to be property
Corner by Owner

Old Farm Fence Weaves

1299.24
649.62
of S.E. 1/4 of Sec 8
(as fenced)

Approx. & D.E. Tower Line

PARCEL A
20.209 AC.

N. 88° 20' 20" W. 1361.15
S. 88° 20' 20" E. 1361.15

N. 1° 31' 20" E.
649.62
West line of N.E. 1/4
Old Farm Fence Weaves

PARCEL B
20.180 AC.

RECORDED IN MACOMB COUNTY
RECORDS AT: 1:46 P M
DEC 29 1972

Edna H. ...
CLERK - REGISTER OF RECORDS
MACOMB COUNTY, MICHIGAN

Old Farm Fence Weaves
N. 88° 37' 15" W. 1359.22
South line of N.E. 1/4 of S.E. 1/4 of Sec 8 (as fenced)


Scale 1" = 200'

PART OF S.E. 1/4 SEC. 8
T.2N., R.13E., CLINTON TWP.,
MACOMB CO., MICHIGAN

Note: Bearings Relate to
Certified Survey
Recorded in L. 2385 P.P. 436 & 437
Macomb Co. Records

S.E. Corner
Section 8
T.2N., R.13E.
(Found 1" Pipe)

For:
Anderson, Eckstein
& Westrick, Inc.
Mount Clemens, Mich.

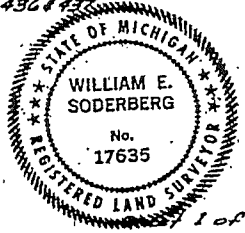

Charles G. Melching
And Associates Inc
Consulting Land Surveyors
68364 S. Main St.
Richmond, Michigan 48062
727-1360

Survey Made
Aug. 1972

Job No A672-129
8-29-72



ORIGINAL

Descriptions
Parcel "A"

A parcel of land in and being a part of the S.E.1/4 of Section 8, T.2N., R.13E., Clinton Township, Macomb County, Michigan and being more particularly described as follows:

Beginning at the East 1/4 Post of Section 8, thence S.1°41'40"W. 642.92 ft., along the East line of Section 9, thence N.88°20'20"W. 1361.15 ft., to the West line of the N.E.1/4 of the S.E.1/4 of Section 8, as fenced, thence N.1°31'20"E. 649.62 ft., along the West line of the N.E.1/4 of the S.E.1/4 of Section 8, as fenced, thence S.88°03'25"E. 1363.12 ft., to the point of beginning and containing 20.209 Acres of land. Subject to easements of record.

Parcel "B"

A parcel of land in and being a part of the S.E.1/4 of Section 8, T.2N., R.13E., Clinton Township, Macomb County, Michigan and being more particularly described as follows:

Beginning at a point on the East line of Section 8, 642.92 ft. S.1°41'40"W. from the East 1/4 Post of Section 8, thence S.1°41'40"W. 642.92 ft., along the East line of Section 8, thence N.88°37'15"W. 1359.22 ft. along the South line of the N.E.1/4 of the S.E.1/4 of Section 8, as fenced, thence N.1°31'20"E. 649.62 ft., along the West line of the N.E.1/4 of the S.E.1/4 of Section 8, as fenced, thence S.88°20'20"E. 1361.15 ft., to the point of beginning and containing 20.180 Acres of land. Subject to easements of record.

SURVEYOR'S CERTIFICATE: I hereby certify that I have surveyed and mapped the land above platted and/or described on 16 Nov 72, and that the ratio of closure on the unadjusted field observations of such survey was 1:10,000, and that all of the requirements of P.A. 132 1970 have been complied with.

Charles G. Melching
and Associates Inc.

by William E. Soderberg
William E. Soderberg
Registered Land Surveyor
No. 17635
68364 South Main
Richmond, Michigan

East 1/4 Post
Section 8 T.2N.R.13E.

P.K. Nail in 3" Poplar N.E. 40.67 Ft.
Top Hydrant S.W. 55.80 Ft.
Spike in Anchor Post West 15.80 Ft.

S.E. Corner
Section 8, T.2N.R.13E.

P.K. Nail in 30" Apple Tree N.W. 56.10 Ft.
P.K. Nail in D.E. Pole N.N.E. 43.43 Ft.
P.K. Nail in D.E. Pole S.W. 54.54 Ft.





Sheet 2 of 2


Job No AET-129
8-29-72

" EAST WINDS SUBDIVISION N° 2 "

PART OF N. 1/2 OF SECTION 8, T.2N., R.13E.
CLINTON TOWNSHIP, MACOMB COUNTY, MICHIGAN

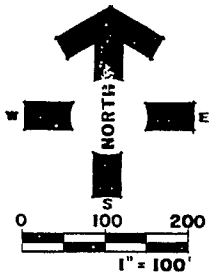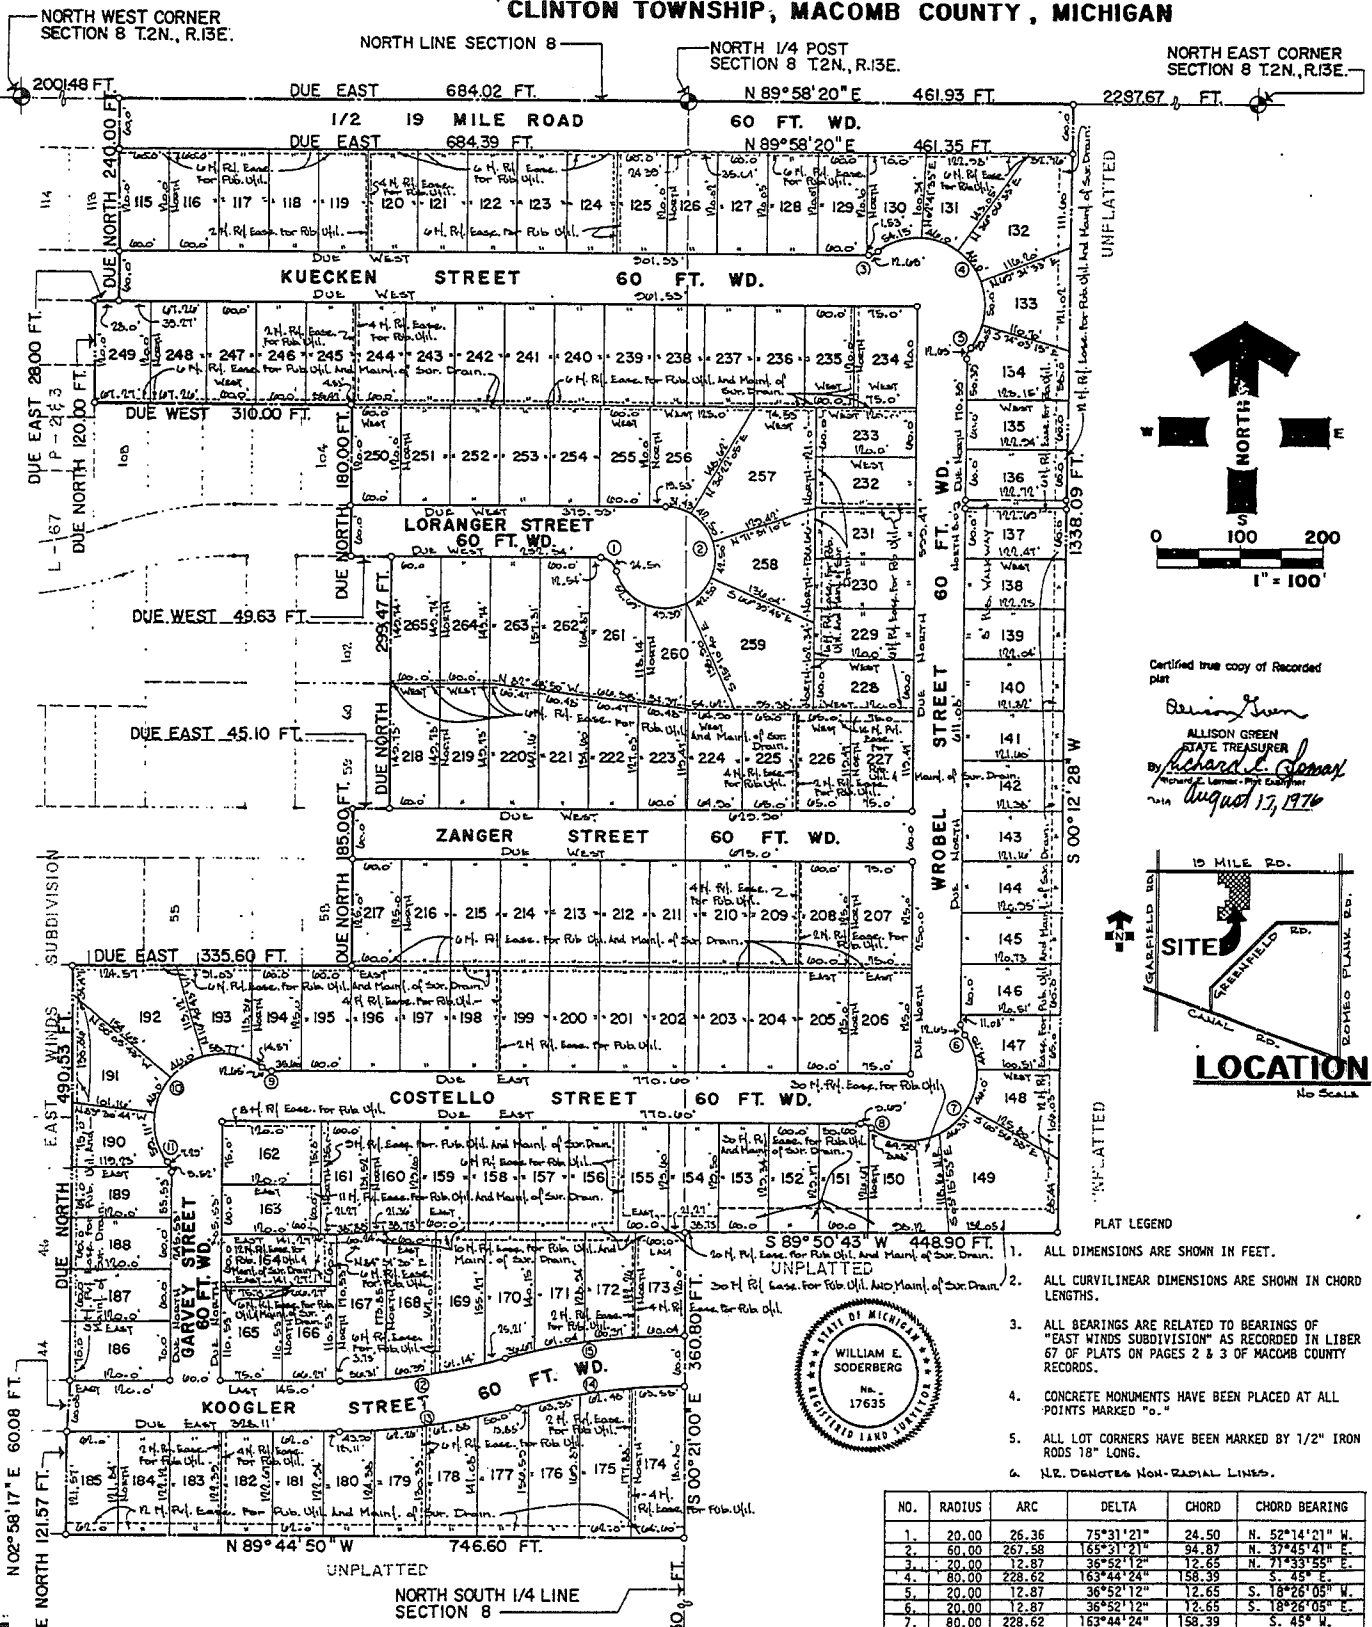

Certified true copy of Recorded plat
Devin Green
 ALLISON GREEN
 STATE TREASURER
 By *Richard L. Soper*
 Mount Clemens, Mich. County Clerk
 August 17, 1976

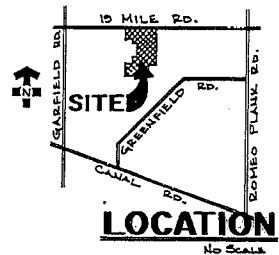

UNPLATTED

PLAT LEGEND

1. ALL DIMENSIONS ARE SHOWN IN FEET.
2. ALL CURVILINEAR DIMENSIONS ARE SHOWN IN CHORD LENGTHS.
3. ALL BEARINGS ARE RELATED TO BEARINGS OF "EAST WINDS SUBDIVISION" AS RECORDED IN LIBER 67 OF PLATS ON PAGES 2 & 3 OF MACOMB COUNTY RECORDS.
4. CONCRETE MONUMENTS HAVE BEEN PLACED AT ALL POINTS MARKED "o."
5. ALL LOT CORNERS HAVE BEEN MARKED BY 1/2" IRON RODS 18" LONG.
6. N.R. DENOTES NON-RADIAL LINES.



NO.	RADIUS	ARC	DELTA	CHORD	CHORD BEARING
1.	20.00	26.36	75°31'21"	24.50	N. 52°14'21" W.
2.	60.00	267.58	165°31'21"	94.87	N. 37°45'41" E.
3.	20.00	12.87	36°52'12"	12.65	N. 71°33'55" E.
4.	80.00	228.62	163°44'24"	158.39	S. 45° W.
5.	20.00	12.87	36°52'12"	12.65	S. 18°26'05" W.
6.	20.00	12.87	36°52'12"	12.65	S. 18°26'05" E.
7.	80.00	228.62	163°44'24"	158.39	S. 45° W.
8.	20.00	12.87	36°52'12"	12.65	N. 71°33'55" W.
9.	20.00	12.87	36°52'12"	12.65	N. 71°33'55" W.
10.	80.00	228.62	163°44'24"	159.39	S. 45° W.
11.	20.00	12.87	36°52'12"	12.65	S. 18°26'05" E.
12.	752.25	203.09	15°15'55"	202.49	S. 82°21'50" W.
13.	822.25	219.07	15°15'55"	218.43	S. 82°21'50" W.
14.	752.25	203.27	15°16'45"	202.67	S. 82°22'15" W.
15.	822.25	218.89	15°15'10"	218.25	S. 82°21'29" W.

51855

ANDERSON ECKSTEIN AND WESTRICK INC.
 CIVIL ENGINEERS AND LAND SURVEYORS
 MOUNT CLEMENS, MICHIGAN 48043

2

" EAST WINDS SUBDIVISION N° 2 "

PART OF N. 1/2 OF SECTION 8, T.2N., R.13E.
CLINTON TOWNSHIP, MACOMB COUNTY, MICHIGAN

SURVEYOR'S CERTIFICATE

I, William E. Soderberg, Surveyor, Certify:

That I have Surveyed, Divided and Mapped the Land Shown on this Plat, Described as follows: "EAST WINDS SUBDIVISION N° 2" Part of N. 1/2 of Section 8, T.2N., R.13E., Clinton Township, Macomb County, Michigan and Being More Particularly Described as follows: Beginning At The North Quarter Point of Section 8; Thence N. 89° 56' 20" E. 401.25 Feet Along The North Line of Section 8; Thence S. 00° 12' 25" W. 1556.00 Ft.; Thence S. 80° 50' 45" W. 446.00 Feet; Thence S. 00° 21' 00" E. 206.00 Feet; Thence N. 80° 44' 50" W. 746.00 Feet to the Southeast Corner of "East Winds Subdivision" As Recorded in Liber 61 of Plats Pages 2 and 3 of Macomb County Records; Thence The Following Thirteen (13) Courses Along The South, East and North Lines of Said "East Winds Subdivision" Due North 111.51 Feet And N. 07° 58' 11" E. 80.00 Feet And Due North 400.00 Feet And Due East 306.00 Feet And Due North 106.00 Feet And Due East 45.00 Feet And Due North 379.47 Feet And Due West 45.00 Feet And Due North 180.00 Feet And Due West 310.00 Feet And Due North 120.00 Feet And Due East 20.00 Feet And Due North 240.00 Feet to The North Line of Section 8; Thence Due East 166.00 Feet Along Said North Line to The Point of Beginning and Containing Lots 116 Through 226, Inclusive and Containing 31.0220 Acres.

That I have made such survey, land division and plat by the direction of the owners of such land.

That such plat is a correct representation of all the exterior boundaries of the land surveyed and the subdivision of it.

That the required monuments and lot markers have been located in the ground or that surety has been deposited with the Municipality, as required by Section 125 of the Act.

That the accuracy of survey is within the limits required by Section 126 of the Act.

That the bearings shown on the plat are expressed as required by Section 126 (3) of the Act and as explained in the legend.

William G. Westrick
William G. Westrick, P.E. No. 17332
Secretary-Treasurer

ANDERSON, ECKSTEIN AND WESTRICK, INC.
42800 Garfield Road
Mount Clemens, Michigan, 48043

1-27-76
Date

William E. Soderberg
William E. Soderberg, R.L.S. No. 17635

PROPRIETOR'S CERTIFICATE - CORPORATION

Republic Development Corporation, a Corporation duly organized and existing under the laws of the State of Michigan, by Leonard R. Farber, President and Howard M. Binkow, Executive Vice-President, as Proprietor, has caused the land to be surveyed, divided, mapped and dedicated as represented on this plat and that the streets and public walkway are for the use of the Public and the private easements shown on the plat are for public utilities and maintenance of surface drainage.

WITNESSES:

Heleen Greenstein
HELEN GREENSTEIN
Leon Binkow
LEON BINKOW

REPUBLIC DEVELOPMENT CORPORATION
a Michigan Corporation
14201 West Eight Mile Road
Detroit, Michigan, 48235

Leonard R. Farber
Leonard R. Farber, President
Howard M. Binkow
Howard M. Binkow, Executive Vice-President

CORPORATION ACKNOWLEDGEMENT

STATE OF MICHIGAN } S.S.
COUNTY OF WAYNE }

Personally came before me this 16th day of MARCH, 1976, Leonard R. Farber, President and Howard M. Binkow, Executive Vice-President of the above named Corporation, to me known to be the persons who executed the foregoing instrument and to me known to be such President and Executive Vice-President of said Corporation, and acknowledged that they executed the foregoing instrument as such officers as the free act and deed of said Corporation, by its authority.

My Commission Expires:
8-2-76

Heleen Greenstein
HELEN GREENSTEIN
Notary Public
Wayne County, Michigan

PROPRIETOR'S CERTIFICATE - INDIVIDUALS AND OTHER THAN CORPORATIONS

I, as proprietor certify that I caused the land embraced in this plat to be surveyed, divided, mapped and dedicated as represented on this plat and that the streets and public walkway are for the use of the Public and the private easements shown on the plat are for public utilities and maintenance of surface drainage.

WITNESSES:

Stanley Hirt
STANLEY HIRT
Milton Rehberg
MILTON REHBERG

Florence Rehberg
Florence Rehberg, Survivor of herself and Emma Sawitzky, Deceased, whose death certificate is recorded in Liber 2580 of Deeds on Page 688, Macomb County Records,
41 Madison Street
Mount Clemens, Michigan, 48043

INDIVIDUAL ACKNOWLEDGEMENT

STATE OF MICHIGAN } S.S.
COUNTY OF MACOMB }

Personally came before me this 15th day of APRIL, 1976, the above named Florence Rehberg, Survivor of herself and Emma Sawitzky, deceased, to me known to be the person who executed the foregoing instrument and acknowledged that she executed the same as her free act and deed.

My Commission Expires:

MAY 14, 1979

Stanley Hirt
STANLEY HIRT
Notary Public
MACOMB COUNTY, MICHIGAN

COUNTY TREASURER'S CERTIFICATE

The records in my office show no unpaid taxes or special assessments for the five years preceding April 6, 1976 involving the lands included in this plat. N^o 261

Rosemary Vernier
Adam E. Nowakowski, County Treasurer
Macomb County by Rosemary Vernier, Clerk

COUNTY DRAIN COMMISSIONER'S CERTIFICATE

Approved on 5/26/76 as complying with Section 192 of Act 288, P.A. 1967 and the applicable rules and regulations published by my office in the County of Macomb.

Thomas S. Welsh
THOMAS S. WELSH, Drain Commissioner

CERTIFICATE OF COUNTY ROAD COMMISSIONERS

Approved on June 15, 1976 as complying with Section 183 of Act 288, P.A. 1967 and the applicable published rules and regulations of the Board of Road Commissioners of Macomb County.

Matthew J. Gaberty
MATHEW J. GABERTY, CHAIRMAN
Joseph P. Perry
JOSEPH P. PERRY, VICE-CHAIRMAN
Keith Bovenschen
Keith Bovenschen, Commissioner

CERTIFICATE OF MUNICIPAL APPROVAL

I certify that this plat was approved by the Township Board of the Township of Clinton at a meeting held June 28th, 1976 and was reviewed and found to be in compliance with Act 288, P.A. 1967, also adequate surety has been deposited with the clerk for the placing of monuments and markers within a reasonable length of time, not to exceed one year from the above date. Minimum lot width and area required by Section 186 (D) Act 288 of P.A. 1967 has been waived and conforms with the legally adopted Zoning and Subdivision Control Ordinances of Clinton Township. Public Sewer and Water services have been installed and are ready for connection.

E. Michael Rhoads
E. Michael Rhoads, Clerk

COUNTY PLAT BOARD CERTIFICATE

This plat has been reviewed and is approved by the Macomb County Plat Board on July 20, 1976 as being in compliance with all of the provisions of Act 288, P.A. 1967, and the Plat Board's applicable rules and regulations.

Edna Miller
Edna Miller, Clerk-Register of Deeds
Robert A. Ver Kullen
ROBERT A. VER KULLEN, Chairman,
Board of County Commissioners
Adam E. Nowakowski
Adam E. Nowakowski, County Treasurer

RECORDING CERTIFICATE

STATE OF MICHIGAN } S.S.
COUNTY OF MACOMB }

This plat was received for recording on the 4th day of August, A.D. 1976 at 1:45 o'clock and is recorded in Liber 68 of Plat Books on Pages 1 and 2 P.M.

Edna Miller
Edna Miller, Clerk-Register of Deeds



ANDERSON, ECKSTEIN AND WESTRICK, INC.
CIVIL ENGINEERING AND LAND SURVEYING
MOUNT CLEMENS, MICHIGAN 48043

LINE 2900 PAGE 936

LAND CORNER RECORDATION CERTIFICATE

FILING REQUIREMENT OF ACT 74, MICH. P.A.1970

A473857

FOR CORNERS OF-- Section 8 LOCATED IN--Clinton Township N. 2 S. R. 13 W.
1. PUBLIC LAND SURVEY
2. PROPERTY CONTROLLING IN SECTION 8 T. 2 N. R. 13 E.
3. MISCELLANEOUS PROPERTY IN SECTION T. N. S. R. E.
4. LOT NO. RECORDED PLAT
5. PRIVATE CLAIMS

CORNER CODE NUMBER

D-3 D-4

E-3

RECORDED IN MACOMB COUNTY

RECORDS AT: 11:09a M.

JAN 11 1978

Edna Hill

CLERK - REGISTER OF DEEDS MACOMB COUNTY, MICHIGAN

REGISTER OF DEEDS STAMP AND FILING NUMBER

I, William E. Soderberg do hereby certify that under requirements of P.A. 74, Michigan P.A. of 1970, the corner points mentioned in lines 1 and 2 above (identified with circles on index code diagram-over) were, in a field survey on 2-16 1977, established, re-established, monumented, re-monumented, recovered or restored as expressed below and in conformance with regulations and rules therefore as required in the current manual of survey instructions of the United States Department of the Interior, Bureau of Land Management or by a decree of a court of law. Furthermore, that the corner points mentioned in lines 3, 4 and 5 above were, in a field survey on 19, found, recovered, restored, established or re-established as expressed below and in conformance with the rules of the Michigan State Board of Registration for Land Surveyors or, by a Decree of a Court of law:

A. Description of original monument and accessories and/or subsequent restoration:

B. Description of corner evidence found and/or method applied in restoring or re-establishing corner:

D-3 3/4" Pipe Iron Found
D-4 1/2" Rod Found
E-3 1/2" Rod Found

C. Description of monument for corner and accessories established to perpetuate locating the position of the corner:

D-3 3/4" Pipe Iron Found
North 49.55' Nail and #123 Tag in D.E. Pole
Northeast 33.80' Center of Gate Well
Southeast 62.66' P.K. Nail in 24" Oak
South 49.98' P.K. Nail in D.E. Pole
D-4 1/2" Rod Found
Northwest 15.42' P.K. Nail in 5" Oak
Northeast 12.20' P.K. Nail in 8" Maple
Southeast 16.67' P.K. Nail in 9" Poplar
Southwest 21.77' P.K. Nail in 5" Maple
E-3 1/2" Rod Found
East 32.86' P.K. Nail in M.B.T. Pole
Southwest 69.47' P.K. Nail in D.E. Pole
Northwest 76.80' Centerline nut top of Fire Hydrant
North Northwest 80.92' Centerline of Gate Well

SIGNED BY William E. Soderberg DATE 11-17-77


SURVEYOR'S MICHIGAN REGISTRATION NO. #17635 (SEAL)

FOR STATE AND UNITED STATES AGENCIES:

SIGNED BY CHIEF OF SURVEY PARTY DATE


APPROVED AND SIGNED BY MICHIGAN REGISTERED LAND SURVEYOR DATE

SURVEYOR'S MICHIGAN REGISTRATION NO.

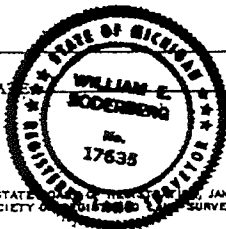

EDWARD SCHULTZ SUBDIVISION


PART OF THE NORTHEAST QUARTER OF SECTION 8, T.2N., R.13.E.
CLINTON TOWNSHIP, MACOMB COUNTY, MICHIGAN

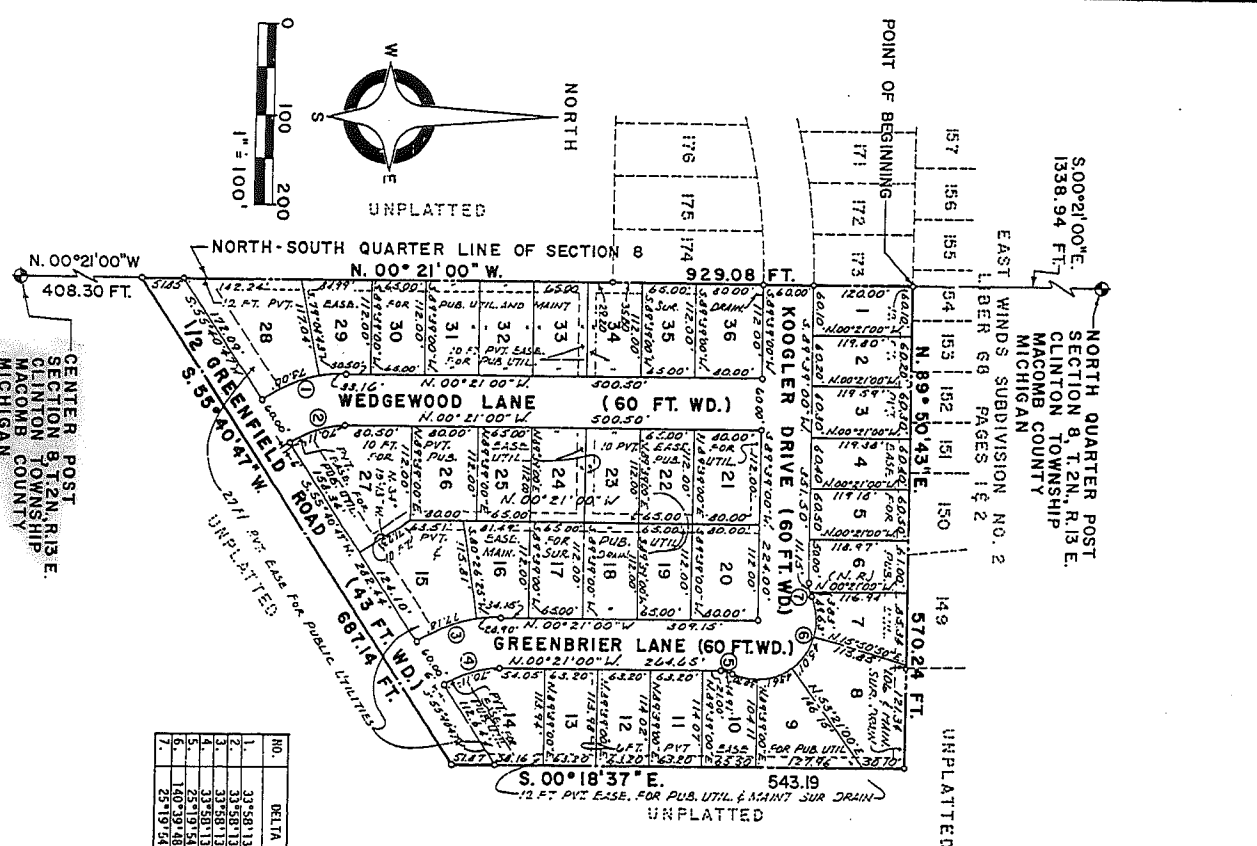

- PLAT LEGEND**
1. ALL DIMENSIONS ARE SHOWN IN FEET.
 2. ALL CURVILINEAR DIMENSIONS ARE SHOWN IN CHORD LENGTHS.
 3. CONCRETE MONUMENTS HAVE BEEN PLACED AT ALL POINTS MARKED 'C'.
 4. ALL LOT CORNERS HAVE BEEN MARKED BY 1/2" IRON RODS 18" LONG.
 5. (N.R.) DENOTES NON-RADIAL LINES.
 6. ALL BEARINGS ARE RELATED TO EAST WINDS SUBDIVISION NO. 2, LIBER 68, PAGES 1 & 2, MACOMB COUNTY RECORDS.

NO.	DELTA	RADIUS	ARC	CHORD	CHORD BEARINGS
1	33°58'13"	180.00'	106.72'	105.17'	N.17°20'07"W
2	33°58'13"	120.00'	71.15'	70.11'	N.17°20'07"W
3	33°58'13"	180.00'	106.72'	105.17'	N.17°20'07"W
4	33°58'13"	120.00'	71.15'	70.11'	N.17°20'07"W
5	25°19'48"	140.00'	127.85'	131.81'	N.42°11'00"E
6	160°19'48"	70.00'	127.85'	131.81'	N.42°11'00"E
7	25°19'48"	140.00'	127.85'	131.81'	N.42°11'00"E

CERTIFIED TRUE COPY OF
RECORDED PLAT
BY
LORNE E. ACKERHOE
STATE TRECORDER
By *William E. Soderberg*
Notary Public
November 30, 1978

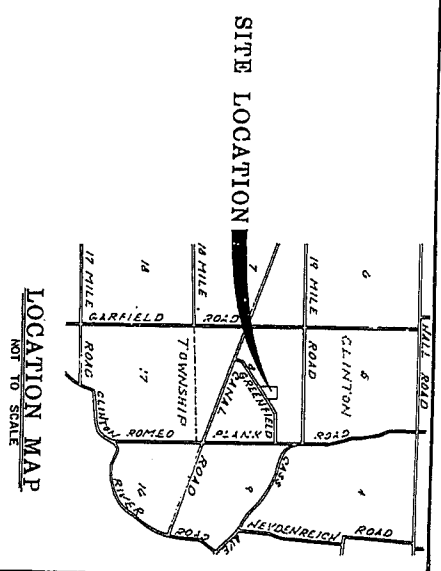

SURVEYOR'S CERTIFICATE

I, William E. Soderberg, Surveyor, certify:
That I have surveyed, divided and capped the land shown on this plat,
described as follows:

"EDWARD SCHULTZ SUBDIVISION" part of the Northeast Quarter of Section 8, T.2N., R.13.E., Clinton Township, Macomb County, Michigan and being a Subdivided Parcel described as follows:
Beginning at a point on the North-South Quarter Line of Section 8, S.00°21'00"E, 1338.94 feet from the North-South Quarter Line of Section 8, recorded in Liber 68 of Public Records, Macomb County Records, thence N. 89° 50' 43" E, 570.24 feet along the extension of said line to the centerline of Greenbrier Road (160 feet wide), thence S. 00° 18' 37" E, 543.19 feet along the centerline of said Greenbrier Road to the North-South Quarter Line of Section 8, thence N. 00° 21' 00" W, 929.08 feet along the North-South Quarter Line of Section 8, to the Point of Beginning and Containing 1.11 Acres.

That I have made such survey, land division and plot by the direction of the owners of such land
That such plat is a correct representation of all the exterior boundaries of the land surveyed and the subdivision of it.
That the required monuments and lot markers have been located in the ground or that survey has been deposited with the Municipality, as required by Section 125 of the Act.
That the accuracy of survey is within the limits required by Section 126 of the Act.
That the bearings shown on the plat are expressed as required by Section 126 (3) of the Act and as explained in the Legend.
February 28, 1978
WILLIAM E. SODERBERG, INC.
Vice-President
42800 Garfield Road
Mt. Clemens, Michigan 48044



ANDERSON, ECKSTEIN, AND WESTRICK, INC.
CIVIL ENGINEERS AND LAND SURVEYORS
MOUNT CLEMENS, MICHIGAN

56716

EDWARD SCHULTZ SUBDIVISION

PART OF THE NORTHEAST QUARTER OF SECTION 8, T.2N., R.13E. CLINTON TOWNSHIP, MACOMB COUNTY, MICHIGAN

PROPRIETOR'S CERTIFICATE

Schultz Homes, Inc., a Corporation duly organized and existing under the laws of the State of Michigan, by Edward Schultz, President and Dennis J. Nitz, Secretary, as Proprietor, has caused the land to be surveyed, divided, mapped and dedicated as represented on this plat that the proceeds from the use of the public utilities and the private easements shown on the plat are for public utilities and maintenance of surface drainage.

Schultz Homes, Inc.
a Michigan Corporation
521 Sheldon
Grosse Pointe Shores, Michigan 48236

WITNESSES:

Kevin C. Dunn
Kevin C. Dunn

Edward Schultz
Edward Schultz, President

Beverly J. Wycoll
Beverly J. Wycoll

Janette J. Waddy
Janette J. Waddy, Secretary

CORPORATION ACKNOWLEDGEMENT

STATE OF MICHIGAN }
COUNTY OF MACOMB } S.S.

Personally came before me this 21 day of March, 1978, Edward Schultz, President and Janette J. Waddy, Secretary of the above named Corporation, to me known to be the persons who executed the foregoing instrument, and to me known to be such President and Secretary of said Corporation, and acknowledged that they executed the foregoing instrument as such officers as the free act and deed of said Corporation, by its authority.

My Commission Expires - July 30, 1979

Beverly J. Wycoll
Beverly J. Wycoll
Notary Public, Macomb County, Michigan

COUNTY TREASURER'S CERTIFICATE

The records in my office show no unpaid taxes or special assessments for the five years preceding March 31, 1978 involving the lands included in this Plat.

Rosemary Vernier
Rosemary Vernier, Deputy Treasurer
Macomb County

COUNTY DRAIN COMMISSIONER'S CERTIFICATE

Approved on June 5, 1978 as complying with Section 192 of Act 289, P.A. 1967 and the applicable rules and regulations published by my office in the County of Macomb.

Thomas S. Nelson
Thomas S. Nelson, Drain Commissioner

CERTIFICATE OF COUNTY ROAD COMMISSIONERS

Approved on 8-15-78 as complying with section 183 of Act 289, P.A. 1967 and the applicable public utility regulations of the Board of Road Commissioners of Macomb County.

Joseph J. Gable
Joseph J. Gable, Chairman

Matthew J. Gable
Matthew J. Gable, Vice-Chairman

John J. Gable
John J. Gable, Commissioner

CERTIFICATE OF MUNICIPAL APPROVAL

I certify that this plat was approved by the Township Board of the Township of Clinton at a meeting held September 19, 1978 and was reviewed and found to be in compliance with Act 289, P.A. 1967, and that the plat was deposited with the Clerk for the platting of monuments and boundaries in a reasonable length of time, not to exceed one year from the above date. The plat and area required by Section 186 (D) Act 289 of P.A. 1967 do not conform with the legally adopted zoning and subdivision control ordinances of Clinton Township. Surety has been posted to insure the installation of public sewer and public water services.

E. Michael Roads
E. Michael Roads, Clerk

COUNTY PLAT BOARD CERTIFICATE

This plat has been reviewed and is approved by the Macomb County Plat Board on October 19, 1978 as being in compliance with all rules and regulations.

Edna Ritter
Edna Ritter, Clerk-Register of Deeds

Robert A. Ver Kullen
Robert A. Ver Kullen, Chairman
Board of County Commissioners

Adam E. Kowalski
Adam E. Kowalski, County Treasurer

RECORDING CERTIFICATE

STATE OF MICHIGAN }
COUNTY OF MACOMB } S.S.

This Plat was received for recording on the 24th day of November, A.D., 1978 at 2:35 P.M. o'clock and is recorded in Book 23 of Plat Books on Pages 17-18.

Edna Ritter
Edna Ritter, Clerk-Register of Deeds



ANDERSON, ESKSTEIN, AND WESTRICK, INC.
CIVIL ENGINEERS AND LAND SURVEYORS
MOUNT CLEMENS, MICHIGAN 48044

Certificate of Survey

A583107

ANDERSON, ECKSTEIN & WESTRICK, INC.
42800 GARFIELD ROAD
MT. CLEMENS, MICH. 48044



Part of the North Half of Section 8
Township 2 North, Range 13 East, Clinton
Township, Macomb County, Michigan

PHONE NUMBER
(313) 286-1234

T2N, R13E

C-4
E-4

East Quarter Post
Section 8
Found Iron
(Liber 3089 Page 946)

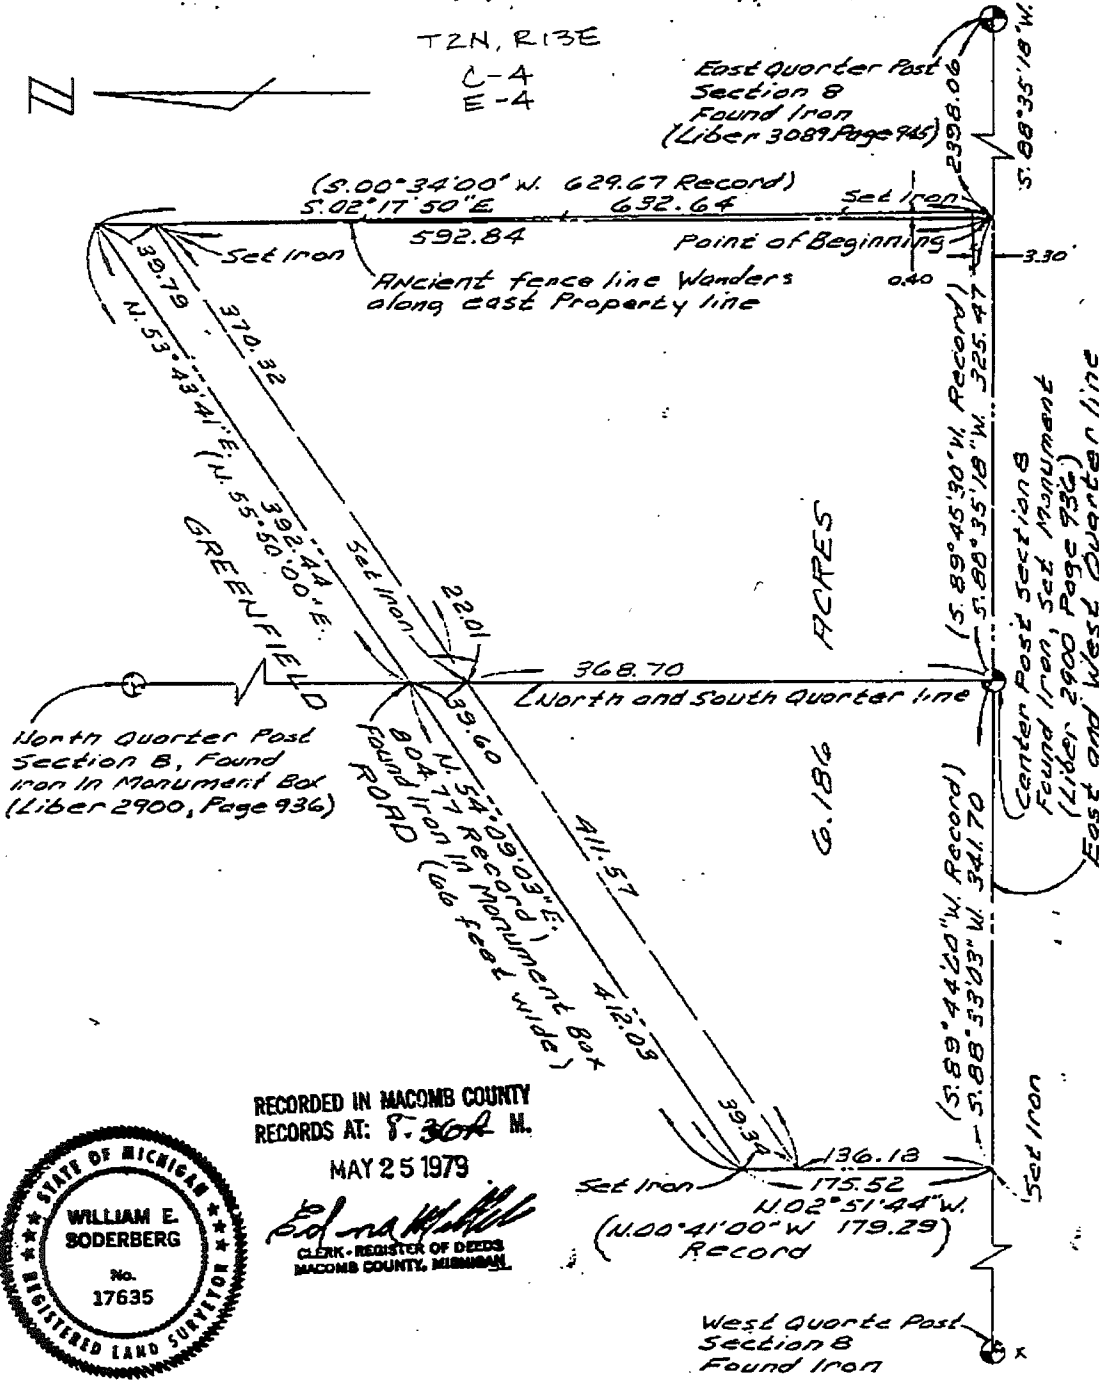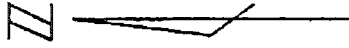

RECORDED IN MACOMB COUNTY
RECORDS AT: 8-308 M.
MAY 25 1979



William E. Soderberg
CLERK - REGISTER OF DEEDS
MACOMB COUNTY, MICHIGAN

CERTIFIED TO *Henry Magielnicki*
ADDRESS *3345 Mine*
CITY & STATE *Sterling Heights, Michigan*
DATE SURVEYED *APRIL 27, 1979*
SCALE: 1" EQUALS *100'*


I hereby certify that I have surveyed and mapped the land
above and/or described on APRIL 27 19 79
and that the ratio of closure on the unadjusted field observations
of such survey was 1/5000 and that all of the re-
quirements of Public Act 132, of 1970 have been complied with.

Bearings shown on this survey were determined as follows:
By Solar Observation

William E. Soderberg
WILLIAM E. SODERBERG #17635 REGISTERED LAND SURVEYOR


N. 89°36'31"E
325.16
CENT. POST
SECT. 8
T. 21N. R. 13E.

UNPLATTED

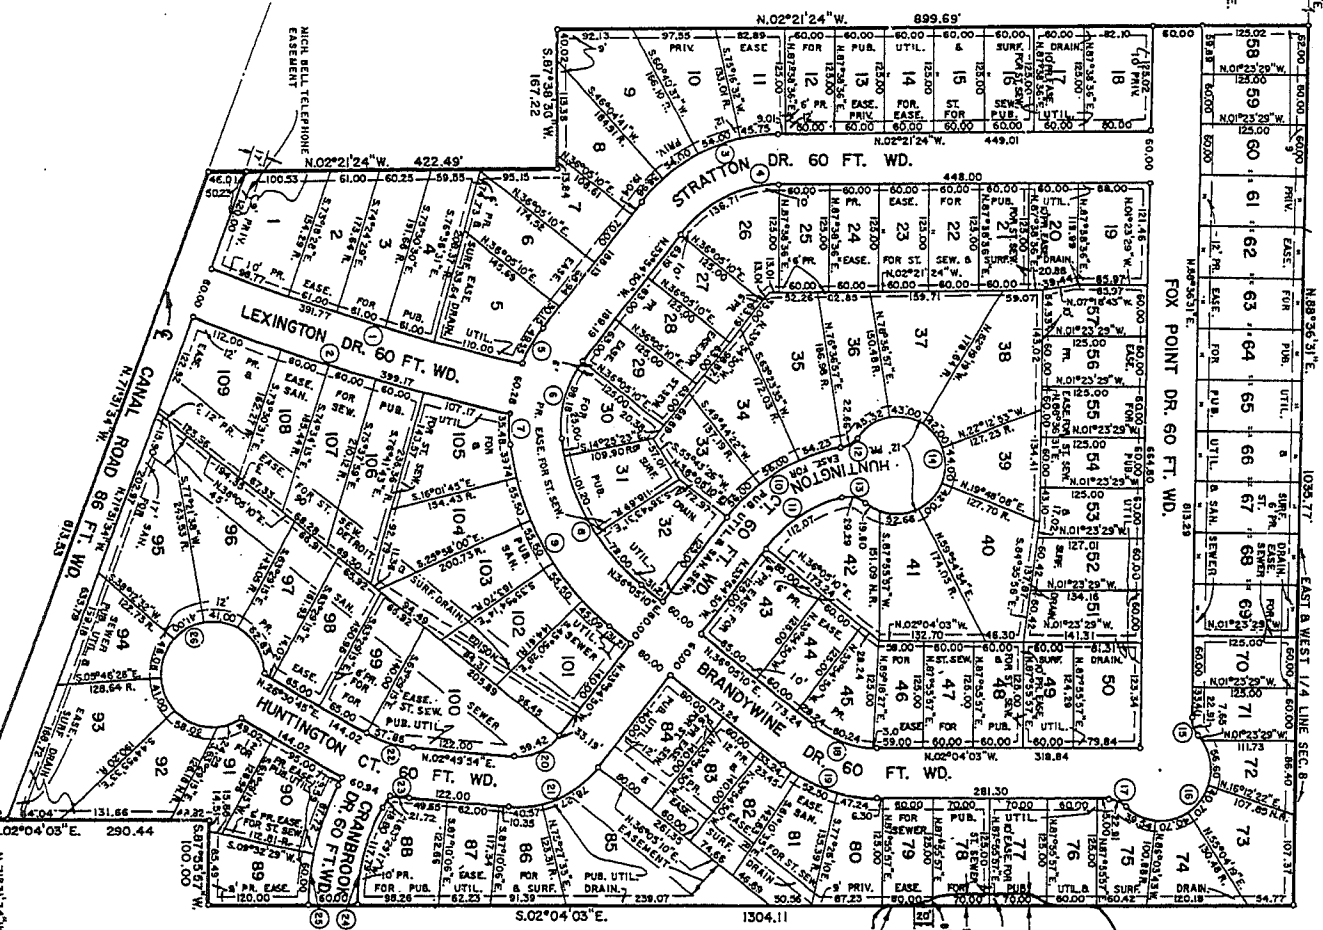

UNPLATTED

FOX POINT DR. 60 FT. WD.

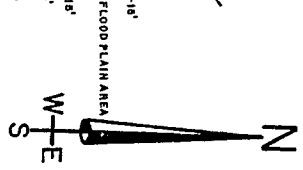

UNPLATTED
FLOOD PLAIN ELEVATION AS ESTABLISHED BY THE D.H.R. 54.00 - (U.S.S.S. DATUM)


LEXINGTON SQUARE SUB.

PART OF THE SOUTHEAST 1/4 OF SECTION 8, T. 21N., R. 13E., CLINTON TOWNSHIP, MACOMB COUNTY, MICHIGAN.

PLAT LEGEND

ALL DIMENSIONS ARE GIVEN IN FEET.
ALL CONVEYING DIMENSIONS ARE GIVEN ALONG THE ARC.
CONCRETE MONUMENTS.
LOT MARKERS ARE 1/2" IRON PIPES AND ARE IN LONG ALL BEARINGS ARE IN RELATION TO THE BEARINGS OF "CANTON OAKS SUBDIVISION" AS RECORDED IN THE MACOMB COUNTY RECORDS, LIBER 71 OF PLATS, PAGES 4, 5, AND 6. N.M. DENOTES NON RADIAL.

LOCATION MAP

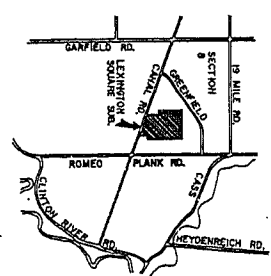

CERTIFIED TRUE COPY OF RECORDS ON FILE

Chas. E. Moore
LOREN E. MACHRE
STATE REGISTER
RECORDED
DATE: *Dec 21 1980*


NO.	STATUS	ARC	DELTA	TANGENT	CURVE	BEARING
1	STRIP	31.77	0.7126	18.51	31.22	N. 89°36'31" E.
2	STRIP	31.77	0.7126	18.51	31.22	N. 89°36'31" E.
CERTIFICATE of SURVEY

LIBER 3461 PAGE 311

A775966

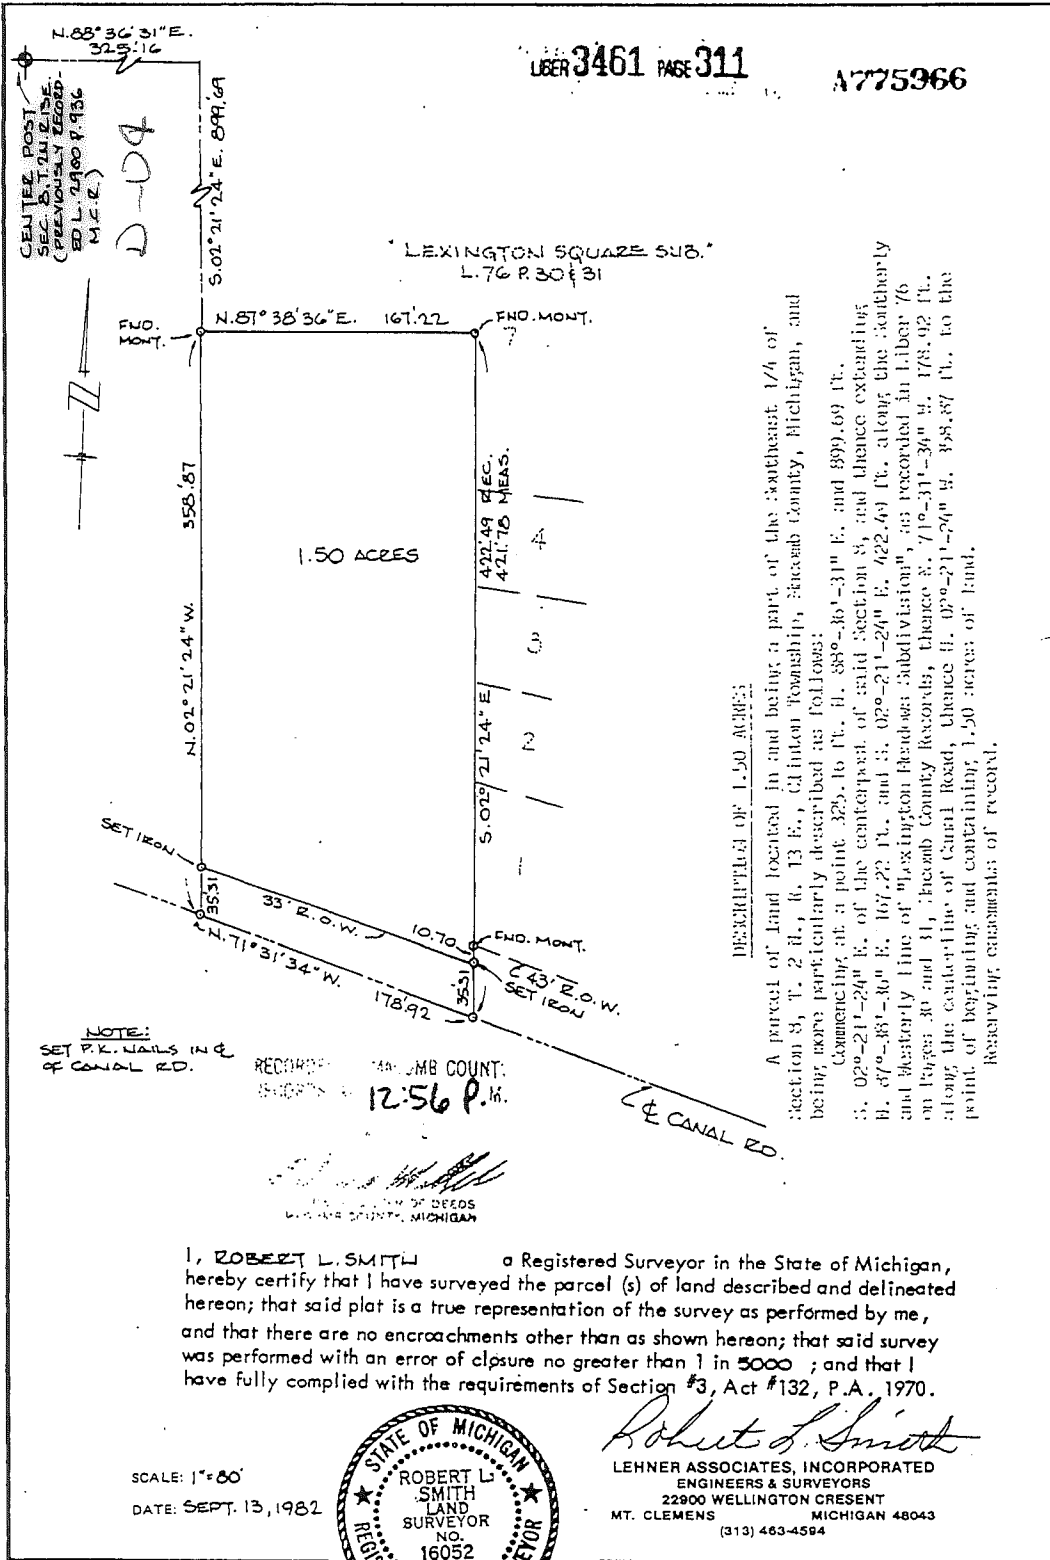

LEXINGTON SQUARE SUB.
L.76 R.30 P.31

1.50 ACRES

DESCRIPTION OF 1.50 ACRES

A parcel of land located in and being a part of the southeast 1/4 of Section 8, T. 2 R. 13 E., Clinton Township, Macomb County, Michigan, and being more particularly described as follows:
Commencing at a point 325.16 ft. N. 88°-36'-31" E. and 899.69 ft. N. 02°-21'-24" E. of the center of said Section 8; and thence extending N. 07°-38'-30" E. 167.22 ft. and S. 02°-21'-24" E. 422.69 ft. along the boundary line of Lexington Meadows Subdivision, as recorded in Liber 76 on Pages 30 and 31, Macomb County Records, thence S. 71°-31'-36" W. 178.92 ft. along the centerline of Canal Road, thence N. 02°-21'-24" E. 458.87 ft. to the point of beginning and containing 1.50 acres of land.
Reserving easements of record.


NOTE:
SET P.K. NAILS IN C
OF CANAL RD.

RECORDED IN MACOMB COUNTY
LIBER 3461 PAGE 311

Robert L. Smith
REGISTERED LAND SURVEYOR
MICHIGAN

I, ROBERT L. SMITH a Registered Surveyor in the State of Michigan, hereby certify that I have surveyed the parcel (s) of land described and delineated hereon; that said plat is a true representation of the survey as performed by me, and that there are no encroachments other than as shown hereon; that said survey was performed with an error of closure no greater than 1 in 5000; and that I have fully complied with the requirements of Section #3, Act #132, P.A. 1970.

SCALE: 1"=80'
DATE: SEPT. 13, 1982

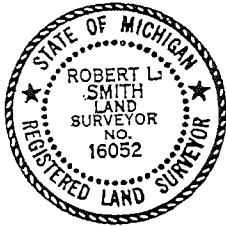

Robert L. Smith
LEHNER ASSOCIATES, INCORPORATED
ENGINEERS & SURVEYORS
22900 WELLINGTON CRESENT
MT. CLEMENS MICHIGAN 48043
(313) 463-4594

82-315 J.L. ZUDOLPH.

3


7

8

CERTIFICATE of SURVEY

LIBER 3785 PAGE 676

A944363

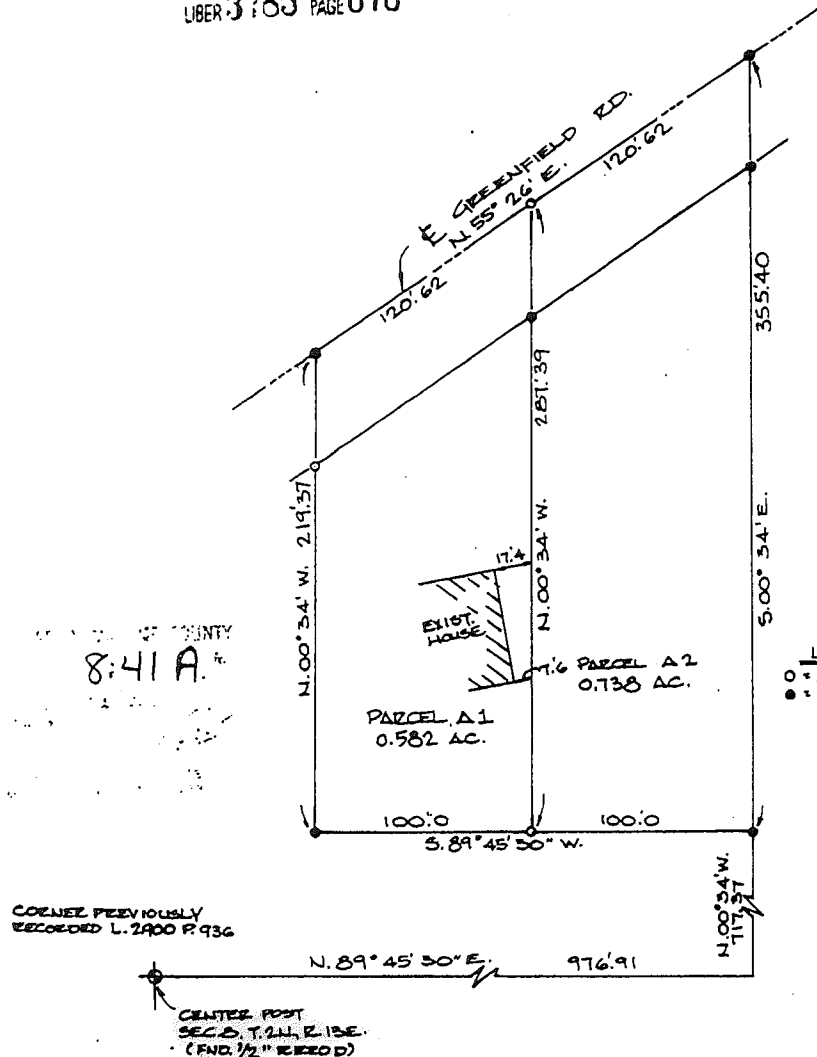

8:41 A.

I, **ROGER J. STECKER**, a Registered Surveyor in the State of Michigan, hereby certify that I have surveyed the parcel (s) of land described and delineated hereon; that said plat is a true representation of the survey as performed by me, and that there are no encroachments other than as shown hereon; that said survey was performed with an error of closure no greater than 1 in 5000; and that I have fully complied with the requirements of Section 23, Act 2132, P.A. 1970.

SCALE: 1" = 60'
DATE: 5/17/85



Roger J. Stecker
LEHMAN ASSOCIATES, INCORPORATED
 2800 WILLOWHURST DRIVE
 ST. CLERIX, MICHIGAN 48043
 (313) 488-4884

84-305 GEO. CLERIX
 SHEET 1 OF 2 SHEETS

7D

NCD

3

9

DESCRIPTION OF PARCEL A-2 (0.738 ACRES)

A parcel of land located in and being a part of the W. 1/2 of N.E. 1/4 of Section 8, T.2 N., R.13 E., Clinton Township, Macomb County, Michigan, and being more particularly described as follows:

Commencing at a point 976.91 ft. N.89°-45'-30"E. and 717.37 ft. N.00°-34'W. from the center post of said Section 8 and thence extending S.89°-45'-30"W. 100.0 ft., thence N.00°-34'W. 287.39 ft., thence N.55°-26'E. 120.62 ft. along the centerline of Greenfield Rd., thence S.00°-34'E. 355.40 ft. to the point of beginning and containing 0.738 acres of land.


Reserving easements of record.

DESCRIPTION OF PARCEL A-1 (0.582 ACRES)

A parcel of land located in and being a part of the W. 1/2 of the N.E. 1/4 of Section 8, T.2 N., R.13 E., Clinton Township, Macomb County, Michigan, and being more particularly described as follows:

Commencing at a point 976.91 ft. N.89°-45'-30"E., 717.37 ft. N.00°-34'W. and 100.0 ft. S.89°-45'-30"W. from the center post of said Section 8 and thence extending S.89°-45'-30"W. 100.0 ft., thence N.00°-34'W. 219.37 ft., thence N.55°-26'E. 120.62 ft. along the centerline of Greenfield Rd., thence S.00°-34'W. 287.39 ft. to the point of beginning and containing 0.582 acres of land.

Reserving easements of record.

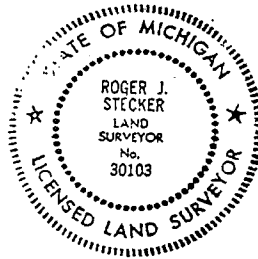


Roger J. Stecker

LEHNER ASSOCIATES, INCORPORATED
ENGINEERS & SURVEYORS
2300 WELLINGTON CIRCLE
MT. CLEMENS MICHIGAN 48043
(313) 480-4804

DATE: 5/17/85



ALDEN SQUARE SUBDIVISION

PART OF THE SOUTH 1/2 OF SECTION 8, T.2N, R.13E.,
CLINTON TOWNSHIP, MACOMB COUNTY, MICHIGAN

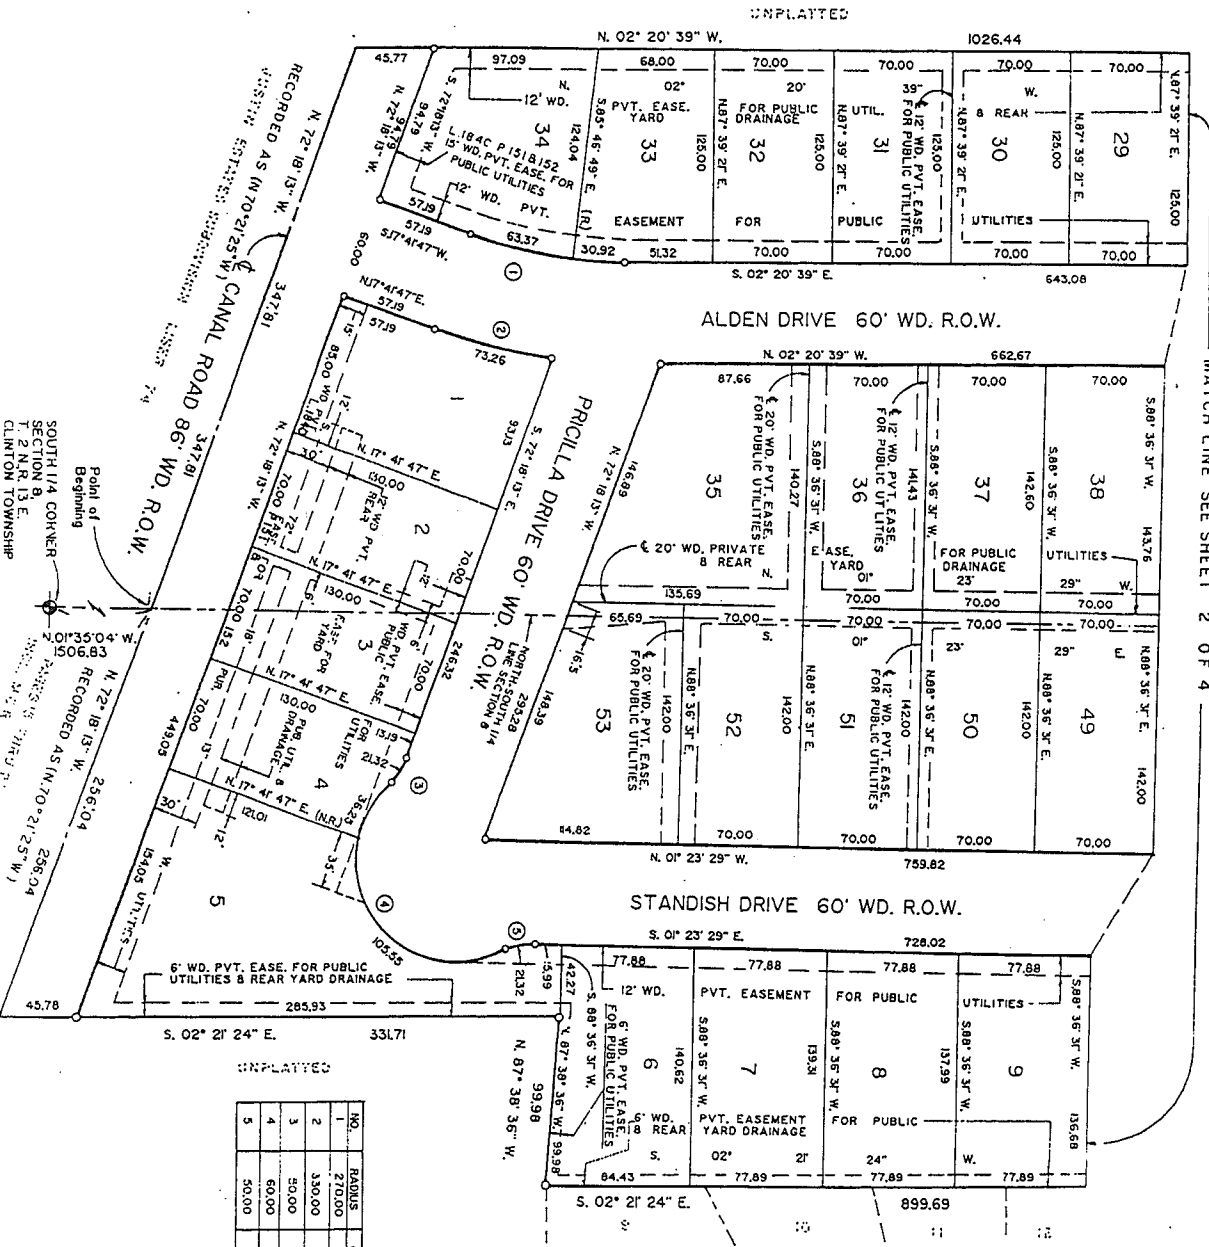

ALDEN SQUARE SUBDIVISION

PART OF THE SOUTH 1/2 OF SECTION 8, T.2N., R.13E.,
CLINTON TOWNSHIP, MACOMB COUNTY, MICHIGAN

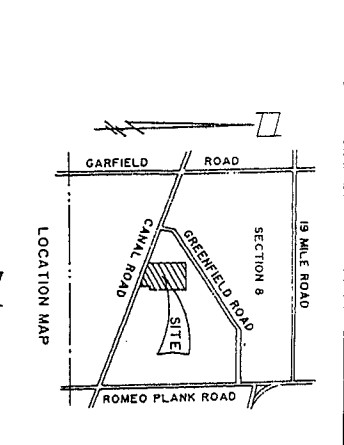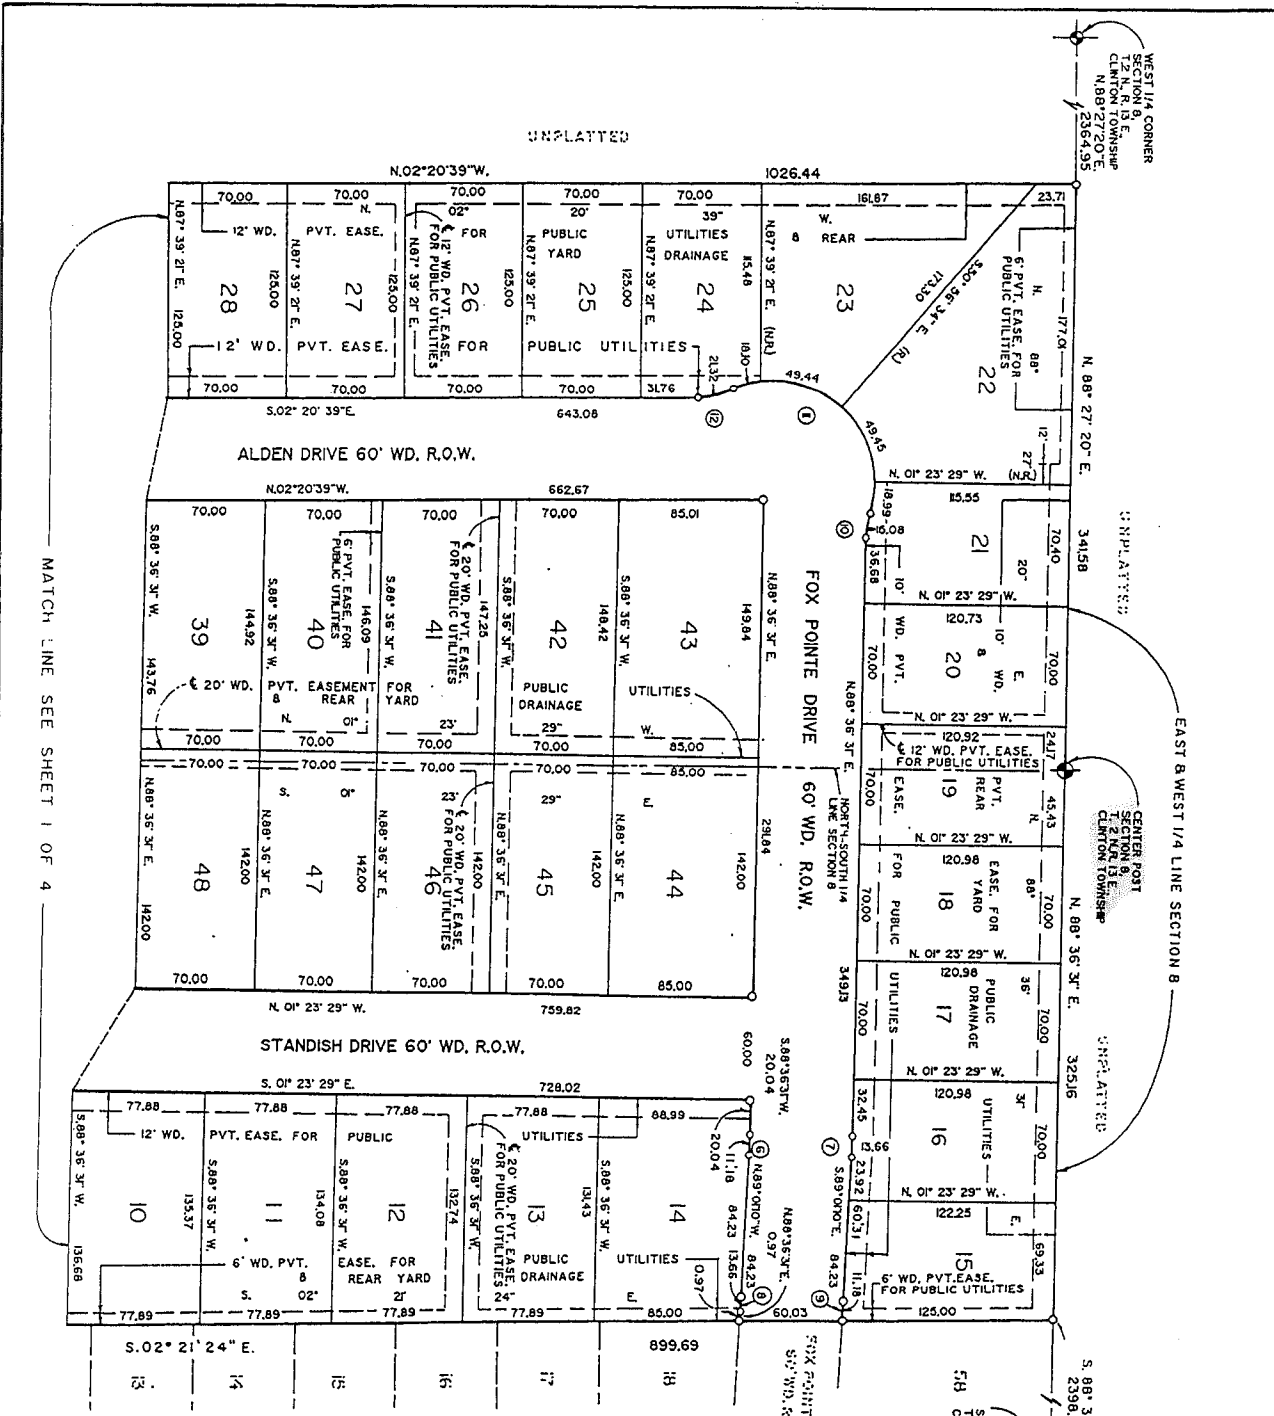

SCALE = 1" = 50'

PLAT LEGEND
 ALL DIMENSIONS ARE SHOWN IN FEET.
 ALL CURVILINEAR DIMENSIONS ARE SHOWN ALONG THE CHORD.
 THE SYMBOL \odot INDICATES A 4" DIAMETER MONUMENT WITHIN 18" FROM CENTER CONC.
 (R) INDICATES RADIAL LOT LINES.
 (NR) INDICATES NOT RADIAL LOT LINES.
 THERE SHALL BE NO DIRECT VEHICULAR ACCESS TO CANAL ROAD FROM LOTS 12, 3, 4, 5 & 34.
 ALL BEARINGS BASED ON THE WEST LINE OF LEXINGTON SQUARE SUB AS RECORDED IN LIBER 76 PAGES 30 & 31 THERE SHALL BE NO PRIVACY FENCES ON LOTS 12, 3, 4, 5 & 34.

NO.	RADIUS	CENT. ANGLE	ARC CHORD	CHD. BEARING
1	270.00	Δ 02° 22' 19"	11.18	N 89° 47' 40" E
2	270.00	Δ 02° 22' 19"	13.66	N 89° 47' 40" E
3	270.00	Δ 02° 22' 19"	11.18	N 89° 47' 40" E
4	330.00	Δ 02° 22' 19"	13.66	N 89° 47' 40" E
5	330.00	Δ 02° 22' 19"	16.13	N 89° 47' 40" E
6	330.00	Δ 02° 22' 19"	13.66	N 89° 47' 40" E
7	330.00	Δ 02° 22' 19"	16.13	N 89° 47' 40" E
8	330.00	Δ 02° 22' 19"	13.66	N 89° 47' 40" E
9	330.00	Δ 02° 22' 19"	16.13	N 89° 47' 40" E
10	330.00	Δ 02° 22' 19"	13.66	N 89° 47' 40" E
11	330.00	Δ 02° 22' 19"	16.13	N 89° 47' 40" E
12	330.00	Δ 02° 22' 19"	13.66	N 89° 47' 40" E

CURVE DATA

ROBERT L. SMITH, SECRETARY
 1111 W. WASHINGTON
 22900 WASHINGTON CRESCENT
 MT. CLEMENS, MICHIGAN 48043
 REGISTERED LAND SURVEYOR #60922

SHEET 2 OF 4



ALDEN SQUARE SUBDIVISION

PART OF THE SOUTH 1/2 OF SECTION 8, T.2N., R.13E., CLINTON TOWNSHIP, MACOMB COUNTY, MICHIGAN

COUNTY TREASURER'S CERTIFICATE

The records in my office show no unpaid taxes or special assessments for the five years preceding December 7, 1987, involving the lands included in this plat.

Rosemary Veczura
DEPUTY COUNTY TREASURER
COUNTY OF MACOMB

COUNTY DRAIN COMMISSIONER'S CERTIFICATE

Approved on 12/18/87, as complying with Section 192 of Act 289, P.A. 1967, and the applicable rule & regulations published by my office in the County of Macomb,

Thomas S. Nelson
THOMAS S. NELSON, COMMISSIONER
OF PUBLIC WORKS

CERTIFICATE OF COUNTY ROAD COMMISSIONER'S

Approved on 12/18/87 as complying with Section 183 of Act 288, P.A. 1967 and the applicable published rules and regulations of the Board of Road Commissioners of Macomb County.

Daniel J. Gubernik
DANIEL J. GUBERNIK, CHAIRMAN
John J. Gubernik
JOHN J. GUBERNIK, VICE CHAIRMAN
Mary Louise Diner
MARY LOUISE DINER, COMMISSIONER

CERTIFICATE OF MUNICIPAL APPROVAL

I certify that this plat was approved by the Township Board of the Township of Clinton, Michigan, on December 15, 1987 and was reviewed and found to be in compliance with Act 289, P.A. 1967 and that the public sewer and public water services have been provided and ready for use within this plat, and that the Township has adopted a subdivision map on or after and waives the minimum lot size specified in Section 186 of Act 289 and that survey is posted for one year to insure the placement of monuments and lot markers.

Debra J. Tomlinson
DEBRA J. TOMLINSON, TOWNSHIP CLERK

COUNTY PLAT BOARD CERTIFICATE

This plat has been reviewed and is approved by the Macomb County Plat Board on December 25, 1987 as being in compliance with all of the provisions of Act 289, P.A. 1967, and the plat board's applicable rules and regulations.

Mark A. Stehenski
MARK A. STEHENSKI
CHAIRMAN, COUNTY BOARD OF
COMMISSIONERS

Tom E. Rogozinski
TOM E. ROGOZINSKI
COUNTY TREASURER
Erna Miller
ERNA MILLER, CLERK
OF DEEDS

RECORDING CERTIFICATE

STATE OF MICHIGAN
MACOMB COUNTY


This plat was received for record on the 16th day of March, 1988 at 9:00 A.M. and recorded in Liber 84 of Plats on Pages 46-49.

Phillip A. Kropf
PHILLIP A. KROPF, DEPUTY
REGISTER OF DEEDS




Robert L. Smith
ROBERT L. SMITH, SECRETARY
LENNER ASSOCIATES INC.
22900 WELLSINGTON CRESCENT
MTC CLEMENS, MICHIGAN 48043
REGISTERED LAND SURVEYOR #46032

ANDREW'S KNOLL SUBDIVISION PART OF THE NE 1/4 OF SECTION 8, T2N, R13E, CLINTON TOWNSHIP, MACOMB COUNTY, MICHIGAN

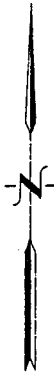


CURVE #	RADIUS	ARC	LONG CHORD	CHORD	DELTA
1	280.00	166.08	S19°19'12"E	163.66	33°59'05"
2	220.00	130.49	S19°19'12"E	128.59	33°59'05"

LEGEND
 ALL DIMENSIONS ARE SHOWN IN FEET.
 ALL CURVILINEAR DIMENSIONS ARE SHOWN ALONG THE CHORD.
 THE SYMBOL "o" INDICATES A 4" DIAMETER 36" LONG W/1/2" STEEL ROD CENTER CONCRETE MONUMENT.
 ALL LOT MARKERS ARE 1/2" STEEL RODS AND ARE 18" LONG (NO I.D. CAPS).
 (R) INDICATES RADIAL LOT LINES.
 (NR) INDICATES NOT RADIAL LOT LINES. BEARINGS BASED ON THE NORTHERLY LINE OF LEXINGTON SQUARE SUB. AS RECORDED IN LIBER 76, PAGES 30-31, INCL., MACOMB COUNTY RECORDS. THERE SHALL BE NO DIRECT VEHICULAR ACCESS TO GREENFIELD ROAD FROM LOTS 1 AND 23.

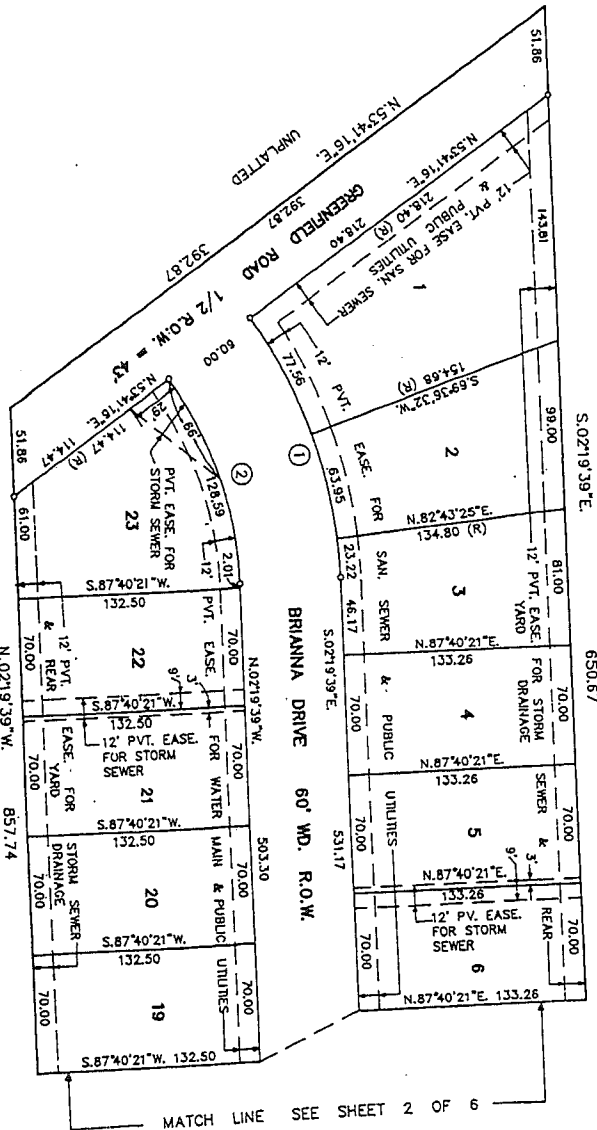

UNPLATTED

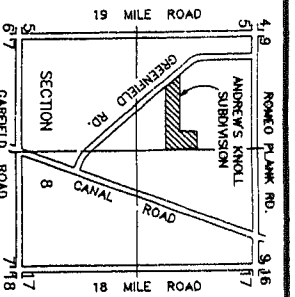

LOCATION MAP
NOT TO SCALE



CERTIFIED TRUE COPY OF
 RECORD OF SUBDIVISION
 BY DEPARTMENT OF COMMERCIAL
 REGISTERED PROFESSIONAL LAND SURVEYOR
 Robert L. Smith
 License No. 10032
 06/19/74






ROBERT L. SMITH
Robert L. Smith

ANDREW'S KNOLL SUBDIVISION PART OF THE NE 1/4 OF SECTION 8, T.2N, R.13E, CLINTON TOWNSHIP, MACOMB COUNTY, MICHIGAN

CURVE #	RADIUS	ARC	LONG. CHORD	CHORD	DELTA
3	20.00	31.42	N.47°19'39"W.	28.28	90°00'00"
4	60.00	36.22	S.14°58'05"W.	35.68	34°35'28"
5	60.00	166.70	S.68°08'43"W.	118.03	159°10'56"
6	60.00	36.22	N.70°22'37"E.	35.68	34°35'28"

LEGEND

ALL DIMENSIONS ARE SHOWN IN FEET.
ALL CURVILINEAR DIMENSIONS ARE SHOWN ALONG THE CHORD.
THE SYMBOL "o" INDICATES A 4" DIAMETER 36" LONG W/1/2" STEEL ROD CENTER CONCRETE MONUMENT.
ALL LOT MARKERS ARE 1/2" STEEL RODS AND ARE 18" LONG (NO I.D. CAPS).
(R) INDICATES RADIAL LOT LINES.
(NR) INDICATES NOT RADIAL LOT LINES.
BEARINGS BASED ON THE NORTHERLY LINE OF LEXINGTON SQUARE SUB. AS RECORDED IN LIBER 76, PAGES 30-31, INCL., MACOMB COUNTY RECORDS.
THERE SHALL BE NO DIRECT VEHICULAR ACCESS TO GREENFIELD ROAD FROM LOTS 1 AND 21.

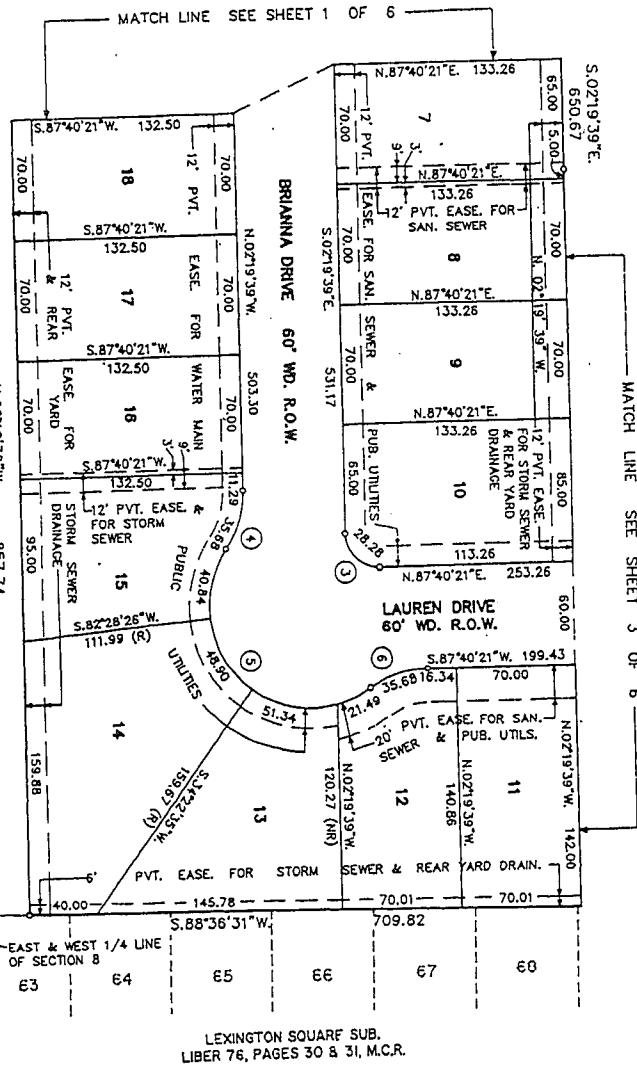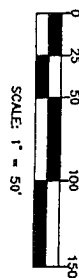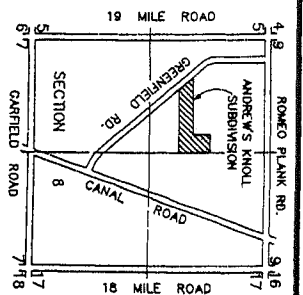

CENTER POST
SECTION 8,
T.2N, R.13E,
C.R.C.
L.2900, P.936

ROBERT L. SMITH

021974

ANDREW'S KNOLL SUBDIVISION


PART OF THE NE 1/4 OF SECTION 8, T.2N., R.13E.,
CLINTON TOWNSHIP, MACOMB COUNTY, MICHIGAN

CURVE DATA


CURVE #	RADIUS	ARC	LONG. CHORD	CHORD	DELTA
7	20.00	31.42	N.47°19'39"W.	26.28	90°00'00"
8	60.00	8.22	S.75°01'59"E.	35.68	34°25'19"
9	60.00	16.89	S.42°40'21"W.	118.02	158°10'37"
10	60.00	36.22	S.19°37'18"E.	35.68	34°25'19"

LEGEND

ALL DIMENSIONS ARE SHOWN IN FEET.
ALL CURVILINEAR DIMENSIONS ARE SHOWN ALONG THE CHORD.
THE SYMBOL "o" INDICATES A 4" DIAMETER 36" LONG W/1/2" STEEL ROD CENTER CONCRETE MONUMENT.
ALL LOT MARKERS ARE 1/2" STEEL RODS AND ARE 18" LONG (NO I.D. CAPS).
(R) INDICATES RADIAL LOT LINES.
(NR) INDICATES NOT RADIAL LOT LINES.
BEARINGS BASED ON THE NORTHERLY LINE OF LEXINGTON SQUARE SUB. AS RECORDED IN LIBER 76, PAGES 30-31, INCL., MACOMB COUNTY RECORDS.
THERE SHALL BE NO DIRECT VEHICULAR ACCESS TO GREENFIELD ROAD FROM LOTS 1 AND 23.

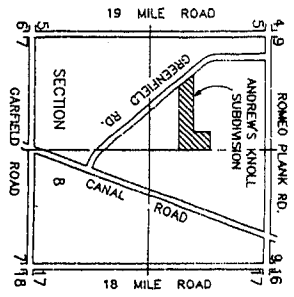

HIDDENBROOK CONDOMINIUMS
LIBER 4369, PAGES 132-105, M.C.R.

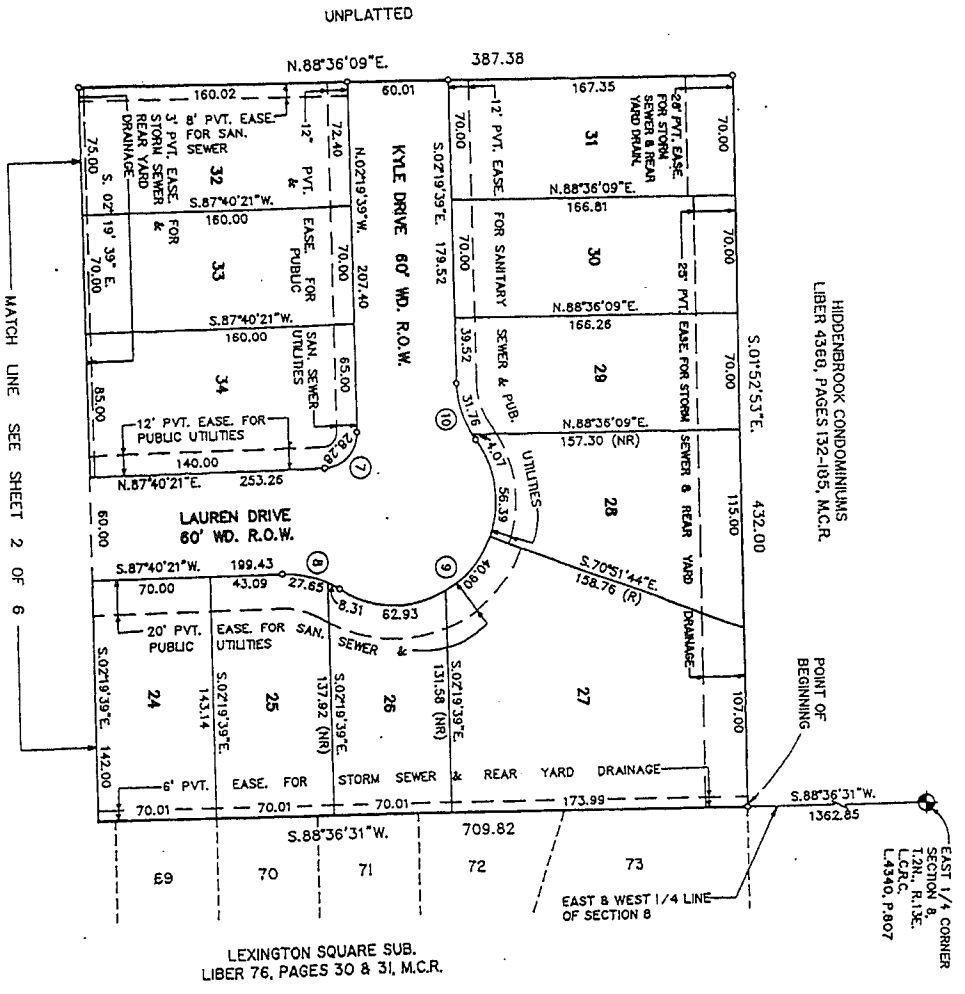

LEXINGTON SQUARE SUB.
LIBER 76, PAGES 30 & 31, M.C.R.



ROBERT L. SMITH

ANDREW'S KNOLL SUBDIVISION PART OF THE NE 1/4 OF SECTION 8, T.2N, R.13E., CLINTON TOWNSHIP, MACOMB COUNTY, MICHIGAN

I, ROBERT L. SMITH, SURVEYOR, CERTIFY:
THAT I HAVE SURVEYED, DIVIDED AND MAPPED THE LAND SHOWN ON THIS PLAT, DESCRIBED AS FOLLOWS:

ANDREW'S KNOLL SUBDIVISION

PART OF THE N.E. 1/4 OF SECTION 8, T.2N., R.13E., CLINTON TOWNSHIP, MACOMB COUNTY, MICHIGAN, AND BEING MORE PARTICULARLY DESCRIBED AS FOLLOWS:
BEGINNING AT A POINT 136295 FT. 5.98'36.31"W. ALONG THE EAST AND WEST 1/4 LINE OF SAID SECTION 8 FROM THE EAST 1/4 CORNER OF SAID SECTION 8; THENCE S.89°36'31"W. 709.82 FT.; ALONG THE NORTH LINE LEXINGTON SQUARE SUBDIVISION AS RECORDED IN LIBER 76, PAGES 30 & 31, MACOMB COUNTY RECORDS; THENCE N.02°19'39"W. 857.74 FT.; THENCE N.53°41'16"E. 392.87 FT. ALONG THE CENTERLINE OF GREENFIELD ROAD 196' WD. ROW; THENCE S.02°19'39"E. 650.67 FT.; THENCE N.89°36'09"E. 387.28 FT.; THENCE S.01°52'53"E. 432.00 FT. ALONG THE WEST LINE OF HIDDENBROOK CONDOMINIUMS AS RECORDED IN LIBER 4369, PAGES 132 THRU 185 INCL., MACOMB COUNTY RECORDS TO THE POINT OF BEGINNING AND CONTAINING 10.80 ACRES OF LAND, AND CONTAINING 34 LOTS NUMBERED 1 THRU 34, INCLUSIVE.

THAT I HAVE MADE SUCH SURVEY, LAND DIVISION AND PLAT BY THE DIRECTION OF THE OWNERS OF SUCH LAND.

THAT SUCH PLAT IS CORRECT REPRESENTATION OF ALL THE EXTERIOR BOUNDARIES OF THE LAND SURVEYED AND THE SUBDIVISION OF IT.

THAT THE REQUIRED MONUMENTS AND LOT MARKERS HAVE BEEN LOCATED IN THE GROUND OR THAT SURETY HAS BEEN DEPOSITED WITH THE MUNICIPALITY, AS REQUIRED BY SECTION 125 OF THE ACT.

THAT THE ACCURACY OF SURVEY IS WITHIN THE LIMITS REQUIRED BY SECTION 126 OF THE ACT. THAT THE BEARINGS SHOWN ON THE PLAT ARE EXPRESSED AS REQUIRED BY SECTION 126 (3) OF THE ACT AND AS EXPLAINED IN THE LEGEND.

DATE: 5-27-92



LEHNER ASSOCIATES, INC.
22900 WELLINGTON CRESCENT
MT. CLEMENS, MICHIGAN 48043

Robert L. Smith
ROBERT L. SMITH
REGISTERED LAND SURVEYOR NO. 16052
SECRETARY-LEHNER ASSOCIATES, INC.

PROPRIETOR'S CERTIFICATE

CREATIVE PHASE BUILDING, INC., A CORPORATION DULY ORGANIZED AND EXISTING UNDER THE LAWS OF THE STATE OF MICHIGAN BY BRYAN C. SAAO, PRESIDENT AND JAMES J. SAAO, JR., VICE PRESIDENT AS PROPRIETOR, HAS CAUSED THE LAND TO BE SURVEYED, DIVIDED, MAPPED AND DEDICATED AS REPRESENTED ON THIS PLAT AND THAT THE STREETS ARE FOR THE USE OF THE PUBLIC; THAT THE PUBLIC UTILITY EASEMENTS ARE PRIVATE EASEMENTS AND THAT ALL OTHER EASEMENTS ARE FOR THE USES SHOWN ON THE PLAT, AND THAT THERE SHALL BE NO DIRECT VEHICULAR ACCESS TO GREENFIELD ROAD, FROM LOTS 1 AND 23.

WITNESSES:

W. S. VANCE
ROBERT S. PRETRICK

J. VANCE
JOHANNIE VANCE

CREATIVE PHASE BUILDING, INC.
19305 CLINTON RIVER ROAD
MT. CLEMENS, MI 48044

Bryan C. Saao
BRYAN C. SAAO, PRESIDENT

James J. Saao, Jr.
JAMES J. SAAO, JR., VICE PRESIDENT



Robert L. Smith
ROBERT L. SMITH

ACKNOWLEDGEMENTS
STATE OF MICHIGAN) S.S.
MACOMB COUNTY)

PERSONALLY CAME BEFORE ME THIS 24th DAY OF May, 1992,
BRYAN C. SAAO, PRESIDENT AND JAMES J. SAAO, JR., VICE PRESIDENT OF THE ABOVE NAMED CORPORATION, TO ME KNOWN TO BE THE PERSONS WHO EXECUTED THE FOREGOING INSTRUMENT, AND TO ME KNOWN TO BE SUCH PRESIDENT AND VICE PRESIDENT OF SAID CORPORATION, AND ACKNOWLEDGED THAT THEY EXECUTED THE FOREGOING INSTRUMENT AS SUCH OFFICERS AS THE FREE ACT AND DEED OF SAID CORPORATION, BY ITS AUTHORITY.

Ellen A. Dobe
NOTARY PUBLIC ELEN A. DOBE MACOMB COUNTY, MICHIGAN
MY COMMISSION EXPIRES: August 23, 1993

**ANDREW'S KNOLL SUBDIVISION
PART OF THE NE 1/4 OF SECTION 8, T2N, R13E,
CLINTON TOWNSHIP, MACOMB COUNTY, MICHIGAN**

PROPRIETOR'S CERTIFICATE

WE AS PROPRIETORS CERTIFY THAT WE CAUSED THE LAND EMBRACED IN THIS PLAT TO BE SURVEYED, DIVIDED, MAPPED AND DEDICATED AS REPRESENTED ON THIS PLAT AND THAT THE STREETS ARE FOR THE USE OF THE PUBLIC; THAT THE PUBLIC UTILITY EASEMENTS ARE PRIVATE EASEMENTS AND THAT ALL OTHER EASEMENTS ARE FOR THE USES SHOWN ON THE PLAT; AND THAT THERE SHALL BE NO DIRECT VEHICULAR ACCESS TO GREENFIELD ROAD FROM LOTS 1 AND 23.

WITNESSES:

Peter Clemens
PIETRO GIRANNI, A SINGLE MAN
18258 GREENFIELD
MT. CLEMENS, MI 48044

John Wallace
JOHN WALLACE

Nicola Giranni
NICOLA GIRANNI, A MARRIED MAN
Victoria Giranni
VITTORIA GIRANNI

ACKNOWLEDGEMENTS

STATE OF MICHIGAN) S.S.
MACOMB COUNTY

PERSONALLY CAME BEFORE ME THIS 1st DAY OF July 1974 THE ABOVE NAMED PIETRO GIRANNI, AND NICOLA GIRANNI, HUSBAND AND WIFE, TO ME KNOWN TO BE THE PERSONS WHO EXECUTED THE FOREGOING INSTRUMENT AND ACKNOWLEDGED THAT THEY EXECUTED THE SAME AS THEIR FREE ACT AND DEED,

Debra A. Hamme
NOTARY PUBLIC DEBRA A. HAMME
MACOMB COUNTY, MICHIGAN

MY COMMISSION EXPIRES: 12/17/73

PROPRIETOR'S CERTIFICATE

WE AS PROPRIETORS CERTIFY THAT WE CAUSED THE LAND EMBRACED IN THIS PLAT TO BE SURVEYED, DIVIDED, MAPPED AND DEDICATED AS REPRESENTED ON THIS PLAT AND THAT THE STREETS ARE FOR THE USE OF THE PUBLIC; THAT THE PUBLIC UTILITY EASEMENTS ARE PRIVATE EASEMENTS AND THAT ALL OTHER EASEMENTS ARE FOR THE USES SHOWN ON THE PLAT; AND THAT THERE SHALL BE NO DIRECT VEHICULAR ACCESS TO GREENFIELD ROAD FROM LOTS 1 AND 23.

WITNESSES:

David H. Donze
DAVID H. DONZE, A MARRIED MAN
18160 GREENFIELD
MT. CLEMENS, MI 48044

Michelle Dombrowski
MICHELLE DOMBROWSKI

Catherine L. Donze
CATHERINE L. DONZE

ACKNOWLEDGEMENTS
STATE OF MICHIGAN) S.S.
MACOMB COUNTY

PERSONALLY CAME BEFORE ME THIS 1st DAY OF July 1974 THE ABOVE NAMED DAVID H. DONZE AND CATHERINE L. DONZE, HUSBAND AND WIFE, TO ME KNOWN TO BE THE PERSONS WHO EXECUTED THE FOREGOING INSTRUMENT AND ACKNOWLEDGED THAT THEY EXECUTED THE SAME AS THEIR FREE ACT AND DEED.

Debra A. Hamme
NOTARY PUBLIC DEBRA A. HAMME
MACOMB COUNTY, MICHIGAN

MY COMMISSION EXPIRES: 12/17/73

PROPRIETOR'S CERTIFICATE

WE AS PROPRIETORS CERTIFY THAT WE CAUSED THE LAND EMBRACED IN THIS PLAT TO BE SURVEYED, DIVIDED, MAPPED AND DEDICATED AS REPRESENTED ON THIS PLAT AND THAT THE STREETS ARE FOR THE USE OF THE PUBLIC; THAT THE PUBLIC UTILITY EASEMENTS ARE PRIVATE EASEMENTS AND THAT ALL OTHER EASEMENTS ARE FOR THE USES SHOWN ON THE PLAT; AND THAT THERE SHALL BE NO DIRECT VEHICULAR ACCESS TO GREENFIELD ROAD FROM LOTS 1 AND 23.

WITNESSES:

George R. Czeiszberger
GEORGE R. CZEISZBERGER, A MARRIED MAN
129 BELLEVUE
MT. CLEMENS, MI 48043

Madonna A. Czeiszberger
MADONNA A. CZEISZBERGER

ACKNOWLEDGEMENTS

STATE OF MICHIGAN) S.S.
MACOMB COUNTY

PERSONALLY CAME BEFORE ME THIS 1st DAY OF July 1974 THE ABOVE NAMED GEORGE R. CZEISZBERGER AND MADONNA A. CZEISZBERGER, HUSBAND AND WIFE, TO ME KNOWN TO BE THE PERSONS WHO EXECUTED THE FOREGOING INSTRUMENT AND ACKNOWLEDGED THAT THEY EXECUTED THE SAME AS THEIR FREE ACT AND DEED.

Debra A. Hamme
NOTARY PUBLIC DEBRA A. HAMME
MACOMB COUNTY, MICHIGAN

MY COMMISSION EXPIRES: 12/17/73



Robert L. Smith
ROBERT L. SMITH

**ANDREW'S KNOLL SUBDIVISION
PART OF THE NE 1/4 OF SECTION 8, T2N, R13E,
CLINTON TOWNSHIP, MACOMB COUNTY, MICHIGAN**

COUNTY TREASURER'S CERTIFICATE

THE RECORDS IN MY OFFICE SHOW NO UNPAID TAXES OR SPECIAL ASSESSMENTS FOR THE FIVE (5) YEARS PRECEDING March 14, 1992 INVOLVING THE LANDS INCLUDED IN THIS PLAT.

Miss Dorothy
MACOMB COUNTY TREASURER'S OFFICE
LORI WITTI, DEPUTY TREASURER

COUNTY DRAIN COMMISSIONER'S CERTIFICATE

APPROVED ON June 29, 1992 AS COMPLYING WITH SECTION 192 OF ACT 288, P.A. 1967, AND THE APPLICABLE RULES AND REGULATIONS PUBLISHED BY MY OFFICE IN THE COUNTY OF MACOMB.

Thomas S. Welsh
THOMAS S. WELSH, MACOMB COUNTY DRAIN COMMISSIONER

CERTIFICATE OF COUNTY ROAD COMMISSIONERS

APPROVED ON July 14, 1992 AS COMPLYING WITH SECTION 183 OF ACT 288, P.A. 1967 AND THE APPLICABLE RULES AND REGULATIONS OF THE BOARD OF ROAD COMMISSIONERS OF MACOMB COUNTY.

Mary Louise Damer
MARY LOUISE DAMER, CHAIRPERSON
John V. Zeccola
JOHN V. ZECCOLA, VICE CHAIRPERSON

Thomas S. Welsh
THOMAS S. WELSH, COMMISSIONER

CERTIFICATE OF MUNICIPAL APPROVAL

I CERTIFY THAT THIS PLAT WAS APPROVED BY THE BOARD OF TRUSTEES OF THE TOWNSHIP OF CLINTON, AT A MEETING HELD ON August 3, 1992 AND WAS REVIEWED AND FOUND TO BE IN COMPLIANCE WITH ACT 288, P.A. 1967, THAT THE LOTS CONFORM WITH THE LEGALLY ADOPTED ZONING SUBDIVISION CONTROL ORDINANCE OF THE TOWNSHIP, AND WAIVE THE MINIMUM LOT SIZES IN SECTION 186, ALSO THAT ADEQUATE SURETY HAS BEEN DEPOSITED WITH THE TOWNSHIP CLERK FOR THE PLACING OF MONUMENTS AND LOT MARKERS WITHIN A REASONABLE LENGTH OF TIME, NOT TO EXCEED ONE (1) YEAR FROM THE ABOVE DATE, AND THAT ADEQUATE SURETY HAS BEEN DEPOSITED FOR THE INSTALLATION OF THE PUBLIC SEWER AND PUBLIC WATER SERVICES.

Dennis C. Tomlinson
DENNIS C. TOMLINSON, TOWNSHIP CLERK

COUNTY PLAT BOARD CERTIFICATE

THIS PLAT HAS BEEN REVIEWED AND IS APPROVED BY THE MACOMB COUNTY PLAT BOARD ON September 17, 1992 AND BEING IN COMPLIANCE WITH ALL THE PROVISIONS OF ACT 288, P.A. 1967, AND THE PLAT BOARD'S RULES AND REGULATIONS.

Patrick J. Johnson
PATRICK J. JOHNSON, CHAIRPERSON OF THE COUNTY BOARD OF COMMISSIONERS

Adam E. Nowakowski
ADAM E. NOWAKOWSKI, MACOMB COUNTY TREASURER

Edna Miller
EDNA MILLER, CLERK REGISTER OF DEEDS

RECORDING CERTIFICATE

STATE OF MICHIGAN
COUNTY OF MACOMB

THIS PLAT WAS RECEIVED FOR RECORD ON THE 14th DAY OF October, 1992 A.D., AT 1:18 P.M., AND RECORDED IN LIBER 917 OF PLATS ON PAGE(S) 20-21


Daniel Kapp
DANIEL KAPP, DEPUTY REGISTER OF DEEDS



Robert L. Smith
ROBERT L. SMITH

GREENFIELD VILLA SUBDIVISION

PART OF THE NW/4 & NE/4 OF SECTION 8, T. 2N., R. 13E., CLINTON TOWNSHIP, MACOMB COUNTY, MICHIGAN.

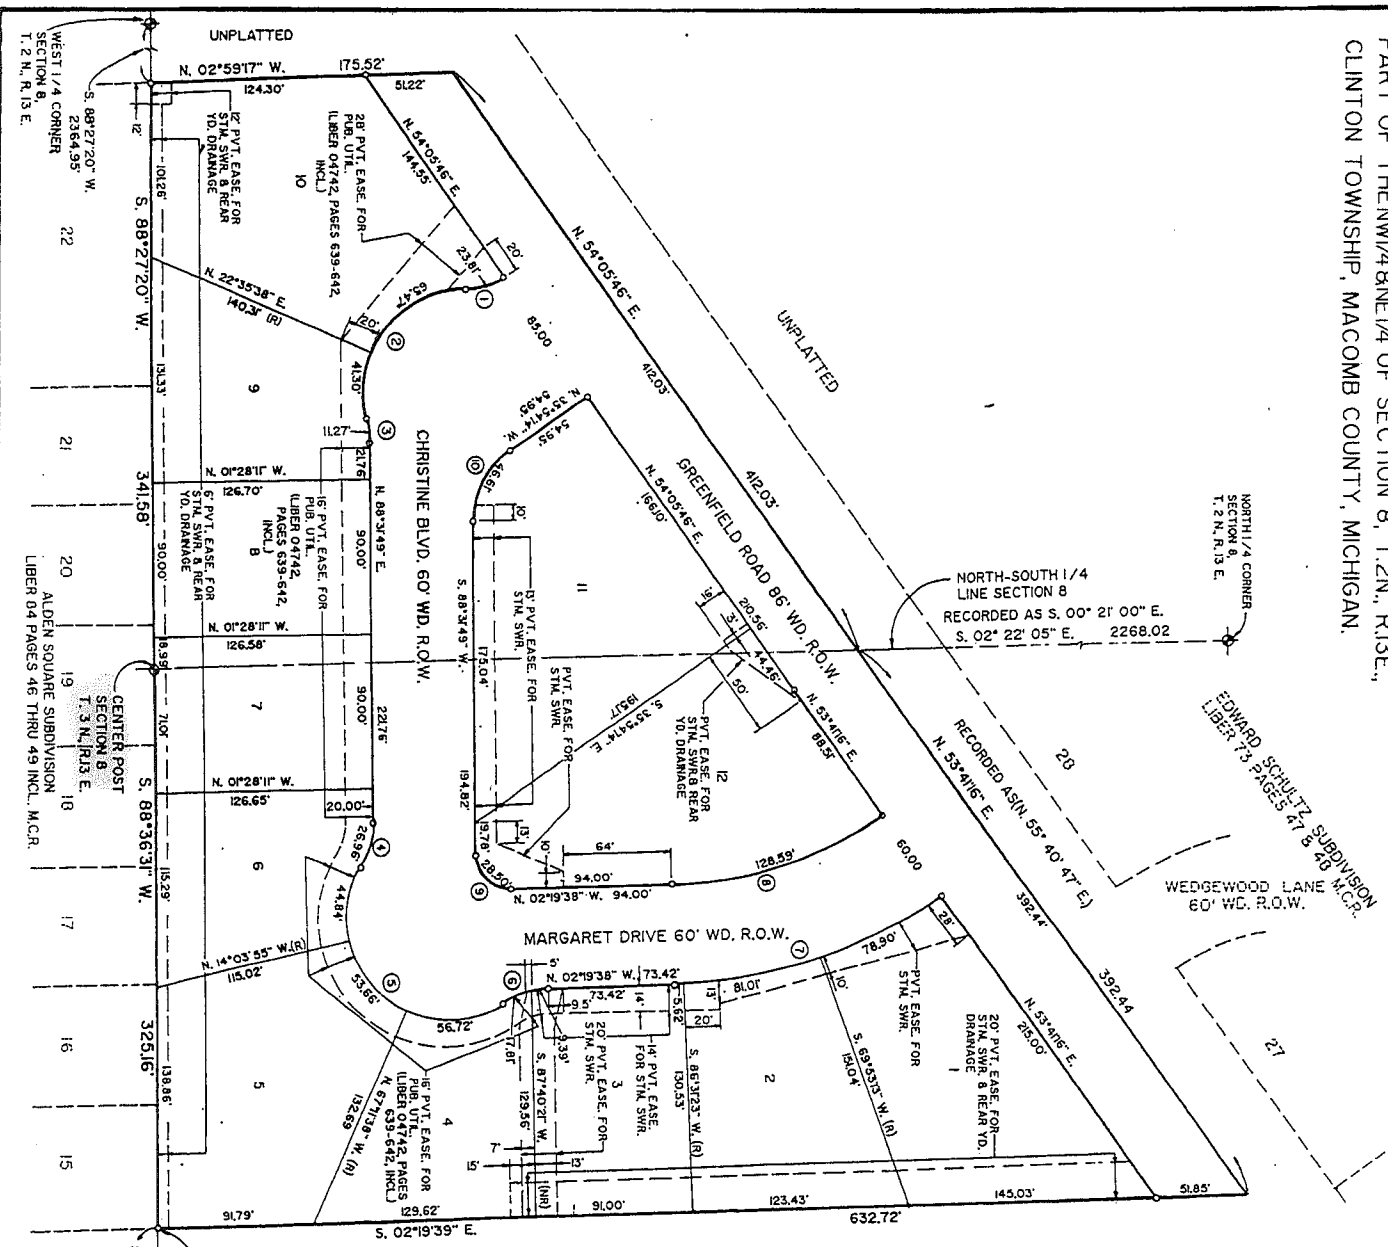

NORTH-SOUTH 1/4 LINE SECTION 8
RECORDED AS S. 00° 21' 00" E.
S. 02° 22' 05" E. 2268.02

EDWARD SCHULTZ SUBDIVISION
LIBER 73 PAGES 47 & 48 M.C.R.

WEDGEWOOD LANE
60' WD. R.O.W.

RECORDED AS IN 55° 40' 47" E.

N. 23° 41' 6" E. 88.5'

N. 53° 41' 6" E. 215.00'

N. 53° 41' 6" E. 392.44'




N. 53° 41' 6" E. 215.00'

N. 53° 41' 6" E. 392.44'

N. 53° 41' 6" E. 215.00'

N. 53° 41' 6" E. 392.44'

UNPLATTED

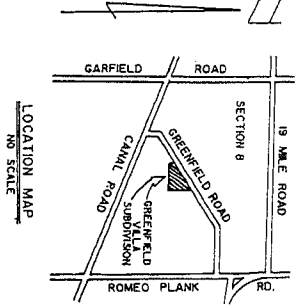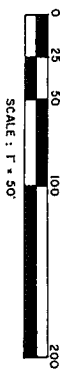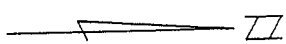

LEGEND
ALL DIMENSIONS ARE SHOWN IN FEET.
ALL CURVILINEAR DIMENSIONS ARE SHOWN ALONG THE CHORD.
THE SYMBOL "Ø" INDICATES A 4" DIAMETER HOLLOW W/1/2" IRON ROD CENTER CONCRETE ALL LOT MARKERS ARE 18" LONG 1/2 IRONS.
(R) INDICATES RADIAL LOT LINES.
(NR) INDICATES NON RADIAL LOT LINES.
THERE SHALL BE NO DIRECT VEHICULAR ACCESS TO GREENFIELD ROAD FROM LOTS 1, 10, 11, & 12. BEARINGS BASED ON ALDEN SQUARE SUBDIVISION AS RECORDED IN LIBER 84 PAGES 46 THRU 49 INCLUSIVE, MACOMB COUNTY RECORDS. THERE SHALL BE NO PRIVACY FENCES ON LOTS 1, 10, 11 AND 12.

CURVE #	RADIUS	ARC	CURVE DATA		
			LONG CHORD	CHORD BEARING	DELTA
1	40.00	27.92	S. 87° 52' 12" E.	58.08	34.3744
2	40.00	11.31	S. 84° 28' 14" E.	56.08	106.2328
3	40.00	11.31	N. 80° 28' 55" E.	11.27	18.1147
4	50.00	27.30	S. 75° 48' 35" E.	28.96	317.712
5	60.00	160.68	N. 43° 08' 05" E.	116.78	153.7252
6	60.00	27.30	N. 17° 58' 15" W.	26.96	317.712
7	290.00	166.08	S. 19° 19' 11" E.	83.66	33.59.05
8	220.00	190.49	N. 18° 51' 11" W.	123.59	33.59.05
9	200.00	32.72	S. 43° 05' 05" W.	28.50	90.58.28
10	500.00	48.49	N. 53° 41' 6" W.	46.61	53.33.37



EAST 1/4 CORNER SECTION 8, T. 2 N., R. 13 E., ALDEN SQUARE SUBDIVISION LIBER 76 PAGES 1 & 2 M.C.R.

POINT OF BEGINNING

S. 88° 36' 31" W. 2399.62'

ROBERT L. SMITH

GREENFIELD VILLA SUBDIVISION

PART OF THE NW/4 & NE/4 OF SECTION 8, T.2N., R.13E.,
CLINTON TOWNSHIP, MACOMB COUNTY, MICHIGAN.

I, Robert L. Smith, surveyor, certify:
That I have surveyed, divided and mapped the land shown on this plat,
described as follows:

GREENFIELD VILLA SUBDIVISION

Part of the NW/4 & NE/4 of Section 8, T.2 N., R.13 E., Clinton Township,
Macomb County, Michigan described as: Beginning at a point of the East
West 1/4 line of Section 8, said point 2398.62 Ft. - 5.89'-35"-31" W. from the
East 1/4 corner of said Section 8, thence along said East-West 1/4 line said
line also being the North line of "Alden Square Subdivision", as recorded in
Liber 84, Pages 46, 47 & 48, Macomb County Records; S. 188'-35"-31" W. 325.16
Ft. to the center post of said Section 8 and S. 188'-27"-20" W. 341.58 Ft.; thence
N. 02'-59"-24" E. 21.42 Ft. to the center line of Greenfield Road (68' W. of N. 04' N.)
the center line of which is also the South line of "Richard Schultz Subdivision"
as recorded in Liber 73, Pages 47 & 48, Macomb County Records; N. 53'-41"-16" E.
392.44 Ft.; thence S. 02'-19"-39" E. 632.72 Ft. to the point of beginning and
containing 6.183 acres of land also containing 12 lots numbered 1 thru 12
Inclusive

That I have made such survey, land division and plat by the direction
of the Owners of such land.

That such plat is a correct representation of all the exterior boundaries
of the land surveyed and the subdivision of it.

That the required monuments and lot markers have been located in the ground
of that survey has been deposited with the municipality, as required by
Section 125 of the Act.

That the accuracy of survey is within the limits required by Section 126 of
the Act.

That the bearings shown on the plat are expressed as required by Section 126
(3) of the Act and as explained in the Legend.

DATE AUGUST 1, 1989

LEINER ASSOCIATES, INC.
22900 WELLINGTON CRESCENT
MT. CLEMENS, MICHIGAN 48043

ROBERT L. SMITH
SECRETARY, RLS NO. 16052



CERTIFIED TRUE COPY OF
RECORDED PLAT
BY DEPARTMENT OF COMMERCE
of *Robert L. Smith*
Richard E. Lovick, L.S.
Manager Plat Section
on *March 16, 1990*

PROPRIETOR'S CERTIFICATE

Quad LTD, a Corporation duly organized and existing under the laws of the
State of Michigan by, Paul Youness, president and Salvatore Monteleone,
secretary and authorized representatives, have requested on this date and in the
presence of witnesses that the plat and map hereon shown be recorded and
are for the use of the public; that the public utility easements are private
easements and that all other easements are for the uses shown on the plat;
and that there shall be no direct vehicular access to Greenfield Road from
Lots 1, 10, 11 & 12, and that there shall be no privacy fences on Lots 1, 10, 11 and 12.

WITNESS

QUAD LTD, A Corporation
11318 Fenwood
Ulster, Michigan 48087

Paul Youness
THOMAS J. BRUNSKI
GARY M. COLDICOTT

Salvatore Monteleone
PAUL TOMASSI, PRESIDENT
of *Quad LTD*
SALVATORE MONTELEONE, SECRETARY

ACKNOWLEDGEMENT
STATE OF MICHIGAN } S.S.
MACOMB COUNTY }

Personally came before me this 2nd day of August, 1989
Paul Youness, president and Salvatore Monteleone, secretary of the above
named corporation, to me known to be the persons who executed the foregoing
instrument, and to me known to be such president and secretary of said
corporation and acknowledged that they executed the foregoing instrument as
such officers as they are in the act and deed of said corporation, by its authority.

DEBRA A. HAMME, NOTARY PUBLIC
MY COMMISSION EXPIRES 12/14/92
MACOMB COUNTY, MICHIGAN



Robert L. Smith
ROBERT L. SMITH

GREENFIELD VILLA SUBDIVISION
 PART OF THE NW1/4 & NE1/4 OF SECTION 8, T.2N., R.13E.,
 CLINTON TOWNSHIP, MACOMB COUNTY, MICHIGAN.

COUNTY TREASURER'S CERTIFICATE
 The records in my office show no unpaid taxes or special assessments for the five years preceding Aug. 3, 1949, involving the lands included in this plat.

Robert J. Dornick
 ROBERT J. DORNICK, DEPUTY COUNTY TREASURER, COUNTY OF MACOMB

COUNTY DRAIN COMMISSIONER'S CERTIFICATE
 Approved on 9/13/49 as complying with Section 192 of Act 288, P.A. 1967, and the applicable rules and regulations published by my office in the County of Macomb.

Thomas S. Welsh
 THOMAS S. WELSH, COMMISSIONER OF PUBLIC WORKS

CERTIFICATE OF COUNTY ROAD COMMISSIONER'S
 Approved on Oct 3, 1949 as complying with section 183 of Act 288, P.A. 1967 and the applicable published rules and regulations of the Board of Road Commissioners of Macomb County.

John J. Goggin
 JOHN J. GOGGIN, VICE CHAIRPERSON
 HARRY POLISE, CHAIRPERSON
Walter J. Goherty
 WALTER J. GOHERTY, COMMISSIONER

CERTIFICATE OF MUNICIPAL APPROVAL

I certify that this plat was approved by the Township Board of the Township of Clinton, at a meeting held August 5, 1949 and was reviewed and found to be in compliance with Act 288 P.A. of 1967 and that the public sewer and public water services have been installed and are ready for use within this plat. The Township Ordinance with the legally adopted zoning and subdivision control Ordinance of the Township and valves the minimum lot size specified in Section 186 of Act 289 and 101 markers is posted for one year to insure the placement of monuments and lot markers.

Dennis Tomlinson
 DENNIS TOMLINSON, TOWNSHIP CLERK

COUNTY PLAT BOARD CERTIFICATE

This plat has been reviewed and is approved by the Macomb County Plat Board on Sept 13, 1949 as being in compliance with all of the provisions of Act 288, P.A. 1967, and the plat board's applicable rules and regulations.

Mark X Steenberg
 MARK X STEENBERG, CHAIRMAN, COUNTY BOARD OF COMMISSIONERS
John T. Tomlonski
 JOHN T. TOMLONSKI, COUNTY TREASURER

Edw. Miller
 EDW. MILLER, CLERK, REGISTER OF DEEDS

RECORDING CERTIFICATE

STATE OF MICHIGAN
 MACOMB COUNTY
 This plat was received for record on the 11th day of January 1949 at 9:03 A.M. and recorded in Liber 127 of Plats on Page(s) 142-143

Phyllis D. Green
 PHYLLIS D. GREEN, DEPUTY REGISTER OF DEEDS



Robert L. Smith
 ROBERT L. SMITH

Andrew's Knoll Subdivision No. 2

PART OF THE N.E. 1/4 OF SECTION 8, T.2N., R.13E., CLINTON TOWNSHIP,
MACOMB COUNTY, MICHIGAN

SURVEYOR'S CERTIFICATE

I, James P. Fraus, Surveyor, certify that I have surveyed, divided and mapped the land as shown on this plat described as follows:
ANDREW'S KNOLL SUBDIVISION NO. 2

Part of the N.E. 1/4 of Section 8, T.2N., R.13E., Clinton Township, Macomb County, Michigan being more particularly described as follows: S. 61° 31' 30" W., 1352.85 feet along the East-West 1/4 line of East of section 8, thence N. 01° 55' 40" W., 432.00 feet along the East line of Andrew's Knoll Subdivision, (recorded in Liber 97, Page 25 through 30 Macomb County Records), being also the West line of "Hiddebrock Condominiums", thence along the boundary line of said "Hiddebrock Condominiums", S. 88° 33' 11" W., 387.48 feet thence in Knoll Subdivision boundary of said "Andrew's Knoll Subdivision", the following courses: N. 87° 40' 21" W., 02.19' 39" W., 490.00 feet; thence N. 02° 19' 39" W., 111.70 feet to the centerline of 108.40 feet thence S. 36° 21' 50" centerline, N. 53° 38' 10" R.; feet along the arc of a curve to the high point 300.00 feet; central angle 28° 27' 03"; chord bears S. 271° 08' 18" E., 17.44 feet; thence N. 88° 03' 53" E., 132.08 feet to a point on the East line of said "Hiddebrock Condominiums", thence continuing along the 491.89 feet of said "Hiddebrock Condominiums", S. 01° 55' 40" E., 16 lots numbered 35 through 50, both inclusive.

That I have made such survey, land division and plat by the direction of the owners of such land.
That such plat is a correct representation of all the exterior boundaries of the land surveyed and the subdivision of it.
That the required monuments and lot markers have been located in the ground or that they have been deposited with the municipality, as required by Section 125 of the Act.
That the accuracy of survey is within the limits required by Section 126 of the Act.
That the bearings shown on the plat are expressed as required by Section 126(3) of the Act and as explained in the legend.
Dated: July 9, 1996



James P. Fraus
Professional Surveyor
P.S. No. 17089

Nowak & Fraus, PLLC
1310 N. Stephenson Hwy.
Royal Oak, MI 48067

PROPRIETOR'S CERTIFICATE

A.R.E. Development Corporation, a Corporation duly organized and existing under the laws of the State of Michigan, by James J. Saad, Jr., President of the State of Michigan, Vice President as proprietor, has caused the land embraced in the above plat to be surveyed, divided, mapped and dedicated as represented on the plat attached, and the streets are for the use of the public; that the public utility easements are private easements and that all other easements are for the uses shown on the plat. There shall be no direct vehicular access to Greenfield Road from lot 50.

WITNESS:
James J. Saad, Jr.
James J. Saad, Jr. President
Maurice Cornwell
Maurice Cornwell

A.R.E. Development Corporation
40080 Greenfield Rd.
Clinton Twp., MI 48038
James Saad, Jr. President
Maurice Cornwell
Maurice Cornwell

ACKNOWLEDGEMENT

Personally came before me this 4th day of JULY, 1996, James J. Saad, Jr., President and Bryan C. Saad, Vice President of the above named Corporation, known to be the persons who executed the foregoing instrument and known to me to be such President and Vice President of said Corporation, that they executed the foregoing instrument as such officers of a free act and deed of said Corporation, by its authority.
Notary Public *Ralph Piana*, Macomb County, Michigan
My Commission Expires 4/13/00

PROPRIETOR'S CERTIFICATE

Me, as proprietor, certify that we caused the land embraced in this plat to be surveyed, divided, mapped and dedicated as shown on this plat and that the streets are for the use of the public; that the public utility easements are private easements and that all other easements are for the uses shown on the plat; there shall be no direct vehicular access to Greenfield Road from lot 50.

WITNESS:
Pietro Ciranni
Pietro Ciranni, a single man
18258 Greenfield
Mt. Clemens, MI 48044
Nicola Ciranni
Nicola Ciranni, a married man
18258 Greenfield
Mt. Clemens, MI 48044
Vittoria Ciranni
Vittoria Ciranni
18258 Greenfield
Mt. Clemens, MI 48044

ACKNOWLEDGEMENT
State of Michigan)
County of Macomb) S.S.
Personally came before me this 4th day of JULY, 1996, the above named Pietro Ciranni, Nicola Ciranni and Vittoria Ciranni, husband and wife, to me known to be the persons who executed the foregoing instrument and acknowledged that they executed the same as their free act and deed.
Notary Public *Ralph Piana*, Macomb County, Michigan
My Commission Expires 4/13/00

Notary Public *Ralph Piana*, Macomb County, Michigan
My Commission Expires 4/13/00

Andrew's Knoll Subdivision No. 2

PART OF THE N.E. 1/4 OF SECTION 8, T.2N., R.13E., CLINTON TOWNSHIP,
MACOMB COUNTY, MICHIGAN

COUNTY TREASURERS CERTIFICATE

The records in my office show no unpaid taxes or special assessments for the five year period preceding 7-9-96, 1996 involving the land in this plat.

[Signature]
M. Will, Deputy Treasurer
Macomb County, Michigan

COUNTY DRAIN COMMISSIONER'S CERTIFICATE

Approved on July 18, 1996 as complying with section 192 of Act 289, P.A. 1967 and the applicable rules and regulations published by my office in the County of Macomb.

[Signature]
Anthony V. Marocco, Macomb County Drain Commissioner

CERTIFICATE OF COUNTY ROAD COMMISSIONERS

Approved on July 23, 1996 as complying with section 183 of Act 289, P.A. 1967 and the applicable published rules and regulations of the Board of Road Commissioners of Macomb County.

[Signature]
MAY IRLING BAKER, Philipson
[Signature]
Thomas S. Keamy, Vice Chairman
[Signature]
John J. Joseph, Commissioner

CERTIFIED TRUE COPY OF
AS SUBMITTED TO THE
BY DEPARTMENT OF CONSUMERS
AND INDUSTRY SERVICES
BY *[Signature]*
MAYNARD & ARLY
MANAGER
SUBDIVISION CONTROL UNIT
DATE 10-15-96

CERTIFICATE OF MUNICIPAL APPROVAL

I hereby certify that this plat was approved by the Board of Trustees of Clinton Township, at a meeting held on August 12, 1996. The plat was reviewed and found to be in compliance with Act 289, P.A. 1967, and the applicable rules and regulations. The Township has adopted zoning and subdivision control ordinances and valves the minimum lot size required in Section 1664, Act 289, P.A. 1967. That adequate surety has been posted with the Township Clerk for the placing of monuments and lot markers within one year from the above date.

[Signature]
Dennis Tomlinson, Township Clerk

COUNTY PLAT BOARD CERTIFICATE

This plat has been reviewed and is approved by the Macomb County Plat Board on September 2, 1996, as being in compliance with all the provisions of Act 289, P.A. 1967, and the plat Board's applicable rules and regulations.

[Signature]
Dione J. Kolakowski, Chairman, Macomb County Board of Commissioners
[Signature]
Carmella Sabough, County Clerk, Register of Deeds

[Signature]
Ted B. Wandy, Macomb County Treasurer

RECORDING CERTIFICATE

State of Michigan)
County of Macomb)
This plat was received for record on the 1st day of October, 1996, A.D. at 11:48 o'clock P.M., and is recorded in Liber IV, of Plats, Page(s) 2, 3, 4, 5, 6.

[Signature]
Carmella Sabough, Clerk, Register of Deeds

