

LAND CORNER RECORDATION CERTIFICATE
Filing Requirement of Act 74, Mich. P.A. 1970

For corners in

<u>MACOMB</u> (County)	Located In:	Corner Code #
	CHESTERFIELD TOWNSHIP	
1. Public Land Survey	T <u>3N</u> R <u>14E</u>	<u>A-1</u>
	T _____ R _____	_____
	T _____ R _____	_____
	T _____ R _____	_____
2. Property Controlling in Section	S _____ T _____ R _____	_____
	S _____ T _____ R _____	_____
3. Miscellaneous Property in Sec.	S _____ T _____ R _____	_____
	S _____ T _____ R _____	_____

Register of Deeds Stamp & File Number

4. Lot No. _____, Recorded Plat _____
 5. Private Claims _____

1	A	B	C	D	E	F	G	H	I	J	K	L	M
2		6		5		4		3		2		1	
3													
4		7		8		9		10		11		12	
5													
6		18		17		16		15		14		13	
7													
8		19		20		21		22		23		24	
9													
10		30		29		28		27		26		25	
11													
12		31		32		33		34		35		36	
13													

I, CRAIG P. AMEY, in a field survey on May 25, 1994 do hereby certify that under requirements of P.A. 74, Michigan P.A. of 1970, the corner points mentioned in lines 1 and 2 above were in conformance with regulations and rules therefore as required in the current manual of survey instructions of the United States Department of the Interior, Bureau of Land Management or by a decree of a Court of Law and for that the corner points mentioned in lines 3, 4 and 5 above were in conformance with the rules of the Michigan Board of Land Surveyors or by a Decree of a Court of Law; established, re-established, monumented, re-monumented, recovered, found as expressed below:

NOTE: Not more than 4 corners, all in the same town and range, may be recorded on this certificate.

A. Description of original monument and accessories and/or subsequent restoration:

G.L.O. (1817)		William Preston	No witnesses remain
LCRC (1977)	L 2882 P 489	Herbert J. Kobs #14097	Found 1/2" pipe with spike in center
LCRC (1981)	L 3398 P 442	Robert L. Smith #16052	Found 1/2" pipe
LCRC (1987)	L 4340 P 806	Robert L. Smith #23505	Found 1/2" iron pipe

Corner is common to M-1 T3N, R13E; M-13 T4N, R13E; A-13 T4N, R14E

B. Description of corner evidence found and/or method applied in restoring or reestablishing corner:

Found 1/2" pipe in a monument box. This corner verified by: Found and matched all existing recorded witnesses.

LCRC Liber 2882 Page 489
 N 31.97' Concrete monument
 N 46.60' A pk in a 24" maple
 S 31.53' Concrete monument

LCRC Liber 3398 Page 442
 N 32.00' Iron in concrete r.o.w. Marker
 N40E 45.90' A pk in a 30" maple
 S 32.18' Nail in mbt pole

LCRC Liber 4340 Page 806
 N 31.97' Center of a concrete monument
 N 46.60' Pk in southeast face 30" tree
 S 31.53' Center of a concrete monument
 S 42.65' A pk in the northwest face of a twin 6" tree

ACCEPTED BY THE MACOMB COUNTY SURVEY PEER GROUP AS THE OFFICIAL CORNER UNDER MICHIGAN PUBLIC ACT 345 OF 1990 AT A MEETING HELD ON 9-27-94


William E. Soderberg
 WILLIAM E. SODERBERG, P.S., CHAIRMAN

C. Description of monument for corner and accessories established to perpetuate locating the position of the corner:

Replaced 1/2" pipe with a 3/4" x 24" iron and a Macomb County Remonumentation cap stamped: "MACOMB COUNTY MONUMENT", "34970", "MI ACT 345"

245- 66.52' Set a pk nail and MCR tag in the south face of a utility pole
 320- 54.02' Set a pk nail and MCR tag in the west face of a utility pole
 60- 71.79' Set a pk nail and MCR tag in the north face of a utility pole
 170- 128.74' Set a pk nail and MCR tag in the west face of a 36" maple

The selected location is accepted by me and is generally accepted by professional surveyors as the best available evidence of the position of the original corner.

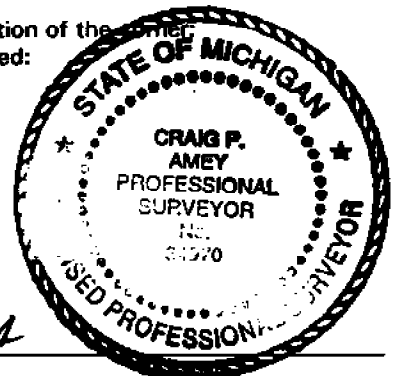

Signed by C. P. Amey
 Surveyor's Michigan License No. 34970

Date 12-15-94