

LAND CORNER RECORDATION CERTIFICATE
Filing Requirement of Act 74, Mich. P.A. 1970

For corners in

MACOMB
 (County)

CHESTERFIELD TOWNSHIP
 Located In: Corner Code #

2266002
LIBER 12434 PAGE 950
 11/08/2002 09:59:36 A.M.
 MACOMB COUNTY, MI SEAL
 CARNELLA SABAUGH, REGISTER OF DEEDS

1. Public Land Survey	T <u>3N</u> R <u>14E</u>	<u>K-2</u>
	T ___ R ___	_____
	T ___ R ___	_____
	T ___ R ___	_____
2. Property Controlling in Section	S ___ T ___ R ___	_____
	S ___ T ___ R ___	_____
3. Miscellaneous Property in Sec.	S ___ T ___ R ___	_____
	S ___ T ___ R ___	_____

Register of Deeds Stamp & File Number

4. Lot No. _____, Recorded Plat _____
 5. Private Claims _____

I, ROBERT H. BIRKETT, in a field survey on July 2002 do hereby certify that under requirements of P.A. 74, Michigan P.A. of 1970, the corner points mentioned in lines 1 and 2 above were in conformance with regulations and rules therefore as required in the current manual of survey instructions of the United States Department of the Interior, Bureau of Land Management or by a decree of a Court of Law and/or that the corner points mentioned in lines 3, 4 and 5 above were in conformance with the rules of the Michigan Board of Land Surveyors or by a Decree of a Court of Law; established, re-established, monumented, re-monumented, recovered, found as expressed below:

	A	B	C	D	E	F	G	H	I	J	K	L	M
1													
2		6		5		4		3		2	●	1	
3													
4		7		8		9		10		11		12	
5													
6		18		17		16		15		14		13	
7													
8		19		20		21		22		23		24	
9													
10		30		29		28		27		26		25	
11													
12		31		32		33		34		35		36	
13													

NOTE: Not more than 2 corners, all in the same town and range, may be recorded on this certificate.

A. Description of original monument and accessories and/or subsequent restoration:
 K-2 CHESTERFIELD
 1818, PRESTON GLO, SET WOOD POST, GENERAL LAND OFFICE FILE NOTES.
 1973, PATTERSON No. 17631, IRON, LCRC L. 2380, P. 496.
 1973, LANSKY No. 18659, FOUND IRON, SURVEY L. 2409, P. 555.
 1979, SMITH No. 16052, FOUND 1/2" PIPE, LCRC L. 3168, P. 946.
 1979, SMITH No. 16052, FOUND 1/2" PIPE, SURVEY L. 3169, P. 30.
 2000, FAZAL KHAN & ASSOC., FOUND PIPE, FIELD NOTES.
 2001, AEW, INC., FOUND 1/2" PIPE, CALCULATION SHEET FOR WATER MAIN PROJECT.



B. Description of corner evidence found and/or method applied in restoring or reestablishing corner:
 K-2 FOUND 1/2" PIPE, CENTER OF GRAVEL HOBARTH ROAD.
 RECOVERED 1/2" PIPE, 33.00' TO THE SOUTH.

FIELD MEASUREMENTS

K-2 TO K-1 : 2691.30 REMON (2002), GLO 40.00 CHAINS - 2640.00' (1818).
 K-2 TO K-3 : 2699.84 REMON (2002), 2699.64 AEW (2001), 2699.70 SMITH (1979), GLO 40.00 CHAINS - 2640.00' (1818).

C. Description of monument for corner and accessories established to perpetuate locating the position of the corner:
 REPLACED 1/2" PIPE WITH 3/4" RE-BAR CAPPED WITH AN ALUMINUM CAP STAMPED "MACOMB COUNTY MONUMENT, MI ACT 345, K-2, 41094."

10° - 31.29' - SET NAIL WITH REMON TAG IN WEST FACE UTILITY POLE.
 190° - 33.00' - FOUND 1/2" PIPE.
 250° - 73.79' - SET NAIL WITH REMON TAG IN NORTHWEST FACE UTILITY POLE AT DRIVE No. 34950.
 320° - 37.86' - CENTER TOP NUT FIRE HYDRANT.

THE SELECTED LOCATION IS ACCEPTED BY ME AND IS GENERALLY ACCEPTED BY PROFESSIONAL SURVEYORS AS THE BEST AVAILABLE EVIDENCE OF THE POSITION OF THE ORIGINAL CORNER.

ACCEPTED BY THE MACOMB COUNTY SURVEY PEER GROUP AS THE OFFICIAL CORNER UNDER MICHIGAN PUBLIC ACT 345 OF 1990 AT A MEETING HELD ON 7/30/02
 WILLIAM E. SODERBERG, P.S., CHAIRMAN

Signed by Robert H. Birkett Date 10/25/02
 Surveyor's Michigan License No. 41094

223-022 2002 Macomb Remon
6-20-02
BMS, JSS K-2 Chesterfield

^{Bent}
Fnd 1/2" Pipe in E Hobarth Rd.

Recovered 1/2" pipe 33.00' S.

190° 33.00'

Fnd 1/2" pipe

250° 73.79'

Set P.K. nail with remon
witness tag in NW face
of U.P. @ E side drive # 34950


320° 37.86'

E Top nut Fire Hydrant

10° 31.29'

Set P.K. with remon tag
in W. face U.P. N. side
Hobarth rd.


No 1937 28

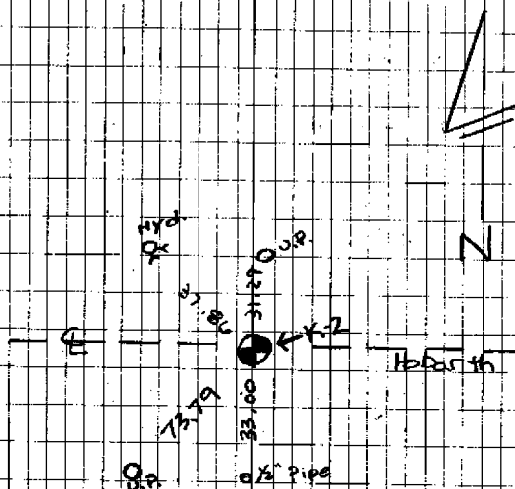

CERTIFICATE of SURVEY A615779

I, ROBERT L. SMITH a Registered Surveyor in the State of Michigan, hereby certify that I have surveyed the parcel (s) of land described and delineated hereon; that said plat is a true representation of the survey as performed by me, and that there are no encroachments other than as shown hereon; that said survey was performed with an error of closure no greater than 1 in 5000; and that I have fully complied with the requirements of Section #3, Act #132, P.A. 1970.


Robert L. Smith

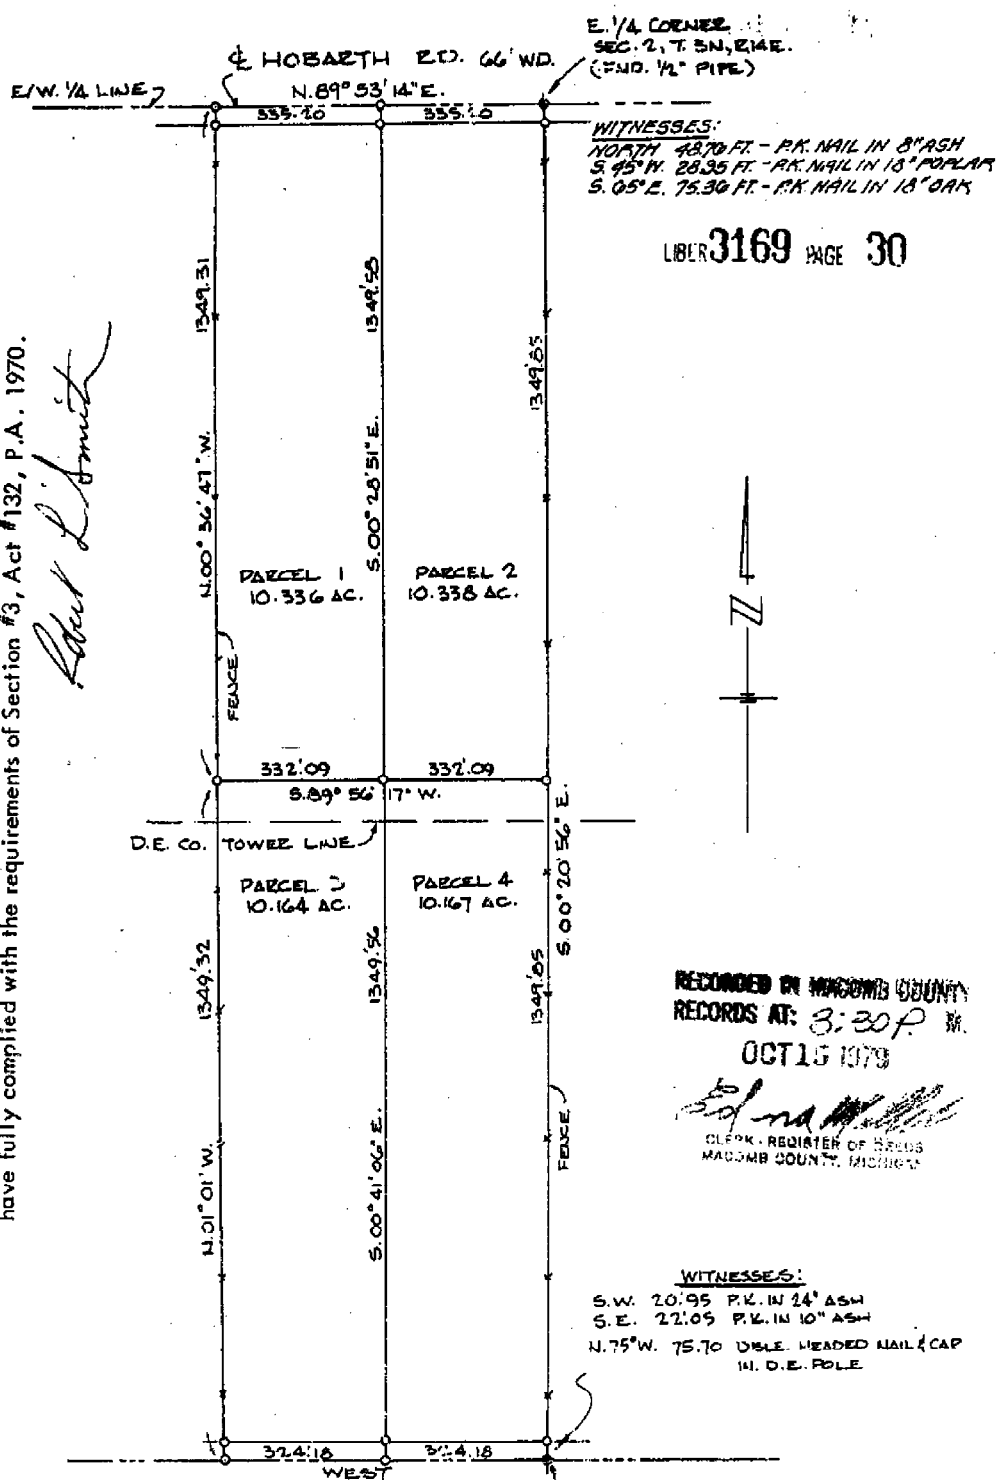

RECORDED IN MACOMB COUNTY
 RECORDS AT: 3:30 P.M.
 OCT 15 1979
[Signature]
 CLERK, REGISTER OF DEEDS
 MACOMB COUNTY, MICHIGAN

NOTE:
 IRONS SET AT ALL POINTS INDICATED THUS - O

SCALE: 1" = 300'
 DATE: 5/10/79

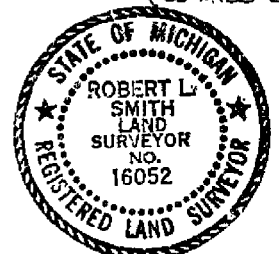

LEHNER ASSOCIATES, INCORPORATED
 ENGINEERS & SURVEYORS
 3300 WELLINGTON CRESSENT
 MT. CLEMENS MICHIGAN
 (313) 463-4594

5/ K-2

Description of Parcel 1 (10.336 Acres)

LIBER 3169 PAGE 31

A parcel of land located in and being a part of the S.E. 1/4 of Section 2, T. 3 N., R. 14 E., Chesterfield Township, Macomb County, Michigan, and being more particularly described as follows:

Commencing at a point 335.20 ft. S. 89°-53'-14" W. from the E. 1/4 corner of Section 2, and thence extending S. 00°-28'-51" E. 1349.58 ft., thence S. 89°-56'-17" W. 332.09 ft., thence N. 00°-36'-47" W. 1349.37 ft., along an old fence line, thence N. 89°-53'-14" E. 335.20 ft. along the East/West 1/4 line, also being the centerline of Hobarth Road (66 ft. wide) to the point of beginning and containing 10.336 acres of land.
Reserving easements of record.

Description of Parcel 2 (10.338 Acres)

A parcel of land located in and being a part of the S.E. 1/4 of Section 2, T. 3 N., R. 14 E., Chesterfield Township, Macomb County, Michigan, and being more particularly described as follows:

Commencing at the E. 1/4 corner of Section 2, and thence extending S. 00°-20'-56" E. 1349.85 ft. along the Easterly line of Section 2, also being an old fence line, thence S. 89°-56'-17" W. 332.09 ft., thence N. 00°-28'-51" W. 1349.58 ft., thence N. 89°-53'-14" E. 335.20 ft. along the East/West 1/4 line also being the centerline of Hobarth Road (66 ft. wide) to the point of beginning and containing 10.338 acres of land.
Reserving easements of record.

Description of Parcel 3 (10.164 Acres)

A parcel of land located in and being a part of the S.E. 1/4 of Section 2, T. 3 N., R. 14 E., Chesterfield Township, Macomb County, Michigan, and being more particularly described as follows:

Commencing at a point 324.18 ft. West from the S.E. corner of Section 2, and thence extending West 324.18 ft. along the South line of Section 2, also being the centerline of 25 Mile Road (66 ft. wide), thence N. 01°-01' W. 1349.32 ft. along an old fence line, thence N. 89°-56'-17" E. 332.09 ft., thence S. 00°-41'-06" E. 1349.56 ft. to the point of beginning and containing 10.164 acres of land.
Reserving easements of record.

Description of Parcel 4 (10.167 Acres)

A parcel of land located in and being a part of the S.E. 1/4 of Section 2, T. 3 N., R. 14 E., Chesterfield Township, Macomb County, Michigan, and being more particularly described as follows:

Commencing at the S.E. corner of Section 2, and thence extending West 324.18 ft. along the South line of Section 2, also being the centerline of 25 Mile Road (66 ft. wide) thence N. 00°-41'-06" W. 1349.56 ft., thence N. 89°-56'-17" E. 332.09 ft., thence S. 00°-20'-56" E. 1349.85 ft. along the East line of Section 2, also being an old fence line, to the point of beginning and containing 10.167 acres of land.
Reserving easements of record.




DATE: 5/10/79

Robert L. Smith
LEHNER ASSOCIATES, INCORPORATED
ENGINEERS & SURVEYORS
22900 WELLINGTON CRESENT
MT. CLEMENS MICHIGAN
(313) 463-4594

ORIGINAL.

A193483

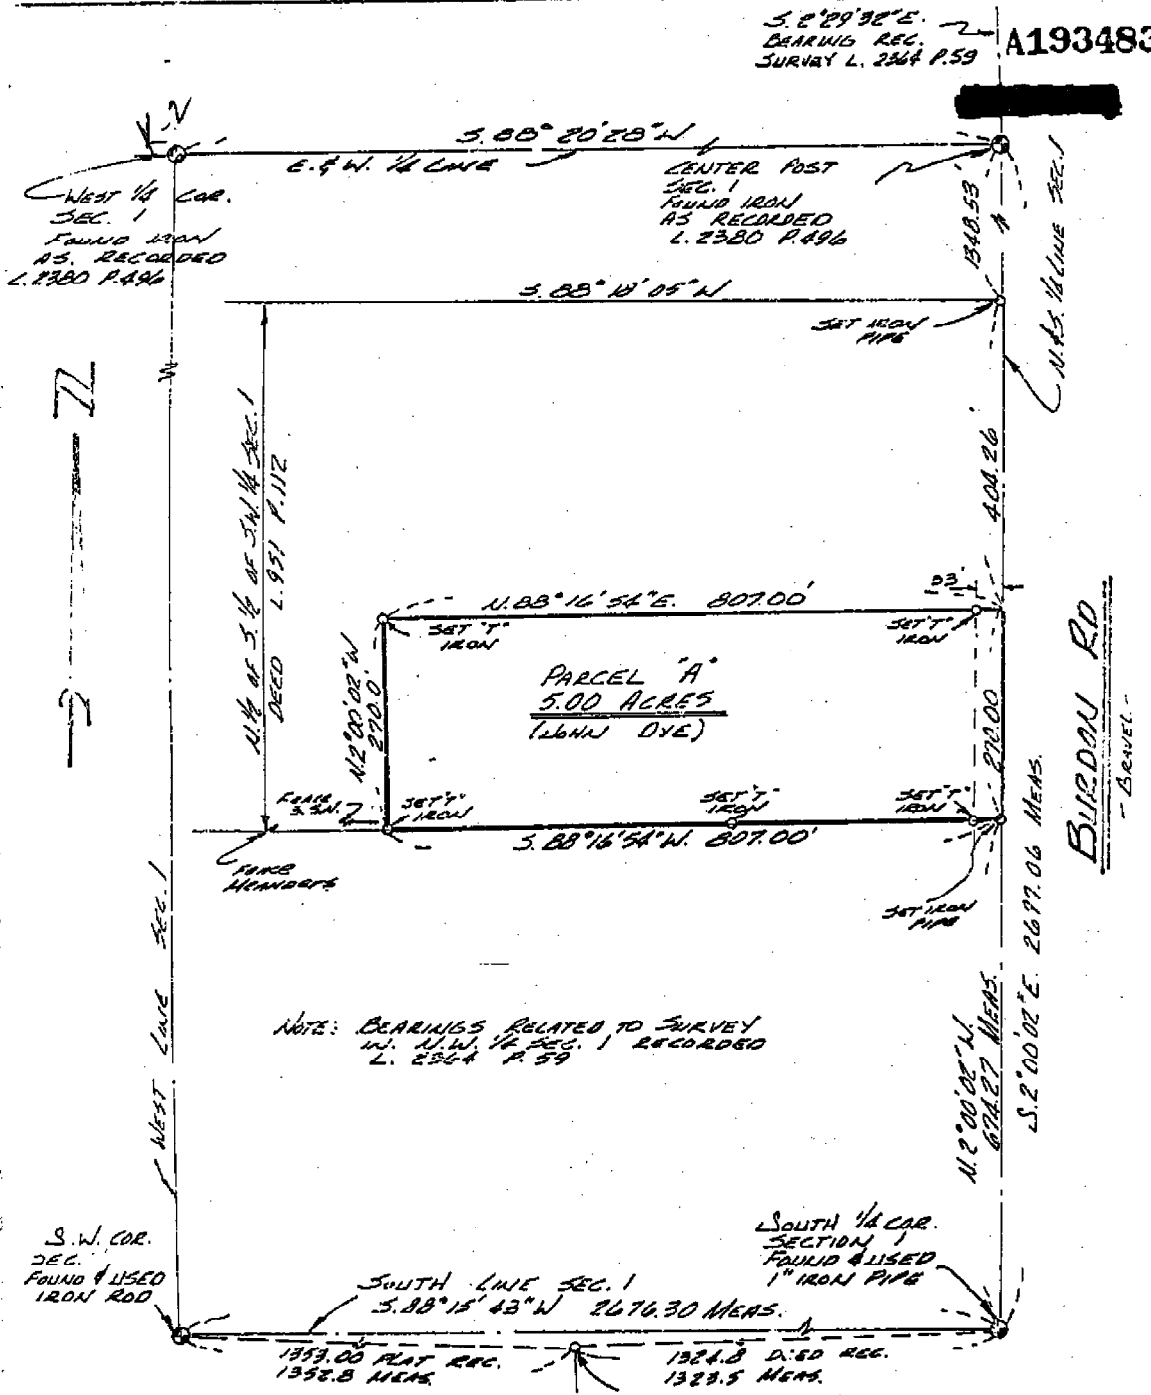

NOTE: BEARINGS RELATED TO SURVEY
 IN 1/4 SECTION 1 T.34N. R.14E
 L. 2564 P. 59

SKETCH OF SURVEY
 PART OF 1/4 OF 3/4 OF S.W. 1/4
 SECTION 1 T.34N. R.14E.
 CHESTERFIELD TWP.
 MACOMB COUNTY MICH.

REFERENCES
 PLATS L. 60 P. 32, 33
 L. 15 P. 43, 44
 DEEDS L. 1896 P. 665
 L. 1092 P. 297



John R. Lansky

JOHN R. LANSKY & ASSOC.
 REGISTERED LAND SURVEYORS
 460 KETCHUM RD
 ST. CLAIR, MICHIGAN
 48079

DATE: JUNE 7 1973
 SCALE: 1"=200'
 DRN: J.L.
 JOB NO. 73-150
 SHEET 1 OF 2

K-2

DESCRIPTION OF PARCEL "A"


A parcel of land in the S.W. 1/4 of Section 1, T.3N., R.14E., Chesterfield Township, Macomb County, Michigan described as:

Commencing at the South 1/4 Corner of Section 1, thence N.2°00'02"W, .674.27 ft. along the N.&S. 1/4 line of Section 1 to the point of beginning, thence S.88°16'54"W. 807.00 ft., thence N.2°00'02"W. 270.00 ft., thence N.88°16'54"E. 807.00 ft. to a point on the N.&S. 1/4 line, thence along said line S.2°00'02"E. 270.00 ft. to the point of beginning.
Contains 5.00 acres of land more or less.

NOTE: The above description is subject to the rights of the public and any governmental agency in any part thereof taken, used, or deeded, for street, road, or highway purposes and is subject to easements of record.

SURVEYOR'S CERTIFICATE:

I hereby certify that I have surveyed the property hereon delineated and described and that this drawing is a true representation of existing conditions and that the error of closure is no greater than 1 in 5000 and that the bearings are related to survey recorded in L.2364 P. 59 Macomb County Records.

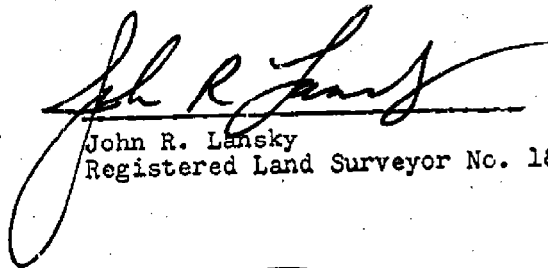
John R. Lansky
Registered Land Surveyor No. 18659



RECORDED IN MACOMB COUNTY
RECORDS AT: 11:38 A.M.

JUN 28 1973



CLERK - REGISTER OF DEEDS
MACOMB COUNTY, MICHIGAN

Date: June 7, 1973
Job No. 73-150
Sheet 2 of 2

John R. Lansky & Associates
Registered Land Surveyors
4660 Ketchum Rd.
St. Clair, Michigan 48079

K-2 FOUND PIPE IN ~~HOBBARTH~~ HOBBARTH ROAD

S05°W 23.32' PK NAIL IN E. FACE 7" ELM

SOUTH 33.00' FOUND IRON

S55°E 21.28' PK NAIL IN N. FACE 12" CHERRY

N03°E 48.76' PK NAIL IN W. FACE 11" ASH

J-1 FOUND 5/8" IRON ROAD IN MAN BOX IN 26 MILES ROAD

SOUTH 31.58' MAG NAIL W. FACE 21" PINE

S12°E 71.83' MAG NAIL ^{TO} ~~TO~~ RAIL POST

N45°E 45.75' MAG NAIL SE FACE U. POLE

N20°W 120.42' MAG NAIL SW FACE U. POLE


I-1 FOUND R. V. SPIKE IN MAN BOX

SOUTH 87.35' PK NAIL IN W. FACE 24" ASH

N80°W 135.86'

N40°E 41.83' PK NAIL ^{IN} ~~IN~~ N. FACE U. POLE

N75°E 113.02' PK NAIL S. FACE 14" ELM

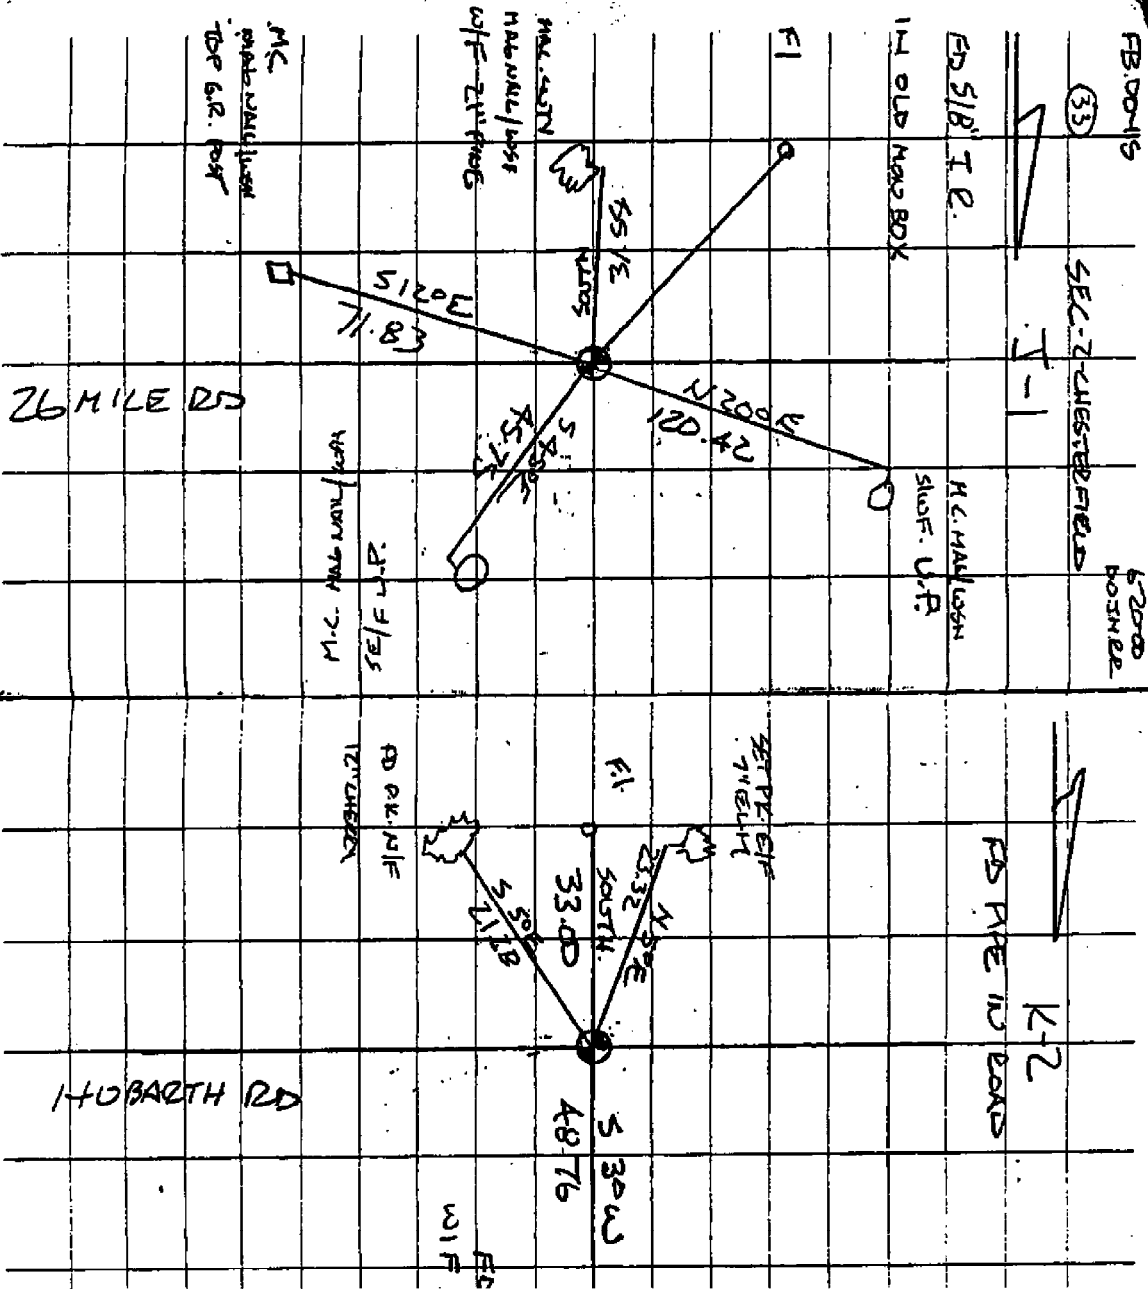


PROJECT #: 126-412 / 126-417
 DESCRIPTION: CHESTERFIELD WVA
 BASEMAP



INDICATE
 NORTH

DATE: APRIL 13, 2001
 CREW: MLD
 PAGE #: _____ OF _____

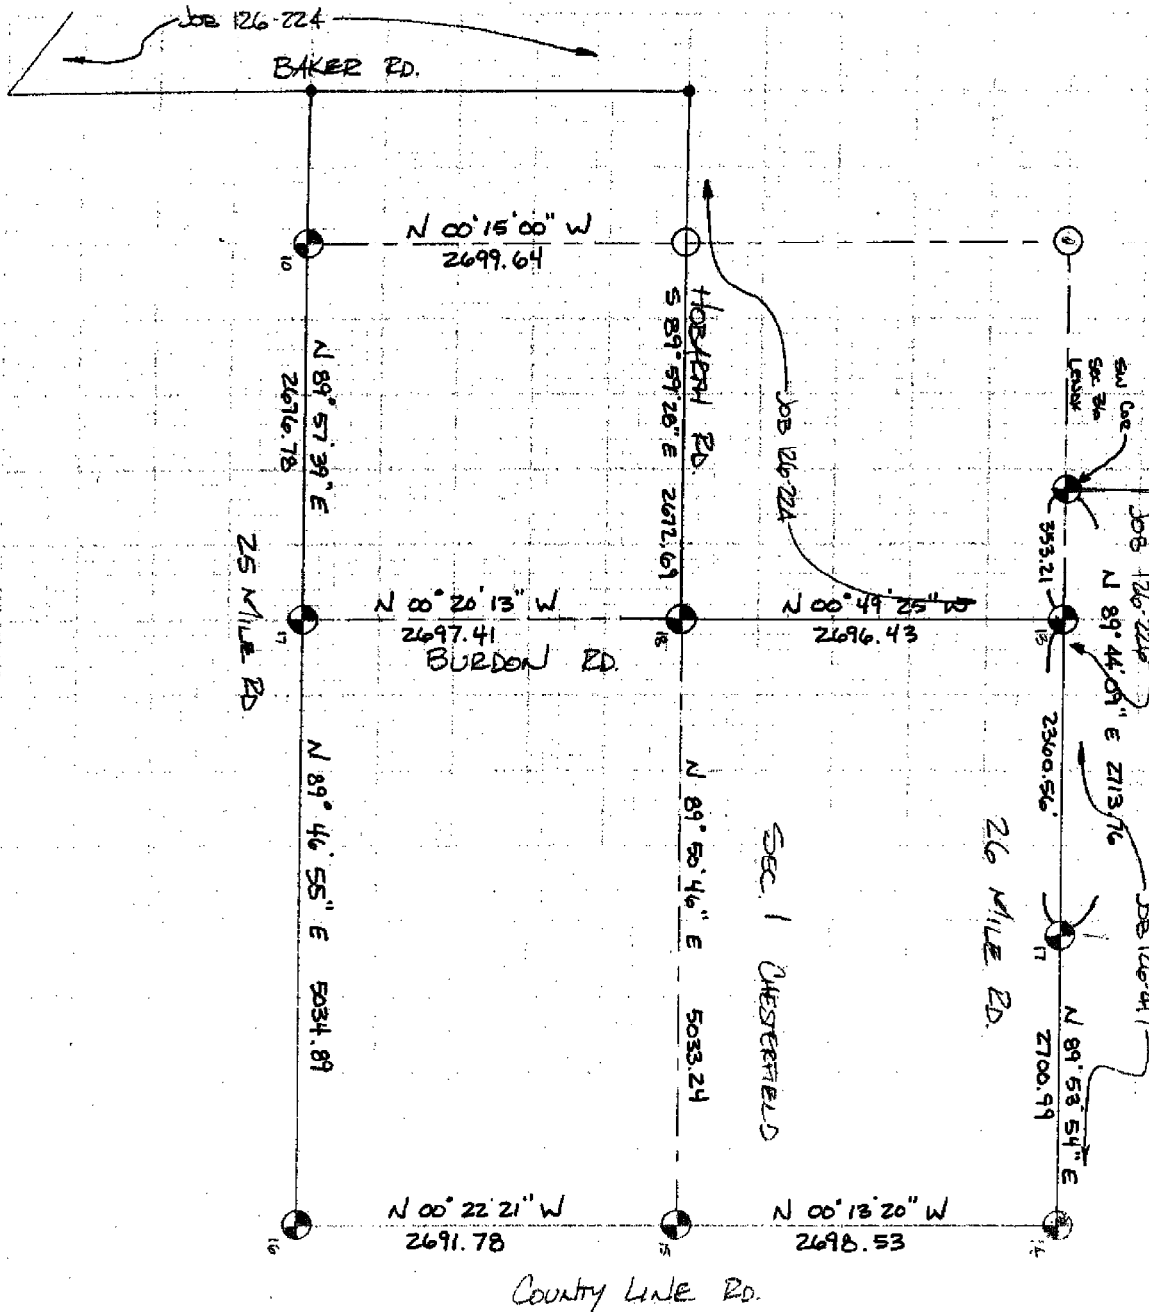

ANDERSON, ECKSTEIN, AND WESTRICK, INC.
 Civil Engineers • Surveyors • Architects

CORPORATE: (610) 726-1236

KENSINGTON: (248) 446-0400

LAND CORNER RECORDATION CERTIFICATE

FILING REQUIREMENT OF ACT 74, MICH. P.A. 1970 **FILE 3168 PAGE 94**

CHESTERFIELD TOWNSHIP, MACOMB COUNTY, MICHIGAN.

A615736

FOR CORNERS OF--	S.E. 1/4	LOCATED IN--	Sec. 2	CORNER CODE NUMBER
1. PUBLIC LAND SURVEY	T. 3	N. 14	E. 14	K-2 (E. 1/4 corner)
2. PROPERTY CONTROLLING IN SECTION	T. _____	N. _____	E. _____	K-3 (S.E. corner)
3. MISCELLANEOUS PROPERTY IN SECTION	T. _____	N. _____	E. _____	
4. LOT NO. _____	RECORDED PLAT _____			
5. PRIVATE CLAIMS _____				

RECORDED IN MACOMB COUNTY
 RECORDS AT: **3:30 P. M.**
OCT 15 1979
Edna Miller
 CLERK - REGISTER OF DEEDS
 MACOMB COUNTY, MICHIGAN
 REGISTER OF DEEDS STAMP AND
 FILING NUMBER

I, Robert L. Smith do hereby certify that under requirements of P.A. 74, Michigan P.A. of 1970, the corner points mentioned in lines 1 and 2 above (identified with circles on index code diagram - over) were, in a field survey on May 1979, established, re-established, monumented, re-monumented, recovered or restored as expressed below and in conformance with regulations and rules therefore as required in the current manual of survey instructions of the United States Department of the Interior, Bureau of Land Management or by a decree of a court of law. Furthermore, that the corner points mentioned in lines 3, 4 and 5 above were, in a field survey on _____ 19____, found, recovered, restored, established or re-established as expressed below and in conformance with the rules of the Michigan State Board of Registration for Land Surveyors or, by a Decree of a Court of law:

A. Description of original monument and accessories and/or subsequent restoration:

B. Description of corner evidence found and/or method applied in restoring or re-establishing corner:

K-2 Found 1/2" pipe
 K-3 Found iron

C. Description of monument for corner and accessories established to perpetuate locating the position of the corner:

K-2 1/2" pipe North 48.76 ft. - P.K. nail in 8" ash
 S. 45° W. 28.95 ft. - P.K. nail in 18" poplar
 S. 65° E. 75.36 ft. - P.K. nail in 18" oak


K-3 iron S.W. 20.95 ft. - P.K. nail in 24" ash
 S.E. 22.05 ft. - P.K. nail in 10" ash
 N. 75° W. 75.70 ft. - double headed nail & cap in Det. Edison pole

SIGNED BY Robert L. Smith DATE 10-2-79

SURVEYOR'S MICHIGAN REGISTRATION NO. 16052

FOR STATE AND UNITED STATES AGENCIES:
 SIGNED BY _____ DATE _____
CHIEF OF SURVEY PARTY

APPROVED AND SIGNED BY _____ DATE _____
MICHIGAN REGISTERED LAND SURVEYOR

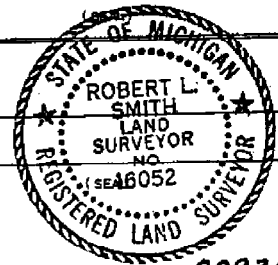

LAND CORNER RECORDATION CERTIFICATE

FILING REQUIREMENT OF ACT 74, MICH. P.A. 1970

Chesterfield Township

LIBER **2380** PAGE **496**

A176340

FOR CORNERS OF--	LOCATED IN--	CORNER CODE NUMBER
1. PUBLIC LAND SURVEY _____	T. <u>3</u> N. <u>X</u> , R. <u>14</u> E. <u>X</u>	<u>K1, L1, K2, L2</u>
2. PROPERTY CONTROLLING IN SECTION _____	T. _____ N. _____ S. _____ R. _____ E. _____ W. _____	_____
3. MISCELLANEOUS PROPERTY IN SECTION _____	T. _____ N. _____ S. _____ R. _____ E. _____ W. _____	_____
4. LOT NO. _____, RECORDED PLAT _____		
5. PRIVATE CLAIMS _____		

RECORDED IN MACOMB COUNTY
RECORDS AT: 10:30 A
MAR 27 1973

Ed ...

CLERK - REGISTER OF DEEDS
MACOMB COUNTY, MICHIGAN
REGISTER OF DEEDS STAMP AND
FILING NUMBER

I, Robert J. Patterson do hereby certify that under requirements of P.A. 74, Michigan P.A. of 1970, the corner points mentioned in lines 1 and 2 above (identified with circles on index code diagram - over) were, in a field survey on February 5 1973, established, re-established, monumented, re-monumented, recovered or restored as expressed below and in conformance with regulations and rules therefore as required in the current manual of survey instructions of the United States Department of the Interior, Bureau of Land Management or by a decree of a court of law. Furthermore, that the corner points mentioned in lines 3, 4 and 5 above were, in a field survey on _____ 19____, found, recovered, restored, established or re-established as expressed below and in conformance with the rules of the Michigan State Board of Registration for Land Surveyors or, by a Decree of a Court of law:

A. Description of original monument and accessories and/or subsequent restoration:

B. Description of corner evidence found and/or method applied in restoring or re-establishing corner:

C. Description of monument for corner and accessories established to perpetuate locating the position of the corner:

K1 - 1/2" Rod in Hand Hole - Witness - P.K. nail in 18" Tree, N.W.'ly - 75.05 ft. P.K. nail in Utility Pole N.E.'ly - 97.44 ft. P.K. nail in Utility Pole S.E.'ly - 74.71 ft.

L1 - P.K. nail - Witness - P.K. nail in Utility Pole N.W.'ly - 53.81 ft. P.K. nail in Utility Pole N.E.'ly - 78.80 ft. P.K. nail in 27" Tree, S.E.'ly - 93.89 ft.

K2 - Iron - Witness - P.K. nail in 12" Tree, N.E.'ly 23.72 ft. P.K. nail in 12" Tree, S.E.'ly - 21.22 ft. P.K. nail in 12" Tree, S.W.'ly - 28.41 ft.

L2 - Iron - Witness - P.K. nail in 12" Tree, N.W.'ly 34.23 ft. P.K. nail in utility Pole N.E.'ly 34.34 ft. P.K. nail in Utility Pole S.W.'ly 140.95 ft.


SIGNED BY Robert J. Patterson DATE February

SURVEYOR'S MICHIGAN REGISTRATION NO. 17631

FOR STATE AND UNITED STATES AGENCIES:

SIGNED BY _____ CHIEF OF SURVEY PARTY DATE _____

APPROVED AND SIGNED BY _____ MICHIGAN REGISTERED LAND SURVEYOR DATE _____

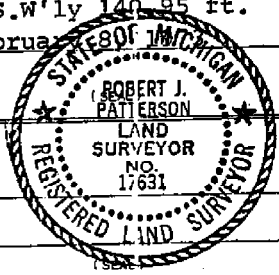

00288

SURVEYOR'S MICHIGAN REGISTRATION NO. _____

26 MILE 203

-001
4.61 CR.
5.14 PL.

-0
11.9

890

295

210

190

1-94


C-25

354

R-23068.32

Pt. 09-01-100-017
Pt. 31.076

CONSUMERS

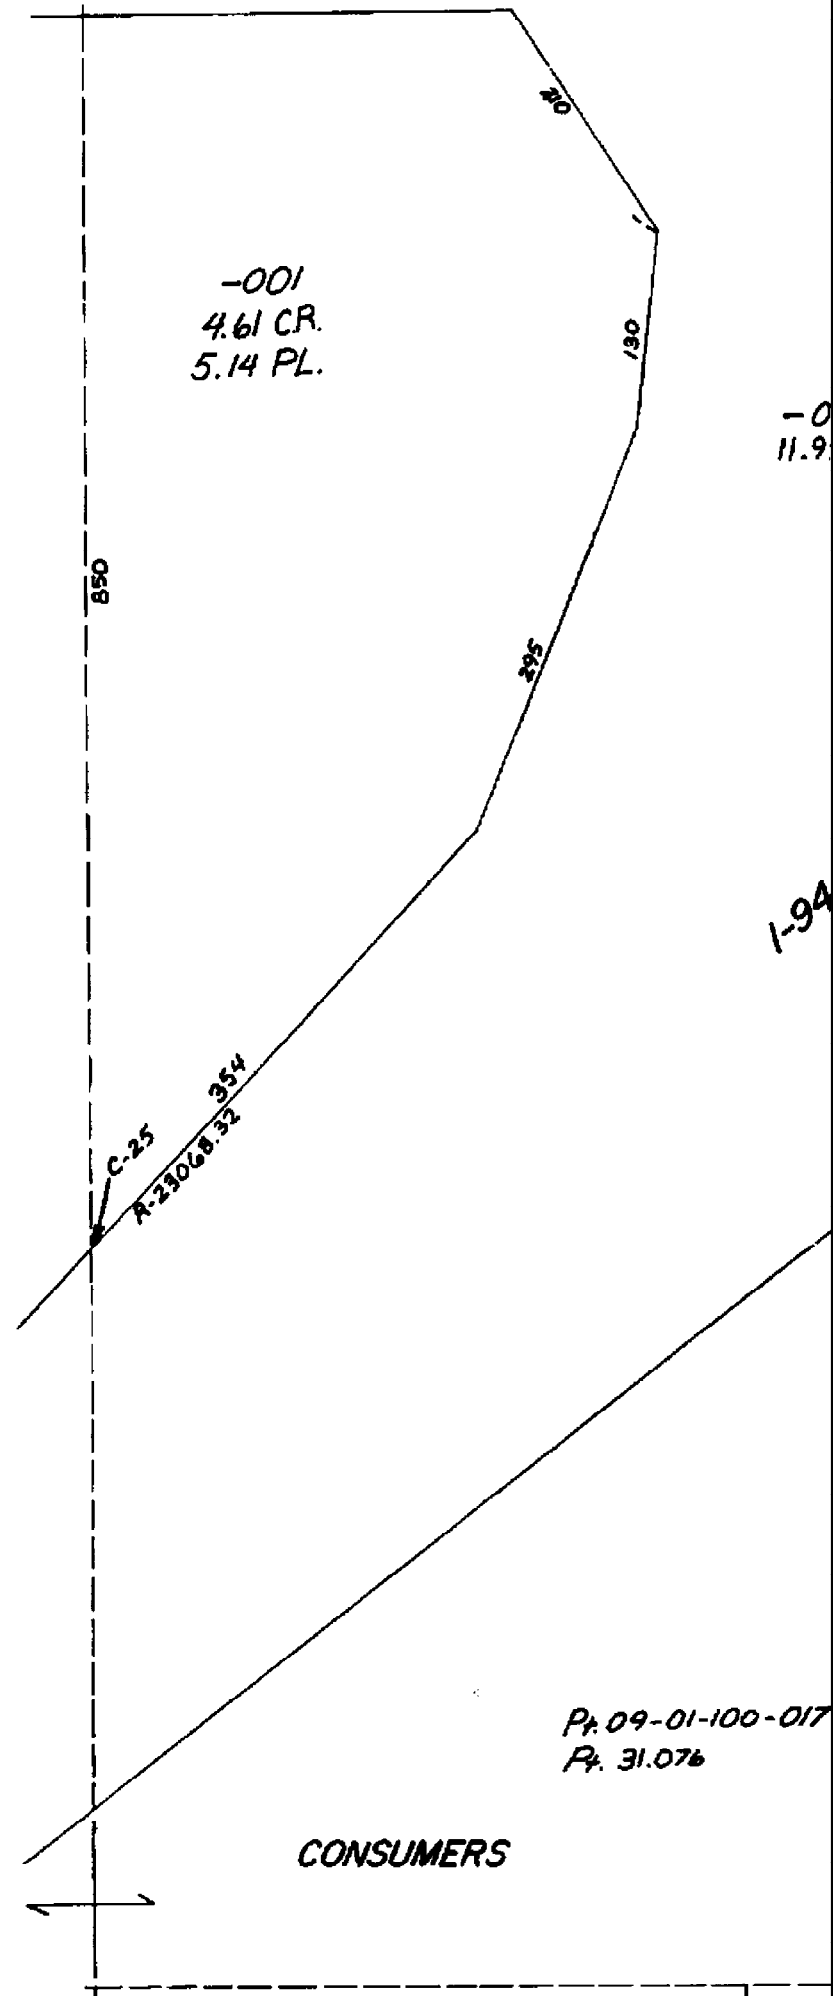

Pt. 09-01-100-017
Pt. 31.076

CONSUMERS

9-20

-015
13.50

CHESTERFIELD
W. 1/2 N.W. 1/4 SEC. 1 T. 2

TERFIELD TWP
 W. 1/4 SEC. 1 T. 3N. R. 14E.

HOBARTH

SCALE: 1" = 100'


COPYRIGHT 1995 MACOMB COUNTY, MI
 All Rights Reserved.

9-1A

Date of Photography: March 2000



1:1200

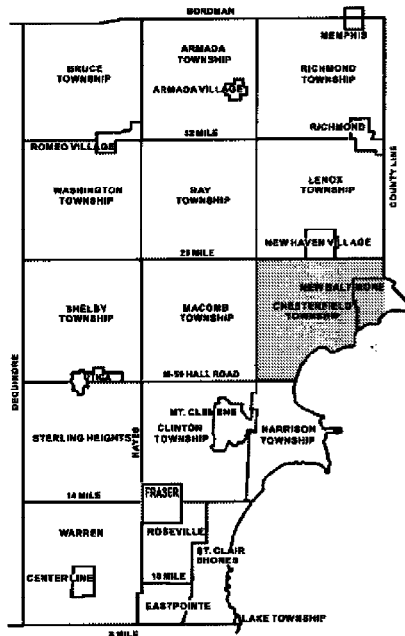

ZIMMERMAN		SCHUELER		25 MILE	
08-11C	08-11B	08-11A	08-11D	08-11E	08-11F
08-12C	08-12B	08-12A	08-12D	08-12E	08-12F
08-13C	08-13B	08-13A	08-13D	08-13E	08-13F
08-14C	08-14B	08-14A	08-14D	08-14E	08-14F
08-15C	08-15B	08-15A	08-15D	08-15E	08-15F
08-16C	08-16B	08-16A	08-16D	08-16E	08-16F
08-17C	08-17B	08-17A	08-17D	08-17E	08-17F
08-18C	08-18B	08-18A	08-18D	08-18E	08-18F
08-19C	08-19B	08-19A	08-19D	08-19E	08-19F
08-20C	08-20B	08-20A	08-20D	08-20E	08-20F
08-21C	08-21B	08-21A	08-21D	08-21E	08-21F
08-22C	08-22B	08-22A	08-22D	08-22E	08-22F
08-23C	08-23B	08-23A	08-23D	08-23E	08-23F
08-24C	08-24B	08-24A	08-24D	08-24E	08-24F
08-25C	08-25B	08-25A	08-25D	08-25E	08-25F
08-26C	08-26B	08-26A	08-26D	08-26E	08-26F
08-27C	08-27B	08-27A	08-27D	08-27E	08-27F
08-28C	08-28B	08-28A	08-28D	08-28E	08-28F
08-29C	08-29B	08-29A	08-29D	08-29E	08-29F
08-30C	08-30B	08-30A	08-30D	08-30E	08-30F

130

-002
11.99

-003
16.168

1-94 8 U.S. 25

346.16

380

-007
15.396

09-01-100-017
31.076

POWER 130

COMPANY

09-01-100-017
31.076

POWER 100

COMPANY

100

-016
13.50

P. 09-01-100-013
Pr. 27.00

RD.
1338 →


-003
16.168



300

946.18

-007
15.396

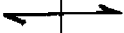

837.53 →

COMPANY



9-1B

1137.71 →

837.53

COMPANY

9-1B

1137.71

Pt. 09-01-100-013
Pt. 27.00

REV. 3-78

RD.

09-01A	09-01B	09-01C	09-01D	09-01E	09-01F	09-01G	09-01H	09-01I	09-01J	09-01K	09-01L	09-01M	09-01N	09-01O	09-01P	09-01Q	09-01R	09-01S	09-01T	09-01U	09-01V	09-01W	09-01X	09-01Y	09-01Z
09-02A	09-02B	09-02C	09-02D	09-02E	09-02F	09-02G	09-02H	09-02I	09-02J	09-02K	09-02L	09-02M	09-02N	09-02O	09-02P	09-02Q	09-02R	09-02S	09-02T	09-02U	09-02V	09-02W	09-02X	09-02Y	09-02Z
09-03A	09-03B	09-03C	09-03D	09-03E	09-03F	09-03G	09-03H	09-03I	09-03J	09-03K	09-03L	09-03M	09-03N	09-03O	09-03P	09-03Q	09-03R	09-03S	09-03T	09-03U	09-03V	09-03W	09-03X	09-03Y	09-03Z
09-04A	09-04B	09-04C	09-04D	09-04E	09-04F	09-04G	09-04H	09-04I	09-04J	09-04K	09-04L	09-04M	09-04N	09-04O	09-04P	09-04Q	09-04R	09-04S	09-04T	09-04U	09-04V	09-04W	09-04X	09-04Y	09-04Z
09-05A	09-05B	09-05C	09-05D	09-05E	09-05F	09-05G	09-05H	09-05I	09-05J	09-05K	09-05L	09-05M	09-05N	09-05O	09-05P	09-05Q	09-05R	09-05S	09-05T	09-05U	09-05V	09-05W	09-05X	09-05Y	09-05Z
09-06A	09-06B	09-06C	09-06D	09-06E	09-06F	09-06G	09-06H	09-06I	09-06J	09-06K	09-06L	09-06M	09-06N	09-06O	09-06P	09-06Q	09-06R	09-06S	09-06T	09-06U	09-06V	09-06W	09-06X	09-06Y	09-06Z
09-07A	09-07B	09-07C	09-07D	09-07E	09-07F	09-07G	09-07H	09-07I	09-07J	09-07K	09-07L	09-07M	09-07N	09-07O	09-07P	09-07Q	09-07R	09-07S	09-07T	09-07U	09-07V	09-07W	09-07X	09-07Y	09-07Z
09-08A	09-08B	09-08C	09-08D	09-08E	09-08F	09-08G	09-08H	09-08I	09-08J	09-08K	09-08L	09-08M	09-08N	09-08O	09-08P	09-08Q	09-08R	09-08S	09-08T	09-08U	09-08V	09-08W	09-08X	09-08Y	09-08Z
09-09A	09-09B	09-09C	09-09D	09-09E	09-09F	09-09G	09-09H	09-09I	09-09J	09-09K	09-09L	09-09M	09-09N	09-09O	09-09P	09-09Q	09-09R	09-09S	09-09T	09-09U	09-09V	09-09W	09-09X	09-09Y	09-09Z
09-10A	09-10B	09-10C	09-10D	09-10E	09-10F	09-10G	09-10H	09-10I	09-10J	09-10K	09-10L	09-10M	09-10N	09-10O	09-10P	09-10Q	09-10R	09-10S	09-10T	09-10U	09-10V	09-10W	09-10X	09-10Y	09-10Z
09-11A	09-11B	09-11C	09-11D	09-11E	09-11F	09-11G	09-11H	09-11I	09-11J	09-11K	09-11L	09-11M	09-11N	09-11O	09-11P	09-11Q	09-11R	09-11S	09-11T	09-11U	09-11V	09-11W	09-11X	09-11Y	09-11Z
09-12A	09-12B	09-12C	09-12D	09-12E	09-12F	09-12G	09-12H	09-12I	09-12J	09-12K	09-12L	09-12M	09-12N	09-12O	09-12P	09-12Q	09-12R	09-12S	09-12T	09-12U	09-12V	09-12W	09-12X	09-12Y	09-12Z
09-13A	09-13B	09-13C	09-13D	09-13E	09-13F	09-13G	09-13H	09-13I	09-13J	09-13K	09-13L	09-13M	09-13N	09-13O	09-13P	09-13Q	09-13R	09-13S	09-13T	09-13U	09-13V	09-13W	09-13X	09-13Y	09-13Z
09-14A	09-14B	09-14C	09-14D	09-14E	09-14F	09-14G	09-14H	09-14I	09-14J	09-14K	09-14L	09-14M	09-14N	09-14O	09-14P	09-14Q	09-14R	09-14S	09-14T	09-14U	09-14V	09-14W	09-14X	09-14Y	09-14Z
09-15A	09-15B	09-15C	09-15D	09-15E	09-15F	09-15G	09-15H	09-15I	09-15J	09-15K	09-15L	09-15M	09-15N	09-15O	09-15P	09-15Q	09-15R	09-15S	09-15T	09-15U	09-15V	09-15W	09-15X	09-15Y	09-15Z
09-16A	09-16B	09-16C	09-16D	09-16E	09-16F	09-16G	09-16H	09-16I	09-16J	09-16K	09-16L	09-16M	09-16N	09-16O	09-16P	09-16Q	09-16R	09-16S	09-16T	09-16U	09-16V	09-16W	09-16X	09-16Y	09-16Z
09-17A	09-17B	09-17C	09-17D	09-17E	09-17F	09-17G	09-17H	09-17I	09-17J	09-17K	09-17L	09-17M	09-17N	09-17O	09-17P	09-17Q	09-17R	09-17S	09-17T	09-17U	09-17V	09-17W	09-17X	09-17Y	09-17Z
09-18A	09-18B	09-18C	09-18D	09-18E	09-18F	09-18G	09-18H	09-18I	09-18J	09-18K	09-18L	09-18M	09-18N	09-18O	09-18P	09-18Q	09-18R	09-18S	09-18T	09-18U	09-18V	09-18W	09-18X	09-18Y	09-18Z
09-19A	09-19B	09-19C	09-19D	09-19E	09-19F	09-19G	09-19H	09-19I	09-19J	09-19K	09-19L	09-19M	09-19N	09-19O	09-19P	09-19Q	09-19R	09-19S	09-19T	09-19U	09-19V	09-19W	09-19X	09-19Y	09-19Z
09-20A	09-20B	09-20C	09-20D	09-20E	09-20F	09-20G	09-20H	09-20I	09-20J	09-20K	09-20L	09-20M	09-20N	09-20O	09-20P	09-20Q	09-20R	09-20S	09-20T	09-20U	09-20V	09-20W	09-20X	09-20Y	09-20Z
09-21A	09-21B	09-21C	09-21D	09-21E	09-21F	09-21G	09-21H	09-21I	09-21J	09-21K	09-21L	09-21M	09-21N	09-21O	09-21P	09-21Q	09-21R	09-21S	09-21T	09-21U	09-21V	09-21W	09-21X	09-21Y	09-21Z
09-22A	09-22B	09-22C	09-22D	09-22E	09-22F	09-22G	09-22H	09-22I	09-22J	09-22K	09-22L	09-22M	09-22N	09-22O	09-22P	09-22Q	09-22R	09-22S	09-22T	09-22U	09-22V	09-22W	09-22X	09-22Y	09-22Z
09-23A	09-23B	09-23C	09-23D	09-23E	09-23F	09-23G	09-23H	09-23I	09-23J	09-23K	09-23L	09-23M	09-23N	09-23O	09-23P	09-23Q	09-23R	09-23S	09-23T	09-23U	09-23V	09-23W	09-23X	09-23Y	09-23Z
09-24A	09-24B	09-24C	09-24D	09-24E	09-24F	09-24G	09-24H	09-24I	09-24J	09-24K	09-24L	09-24M	09-24N	09-24O	09-24P	09-24Q	09-24R	09-24S	09-24T	09-24U	09-24V	09-24W	09-24X	09-24Y	09-24Z
09-25A	09-25B	09-25C	09-25D	09-25E	09-25F	09-25G	09-25H	09-25I	09-25J	09-25K	09-25L	09-25M	09-25N	09-25O	09-25P	09-25Q	09-25R	09-25S	09-25T	09-25U	09-25V	09-25W	09-25X	09-25Y	09-25Z
09-26A	09-26B	09-26C	09-26D	09-26E	09-26F	09-26G	09-26H	09-26I	09-26J	09-26K	09-26L	09-26M	09-26N	09-26O	09-26P	09-26Q	09-26R	09-26S	09-26T	09-26U	09-26V	09-26W	09-26X	09-26Y	09-26Z
09-27A	09-27B	09-27C	09-27D	09-27E	09-27F	09-27G	09-27H	09-27I	09-27J	09-27K	09-27L	09-27M	09-27N	09-27O	09-27P	09-27Q	09-27R	09-27S	09-27T	09-27U	09-27V	09-27W	09-27X	09-27Y	09-27Z
09-28A	09-28B	09-28C	09-28D	09-28E	09-28F	09-28G	09-28H	09-28I	09-28J	09-28K	09-28L	09-28M	09-28N	09-28O	09-28P	09-28Q	09-28R	09-28S	09-28T	09-28U	09-28V	09-28W	09-28X	09-28Y	09-28Z
09-29A	09-29B	09-29C	09-29D	09-29E	09-29F	09-29G	09-29H	09-29I	09-29J	09-29K	09-29L	09-29M	09-29N	09-29O	09-29P	09-29Q	09-29R	09-29S	09-29T	09-29U	09-29V	09-29W	09-29X	09-29Y	09-29Z
09-30A	09-30B	09-30C	09-30D	09-30E	09-30F	09-30G	09-30H	09-30I	09-30J	09-30K	09-30L	09-30M	09-30N	09-30O	09-30P	09-30Q	09-30R	09-30S	09-30T	09-30U	09-30V	09-30W	09-30X	09-30Y	09-30Z


DESCRIPTION OF PERMANENT REAL ESTATE INDEX NUMBER

13 - 19 - 302 - 018



09-01A

W. 1/2 N.W. 1/4 SEC. 1 T. 3N. R. 14E.
CHESTERFIELD TWP.

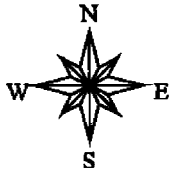

Source: Macomb County Planning and Economic Development Department (PEDD)
- 2000 Digital Orthophotography Project
- Parcel Conversion Project

Note: Digital Orthophotography horizontal positioning accuracy is 3 feet.

Parcel boundary lines should be considered a graphical representation and not in any way a legal survey or engineering document. In general, the horizontal positioning and length accuracy is 15 feet.

This map is intended for general planning purposes. Site specific evaluation should be verified by field inspection. This is a work in progress and may contain errors and omissions. Please report any potential revisions to the PEDD at (810)469-5285.

K-2

GISs **MACOMB COUNTY**
 Planning and Economic
 Development Department

HOBARTH

←1067.18

RD.



Pt. -014

Pt. 95.528

9-2G

337.06

699.6

-003
5.424

702.26

"

-004
5.444


704.96

"

-005
5.465

707.64

768.61


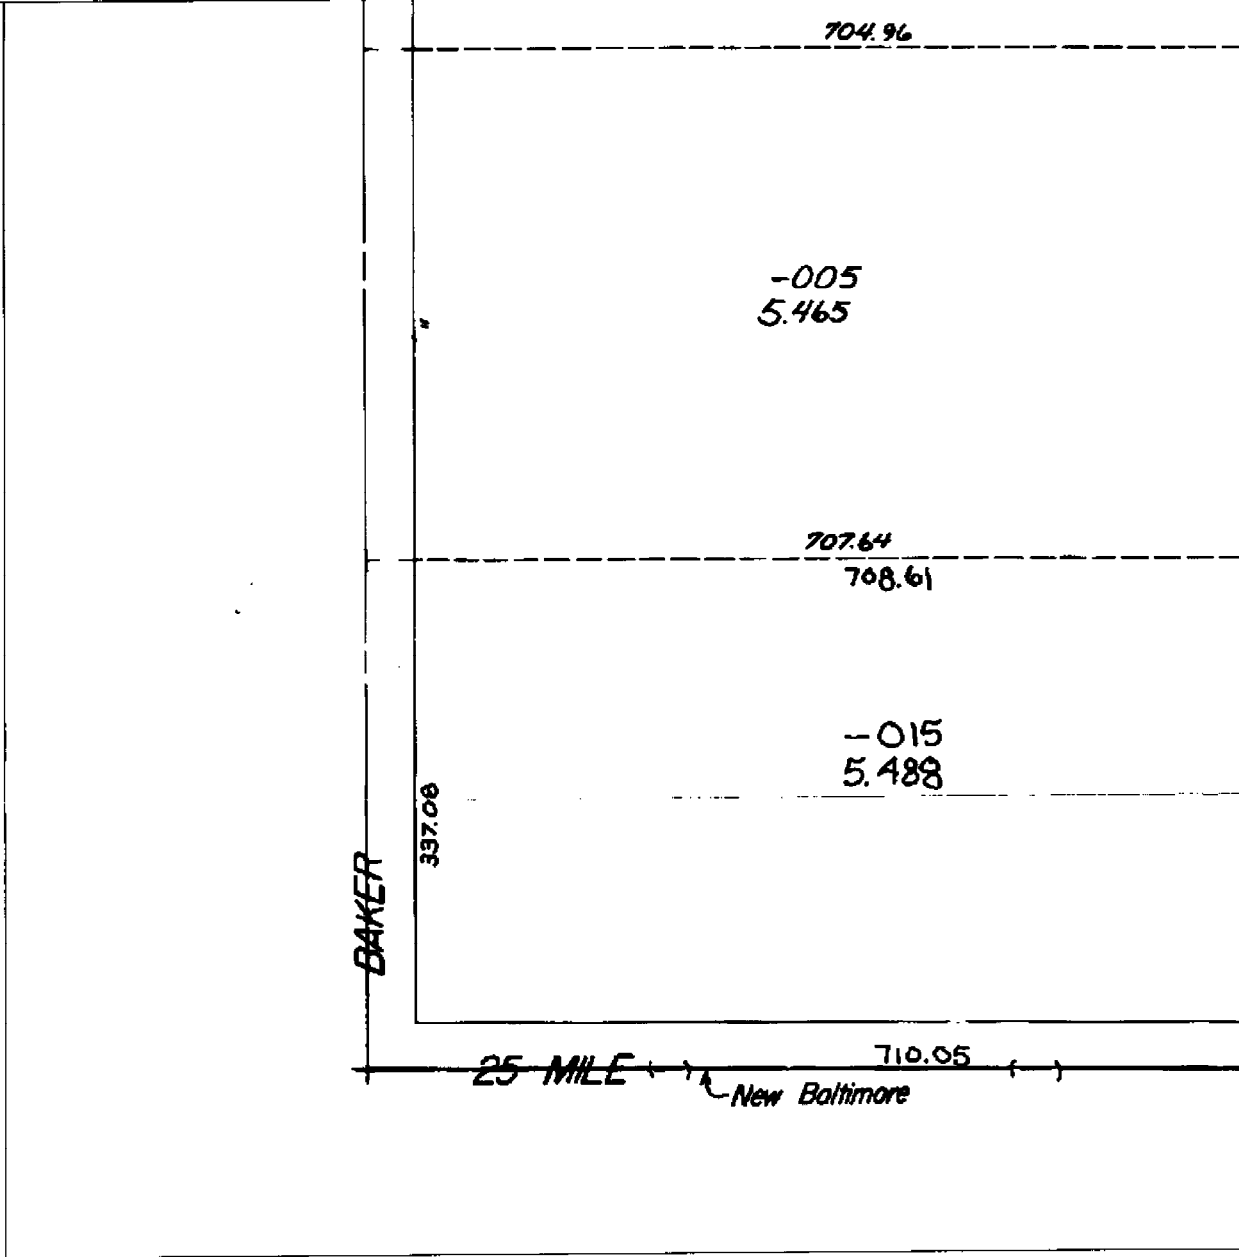


Date of Photography: March 2000

100 0 100 200 Feet



1:1200

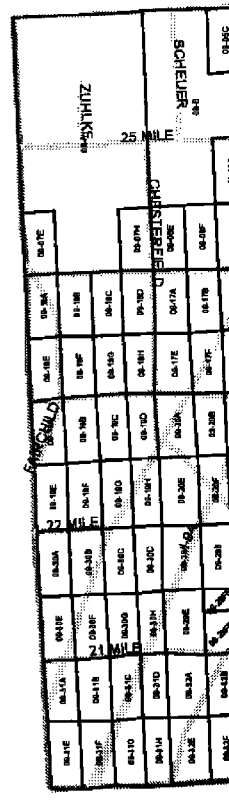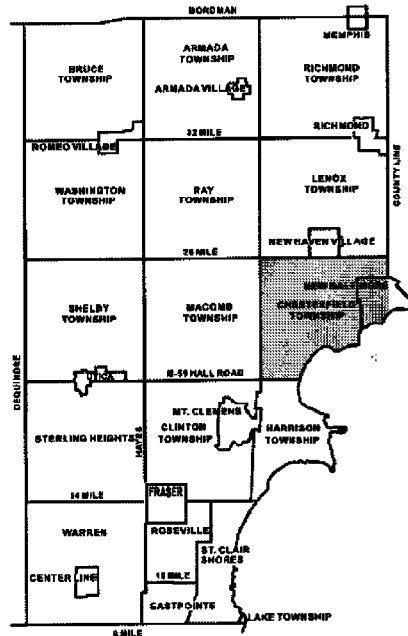

9-20

-7

335.20

335.20

1348.74
/349.31

-008
10.336

/349.59

-009
10.338

332.09

332.09

400

337.08

"

-012
5.082

-013
5.082

-011
10.167

1349.32

1349.56

337.08

~~RD.~~ E 1/4 POST

338.20

1349.68

-009
10.338

1349.65

-013
5.082

1349.56

-011
10.167

332.09

1349.85

9-1E

LD TWP:
2 T3N R14E

1349.8

CHESTERFIELD TWP.
E 1/2 S.E. 1/4 SEC. 2 T.3N. R.14E

REV. 6-01
REV. 7-93

324.18

RD Line

COPYRIGHT 1995 MACOMB COUNTY, MI.
All Rights Reserved.

SCALE: 1" = 100'

9-2H

09-02H


E. 1/2 S.E. 1/4 SEC. 2 T. 3N. R. 14E.
CHESTERFIELD TWP.

DESCRIPTION OF PERMANENT REAL ESTATE INDEX NUMBER

13 - 19 - 302 - 018

AREA NUMBER (TOWNSHIP UNDER SURVEY)
 SUR AREA NUMBER (ALWAYS COMBINES WITH SECTION NUMBER)
 BLOCK NUMBER (CITY BLOCK LOCATION IN SECTION)
 PARCEL NUMBER (USUALLY A HOUSE LOT OR FARM)

13-19-302-018	13-19-302-017	13-19-302-016	13-19-302-015	13-19-302-014	13-19-302-013	13-19-302-012	13-19-302-011	13-19-302-010	13-19-302-009	13-19-302-008	13-19-302-007	13-19-302-006	13-19-302-005	13-19-302-004	13-19-302-003	13-19-302-002	13-19-302-001

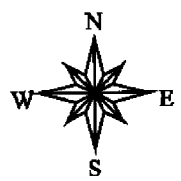

Source: Macomb County Planning and Economic Development Department (PEDD)
 - 2000 Digital Orthophotography Project
 - Parcel Conversion Project

Note: Digital Orthophotography horizontal positioning accuracy is 3 feet.

Parcel boundary lines should be considered a graphical representation and not in any way a legal survey or engineering document. In general, the horizontal positioning and length accuracy is 15 feet.

This map is intended for general planning purposes. Site specific evaluation should be verified by field inspection. This is a work in progress and may contain errors and omissions. Please report any potential revisions to the PEDD at (810)469-5285.

GIS **MACOMB COUNTY**
 Planning and Economic
 Development Department

HOBARTH

9-2H

H2-6

91.577


P.O.
F

CHESTERFIELD TWP.
W. 1/2 S.W. 1/4 SEC. 1 T. 3N R. 14E.

FIELD TWP.
SEC. 1 T. 3 N. R. 14 E.

Pr. C
P


SCALE : 1" = 100'

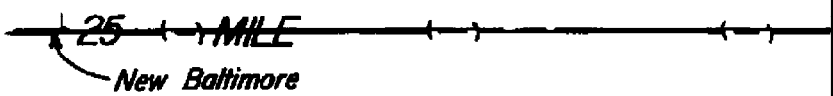




COPYRIGHT 1995 MACOMB COUNTY, MI.
All Rights Reserved.

9-IE

Date of Photography: March 2000

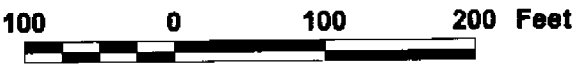

1:1200

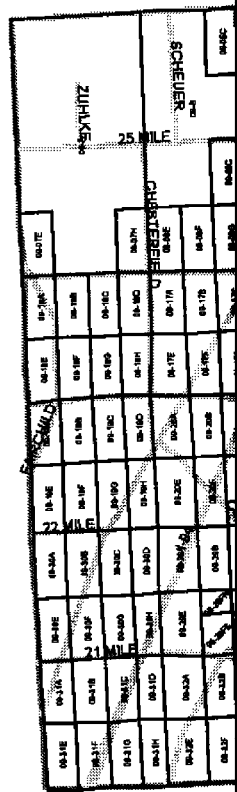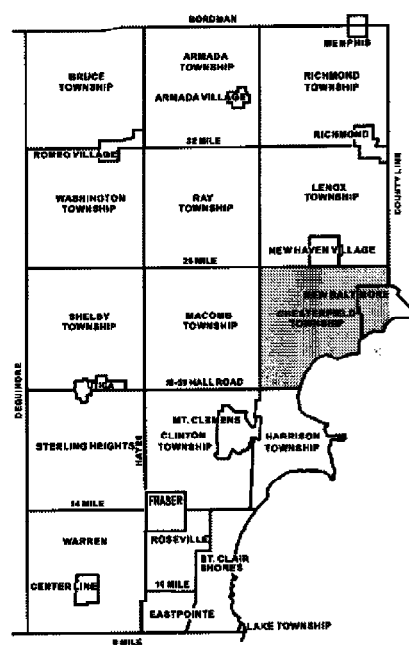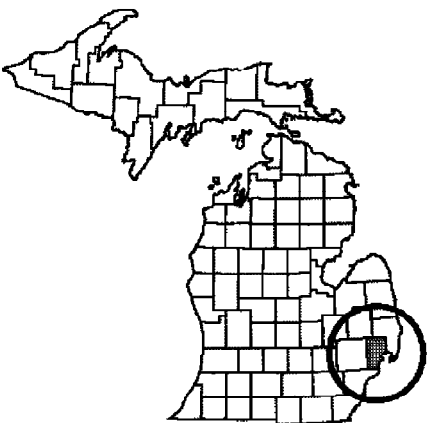

P. 09-01-300-001
P. 80.00 C.R.
81.00 PL.

300

Pt. - 010



Pt. 39.82

Pt. 09-01-300-008
Pt. 40.00

Pr. 09-01-300-008
Pr. 40.00

Corp.
9-12A

RD

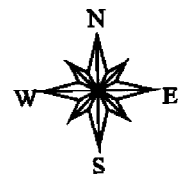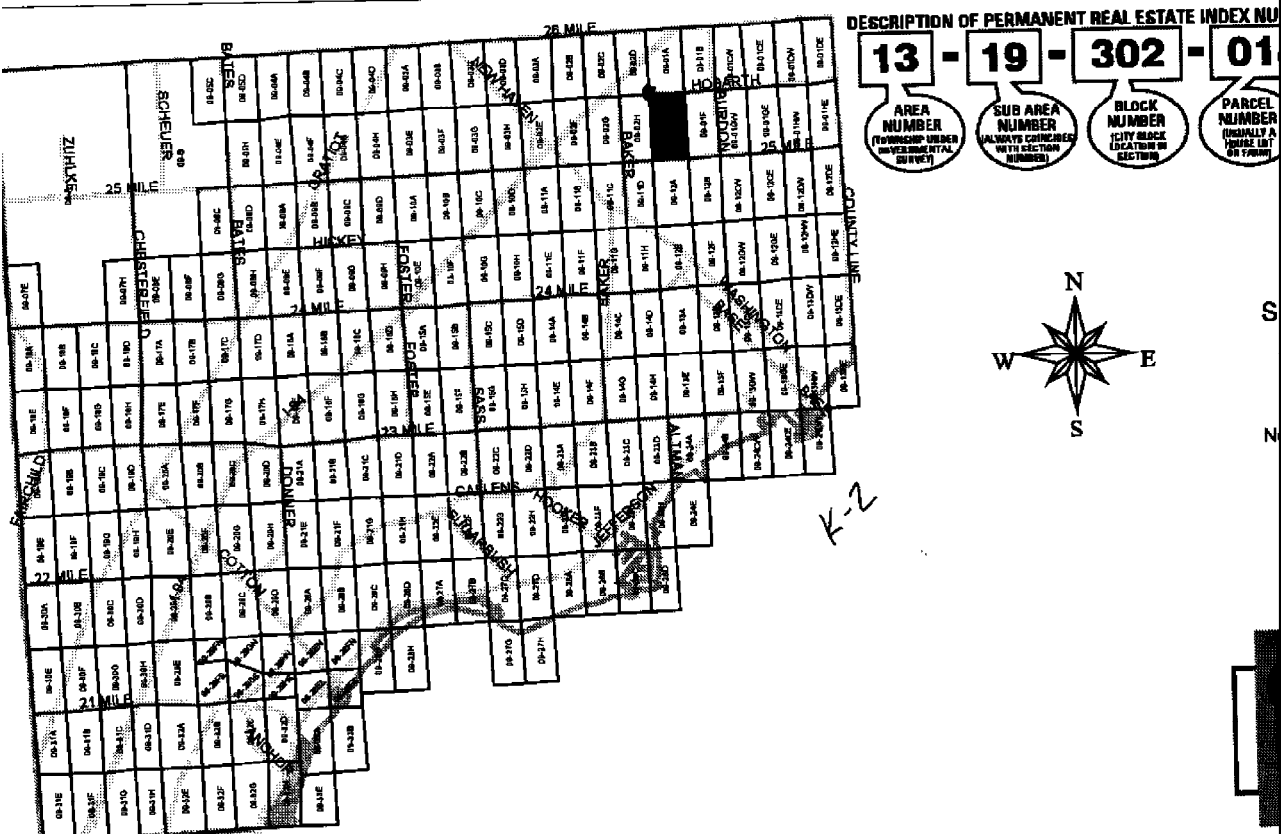

K-2

RD.



9-1F

9-1F

2674.87

010
39.82

69.8072

Rev. 1-00
 Rev. 3-97

RD
 Line


09-01B	09-01F	09-01G	09-01H	09-01I	09-01J	09-01K	09-01L	09-01M	09-01N	09-01O	09-01P	09-01Q	09-01R	09-01S	09-01T	09-01U	09-01V	09-01W	09-01X	09-01Y	09-01Z
09-02A	09-02B	09-02C	09-02D	09-02E	09-02F	09-02G	09-02H	09-02I	09-02J	09-02K	09-02L	09-02M	09-02N	09-02O	09-02P	09-02Q	09-02R	09-02S	09-02T	09-02U	09-02V
09-03A	09-03B	09-03C	09-03D	09-03E	09-03F	09-03G	09-03H	09-03I	09-03J	09-03K	09-03L	09-03M	09-03N	09-03O	09-03P	09-03Q	09-03R	09-03S	09-03T	09-03U	09-03V
09-04A	09-04B	09-04C	09-04D	09-04E	09-04F	09-04G	09-04H	09-04I	09-04J	09-04K	09-04L	09-04M	09-04N	09-04O	09-04P	09-04Q	09-04R	09-04S	09-04T	09-04U	09-04V

DESCRIPTION OF PERMANENT REAL ESTATE INDEX NUMBER

13 - 19 - 302 - 018

09-01E

W.1/2 S.W.1/4 SEC.1 T.3N. R.14E.
CHESTERFIELD TWP.

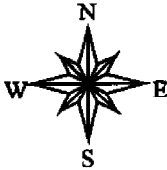

Source: Macomb County Planning and Economic Development Department (PEDD)
 - 2000 Digital Orthophotography Project
 - Parcel Conversion Project

Note: Digital Orthophotography horizontal positioning accuracy is 3 feet.
 Parcel boundary lines should be considered a graphical representation and not in any way a legal survey or engineering document. In general, the horizontal positioning and length accuracy is 15 feet.

This map is intended for general planning purposes. Site specific evaluation should be verified by field inspection. This is a work in progress and may contain errors and omissions. Please report any potential revisions to the PEDD at (810)468-5285.

MACOMB COUNTY
 Planning and Economic
 Development Department

26 MILE

RD.

311

-003
8.21

-005
24.451 C.R.
26.10 PL.

311

2307.79

9-2C

166

CONSUMERS

POWER

COMPANY

752.78

317

2307.79

CONSUMERS POWER COMPANY

9-2C

166

752.78

200

-013
5.62

645

790

1-94 & U.S. 25

81


BAKER

392.26


1250 R.
1215 R.

RD.




2.96

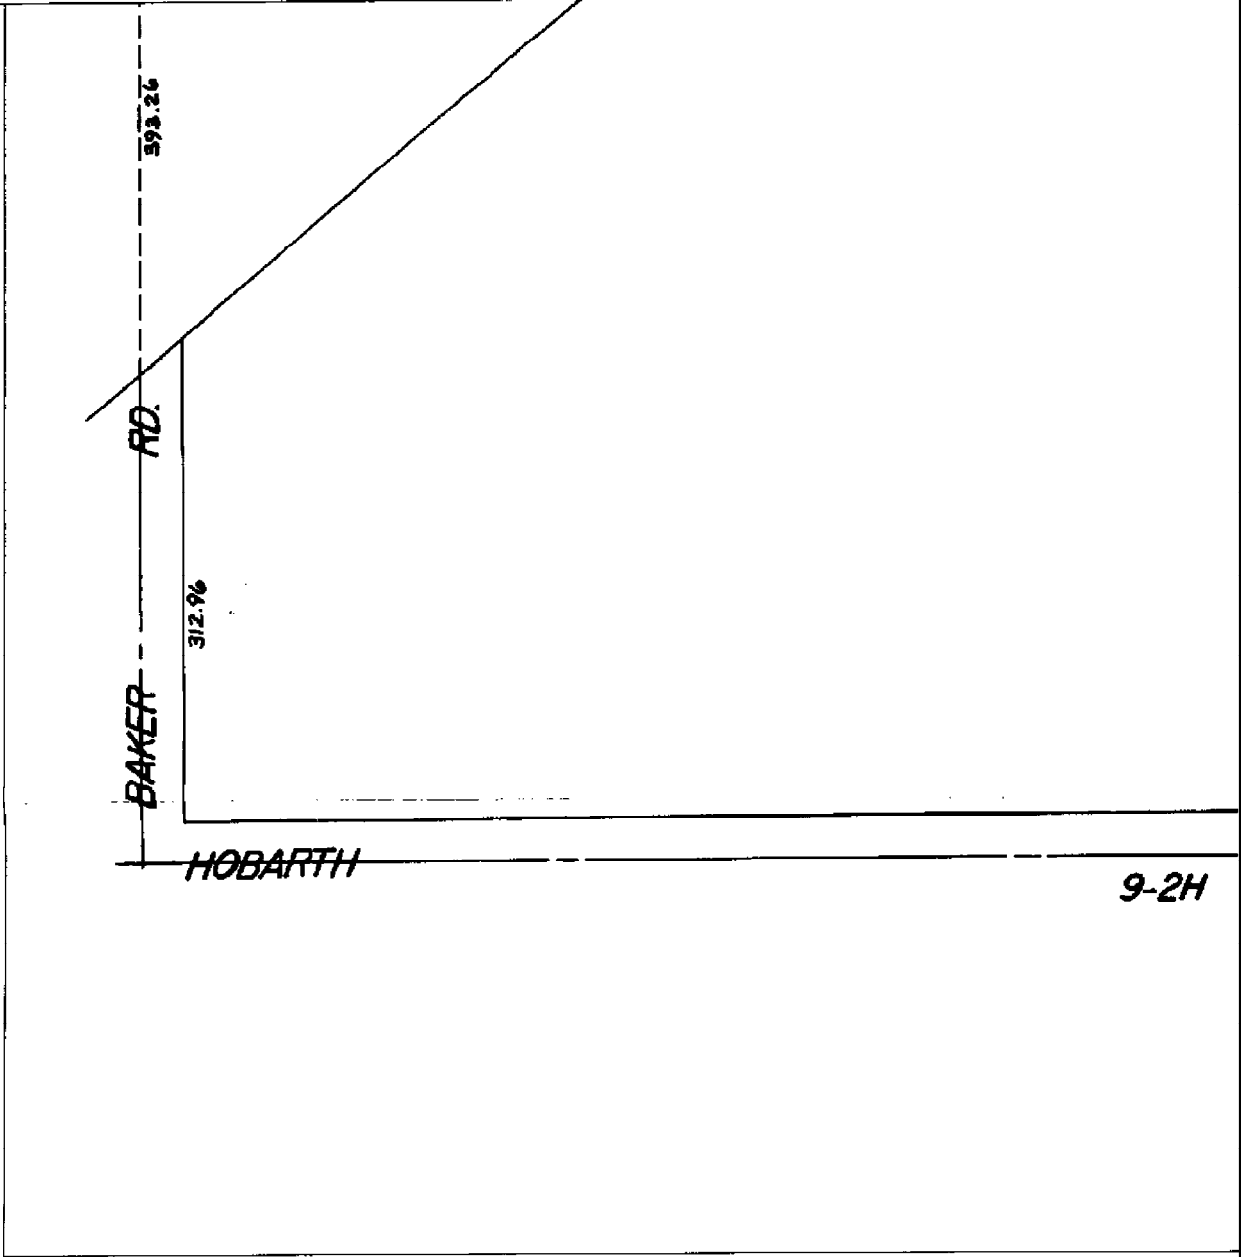

Date of Photography: March 2000

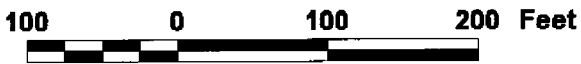


1:1200

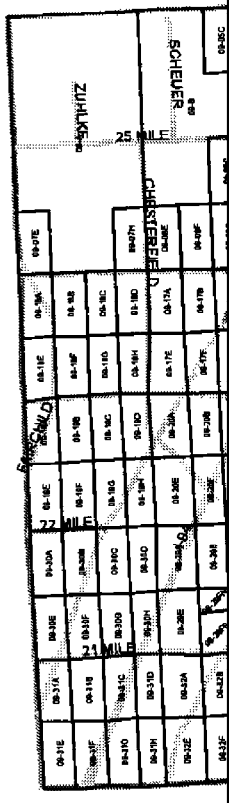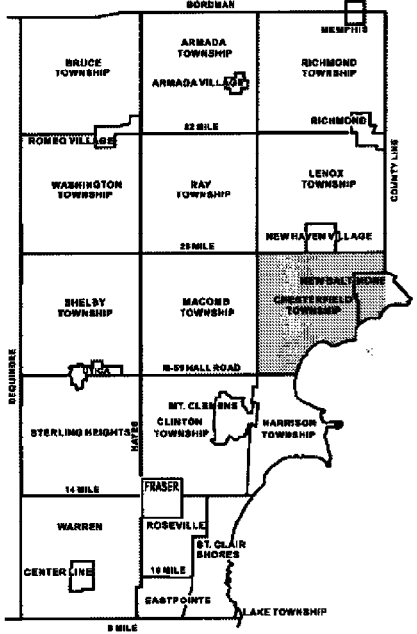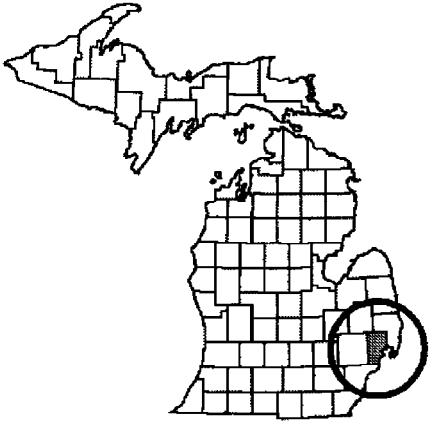

6-35H

RD.

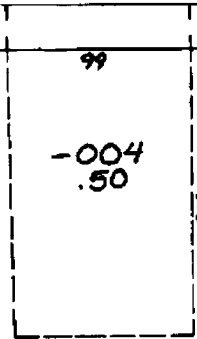

379.6

636.72

5
C.R.
PL.

537.51
795.86

-008
3 429

504.86

C-258.95
R-23068.32

611.56
461.44



C-258.35
R-23068.32

611.56
461.44

-014
8.64

S. 22910.32
C-380

S. 25

9-1A

-015
25.74 C.R.
27.44 PL.

RD.

379.6

698.72


637.51
795.86

-008
3 429

504.86



70.22
380

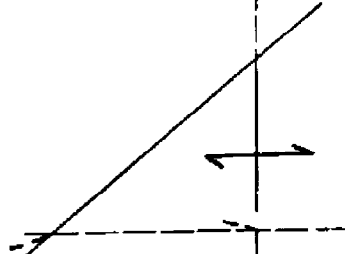

9-1A

HESTERFIELD TWP.
NE. 1/4 SEC. 2 T.3N. R.14E.

CHESTERFIELD TWP
E. 1/2 NE. 1/4 SEC. 2 T.3N. R.14

E 1/4 POST

RD.

SCALE: 1" = 100'

COPYRIGHT 1995 MACOMB COUNTY, MI.
 All Rights Reserved.

9-2D

18-118	18-119	18-120	18-200
--------	--------	

DESCRIPTION OF PERMANENT REAL ESTATE INDEX NUMBER

13 - 19 - 302 - 018

- AREA NUMBER**
(TOWNSHIP UNDER SUPERSEDED SURVEY)
- SUB AREA NUMBER**
(ALWAYS CONSIDERED WITH SECTION NUMBER)
- BLOCK NUMBER**
(CITY BLOCK LOCATION IN SECTION)
- PARCEL NUMBER**
(USUALLY A HOUSE LOT OR FARM)

09-02D

E. 1/2 N.E. 1/4 SEC. 2 T. 3N. R. 14E.
CHESTERFIELD TWP.

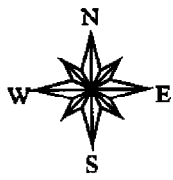

Source: Macomb County Planning and Economic Development Department (PEDD)
 - 2000 Digital Orthophotography Project
 - Parcel Conversion Project

Note: Digital Orthophotography horizontal positioning accuracy is 3 feet.
 Parcel boundary lines should be considered a graphical representation and not in any way a legal survey or engineering document. In general, the horizontal positioning and length accuracy is 15 feet.

This map is intended for general planning purposes. Site specific evaluation should be verified by field inspection. This is a work in progress and may contain errors and omissions. Please report any potential revisions to the PEDD at (810)469-5285.

MACOMB COUNTY
 Planning and Economic
 Development Department